


STATE	PROJ. NO.	FISCAL YEAR	SHEET NO.	TOTAL SHEETS
HAW.	19 BC-01-71	1973	22	51

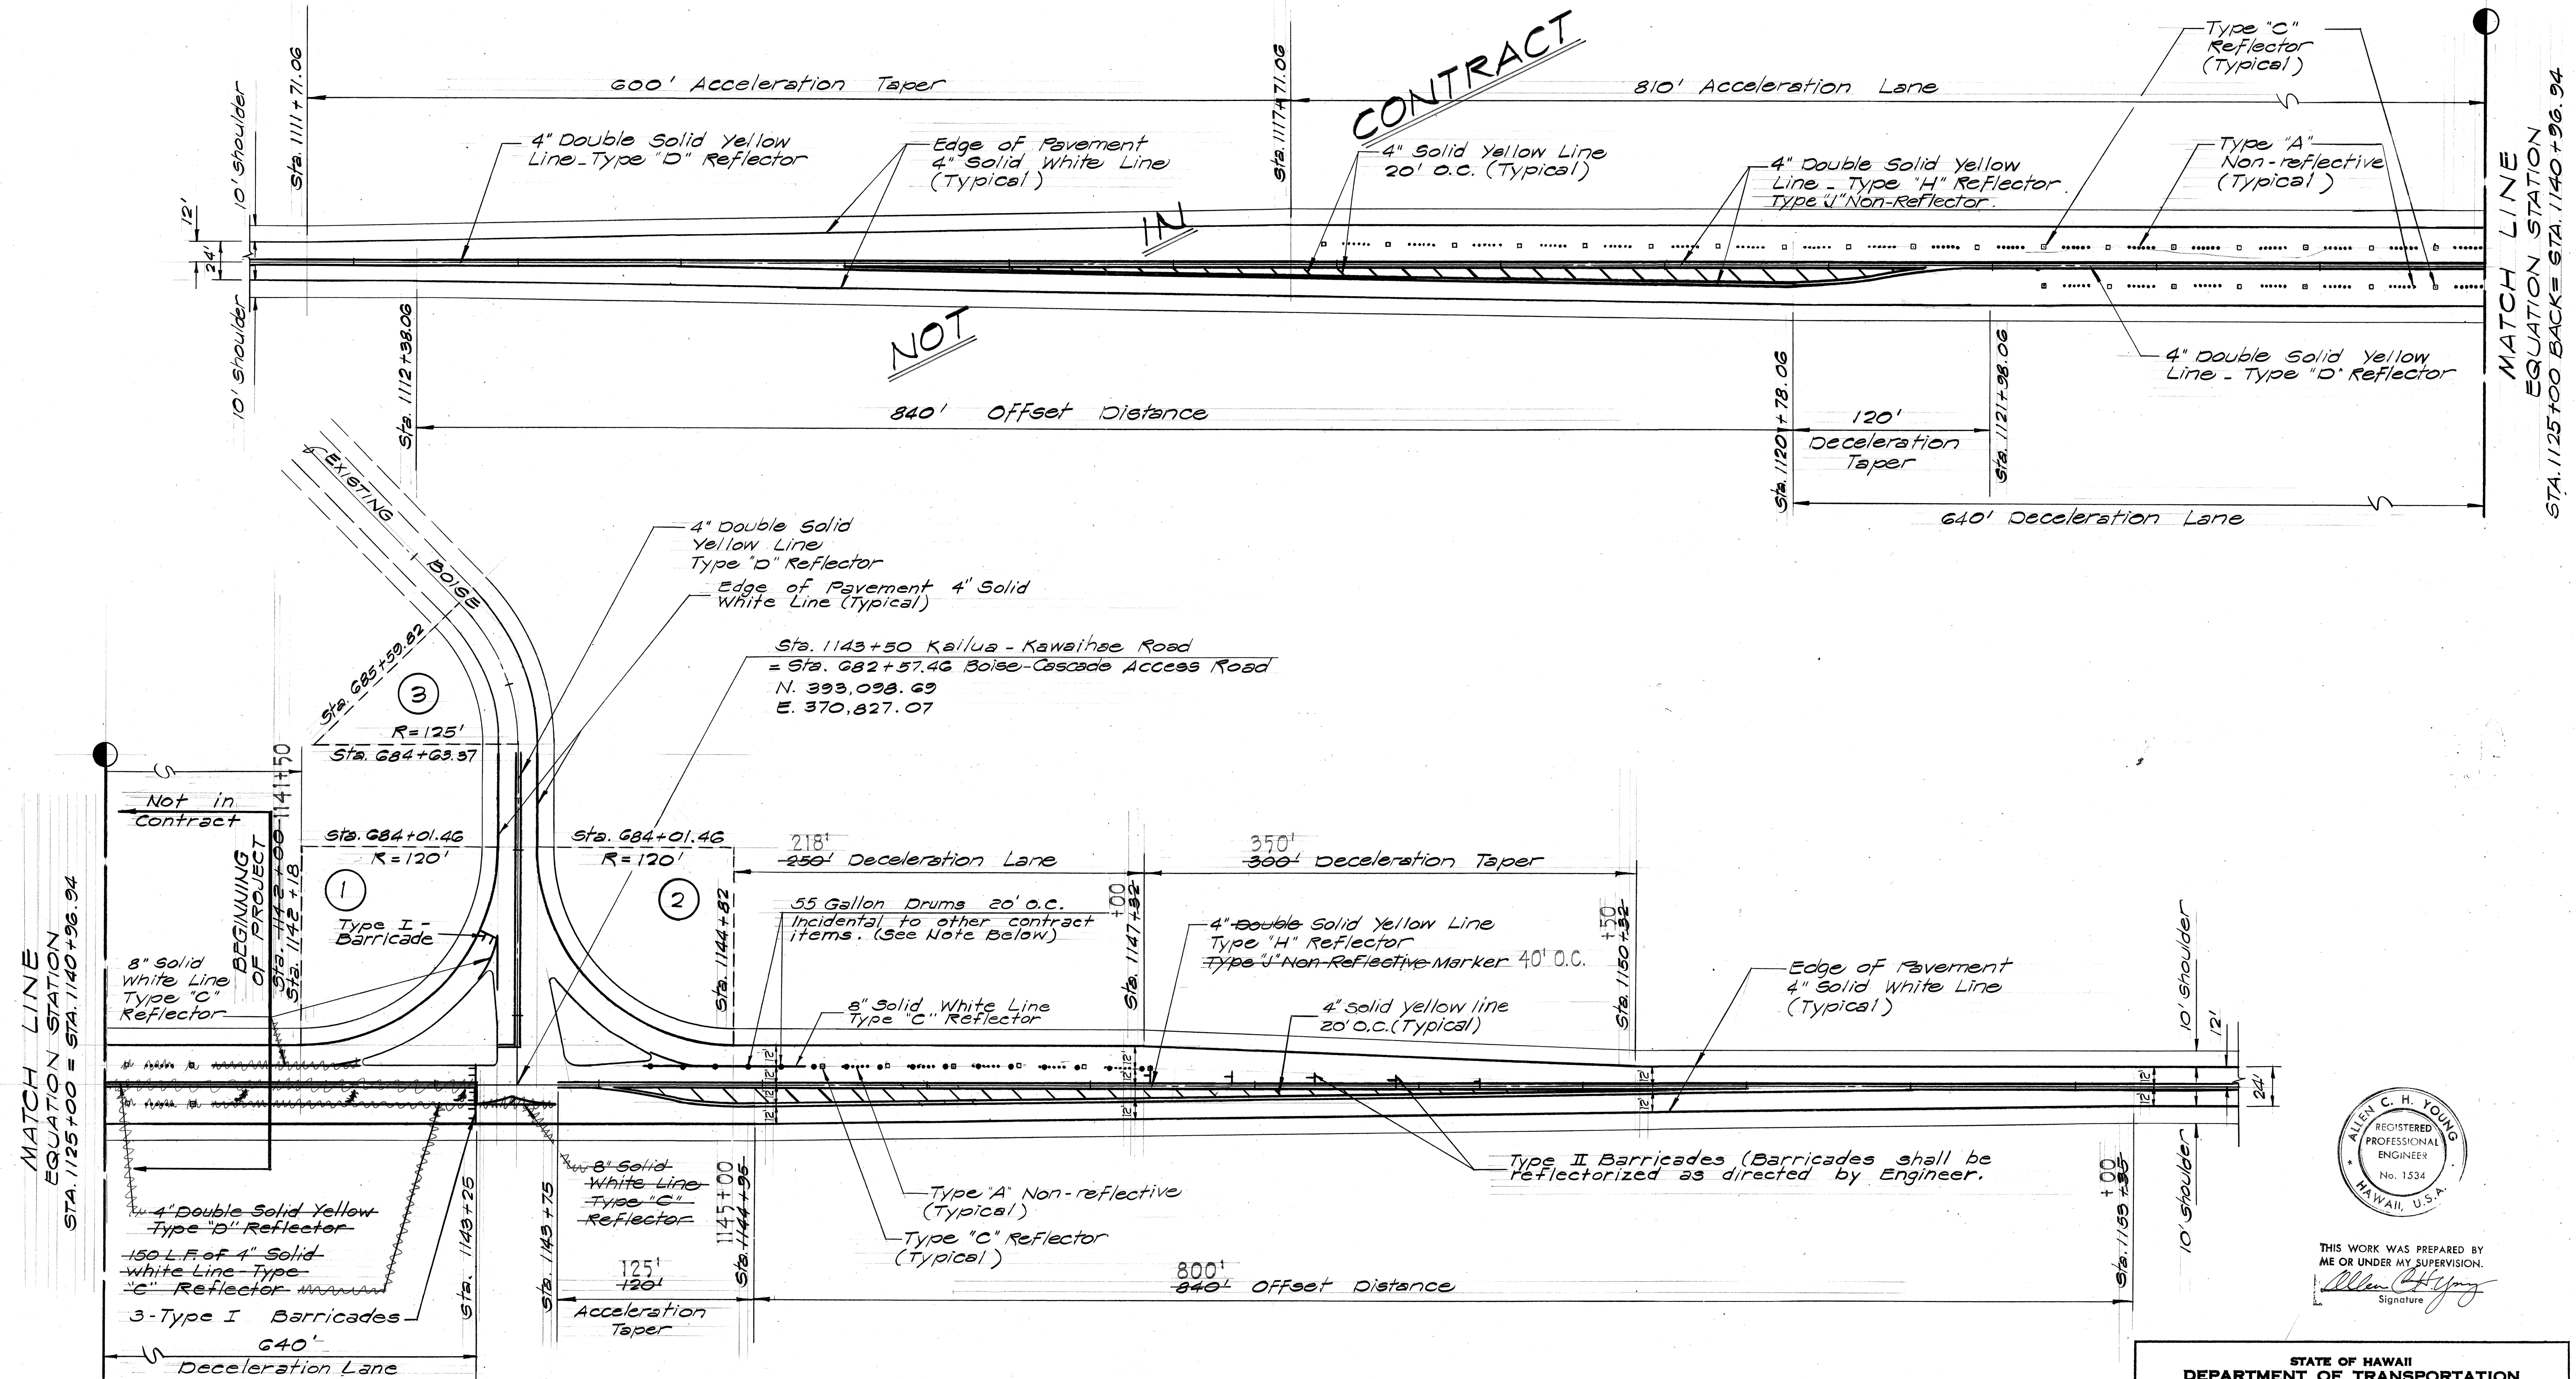

EDGE PAVEMENT CURVE DATA



① & ②
$\Delta = 90^{\circ}00'$
$\Delta 2 = 45^{\circ}00'$
$R = 120.00'$
$T = 120.00'$
$C = 169.71'$
$LC = 188.50'$

③ CURVE DATA

③
$\Delta = 44^{\circ}12'31''$
$\Delta 2 = 22^{\circ}06'15.5''$
$R = 125.00'$
$T = 50.77'$
$C = 94.07'$
$LC = 96.45'$

NOTE:

- 55 gallon drums reflectorized and painted in accordance to the manual on uniform traffic control devices or as directed by the Engineer.
- Refer to sheet No 42 for pavement marker detail.

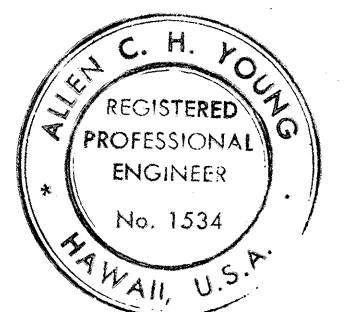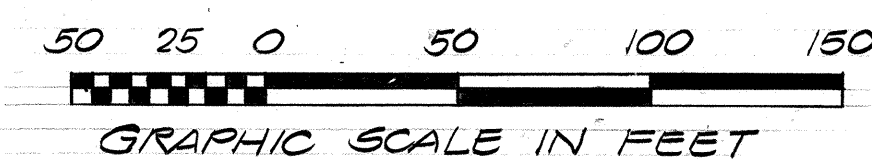

THIS WORK WAS PREPARED BY
ME OR UNDER MY SUPERVISION.
Allen C. H. Young
Signature

STATE OF HAWAII
DEPARTMENT OF TRANSPORTATION
HIGHWAYS DIVISION


STRIPING PLAN

INTERSECTION OF KAILUA - KAWAIHAE
ROAD STA. 1143+00 AT
BOISE - CASCADE ACCESS ROAD

KAILUA - KAWAIHAE ROAD
ANAEOOMALU TO HAPUNA
PROJ. NO. 19 BC-01-71

SHEET No. 1 OF 3 SHEETS


STATE	PROJ. NO.	FISCAL YEAR	SHEET NO.	TOTAL SHEETS
HAW.	199C-01-71	1973	23	51

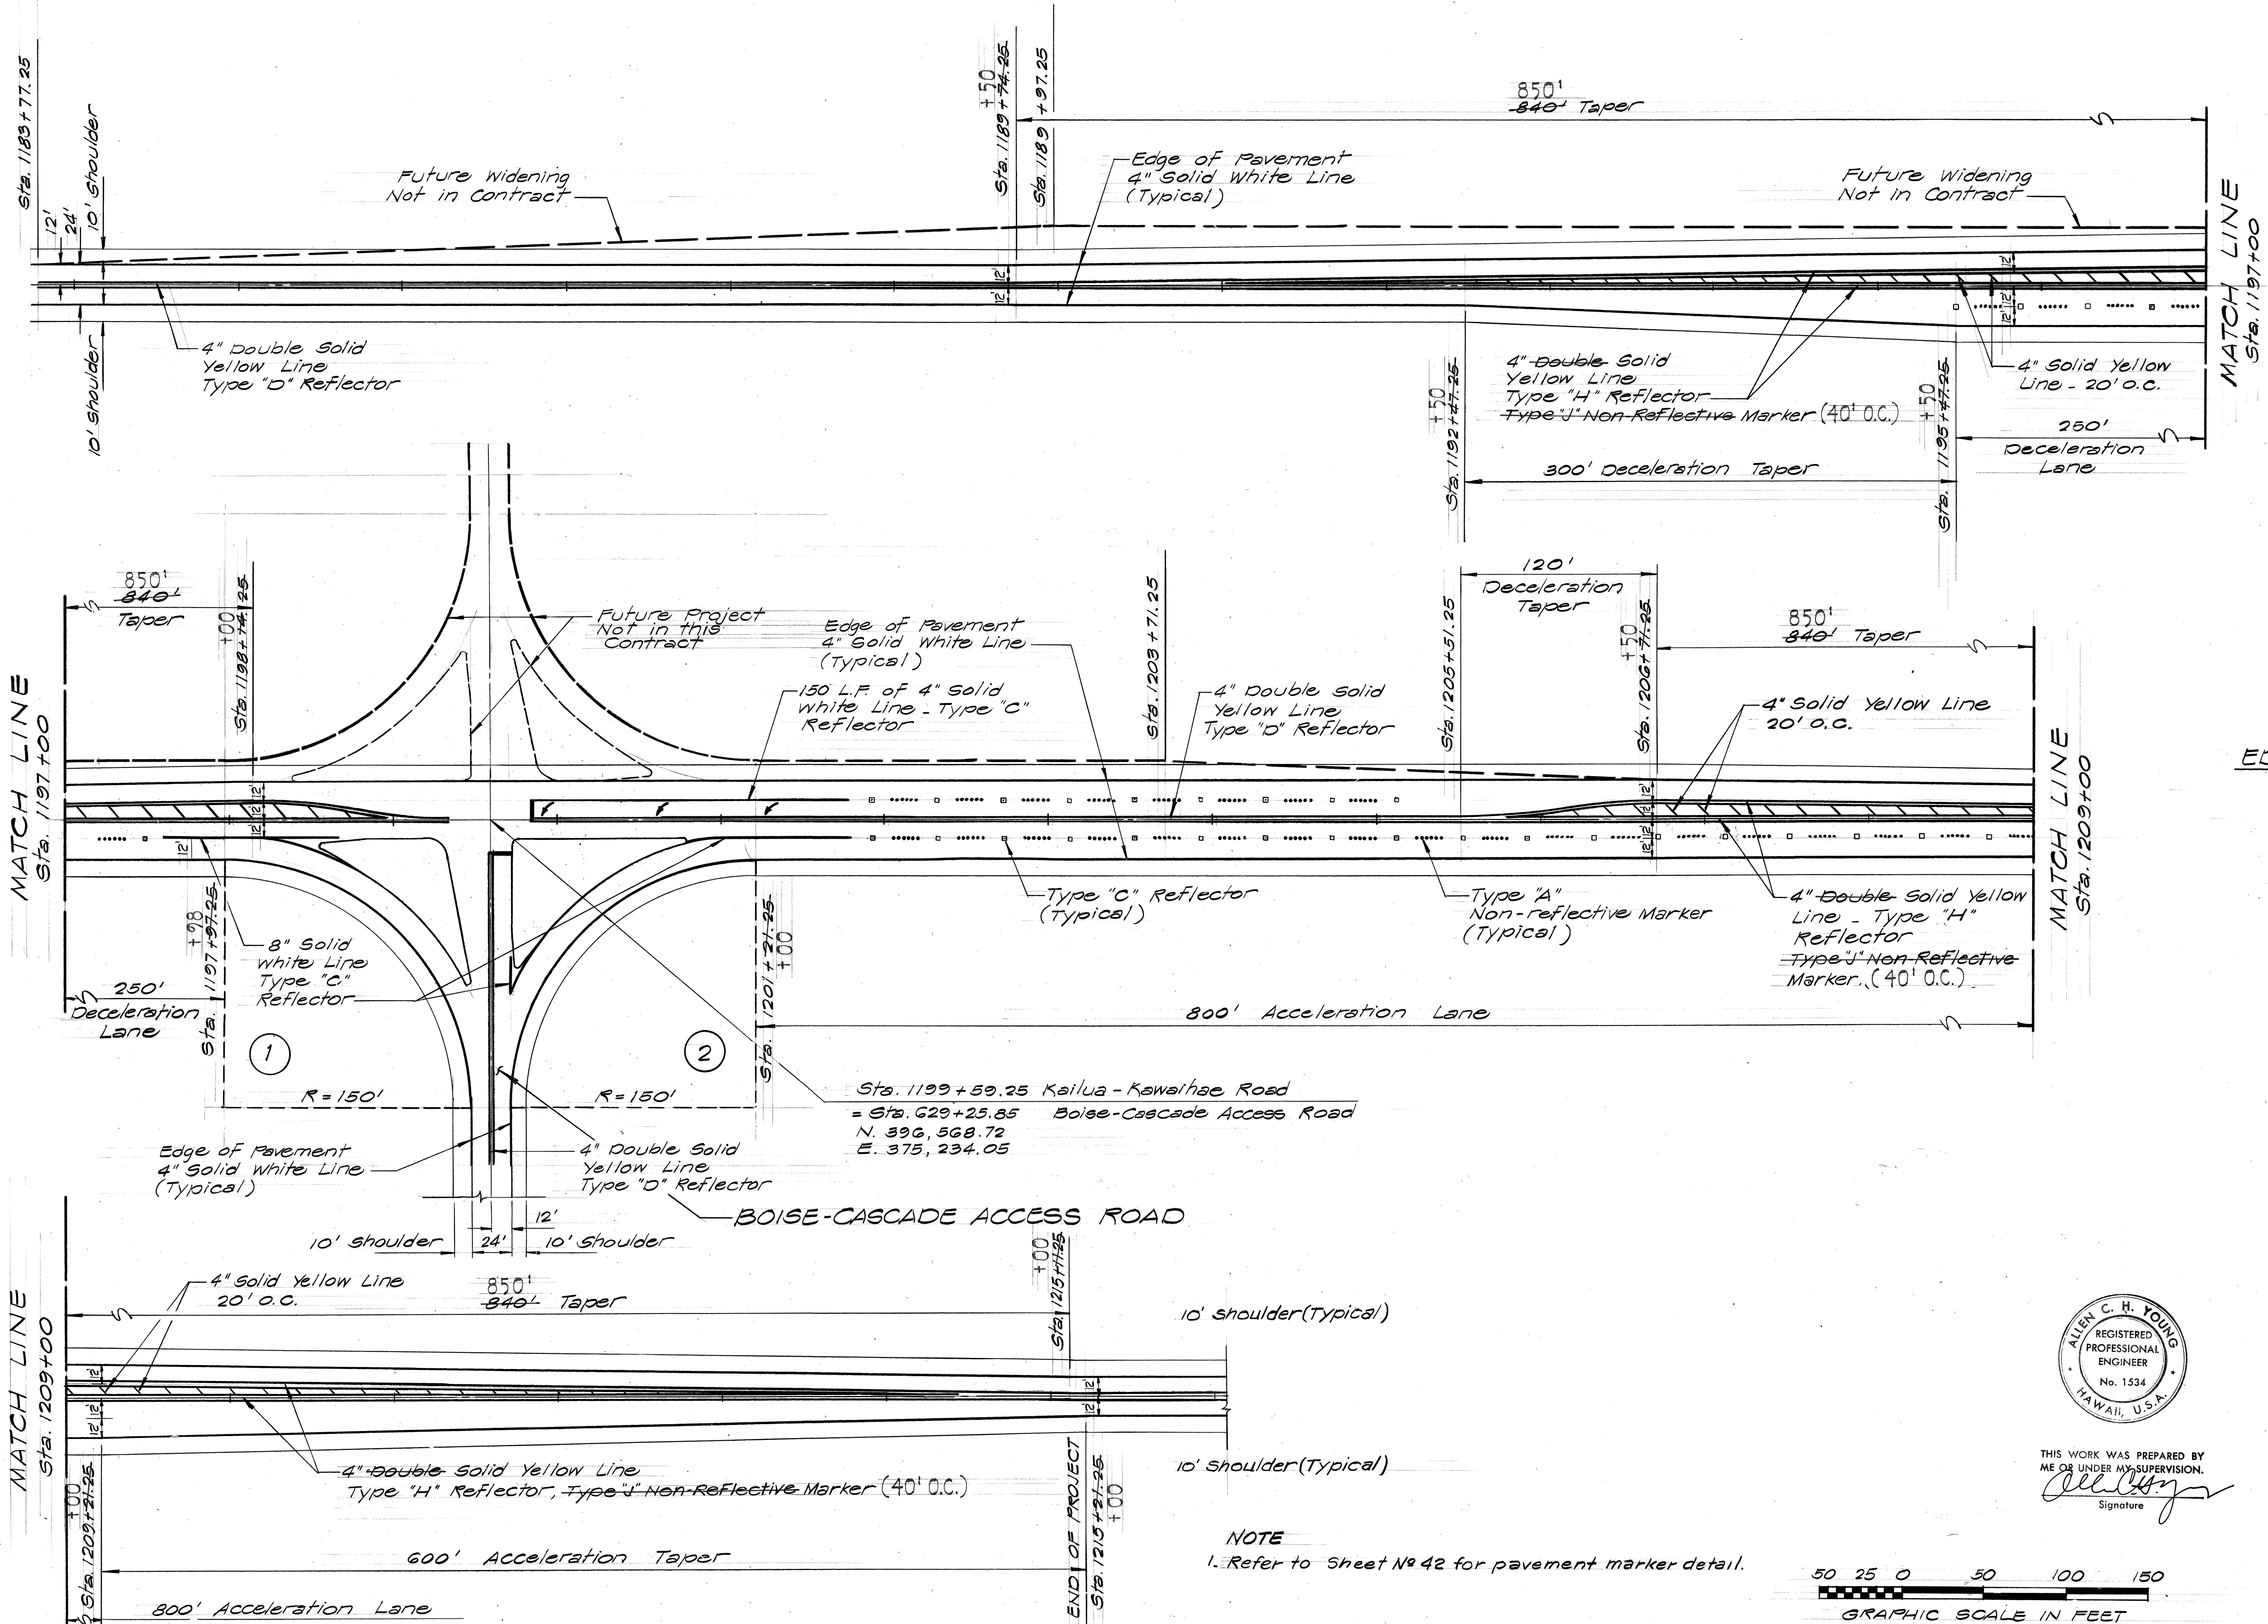

EDGE PAVEMENT CURVE DATA

①	②
$\Delta = 90^{\circ}00'$	
$\frac{\Delta}{2} = 45^{\circ}00'$	
$R = 150.00'$	
$T = 150.00'$	
$C = 212.13'$	
$LC = 235.62'$	

SURVEY PLOTTED BY	DATE
DRAWN BY	
DESIGNED BY	
NOTED BY	
CHECKED BY	
ORIGINAL PLAN	
NO.	

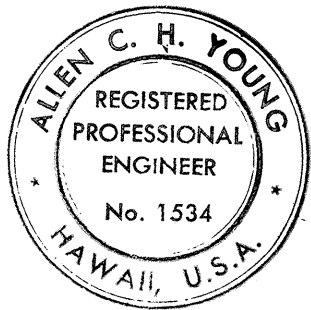


THIS WORK WAS PREPARED BY
ME OR UNDER MY SUPERVISION.
Allen C. H. Young
Signature

STATE OF HAWAII
DEPARTMENT OF TRANSPORTATION
HIGHWAYS DIVISION


STRIPING PLAN
INTERSECTION OF KAILUA-KAWAIHAE
ROAD STA. 1199+59.25 AT
BOISE-CASCADE ACCESS ROAD
KAILUA-KAWAIHAE ROAD
ANAEHOOMALU TO HAPUNA
PROJ. NO. 19 BC-01-71

SHEET No. 2 OF 3 SHEETS

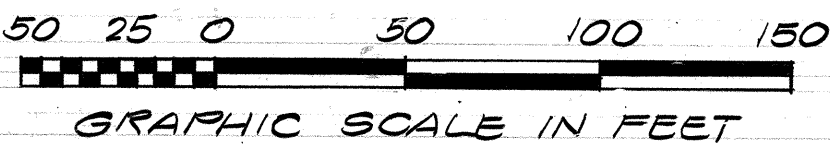


NOTE
1. Refer to Sheet No. 42 for pavement marker detail.

STATE	PROJ. NO.	FISCAL YEAR	SHEET NO.	TOTAL SHEETS
HAW.	19BC-01-71	1973	24	51

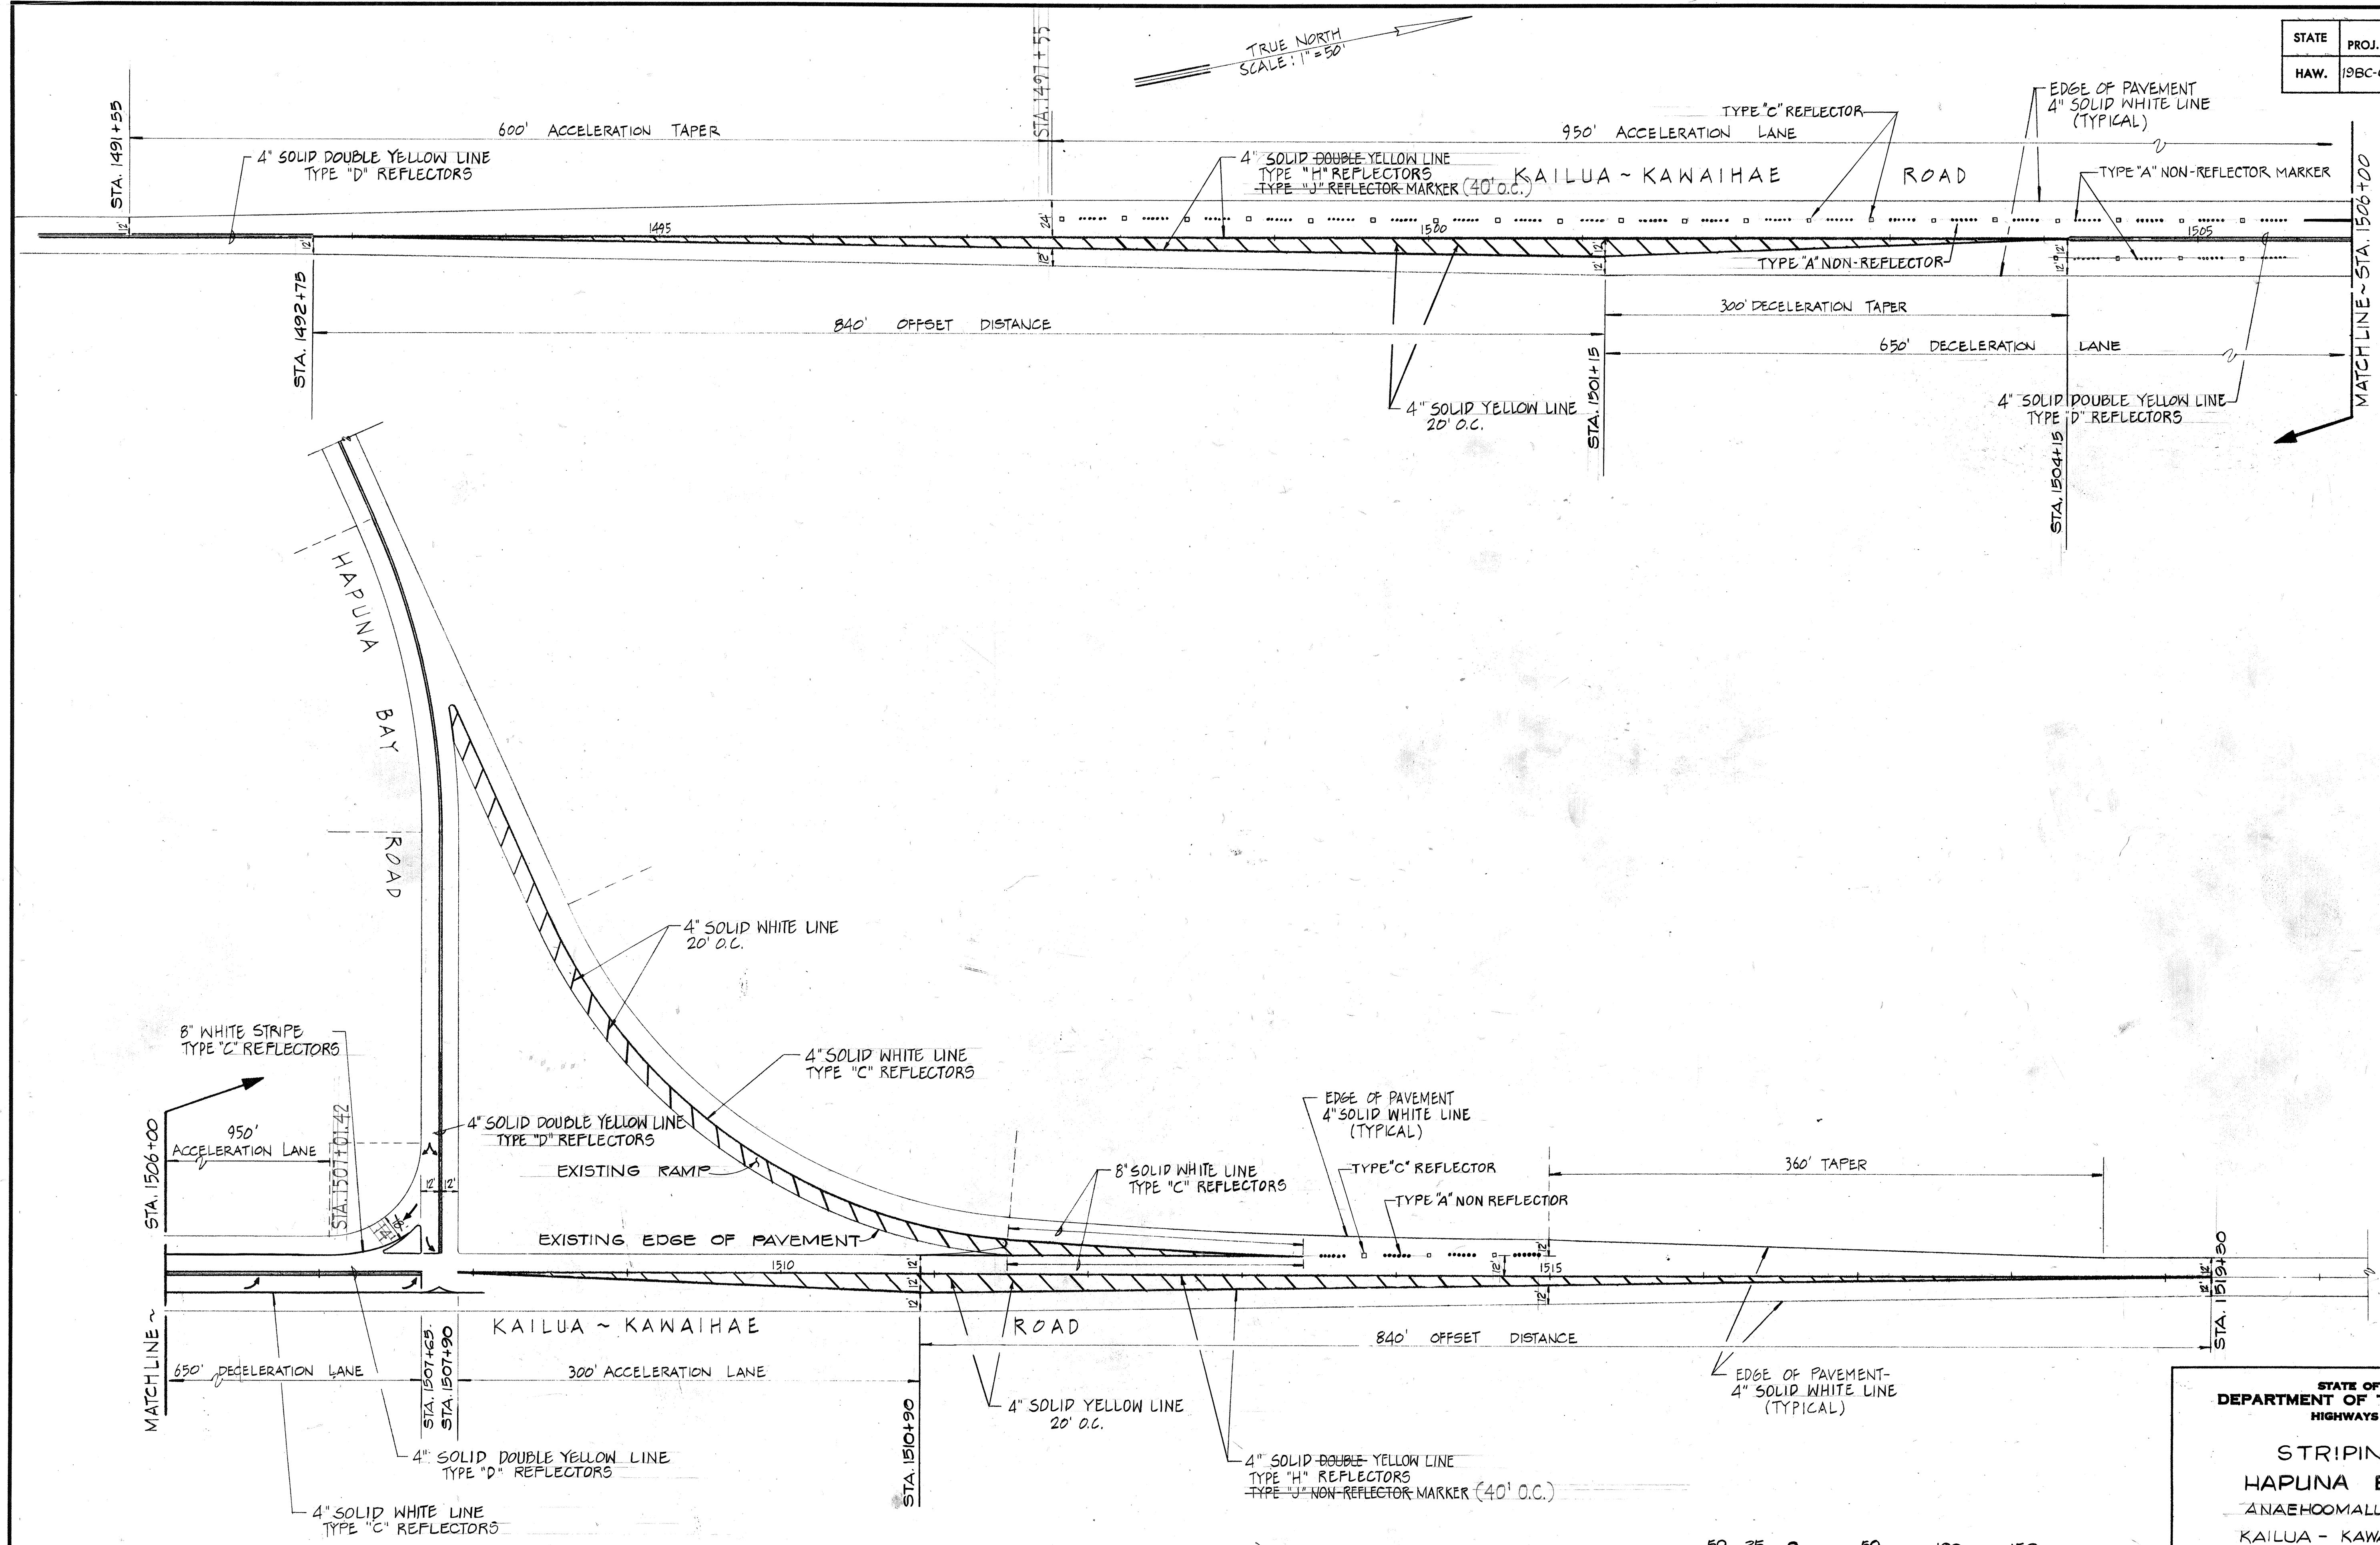

DATE	
DESIGNED BY	
ENGINEERED BY	
CHECKED BY	
NOTED BY	
ORIGINAL PLAN	
QUANTITIES BY	
NO.	

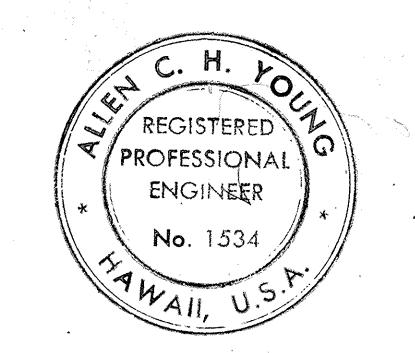

THIS WORK WAS PREPARED BY ME OR UNDER MY SUPERVISION.
Allen C. H. Young
 Signature

STATE OF HAWAII
 DEPARTMENT OF TRANSPORTATION
 HIGHWAYS DIVISION

STRIPING PLAN
 HAPUNA BAY ROAD
 ANAEOHOMALU TO HAPUNA
 KAILUA - KAWAIIHAE ROAD

PROJ. No. 19 BC-01-71

SHEET No. 3 OF 3 SHEETS

