

INDEX TO DRAWINGS	
SHEET NO.	DESCRIPTION
1	TITLE SHEET
2-3	TYPICAL ROADWAY SECTIONS
4	TYPICAL ROADSIDE DITCH SECTIONS
5	STRIPING SCHEDULE
6-19	PLAN & PROFILE
20-21	INTERSECTION LAYOUT PLANS
22-24	STRIPING PLANS
25	PROJECT INFORMATION SIGN
26-49	STANDARD DETAILS
50-51	SIGN DETAILS

STATE OF HAWAII

DEPARTMENT OF TRANSPORTATION

HIGHWAYS DIVISION

"AS BUILT" PLANS FOR

KAILUA-KAWAIHAE ROAD

PHASE IIIA

ANAEHOOMALU TO HAPUNA


(PAVING)

PROJECT NO. 19 BC-01-71

DISTRICT OF NORTH KONA & SOUTH KOHALA

ISLAND OF HAWAII

SCALES	
PLAN	1 INCH = 100 FT.
PROFILE	HOR. 1 INCH = 100 FT.
	VER. 1 INCH = 10 FT.

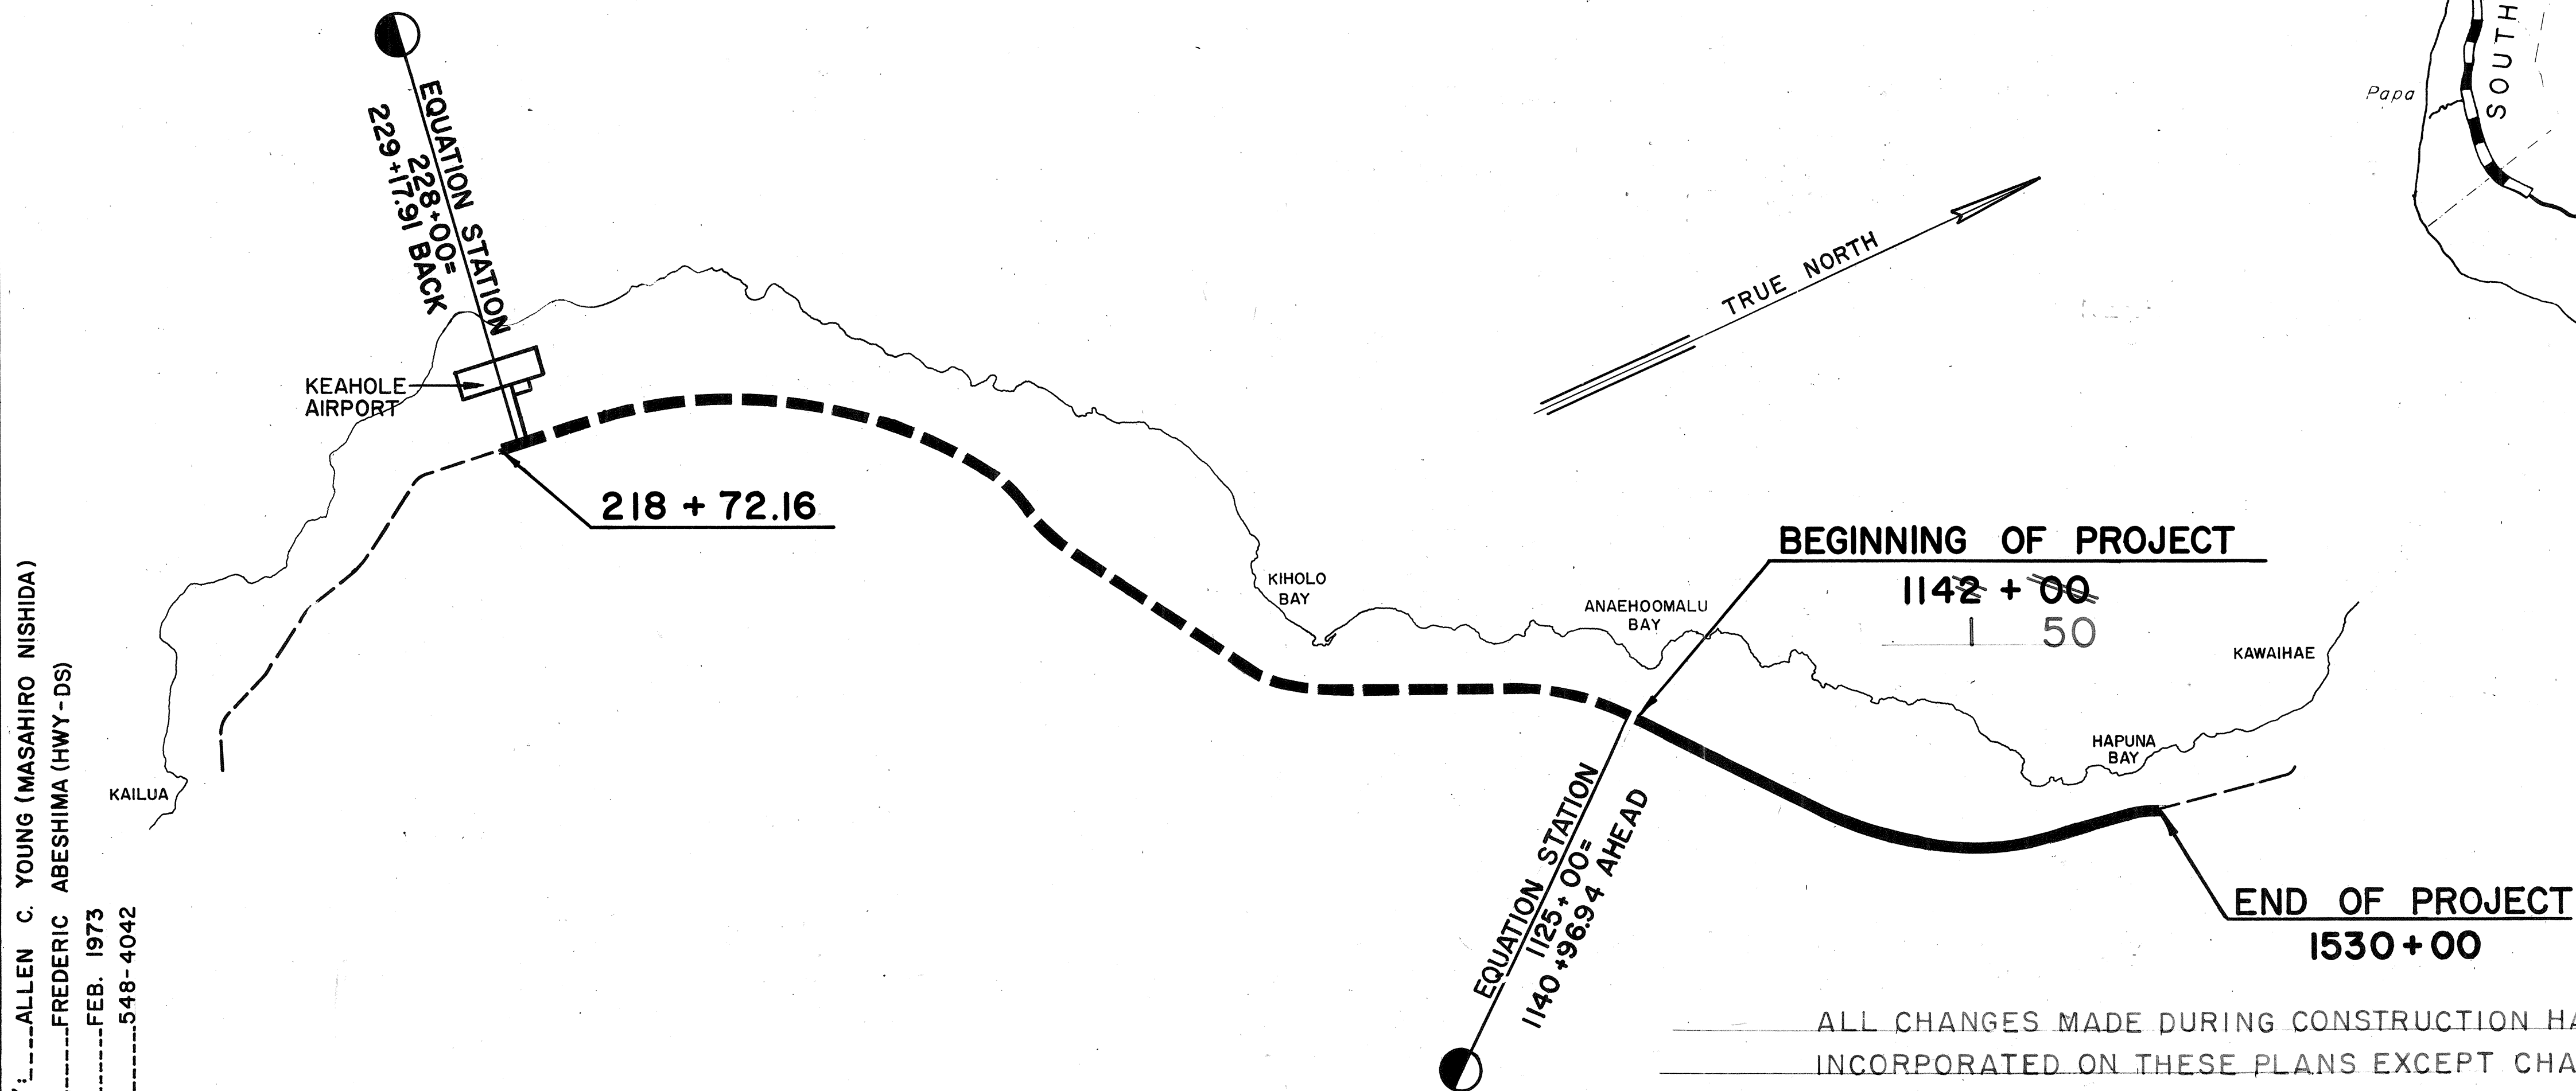


DESIGNED BY: ALLEN C. YOUNG (MASAHIRO NISHIDA)

P.S. & E. BY: FREDERIC ABESHIMA (HWY-DS)

DATE: FEB. 1973

PHONE: 548-4042

GENERAL LOCATION PLAN

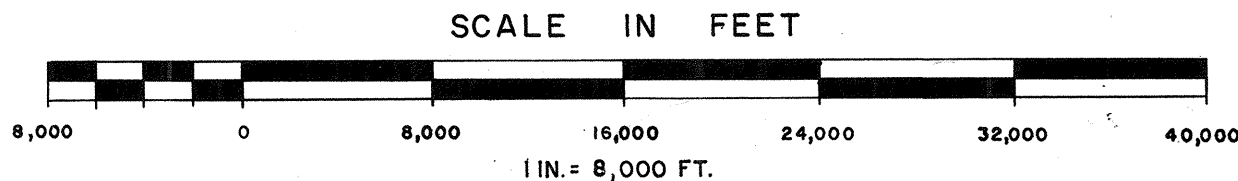

ALL CHANGES MADE DURING CONSTRUCTION HAVE BEEN

INCORPORATED ON THESE PLANS EXCEPT CHANGES IN


THE ORIGINAL THEORETICAL QUANTITIES.

PROJECT ENGINEER

DATE

GROSS LENGTH OF PROJECT - 7.34 MILES

STATE	PROJECT NO.	FISCAL YEAR	SHEET NO.	TOTAL SHEETS
HAWAII	19 BC-01-71	1973	1	51

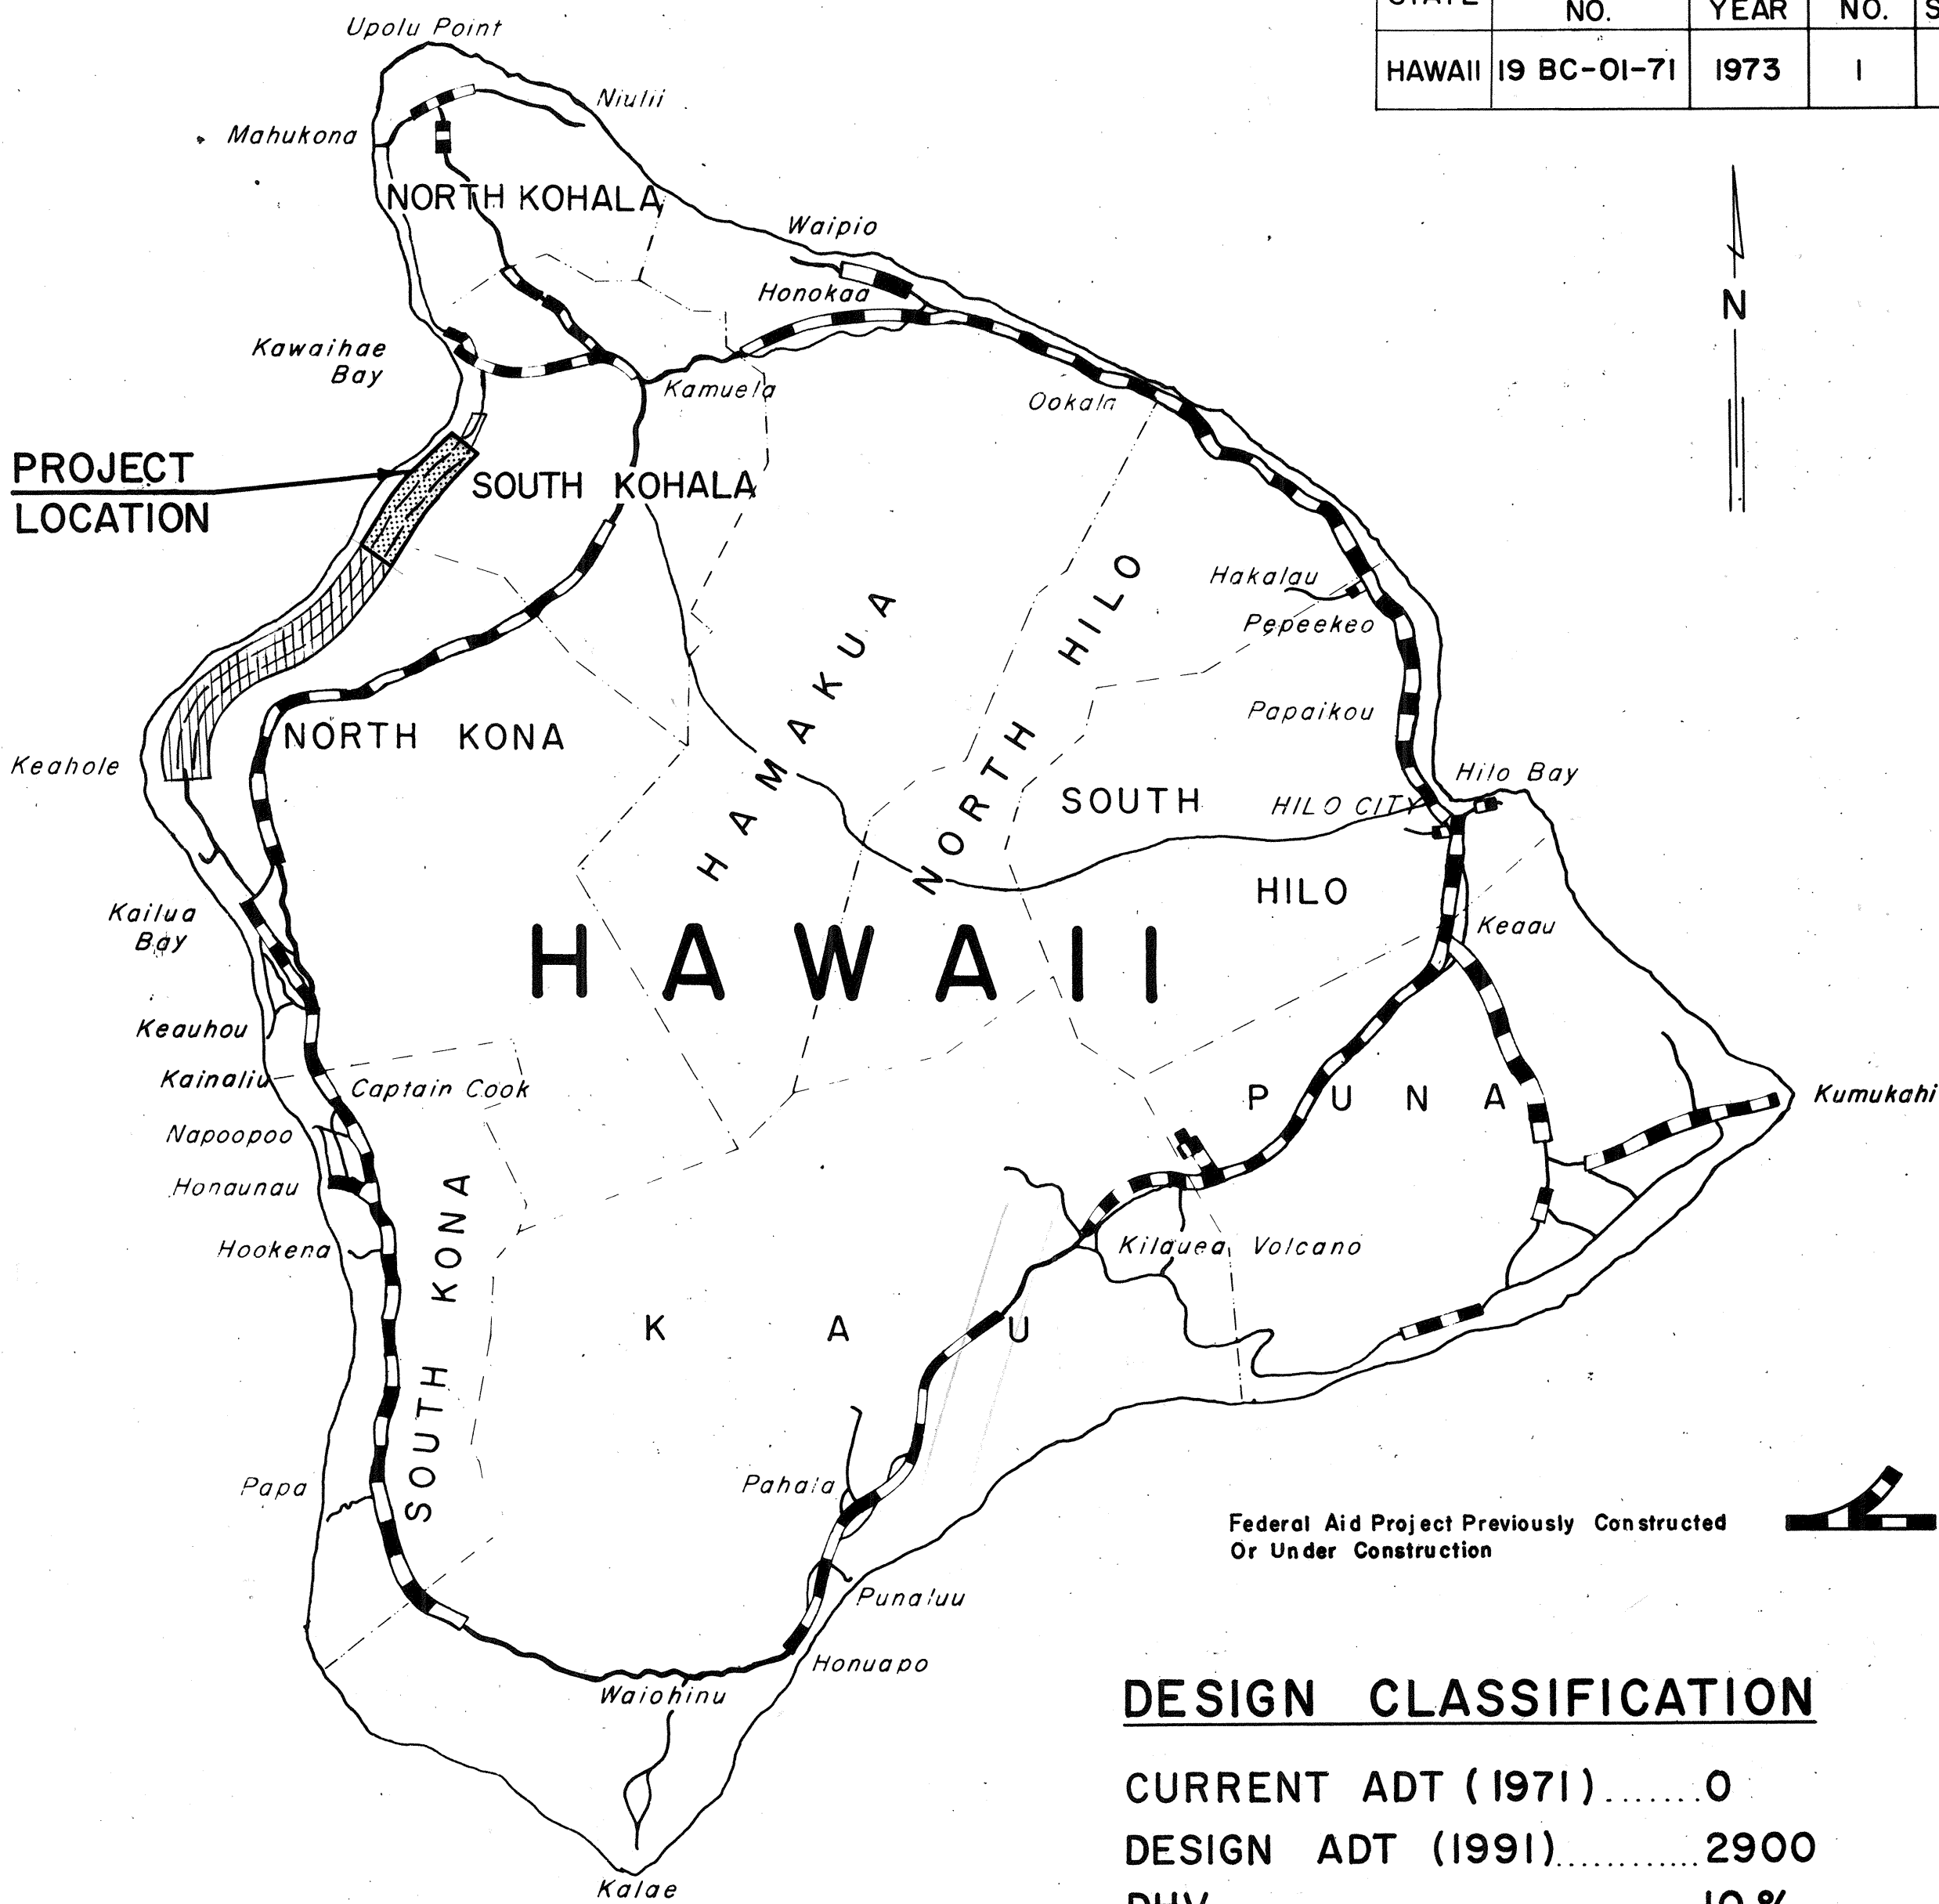


DESIGN CLASSIFICATION

CURRENT ADT (1971)	0
DESIGN ADT (1991)	2900
DHV	10 %
D	55 / 45
T	10 %
T24	10 %
V	70 MPH

R. M. TOWILL CORPORATION

CIVIL ENGINEERS & SURVEYORS

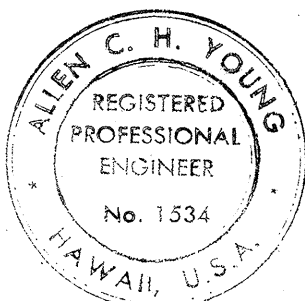

THIS WORK WAS PREPARED BY

ME OR UNDER MY SUPERVISION.

Signature

DEPARTMENT OF TRANSPORTATION STATE OF HAWAII	
APPROVED:	
DIR. OF TRANSPORTATION	DATE