



FED. ROAD DIST. NO.	STATE	FED-AID PROJ. NO.	FISCAL YEAR	SHEET NO.	TOTAL SHEETS
HAWAII	HAW.	19 GHK-01-73	1973	15	39

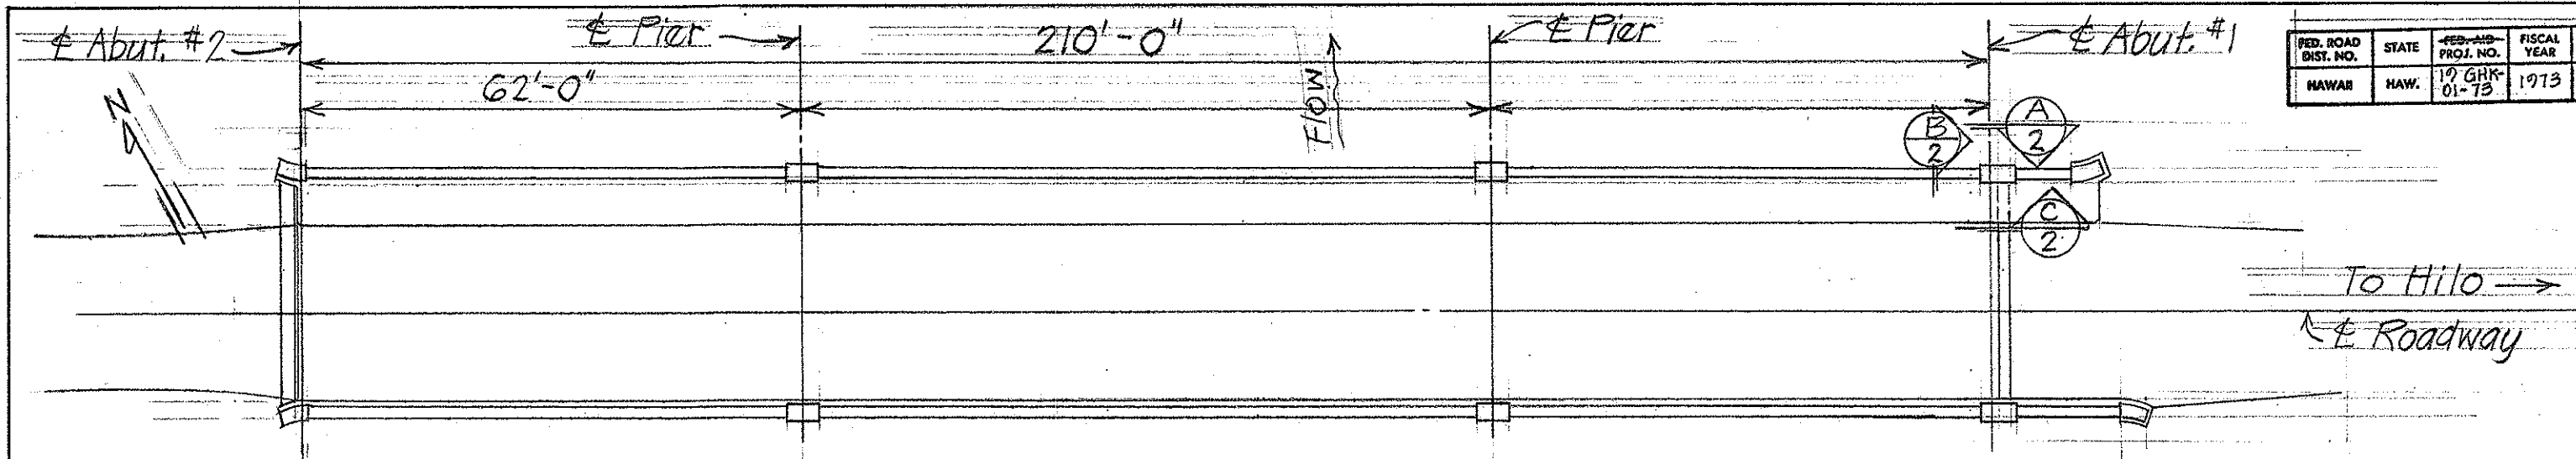

LAYOUT PLAN Scale: 1" = 20'-0"

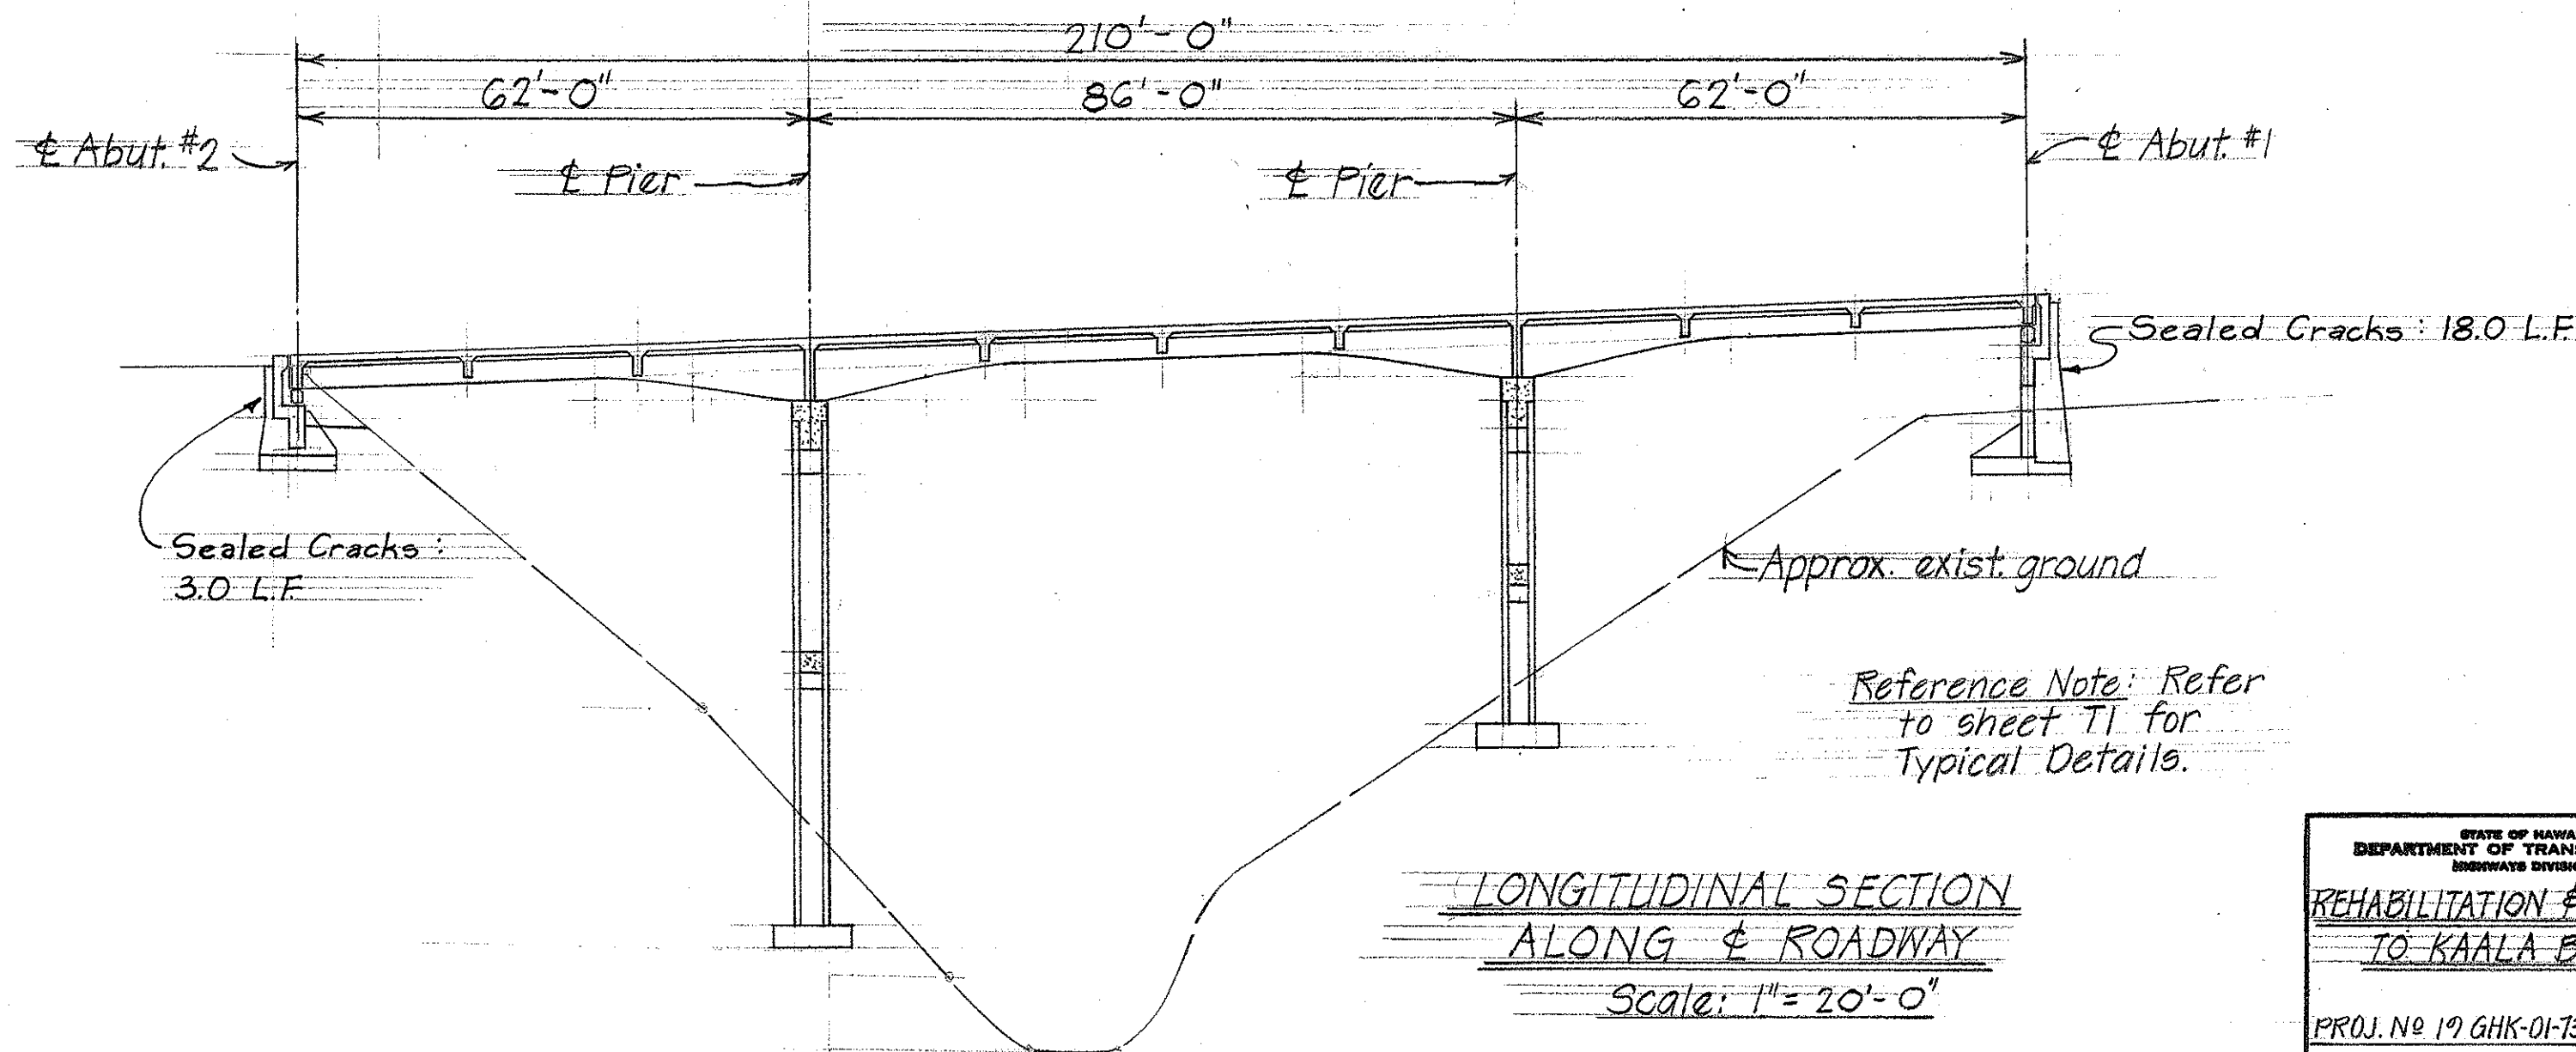

DESIGNED BY	DATE
DRAWN BY	
CHECKED BY	
IN CHARGE	
NOTED BY	
CHECKED BY	


STATE OF HAWAII
DEPARTMENT OF TRANSPORTATION
HIGHWAYS DIVISION

REHABILITATION & REPAIRS
TO KAALA BRIDGE

PROJ. No 19 GHK-01-73 Nov. 1973

SHEET No. 1 OF 2 SHEETS

FED. ROAD DIST. NO.	STATE	FED. AID PROJ. NO.	FISCAL YEAR	SHEET NO.	TOTAL SHEETS
HAWAII	HAW.	19 GHK-01-73	1973	16	39

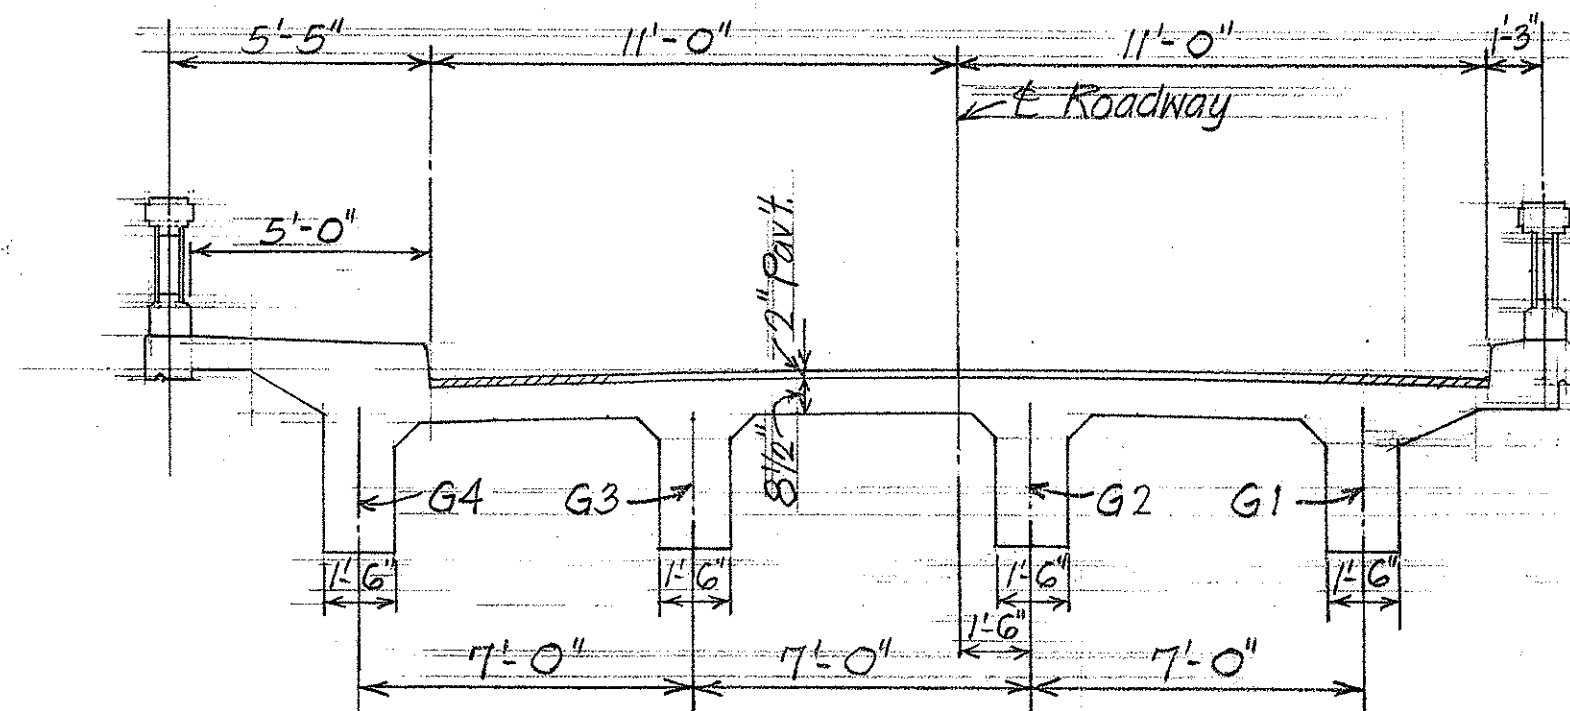

NORMAL DECK SECTION

Scale: 1/4" = 1'-0"


* SUMMARY:

SEALING OF CRACKS:

Abutment No. 1: 18.0 L.F.


" No. 2: 3.0 L.F.

TOTAL: 21.0 L.F.

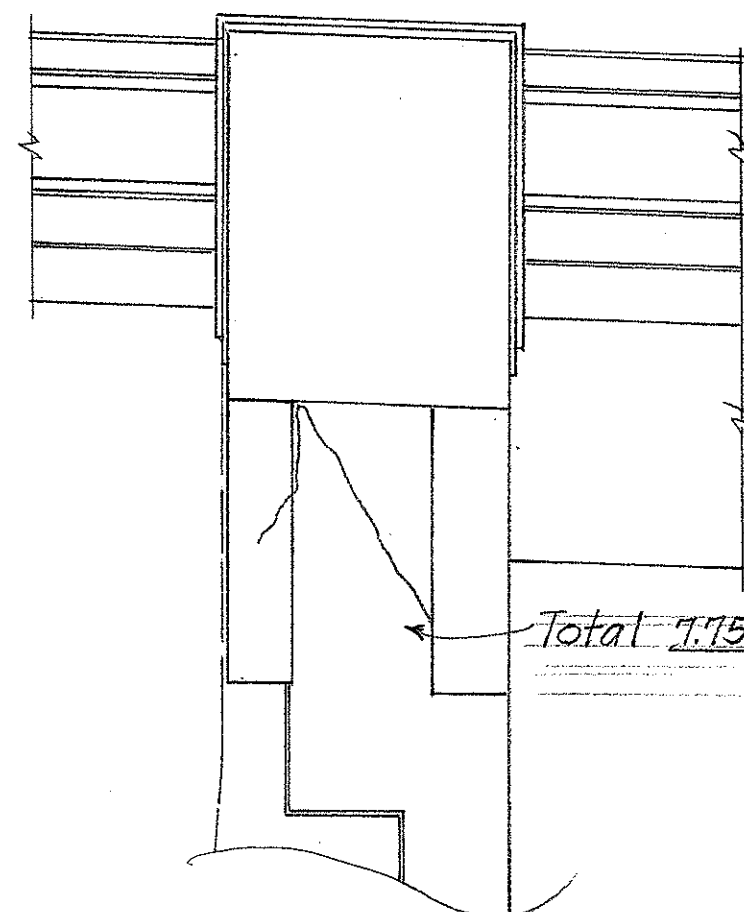


ELEVATION $\frac{A}{2}$

Scale: 3/8" = 1'-0"

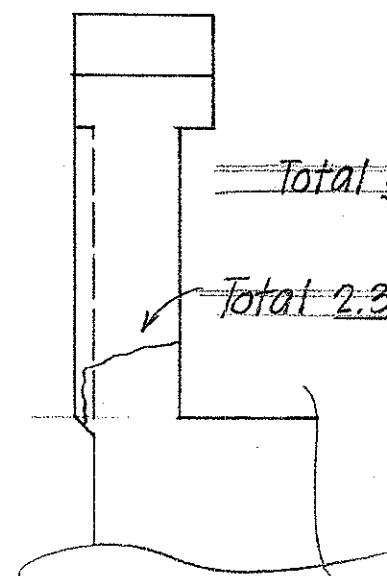

ELEVATION $\frac{B}{2}$

Scale: 3/8" = 1'-0"

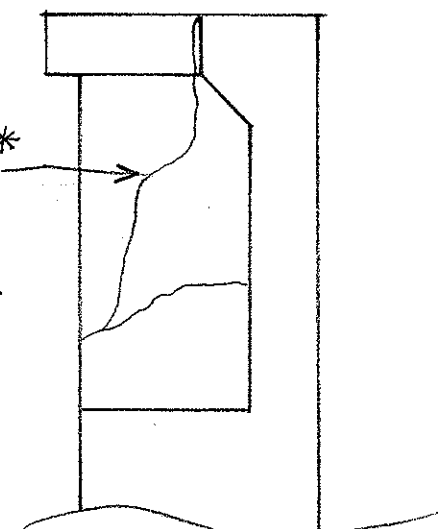

SECTION $\frac{C}{2}$

Scale: 3/8" = 1'-0"

STATE OF HAWAII	
DEPARTMENT OF TRANSPORTATION	
HIGHWAYS DIVISION	
<u>REHABILITATION & REPAIRS</u>	
<u>TO KAALA BRIDGE</u>	
PROJ. NO 19 GHK-01-73 Nov. 1973	
SHEET No. 2 OF 2 SHEETS	

DESIGNED BY	DATE
DRAWN BY	
CHECKED BY	
IN CHARGE	
NOTED	
REVISIONS	