
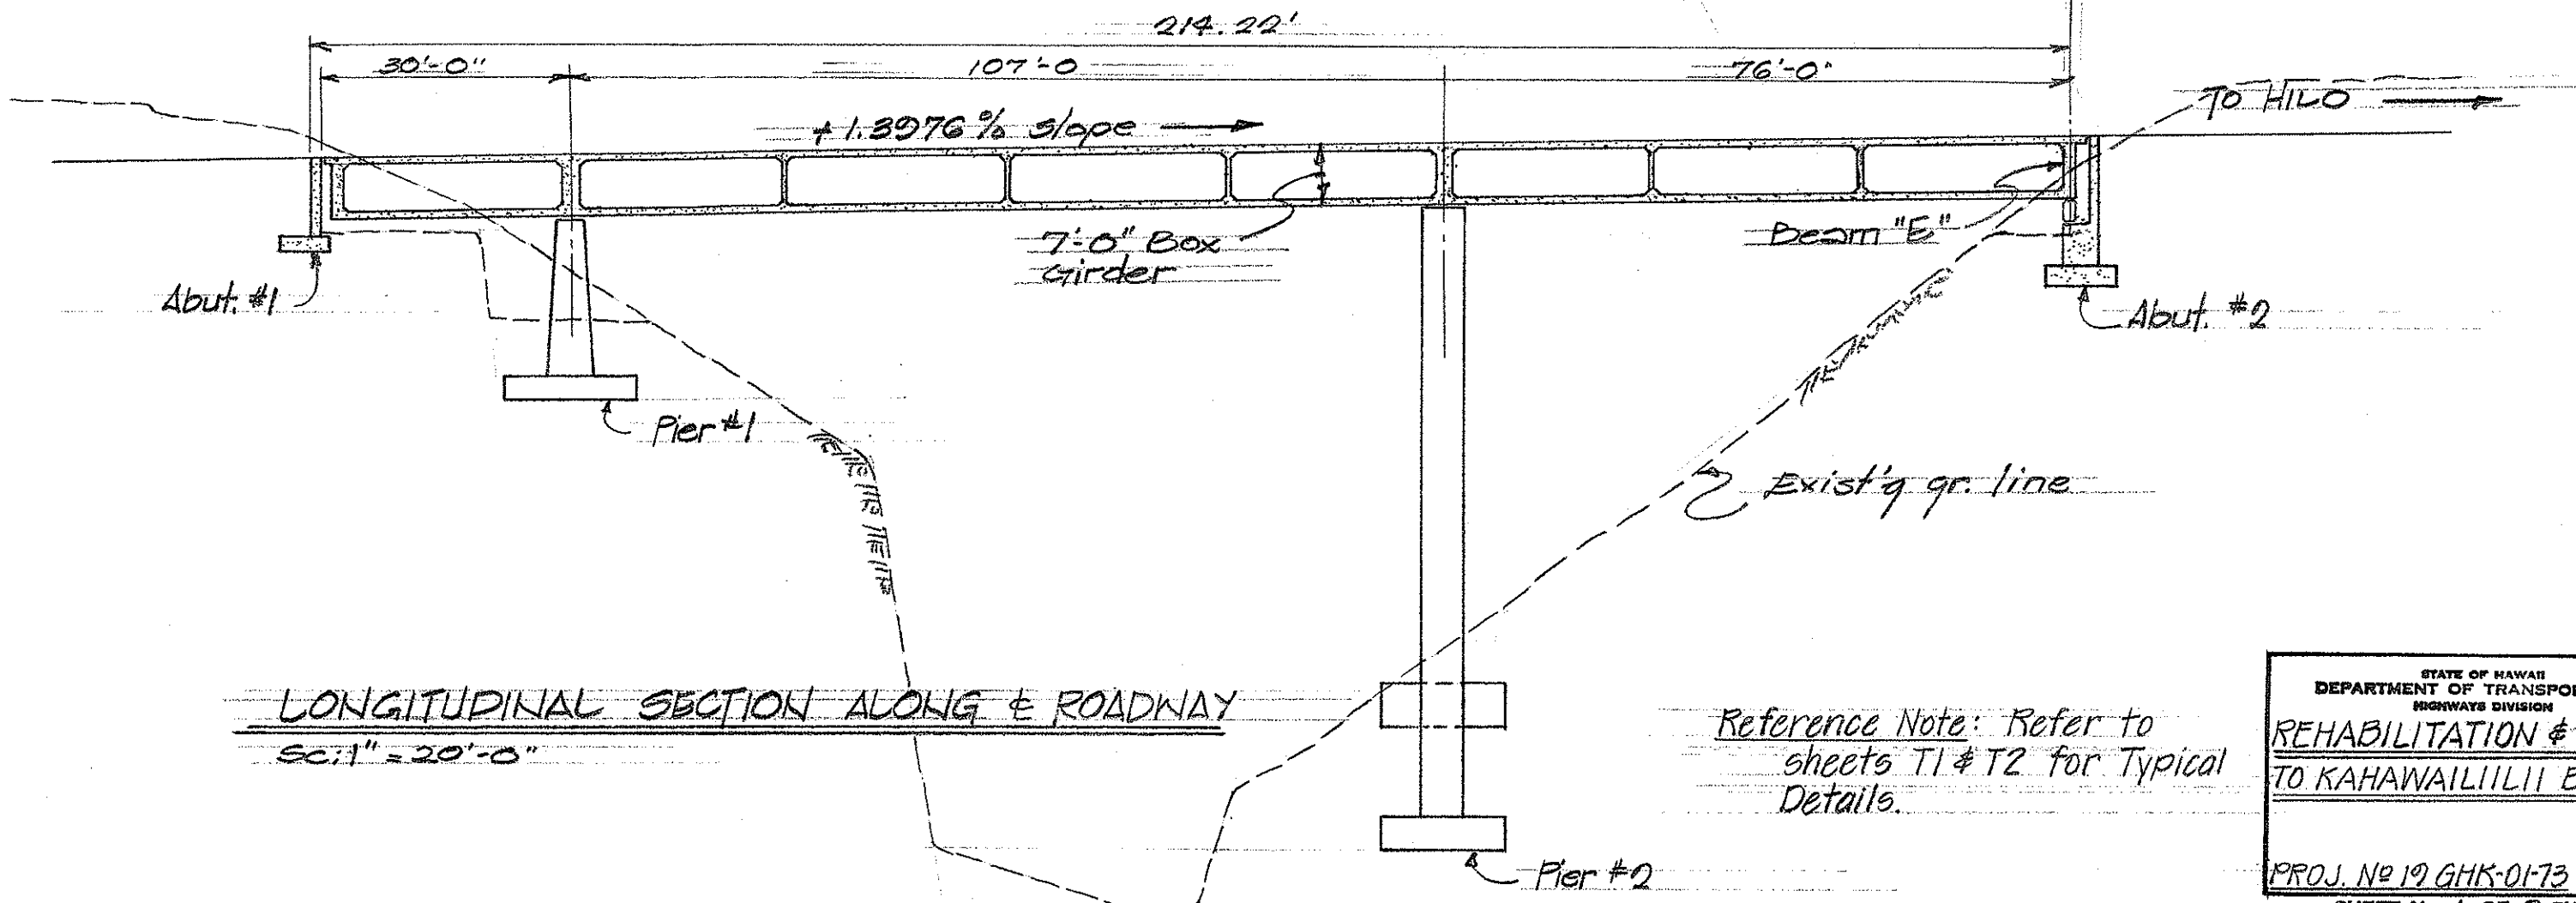


FED. ROAD DIST. NO.	STATE	FISCAL YEAR	SHEET NO.	TOTAL SHEETS
HAWAII	HAW.	1973	5	39

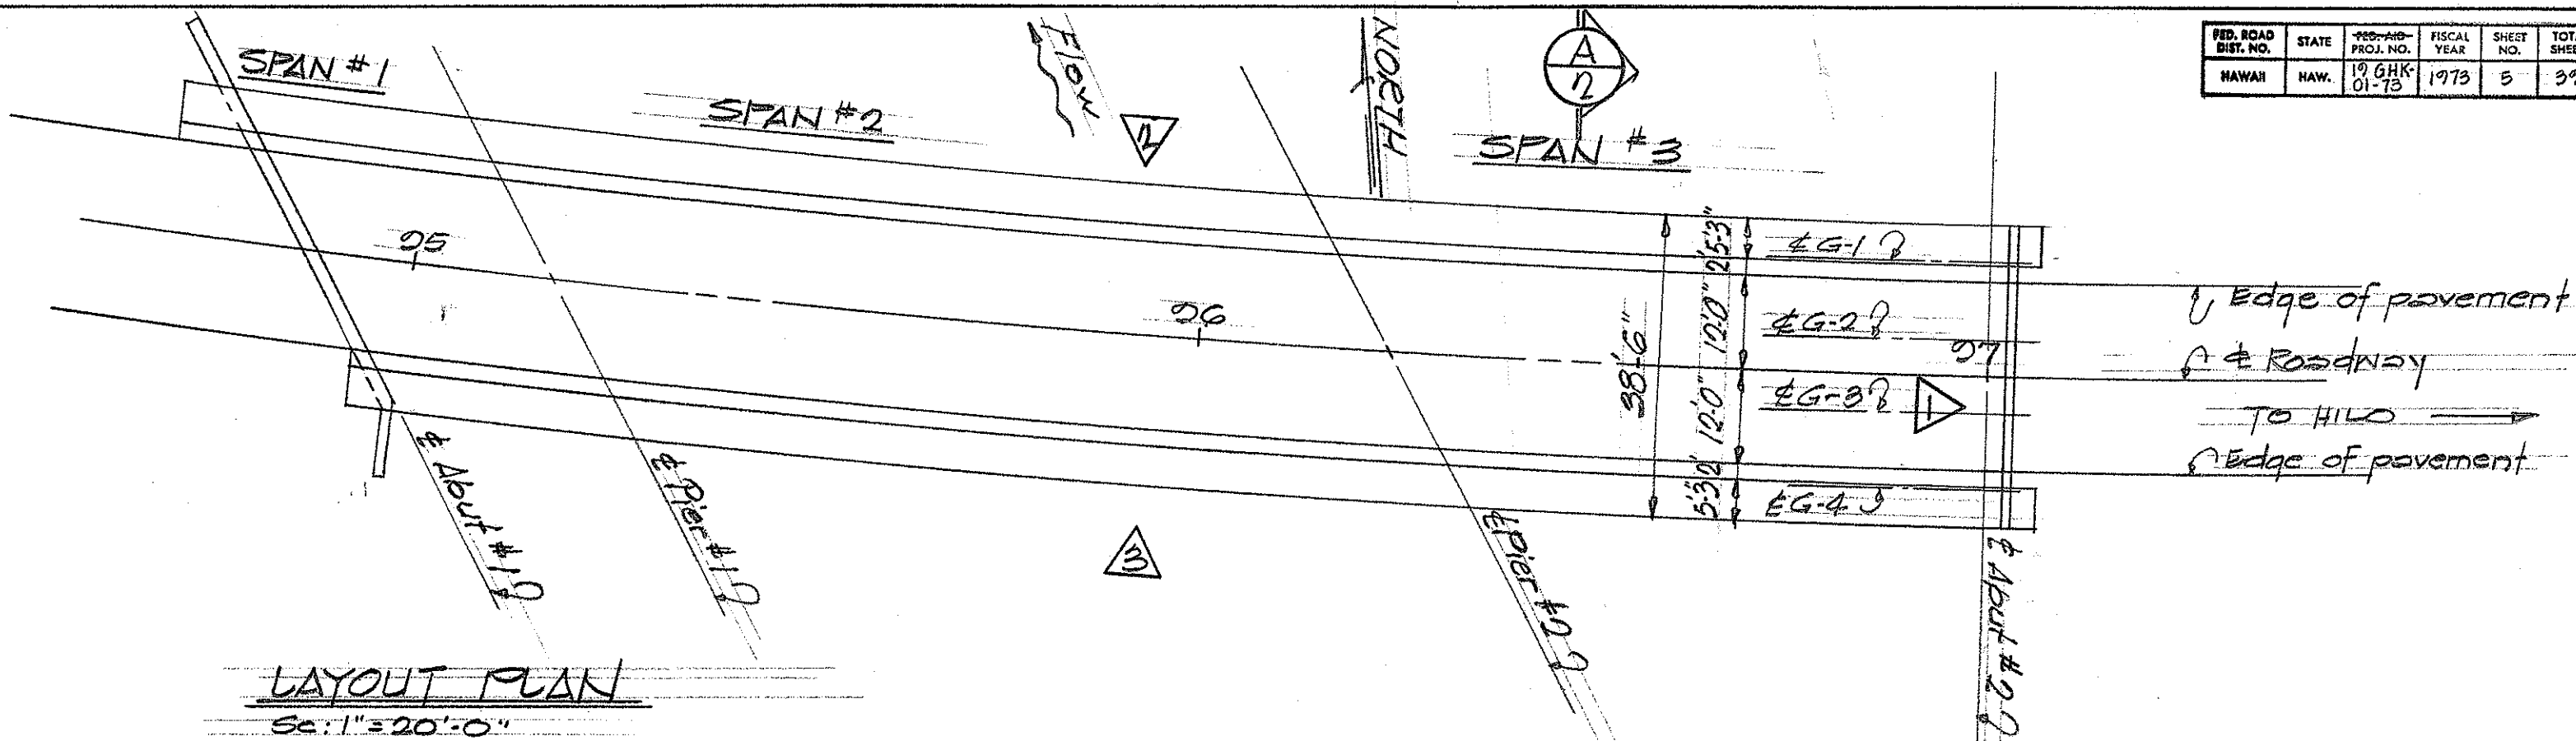

Reference Note: Refer to sheets T1 & T2 for Typical Details.

STATE OF HAWAII
DEPARTMENT OF TRANSPORTATION
HIGHWAYS DIVISION




**REHABILITATION & REPAIRS
TO KAHAWAILIILII BRIDGE**

PROJ. No 19 GHK-01-73 Nov. 1973
SHEET No. 1 OF 3 SHEETS

FED. ROAD DIST. NO.	STATE	FED. AID PROJ. NO.	FISCAL YEAR	SHEET NO.	TOTAL SHEETS
HAWAII	HAW.	19 GHK-01-73	1973	6	39

SUMMARY:

Abutment No. 2:	22.0	L.F.
" " 1:	8.0	L.F.
"G-4" (Mountain Side):	297.7	L.F.
"G-1" (Ocean Side):	195.5	L.F.
(Sealing) Total:	523.2	L.F.
(Spalls) Total:	40.4	SQ. FT.

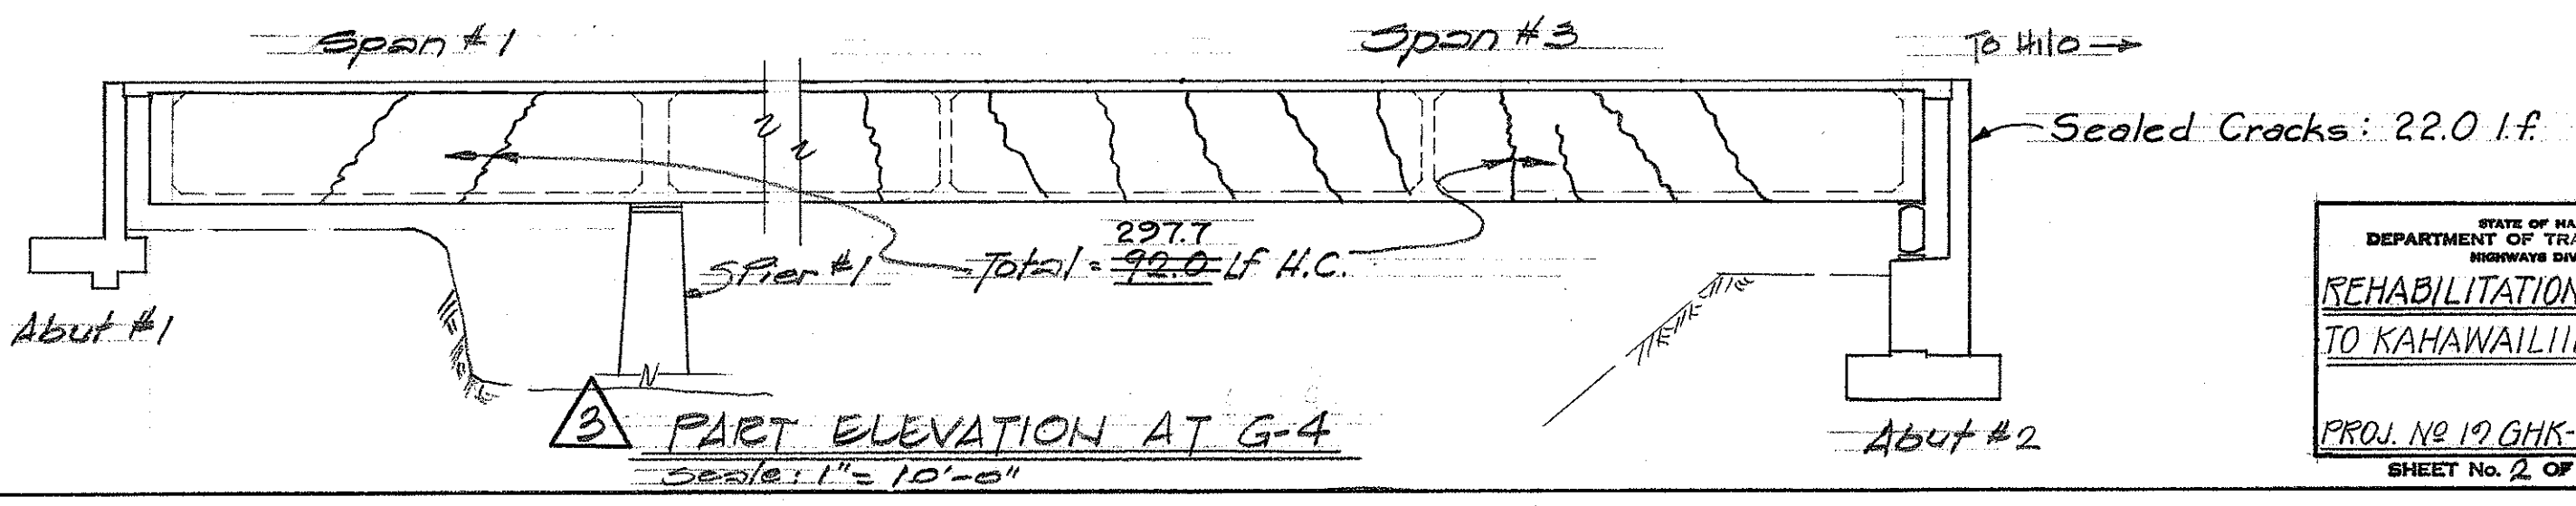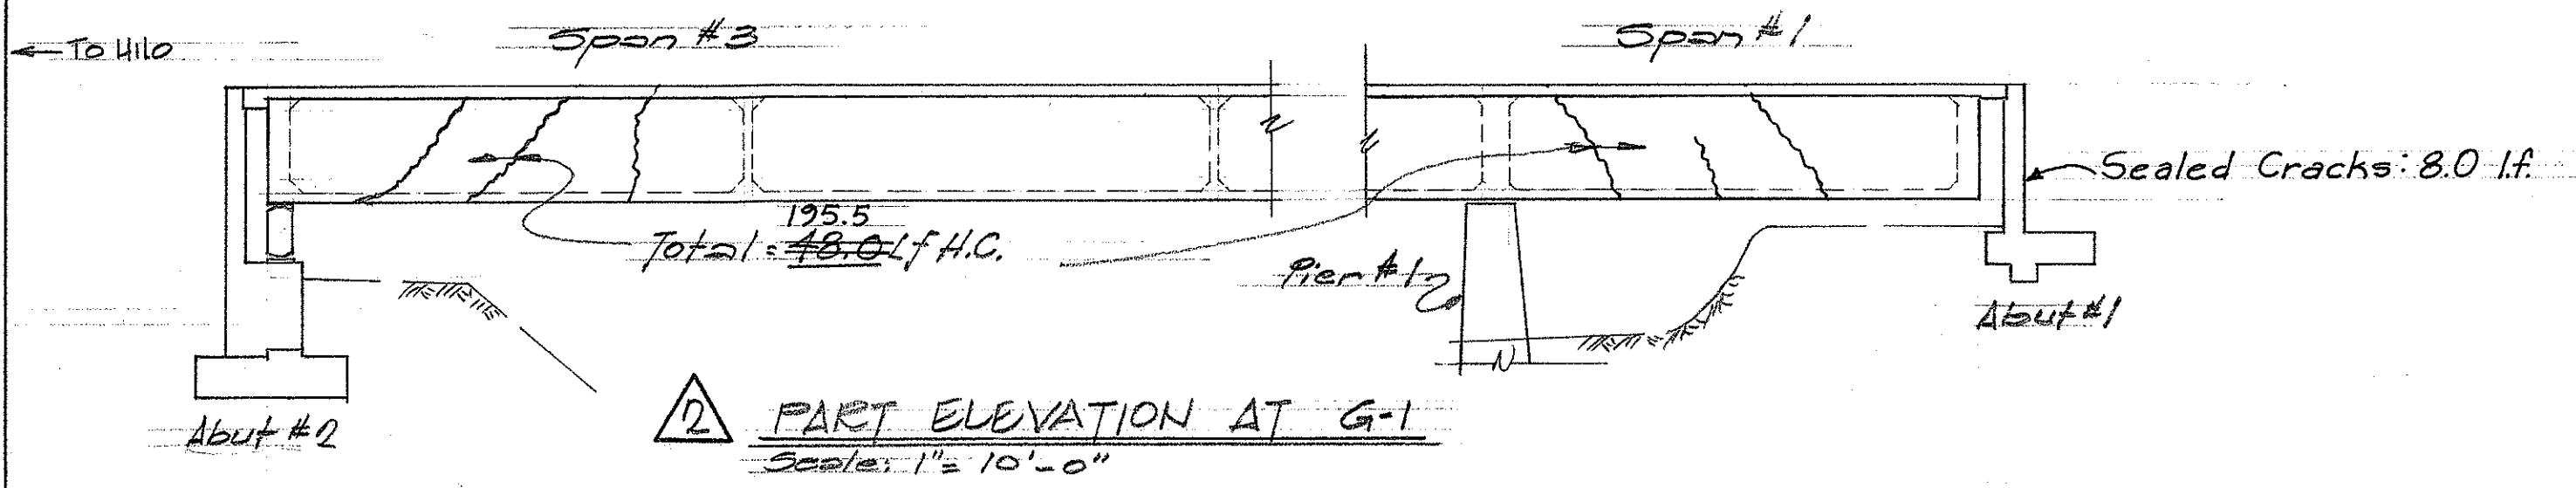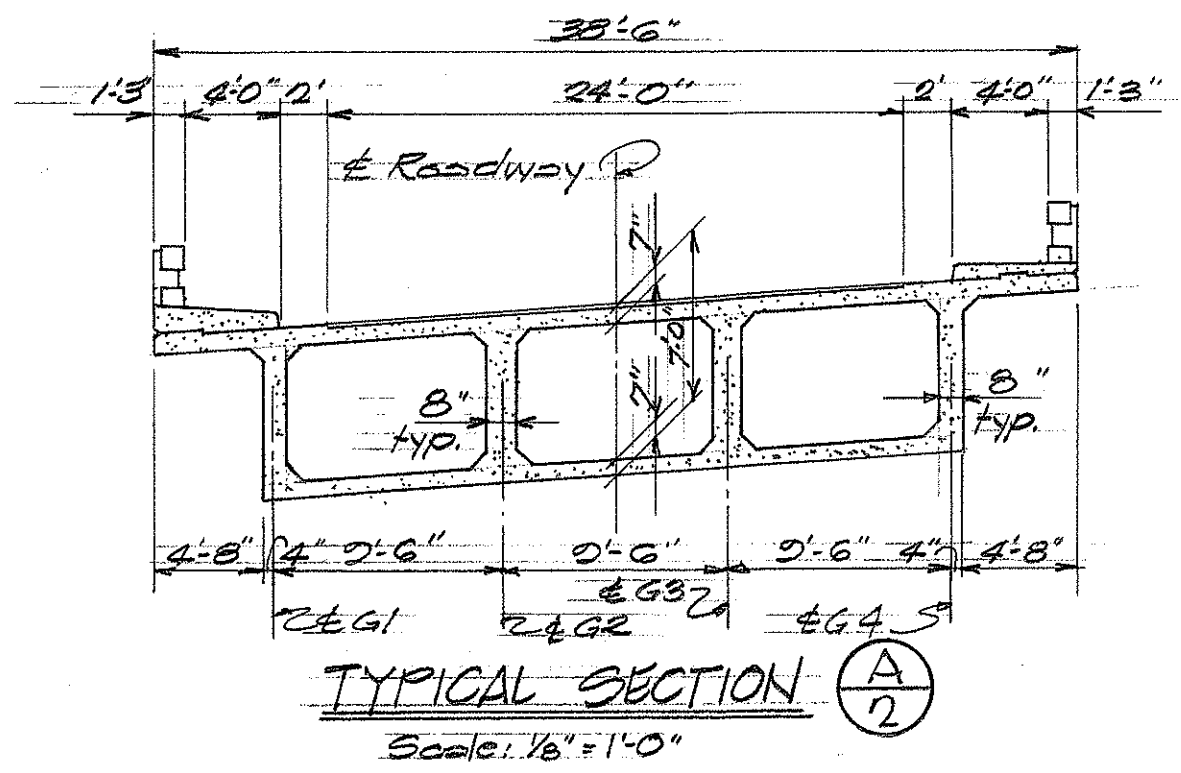


STATE OF HAWAII
DEPARTMENT OF TRANSPORTATION
HIGHWAYS DIVISION

**REHABILITATION & REPAIRS
TO KAHAWAILIILI BRIDGE**


PROJ. No 19 GHK-01-73 Nov. 1973
SHEET No. 2 OF 3 SHEETS

DATE: _____
SURVEY PLOTTED BY: _____
DRAWN BY: _____
CHECKED BY: _____
NOTE BOOK: _____

FED. ROAD DIST. NO.	STATE	PROJ. NO.	FISCAL YEAR	SHEET NO.	TOTAL SHEETS
HAWAII	HAW.	19 GHK-01-73	1973	7	39

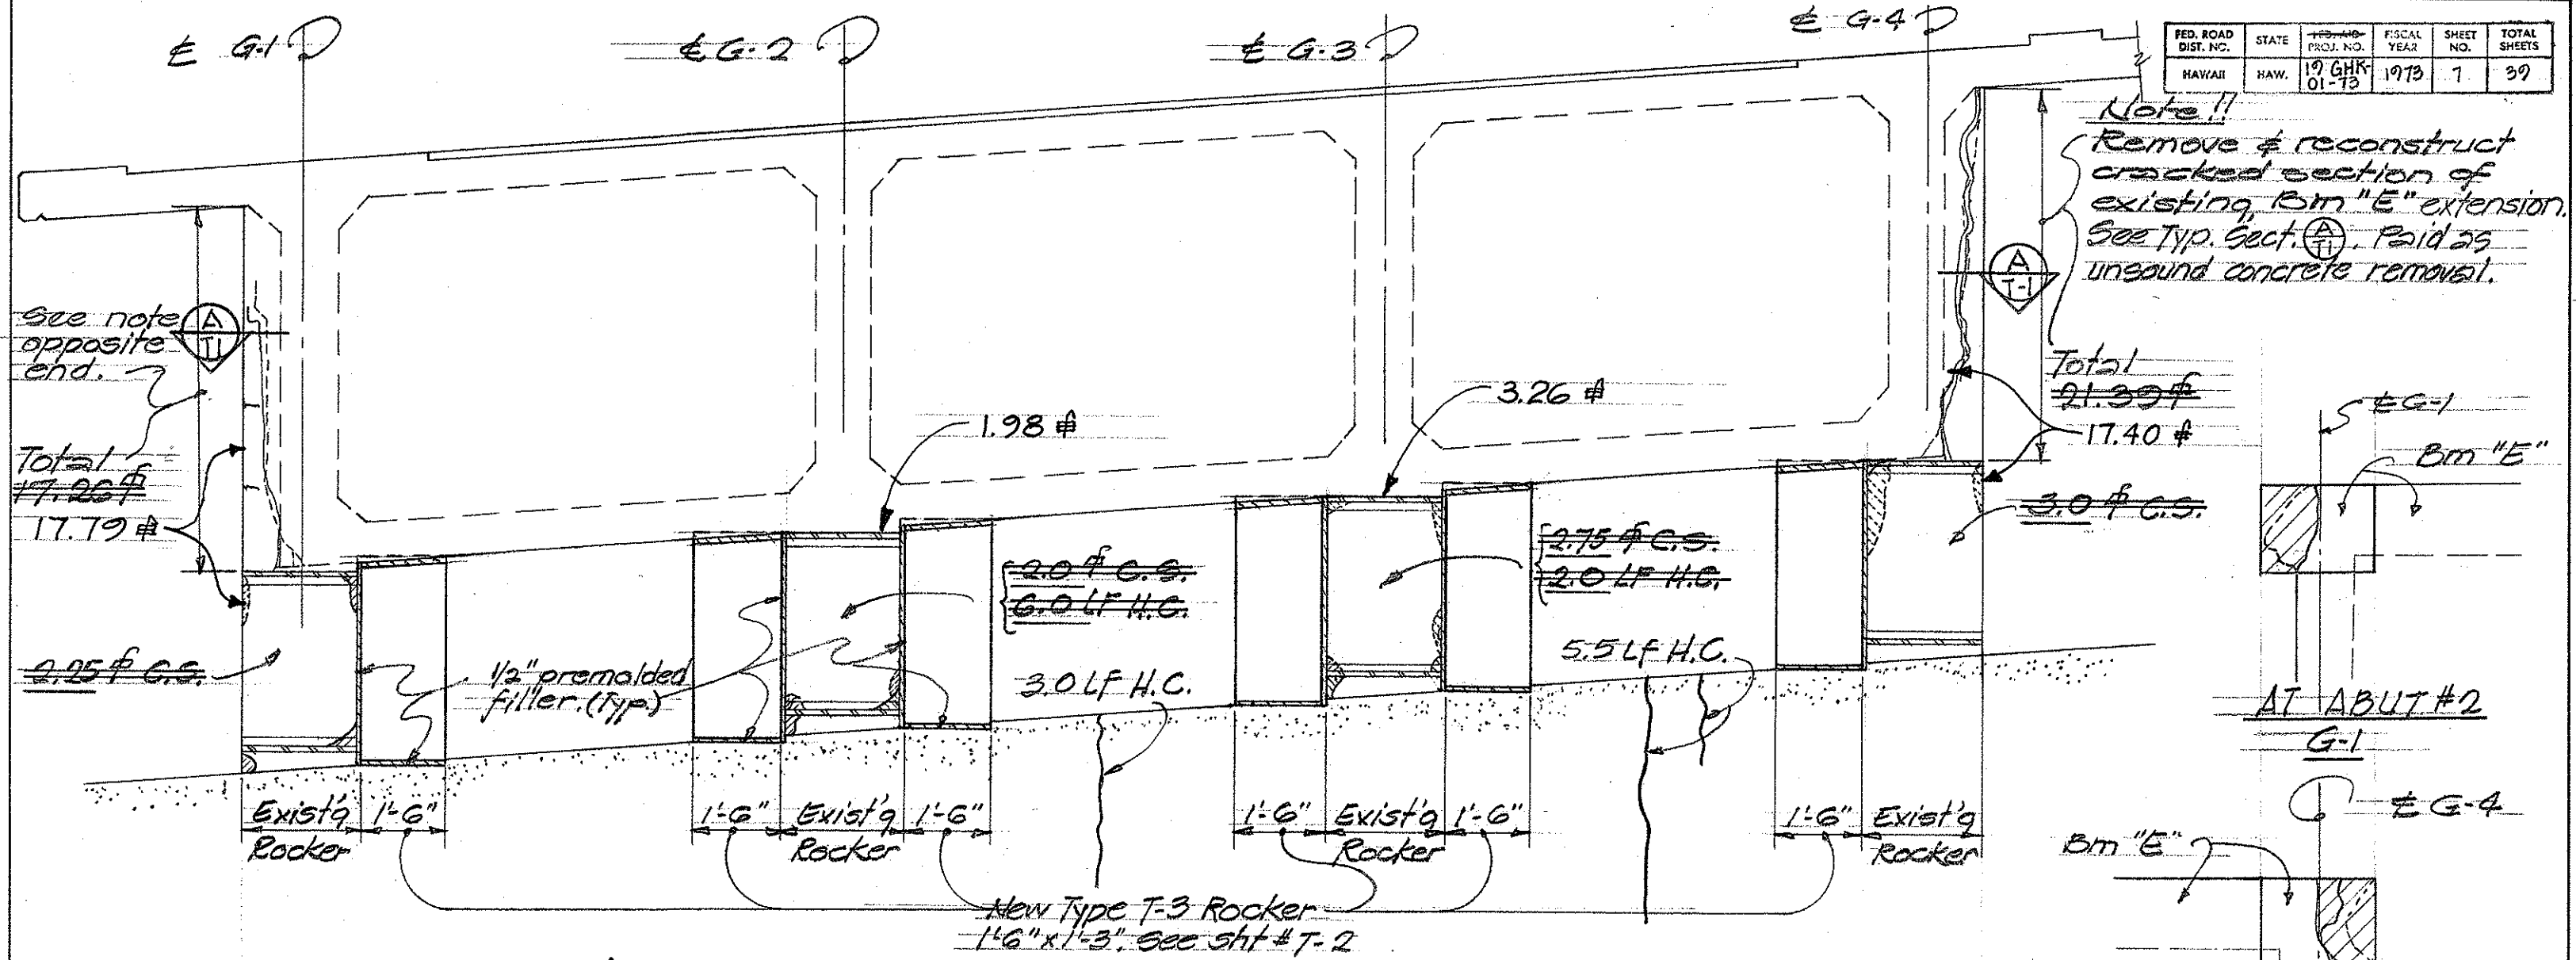

ELEV. ~ BEAM "E" AT ABUT. #2
Scale: $3/8" = 1'-0"$

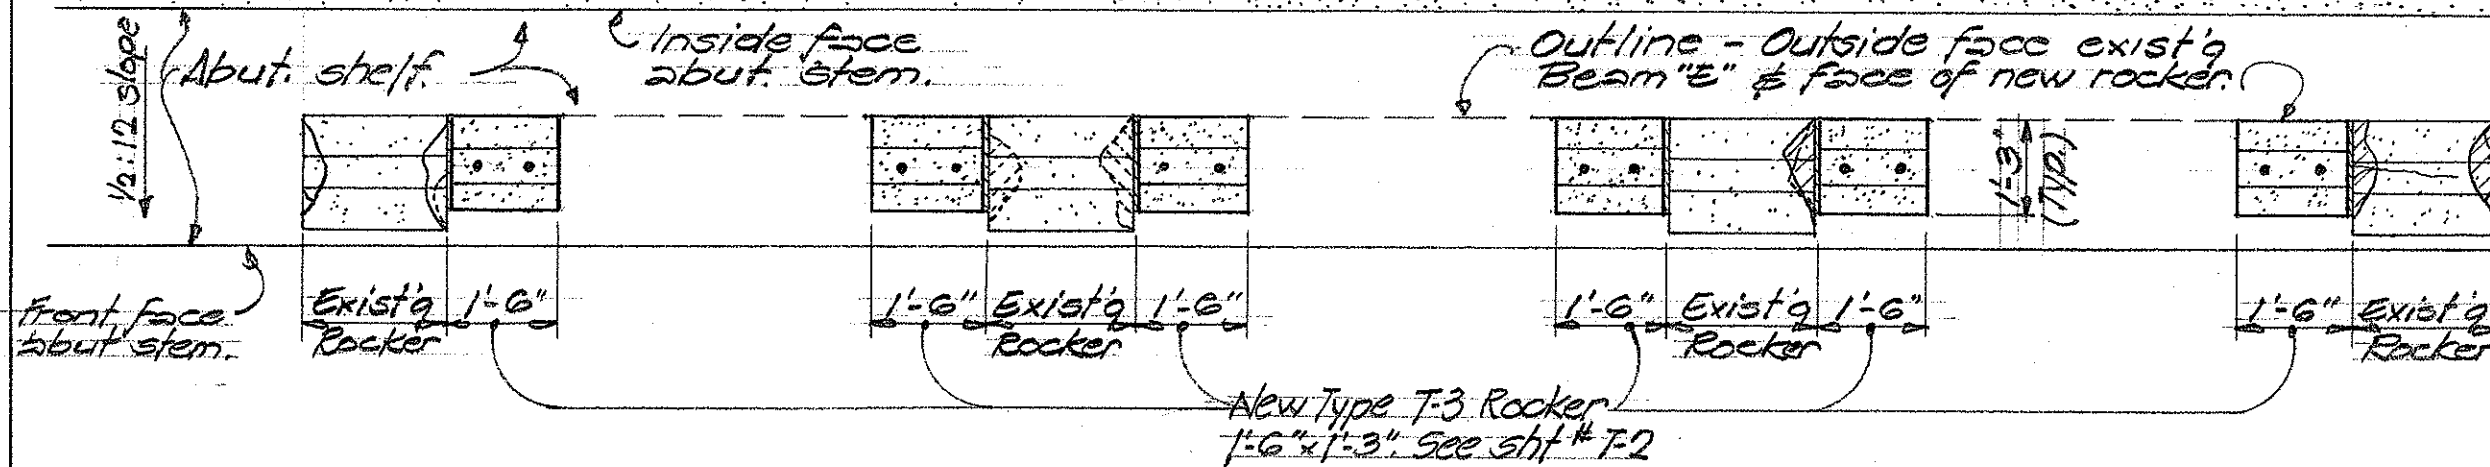

TOP PLAN ~ CONCRETE ROCKER
Scale: $3/8" = 1'-0"$

PART DECK REFLECTED CEILING PLAN
Scale: $3/8" = 1'-0"$

STATE OF HAWAII
DEPARTMENT OF TRANSPORTATION
HIGHWAYS DIVISION
**REHABILITATION & REPAIRS
TO KAHAWAILIILI BRIDGE**
PROJ. No. 19 GHK-01-73 Nov. 1973
SHEET No. 3 OF 3 SHEETS

DATE: _____
SURVEY PLOTTED BY: _____
DRAWN BY: _____
CHECKED BY: _____
ORIGINAL PLAN
NOTES BOOK