




FED. ROAD DIST. NO.	STATE	FED. AID PROJ. NO.	FISCAL YEAR	SHEET NO.	TOTAL SHEETS
HAWAII	HAW.	19 GHK 01-73	1973	34	39

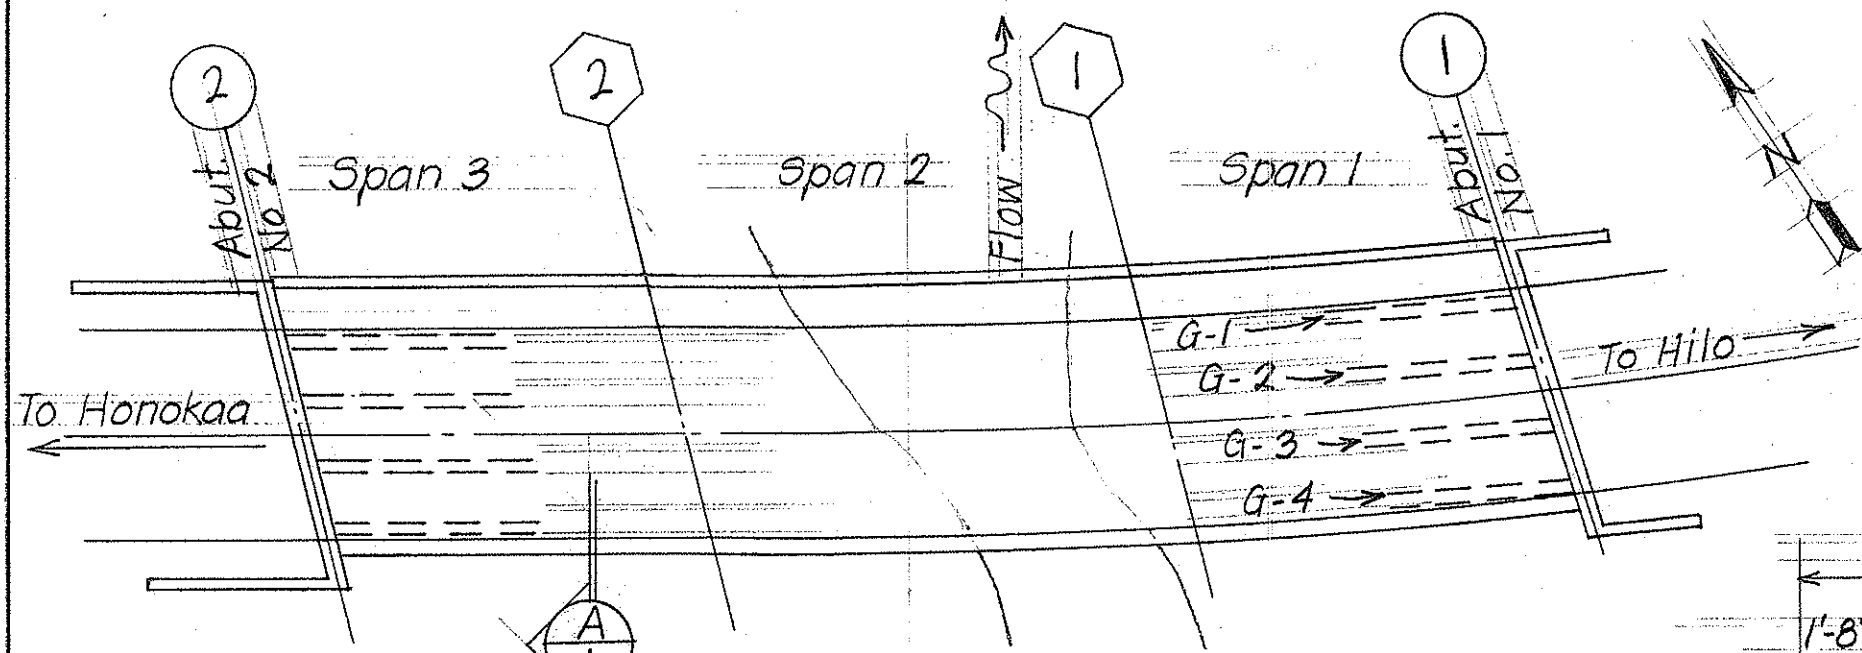

LAYOUT PLAN
Scale : 1" = 20'-0"

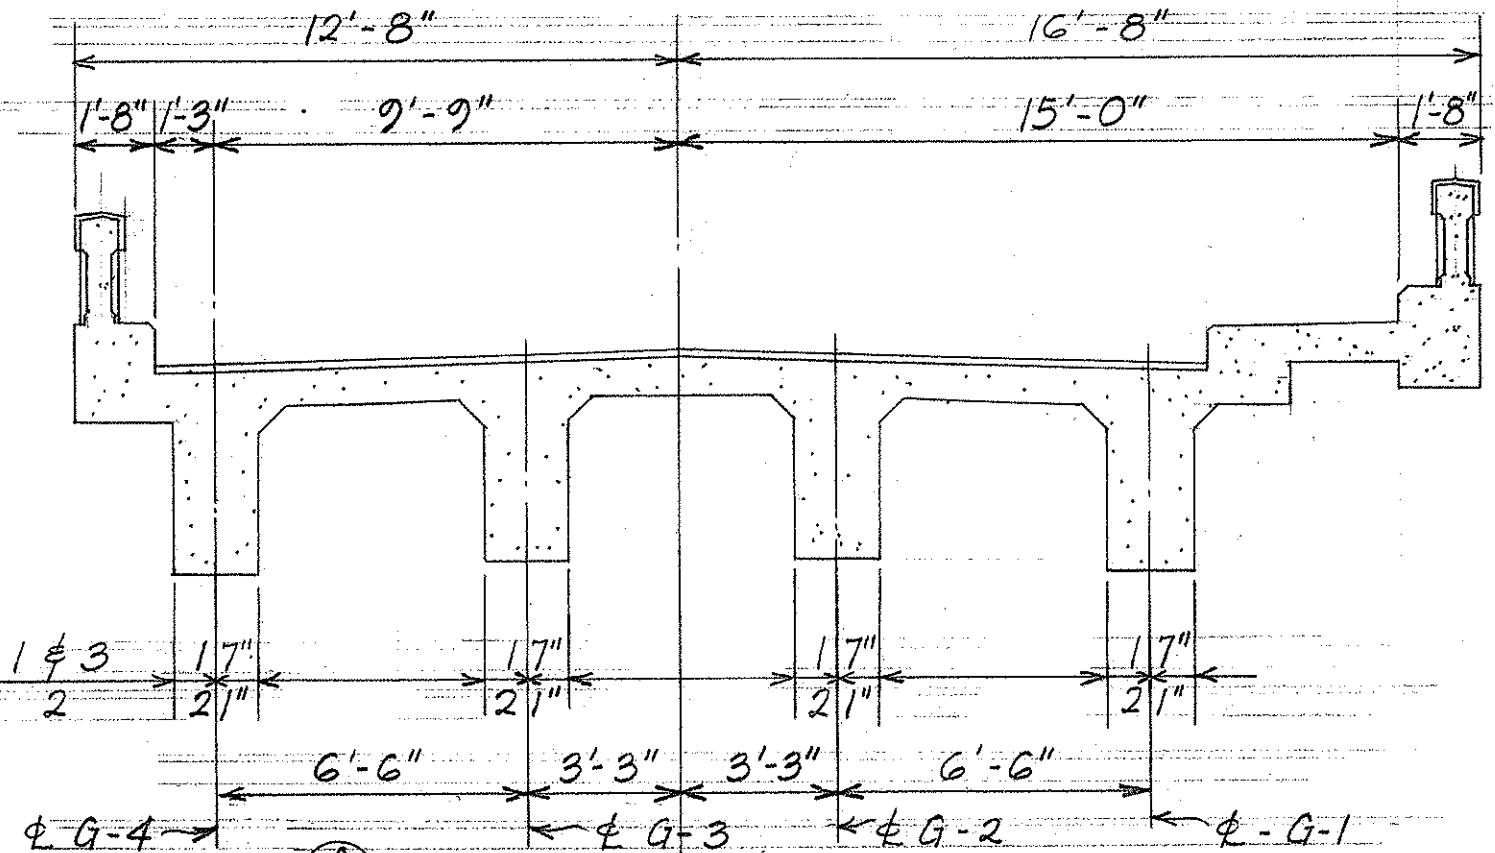

NORMAL DECK SECTION
Scale : 1/4" = 1'-0"

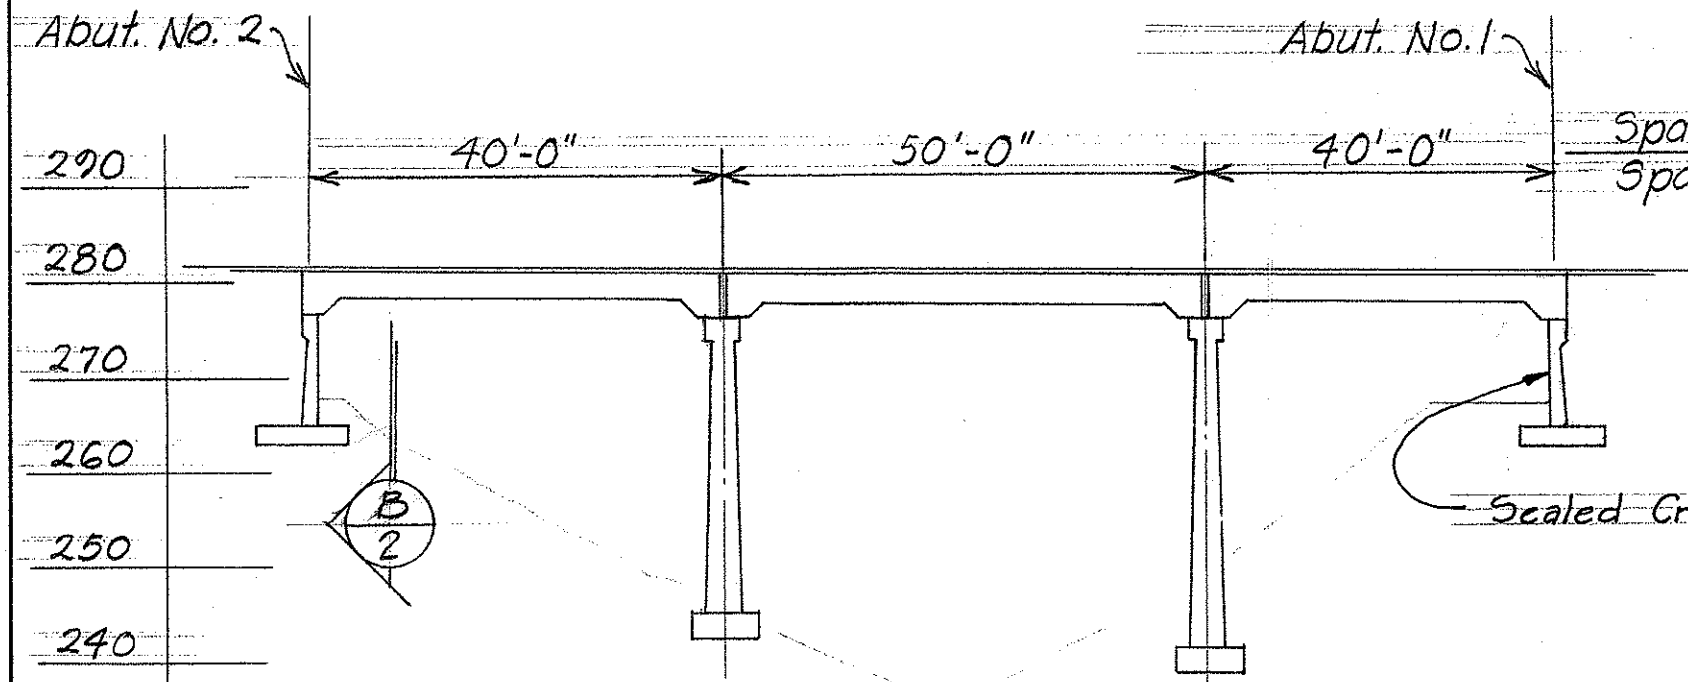

LONGITUDINAL SECTION
Scale : 1" = 20'-0"

Scaled Cracks : 56.0 L.F.

Reference Note: Refer to sheet T1 for Typical Details.


STATE OF HAWAII
DEPARTMENT OF TRANSPORTATION
HIGHWAYS DIVISION

**REHABILITATION & REPAIRS
TO KAPEHU BRIDGE**

PROJ. No 19 GHK-01-73 Nov. 1973
SHEET No. 1 OF 2 SHEETS

DESIGNED BY	DATE
DRAWN BY	
CHECKED BY	
NOTED BY	
APPROVED BY	

FED. ROAD DIST. NO.	STATE	FED. AID PROJ. NO.	FISCAL YEAR	SHEET NO.	TOTAL SHEETS
HAWAII	HAW.	19 GHK 01-73	1973	35	37

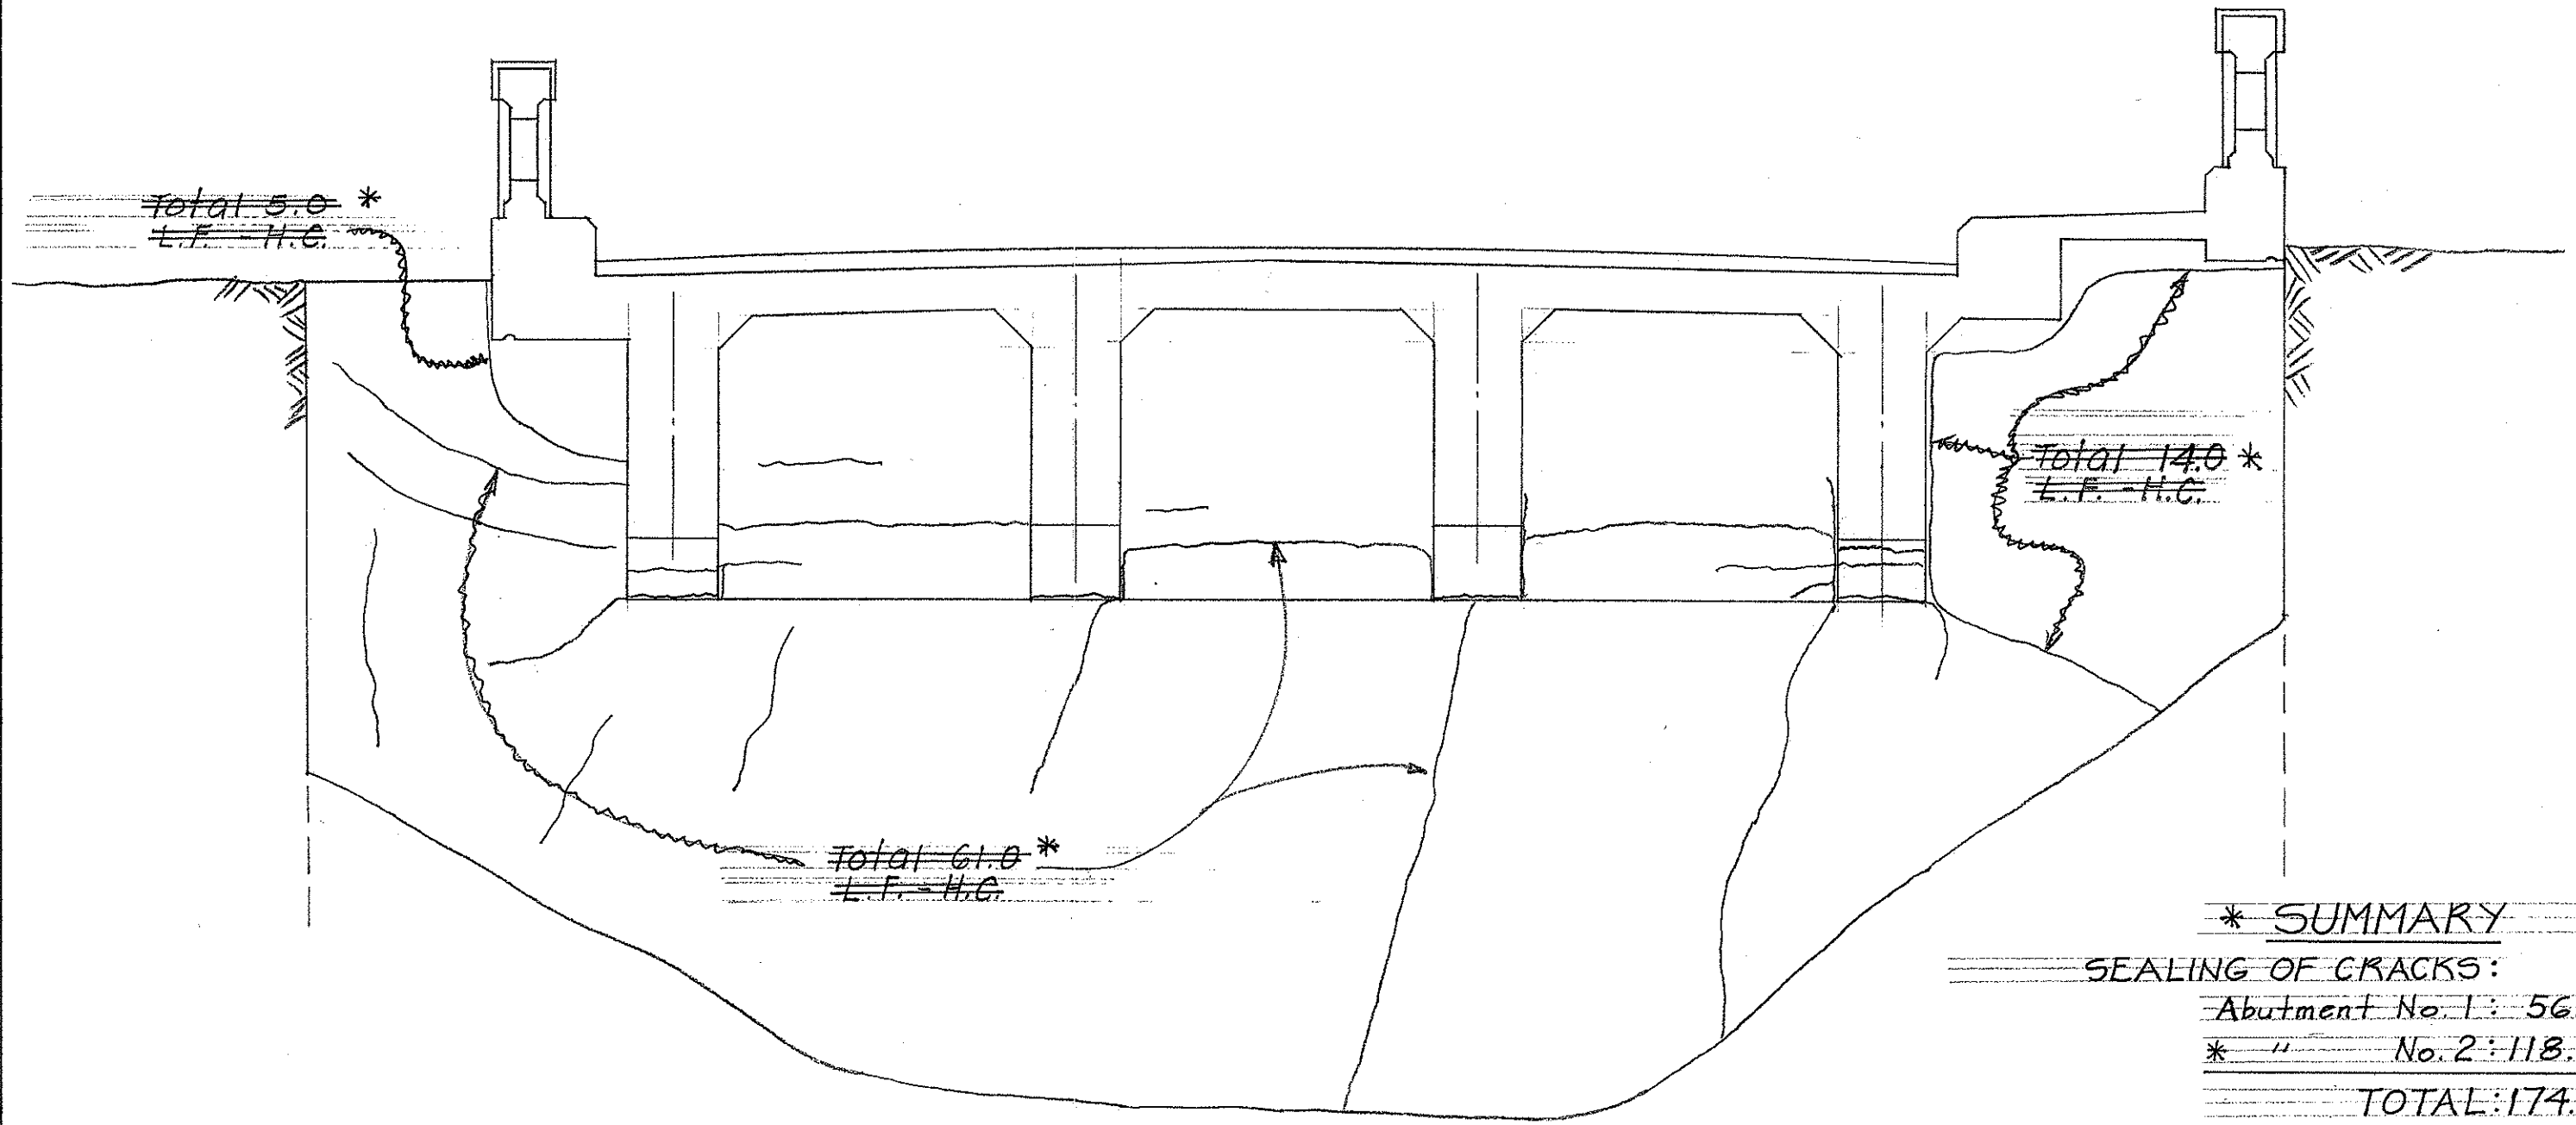

* SUMMARY

SEALING OF CRACKS:

Abutment No. 1: 56.0 L.F.

* " No. 2: 118.0 L.F.

TOTAL: 174.0 L.F.

(B/2)

ELEVATION ABUTMENT NO. 2

Scale: 3/8" = 1'-0"

DESIGNED BY	DATE
DRAWN BY	DATE
CHECKED BY	DATE
NOTED BY	DATE

STATE OF HAWAII
DEPARTMENT OF TRANSPORTATION
HIGHWAYS DIVISION

REHABILITATION & REPAIRS
TO KAPEHU BRIDGE

PROJ. No. 19 GHK 01-73 Nov. 1973

SHEET No. 2 OF 2 SHEETS