
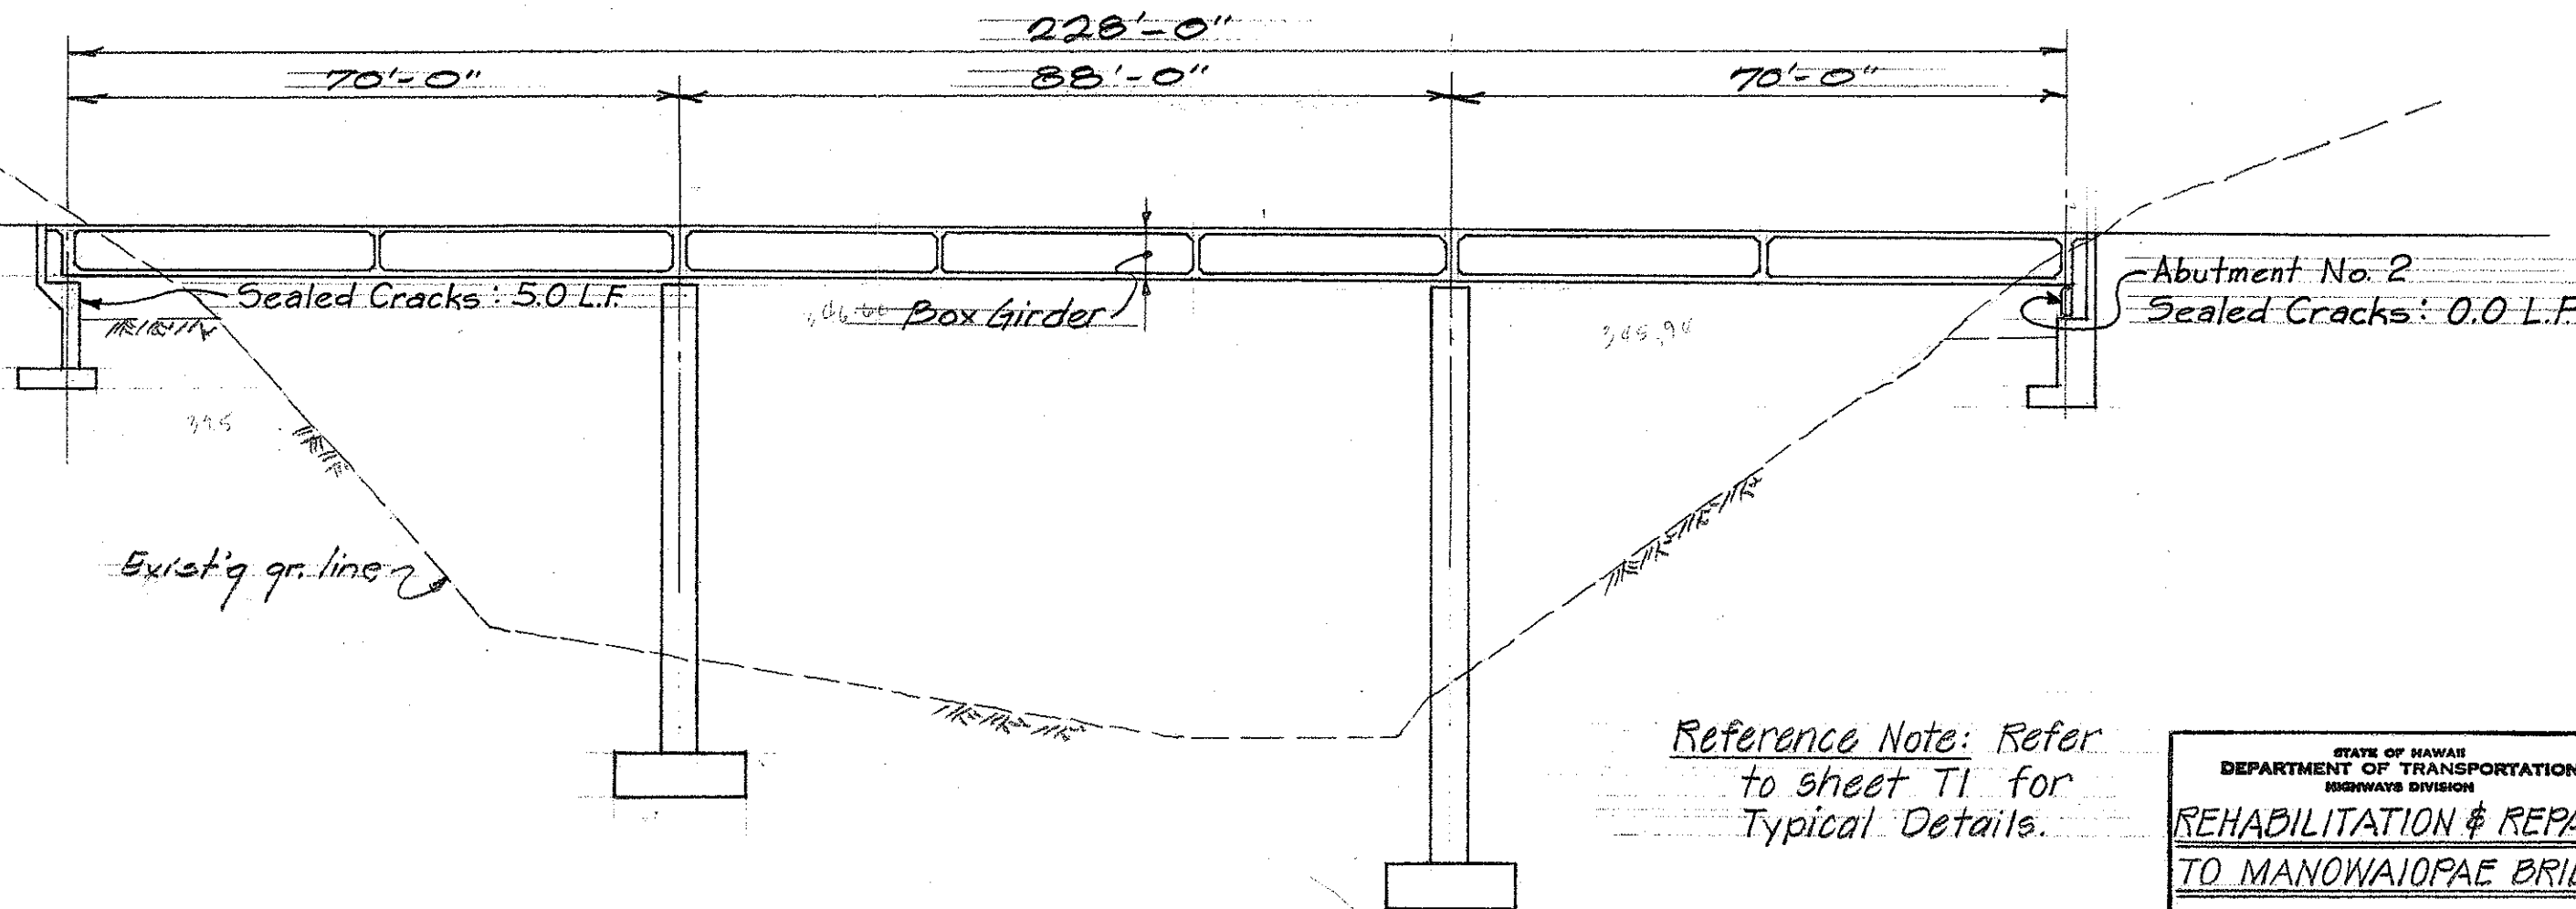


FED. ROAD DIST. NO.	STATE	FED-AID PROJ. NO.	FISCAL YEAR	SHEET NO.	TOTAL SHEETS
HAWAII	HAW.	19 GHK-01-73	1973	25	39

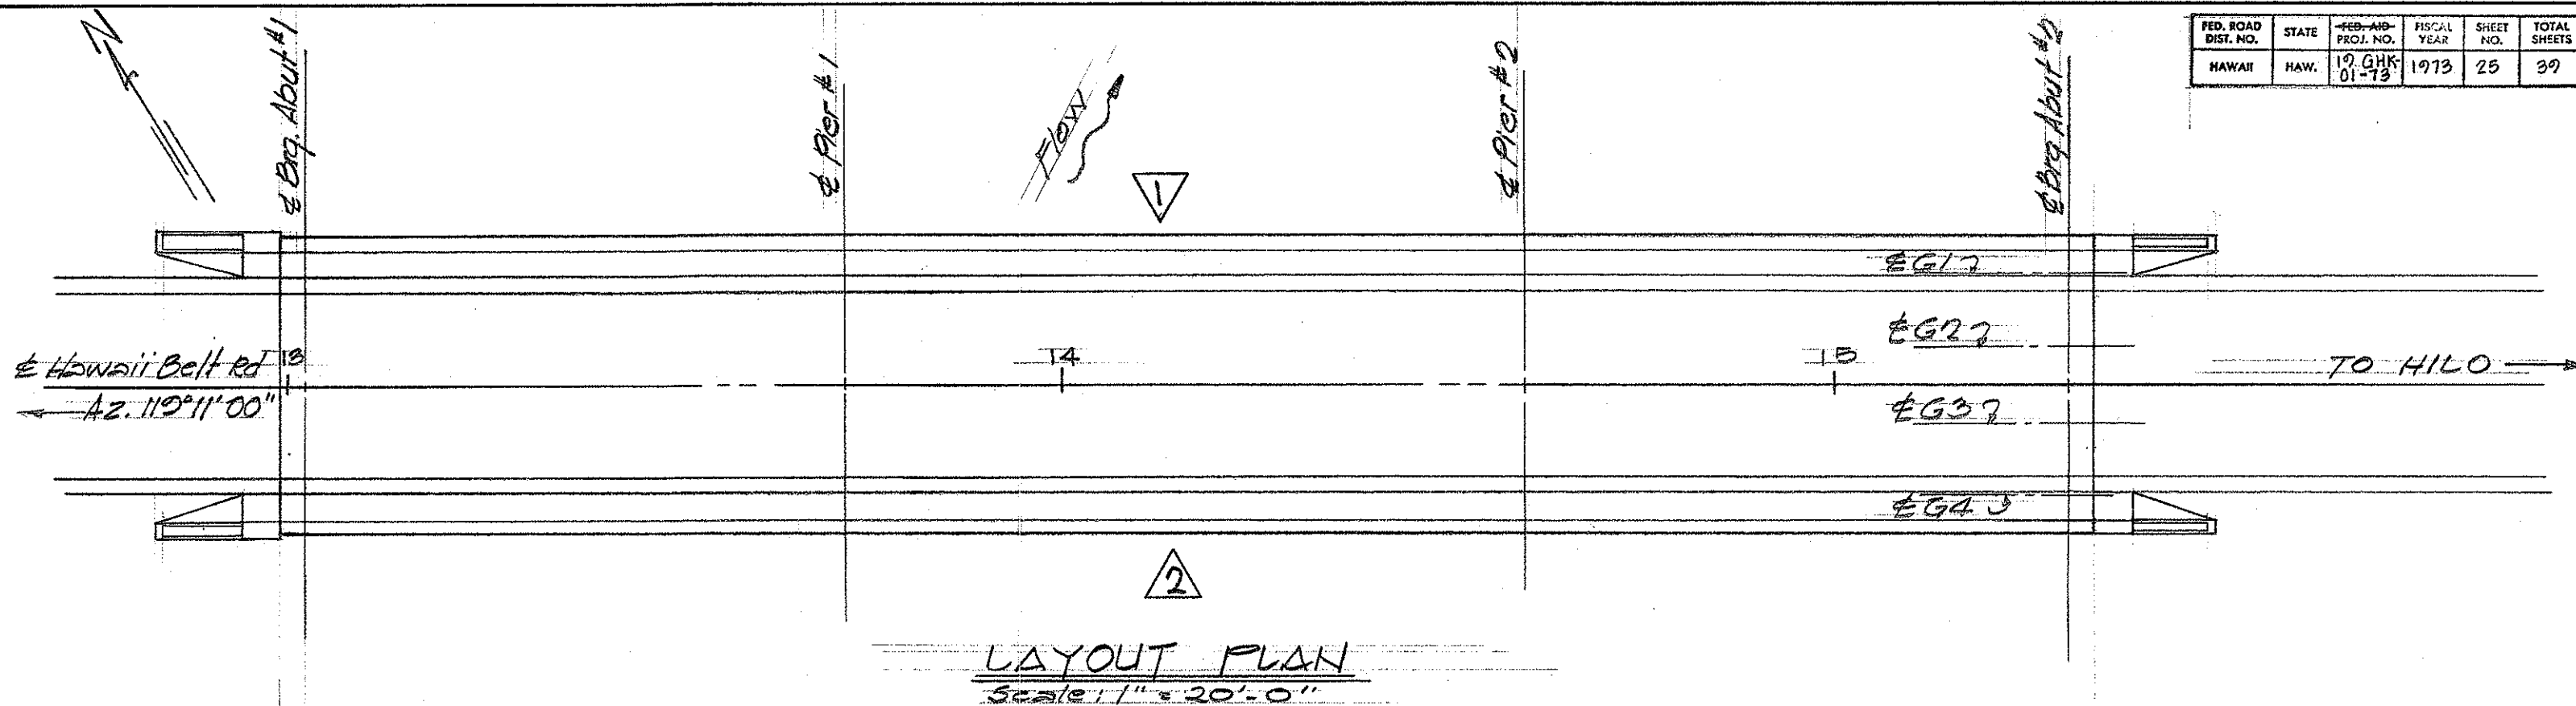

SURVEY PLOTTED BY	DATE
DRAWN BY	
CHECKED BY	
QUANTITIES BY	
NOTES BY	
CHECKED BY	

STATE OF HAWAII
DEPARTMENT OF TRANSPORTATION
HIGHWAYS DIVISION

**REHABILITATION & REPAIRS
TO MANOWAIOPAE BRIDGE**

PROJ. No 19 GHK-01-73 Nov. 1973
SHEET No. 1 OF 2 SHEETS

