




FED. ROAD DIST. NO.	STATE	FED. AID PROJ. NO.	FISCAL YEAR	SHEET NO.	TOTAL SHEETS
HAWAII	HAW.	19 GHK-01-13	1973	33	39

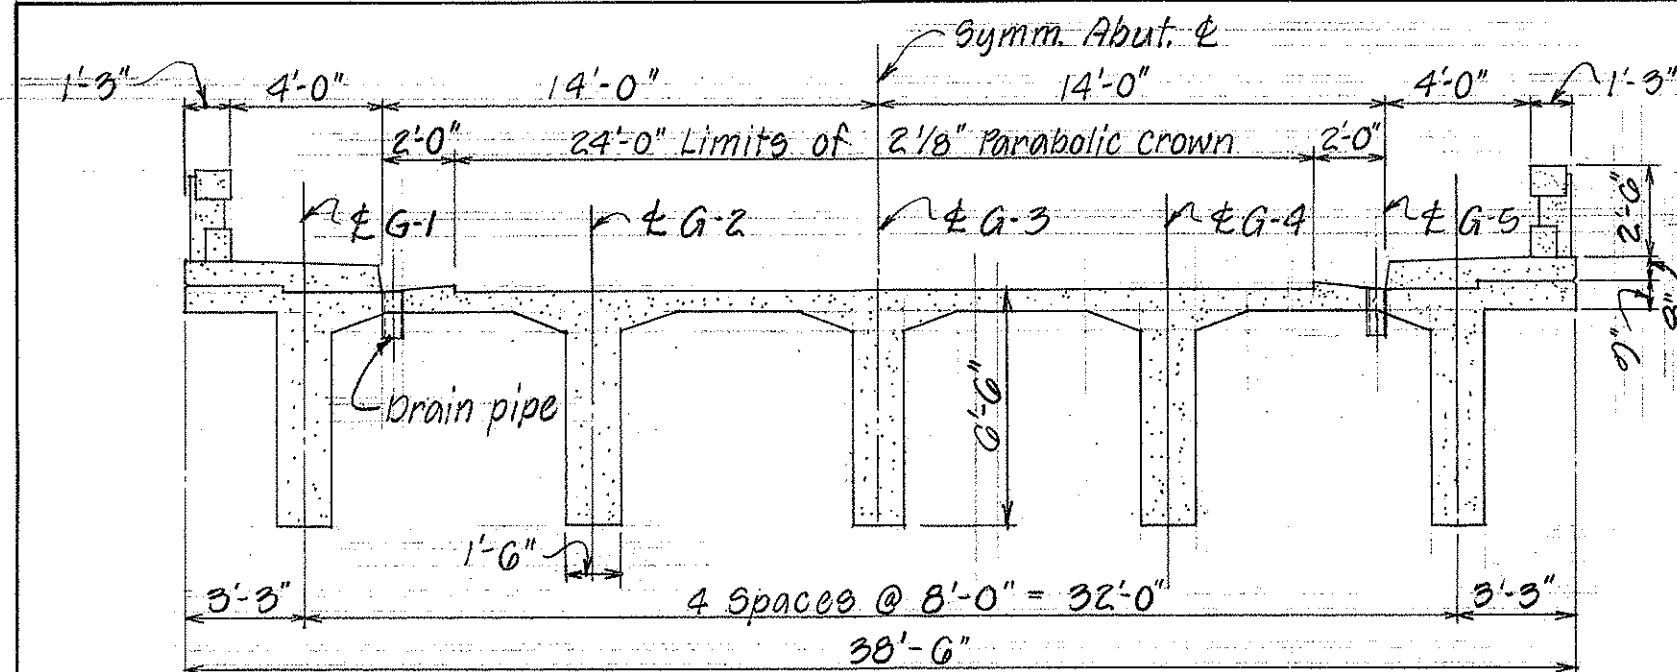

NORMAL SECTION
Scale: 3/8" = 1'-0"

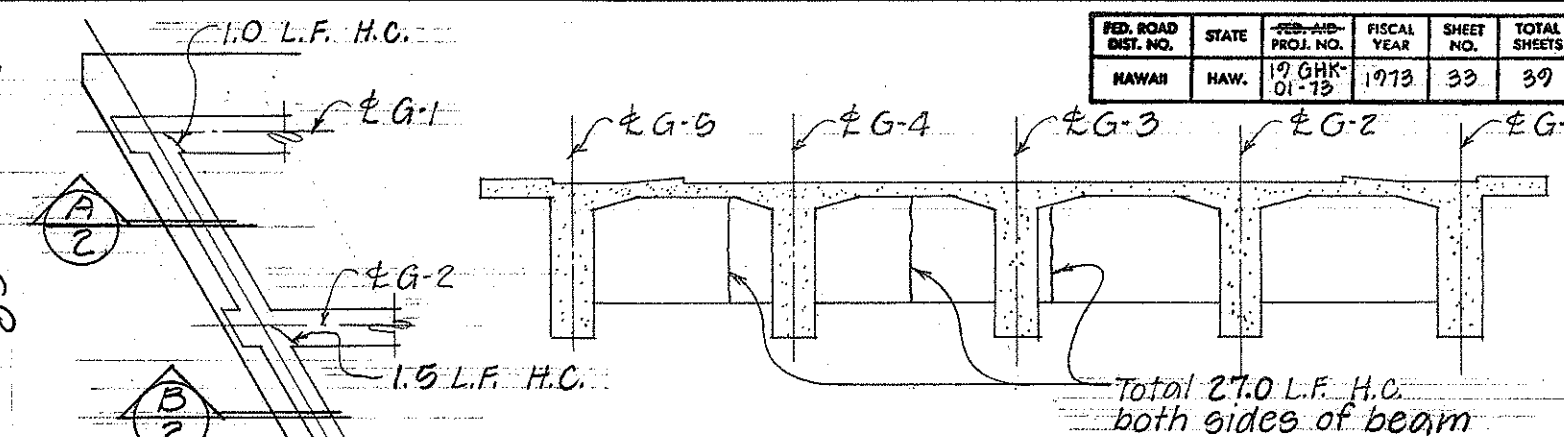


ELEV. BEAM "A" AT ABUT. #1
Scale: 1/8" = 1'-0"

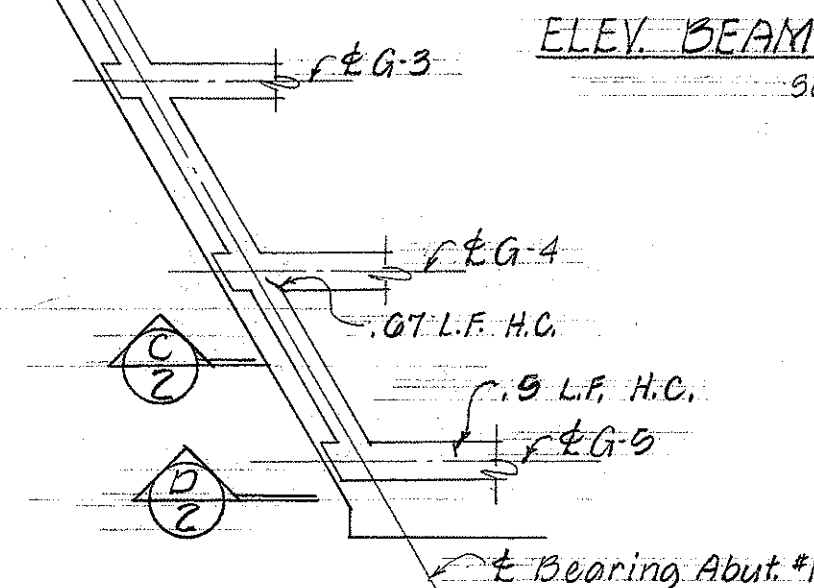


REFLECTED CEILING PLAN - ABUT. #1
Scale: 1/8" = 1'-0"


Note: All hairline cracks shown on this page were sealed with epoxy. The corrected Quantity is shown in the Summary on page 32.

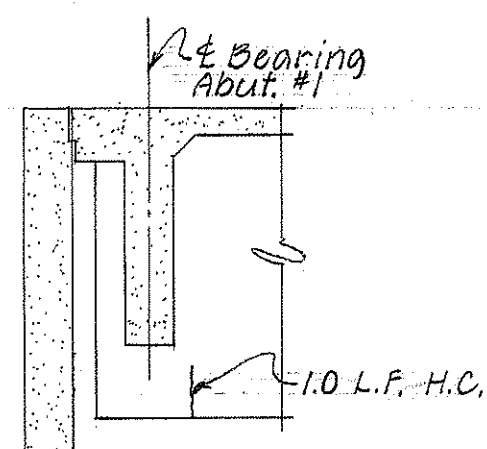


ELEV. (A/2) G-1

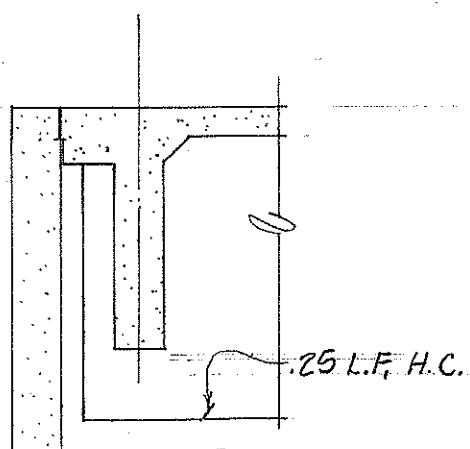


ELEV. (B/2) G-2

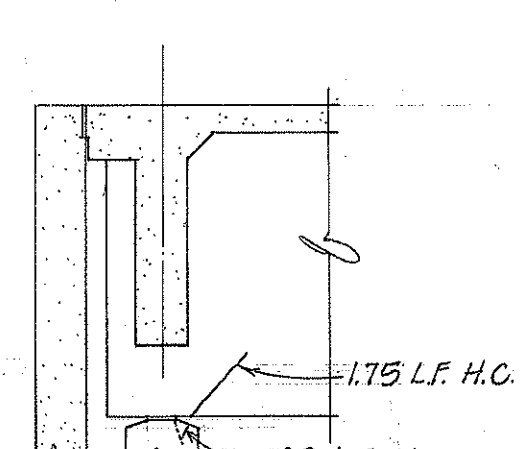


ELEV. (C/2) G-4

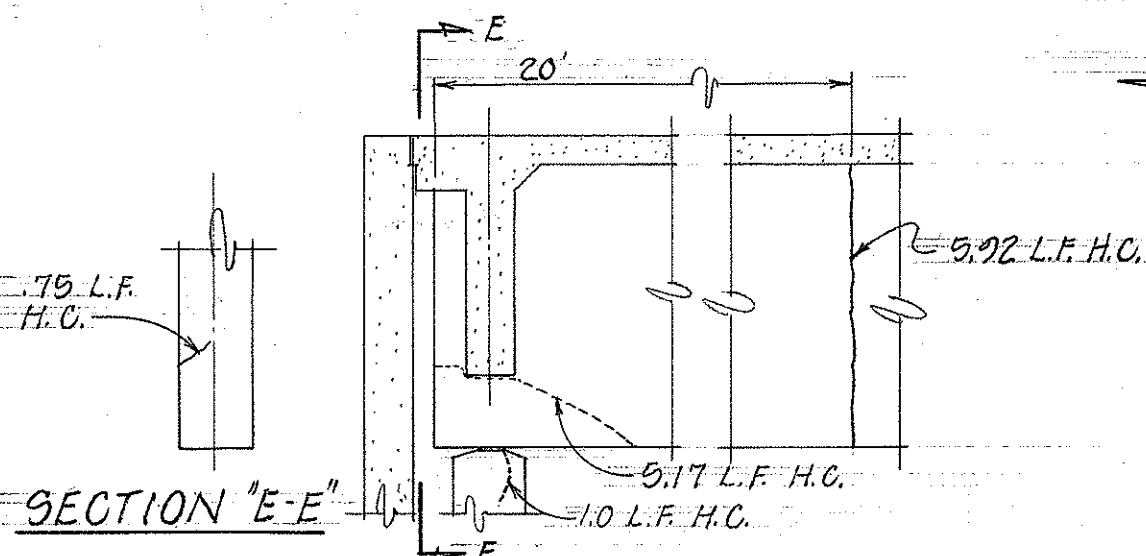

SECTION "E-E"

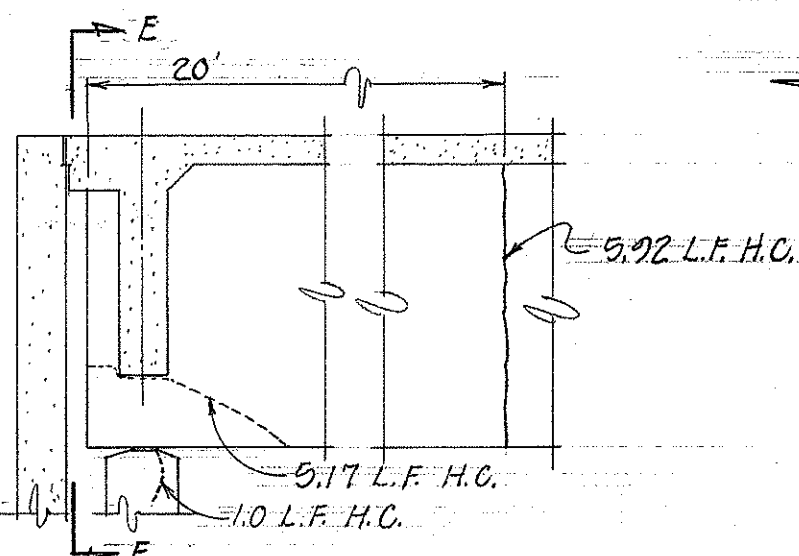

ELEV. (D/2) G-5

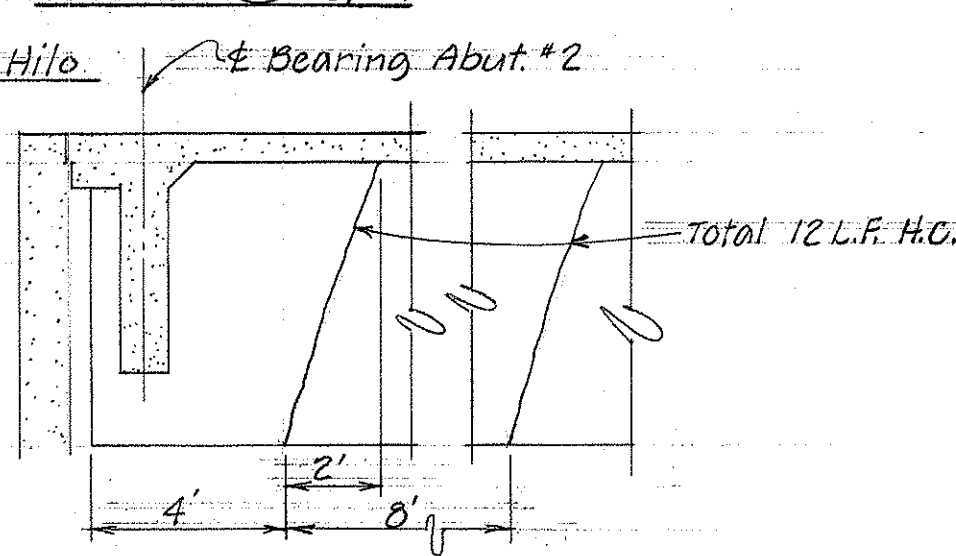

ELEV. (E/2) G-1

STATE OF HAWAII
DEPARTMENT OF TRANSPORTATION
HIGHWAYS DIVISION
**REHABILITATION & REPAIRS
TO MOANALULU BRIDGE**
PROJ. NO. 19 GHK-01-13 Nov. 1973
SHEET No. 2 OF 2 SHEETS