
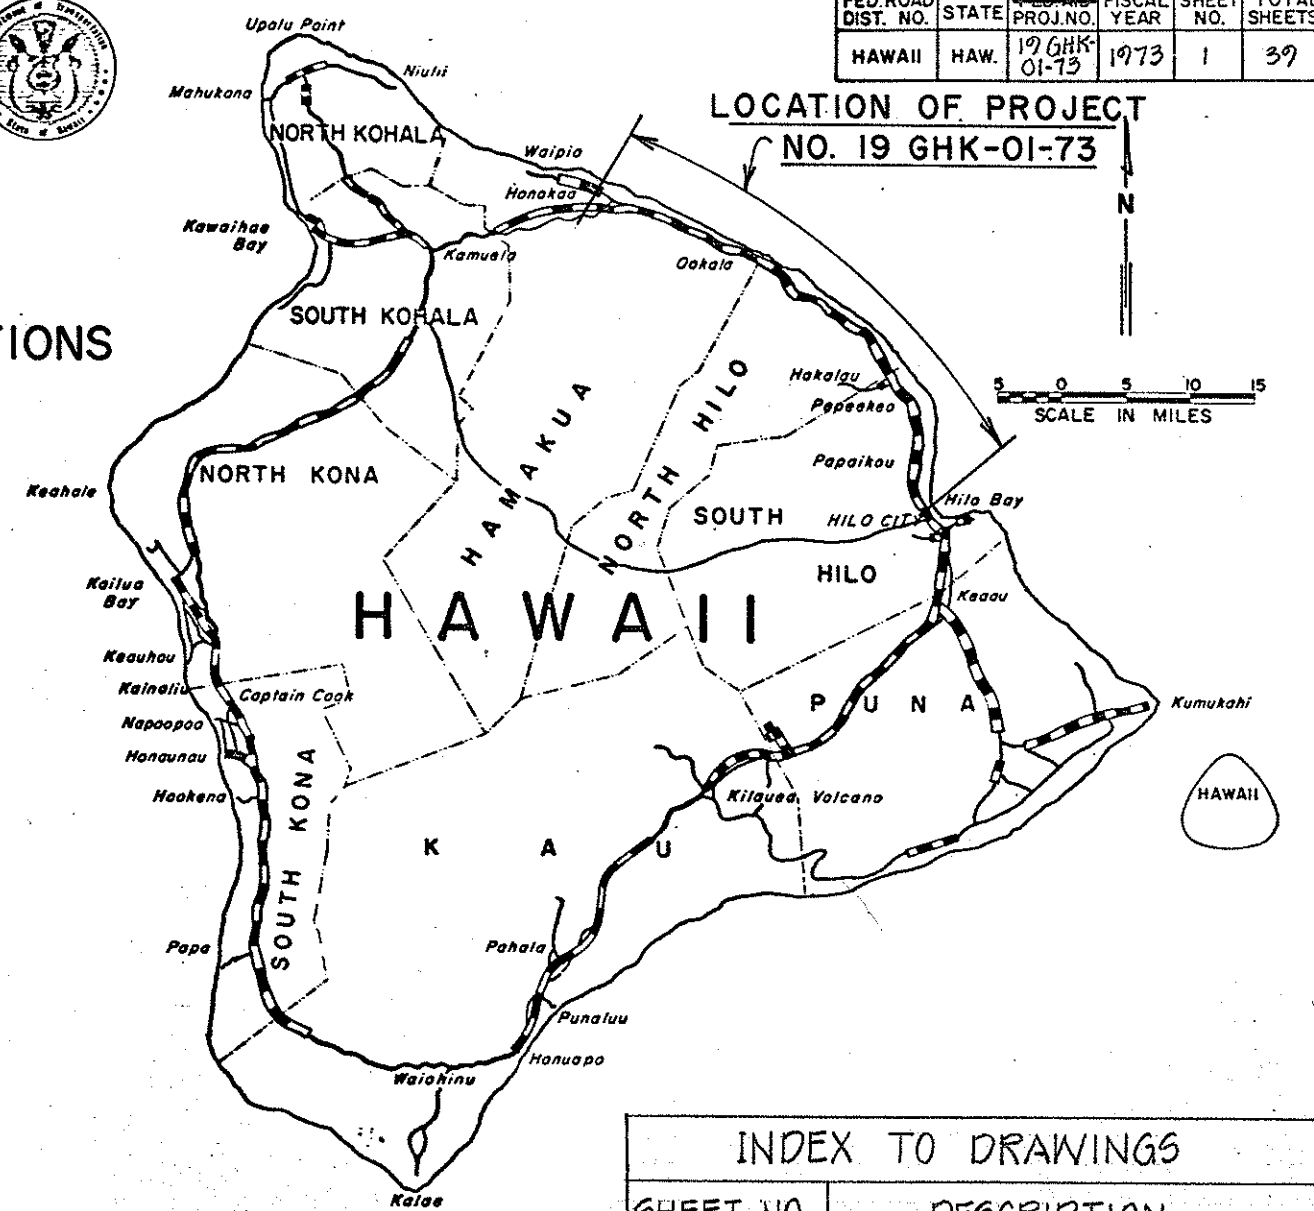


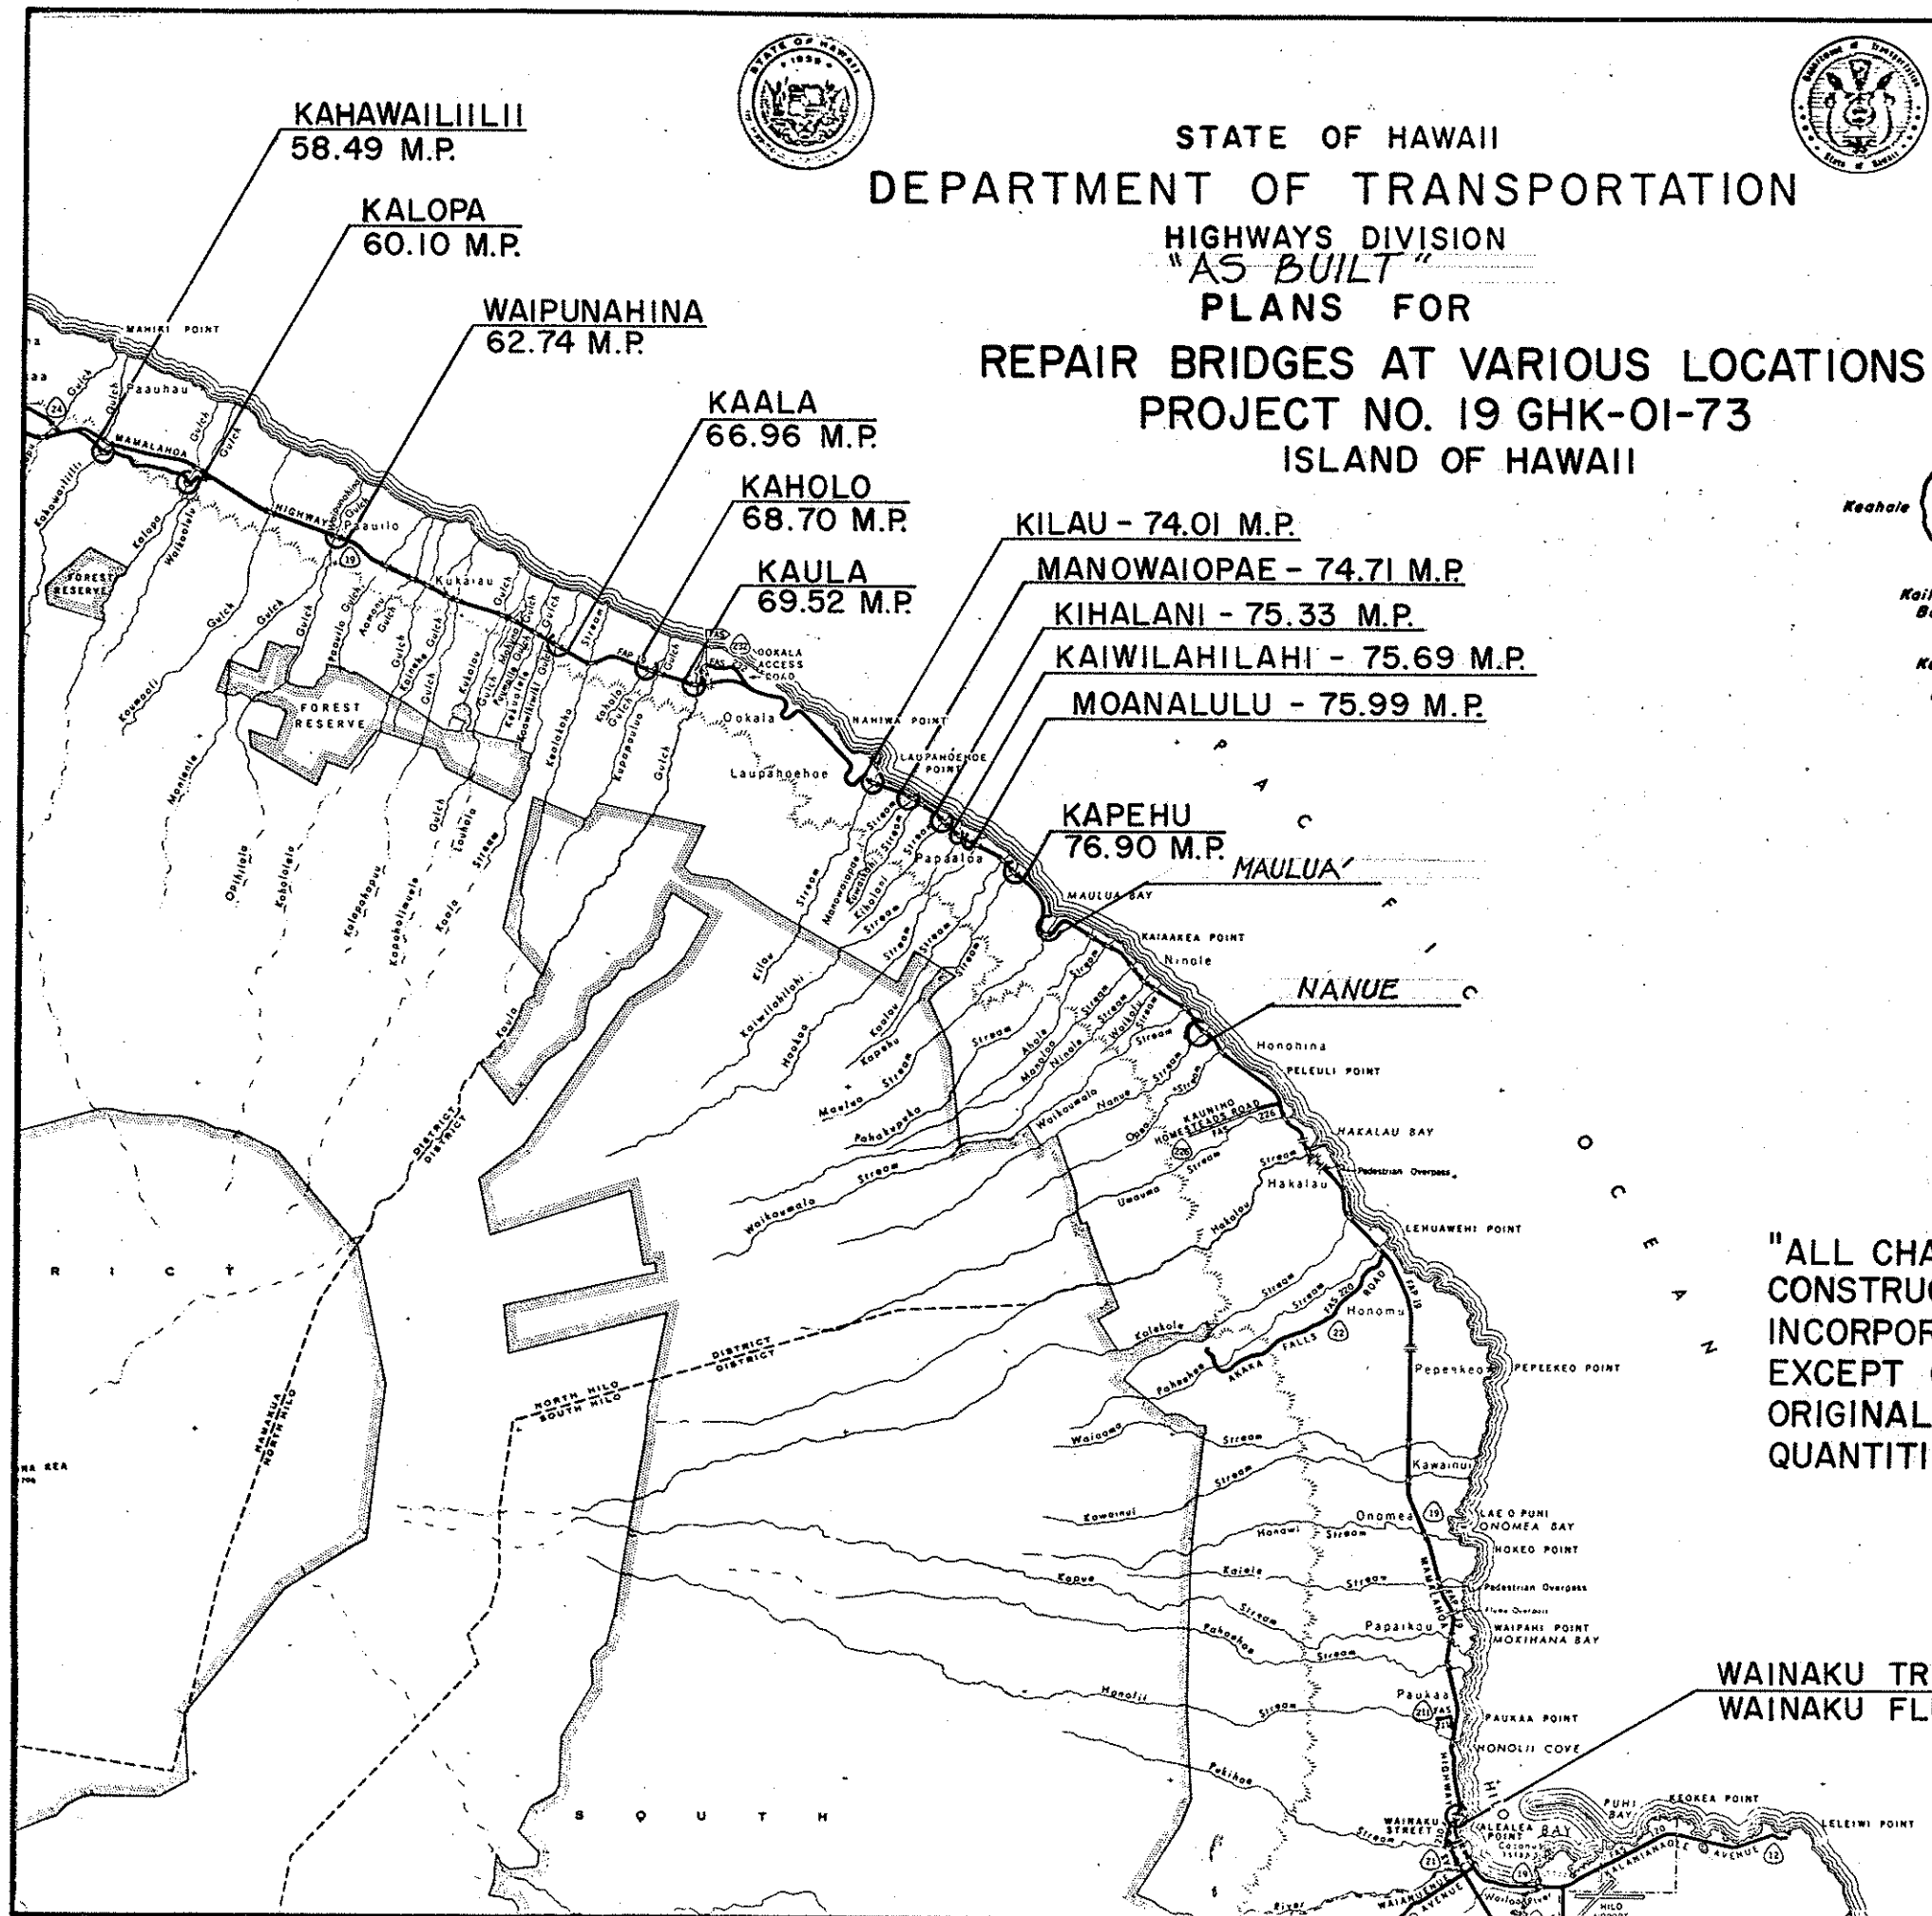

FED. ROAD DIST. NO.	STATE	FED. PROJ. NO.	FISCAL YEAR	SHEET NO.	TOTAL SHEETS
HAWAII	HAW.	19 GHK-01-73	1973	1	39

LOCATION OF PROJECT
NO. 19 GHK-01-73

SCALE IN MILES
0 5 10 15

INDEX TO DRAWINGS	
SHEET NO.	DESCRIPTION
1	TITLE SHEET
2	ESTIMATED QUANTITIES AND INDEX TO DRAWINGS
3,4	TYPICAL DETAILS
5 TO 39	BRIDGE DETAILS - SEE INDEX, SHEET NO 2

"ALL CHANGES MADE DURING CONSTRUCTION HAVE BEEN INCORPORATED ON THESE PLANS EXCEPT CHANGES IN THE ORIGINAL THEORETICAL QUANTITIES."

Lloyd Lee
LLOYD LEE
PROJECT ENGINEER

WAINAKU TRUCK O.P. - 96.56 M.P.
WAINAKU FLUME O.P. - 96.73 M.P.

LOCATION PLAN
SCALE: 1" = 3 MI.

DEPARTMENT OF TRANSPORTATION
STATE OF HAWAII
APPROVED: *Murray Lee* 1/15/74
FOR DIR. OF TRANSPORTATION DATE