



FED. ROAD DIST. NO.	STATE	FED. AID PROJ. NO.	FISCAL YEAR	SHEET NO.	TOTAL SHEETS
HAWAII	HAW.	19 GHK-01-73	1973	39	39

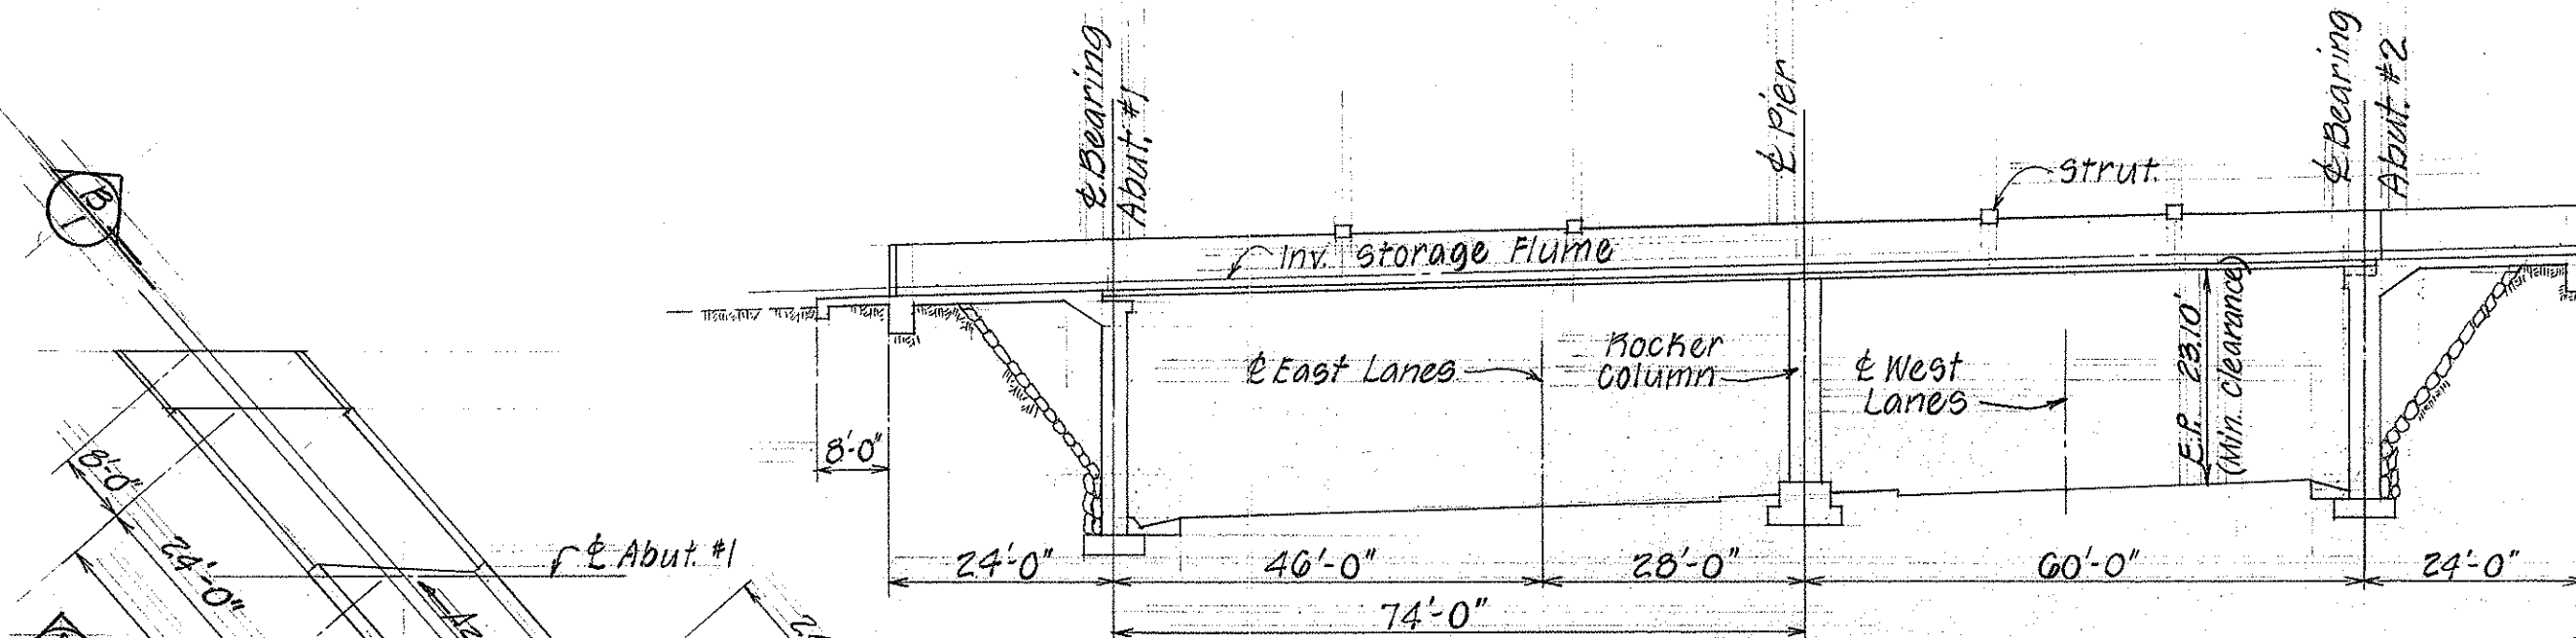


LONGITUDINAL SECTION (B)
Scale: 1" = 20'


SUMMARY
SEALING OF CRACKS:
Abutment No. 1: 30.0 L.F.

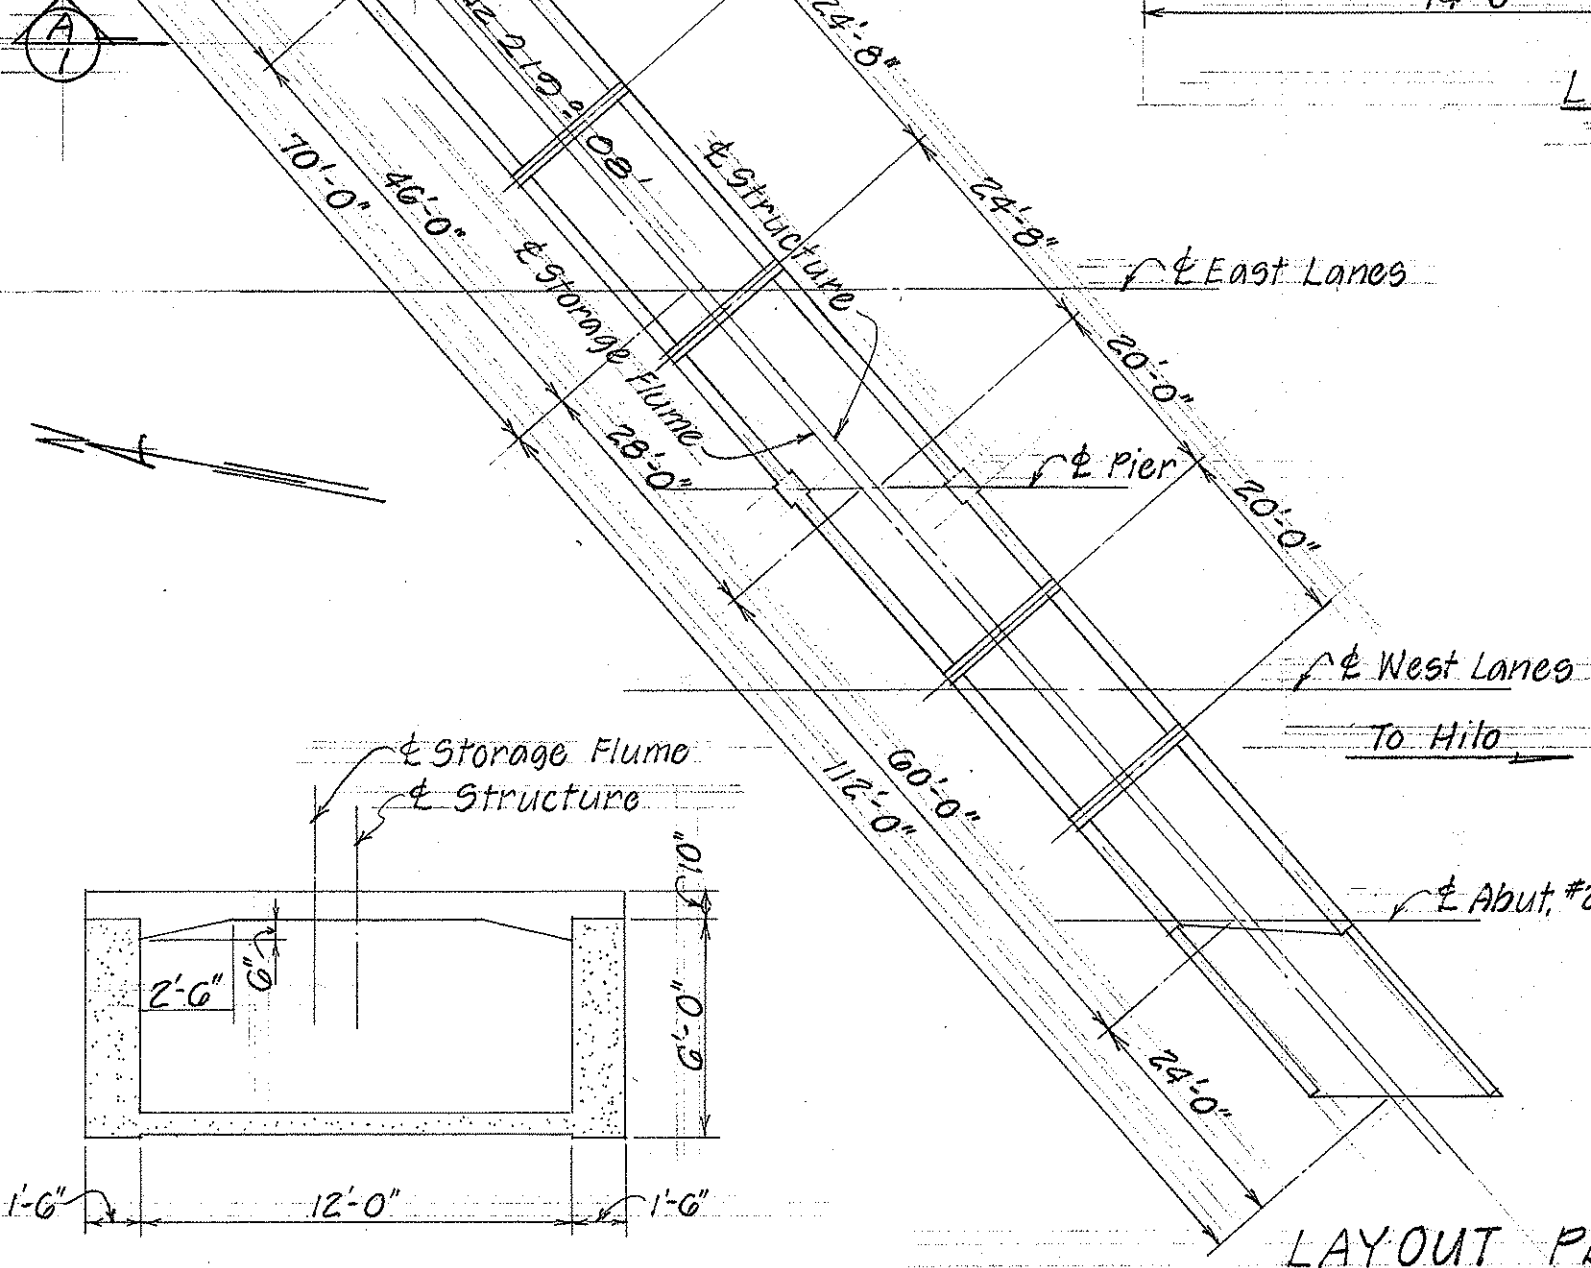

LAYOUT PLAN
Scale: 1" = 20'

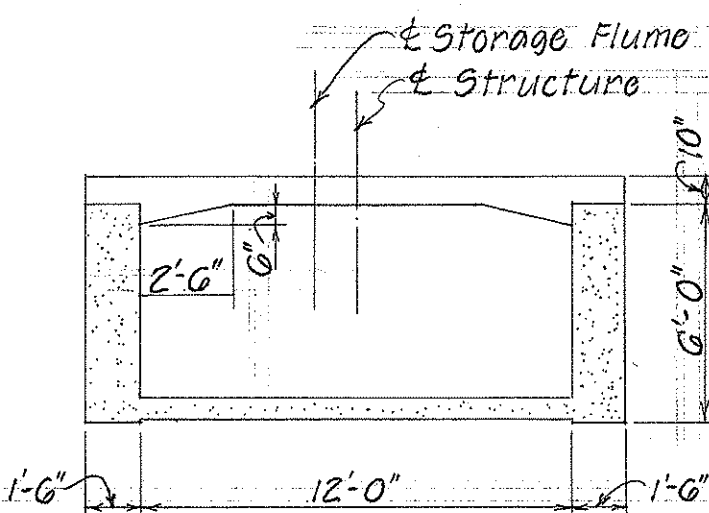

NORMAL SECTION
Scale: 3/16" = 1'-0"

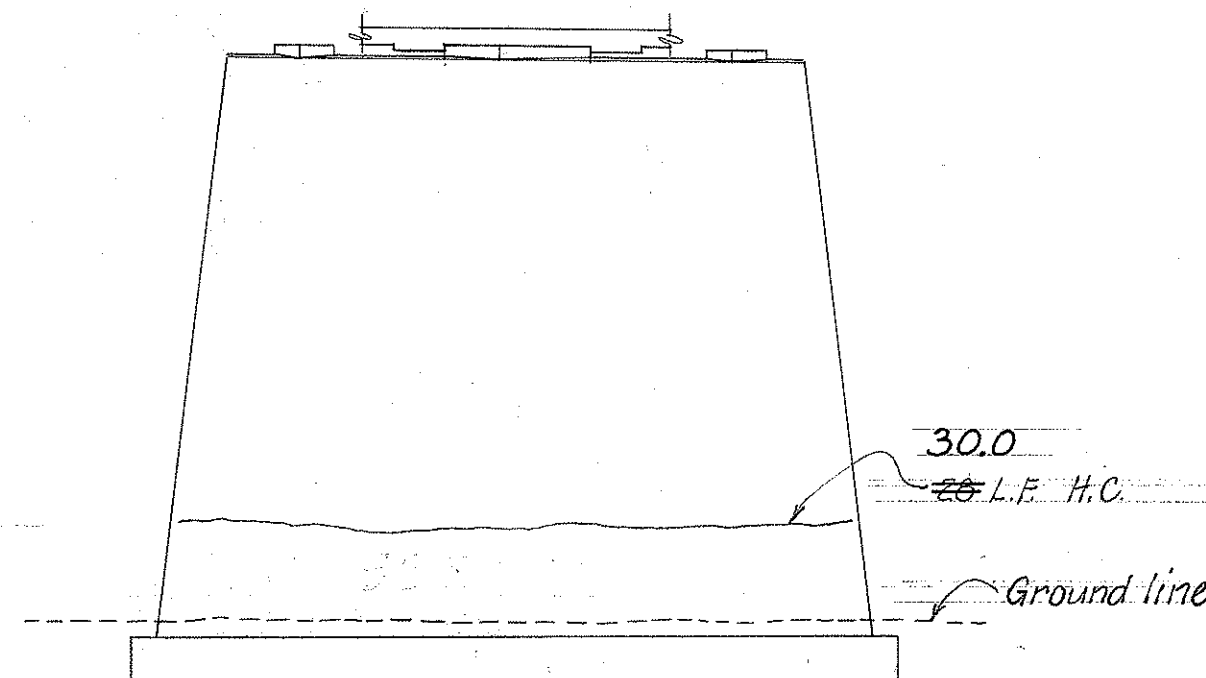

ELEV. (A) ABUT. #1
Scale: 1/8" = 1'-0"

Reference Note: Refer to sheet T1 for Typical Details.

STATE OF HAWAII
DEPARTMENT OF TRANSPORTATION
HIGHWAYS DIVISION
REHABILITATION & REPAIRS
TO WAINAKU FLUME OVERPASS
PROJ. NO. 19 GHK-01-73 Nov. 1973
SHEET No. 1 OF 1 SHEETS