

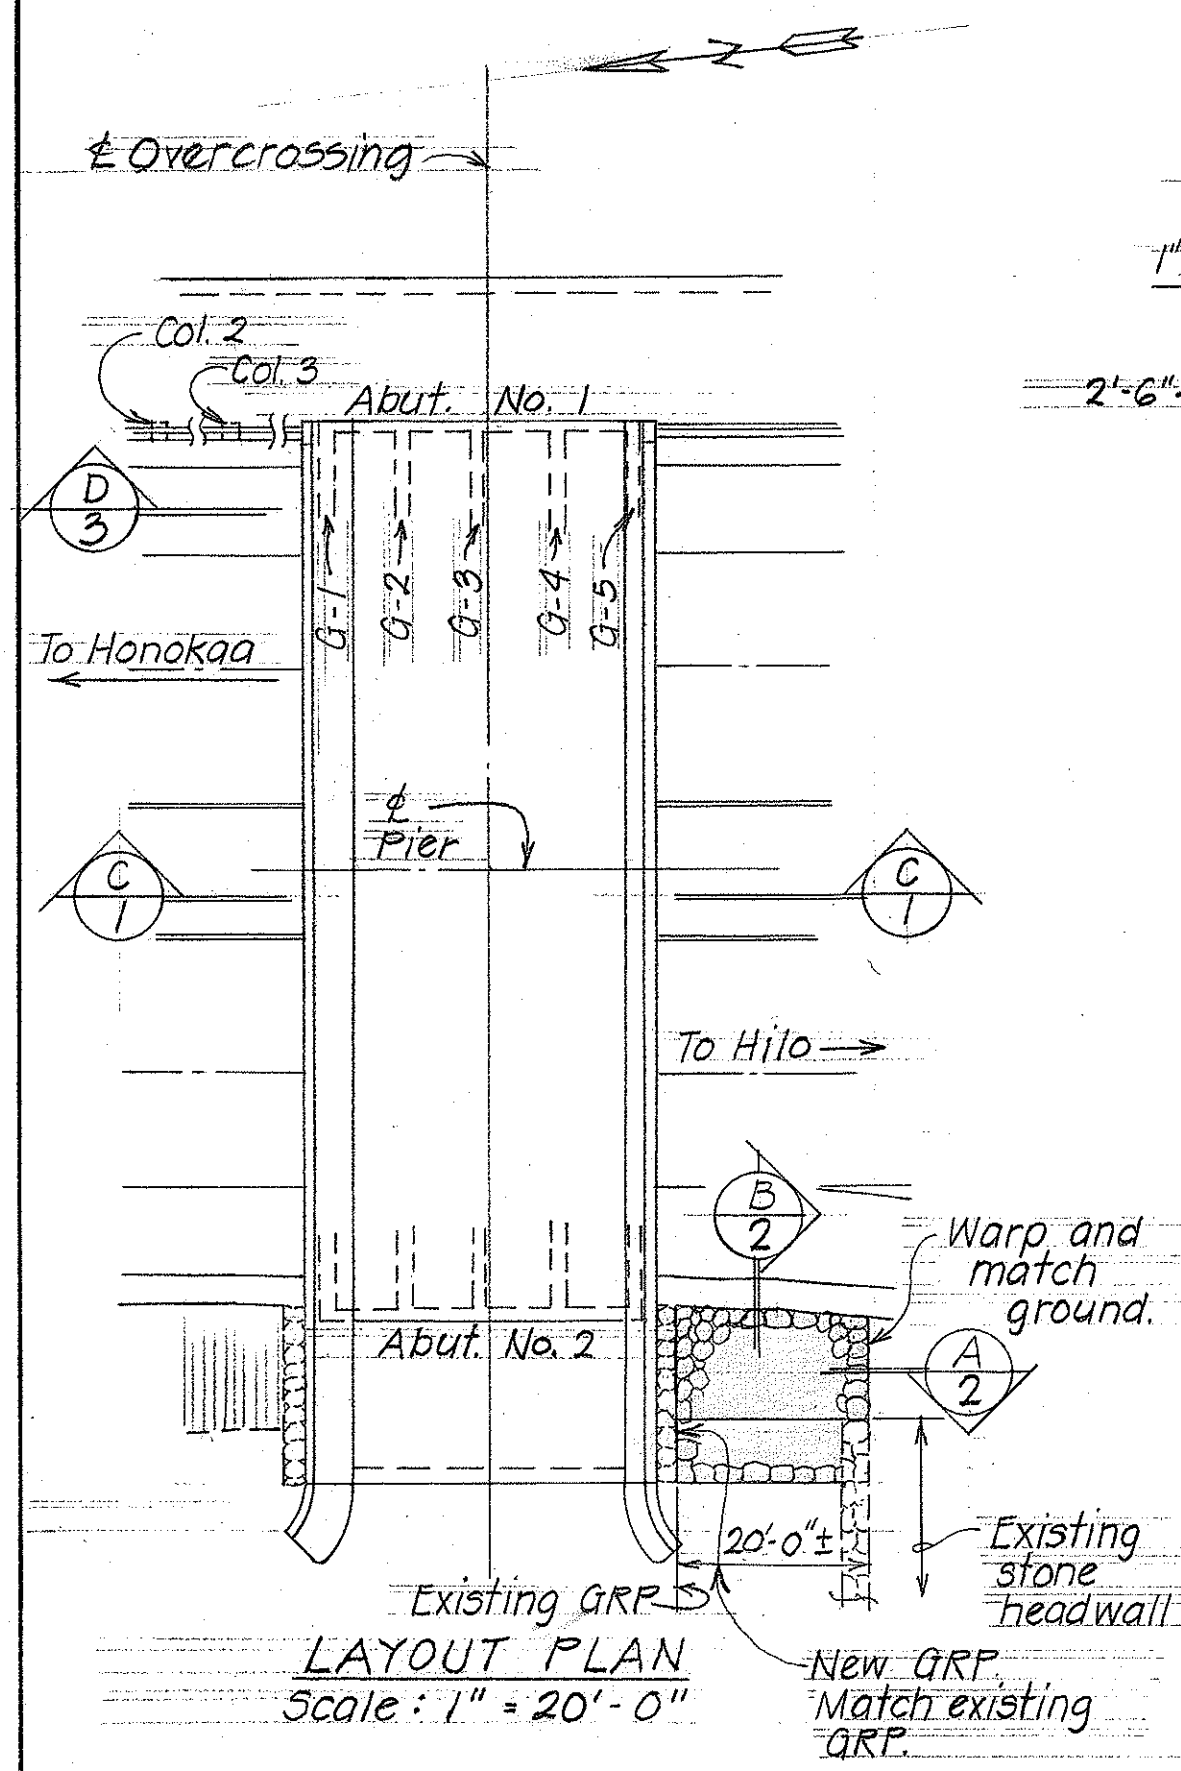


FED. ROAD DIST. NO.	STATE	FED. AID PROJ. NO.	FISCAL YEAR	SHEET NO.	TOTAL SHEETS
HAWAII	HAW.	19 GHK-01-73	1973	36	39


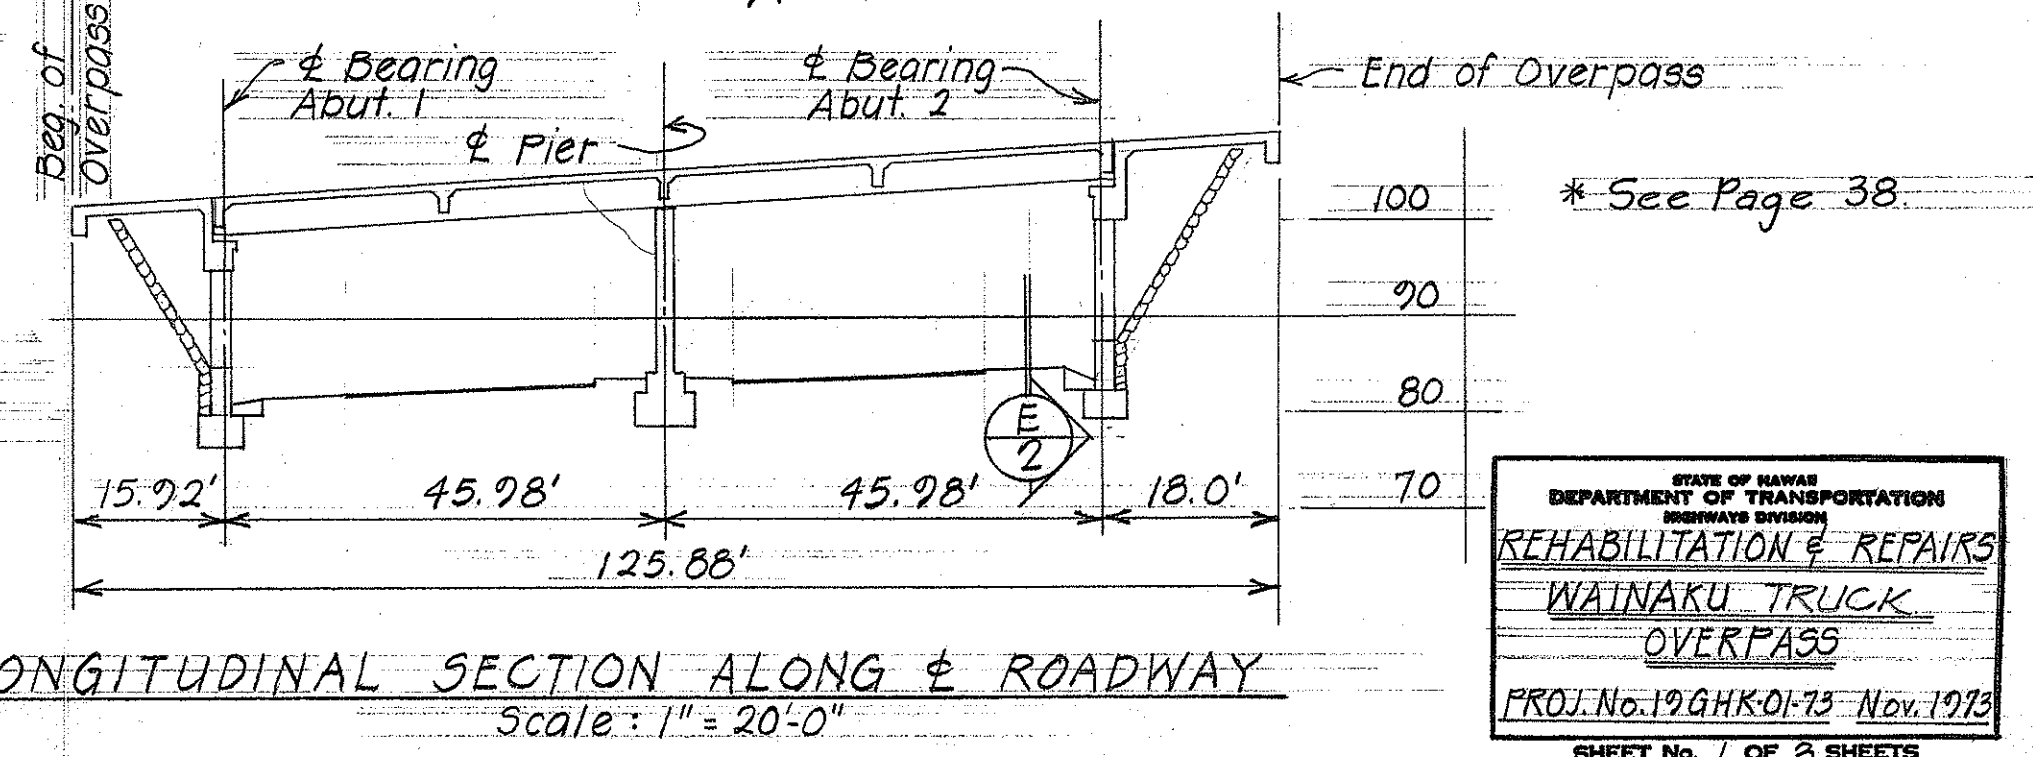


Reference Note: Refer to sheet T1 for Typical Details.

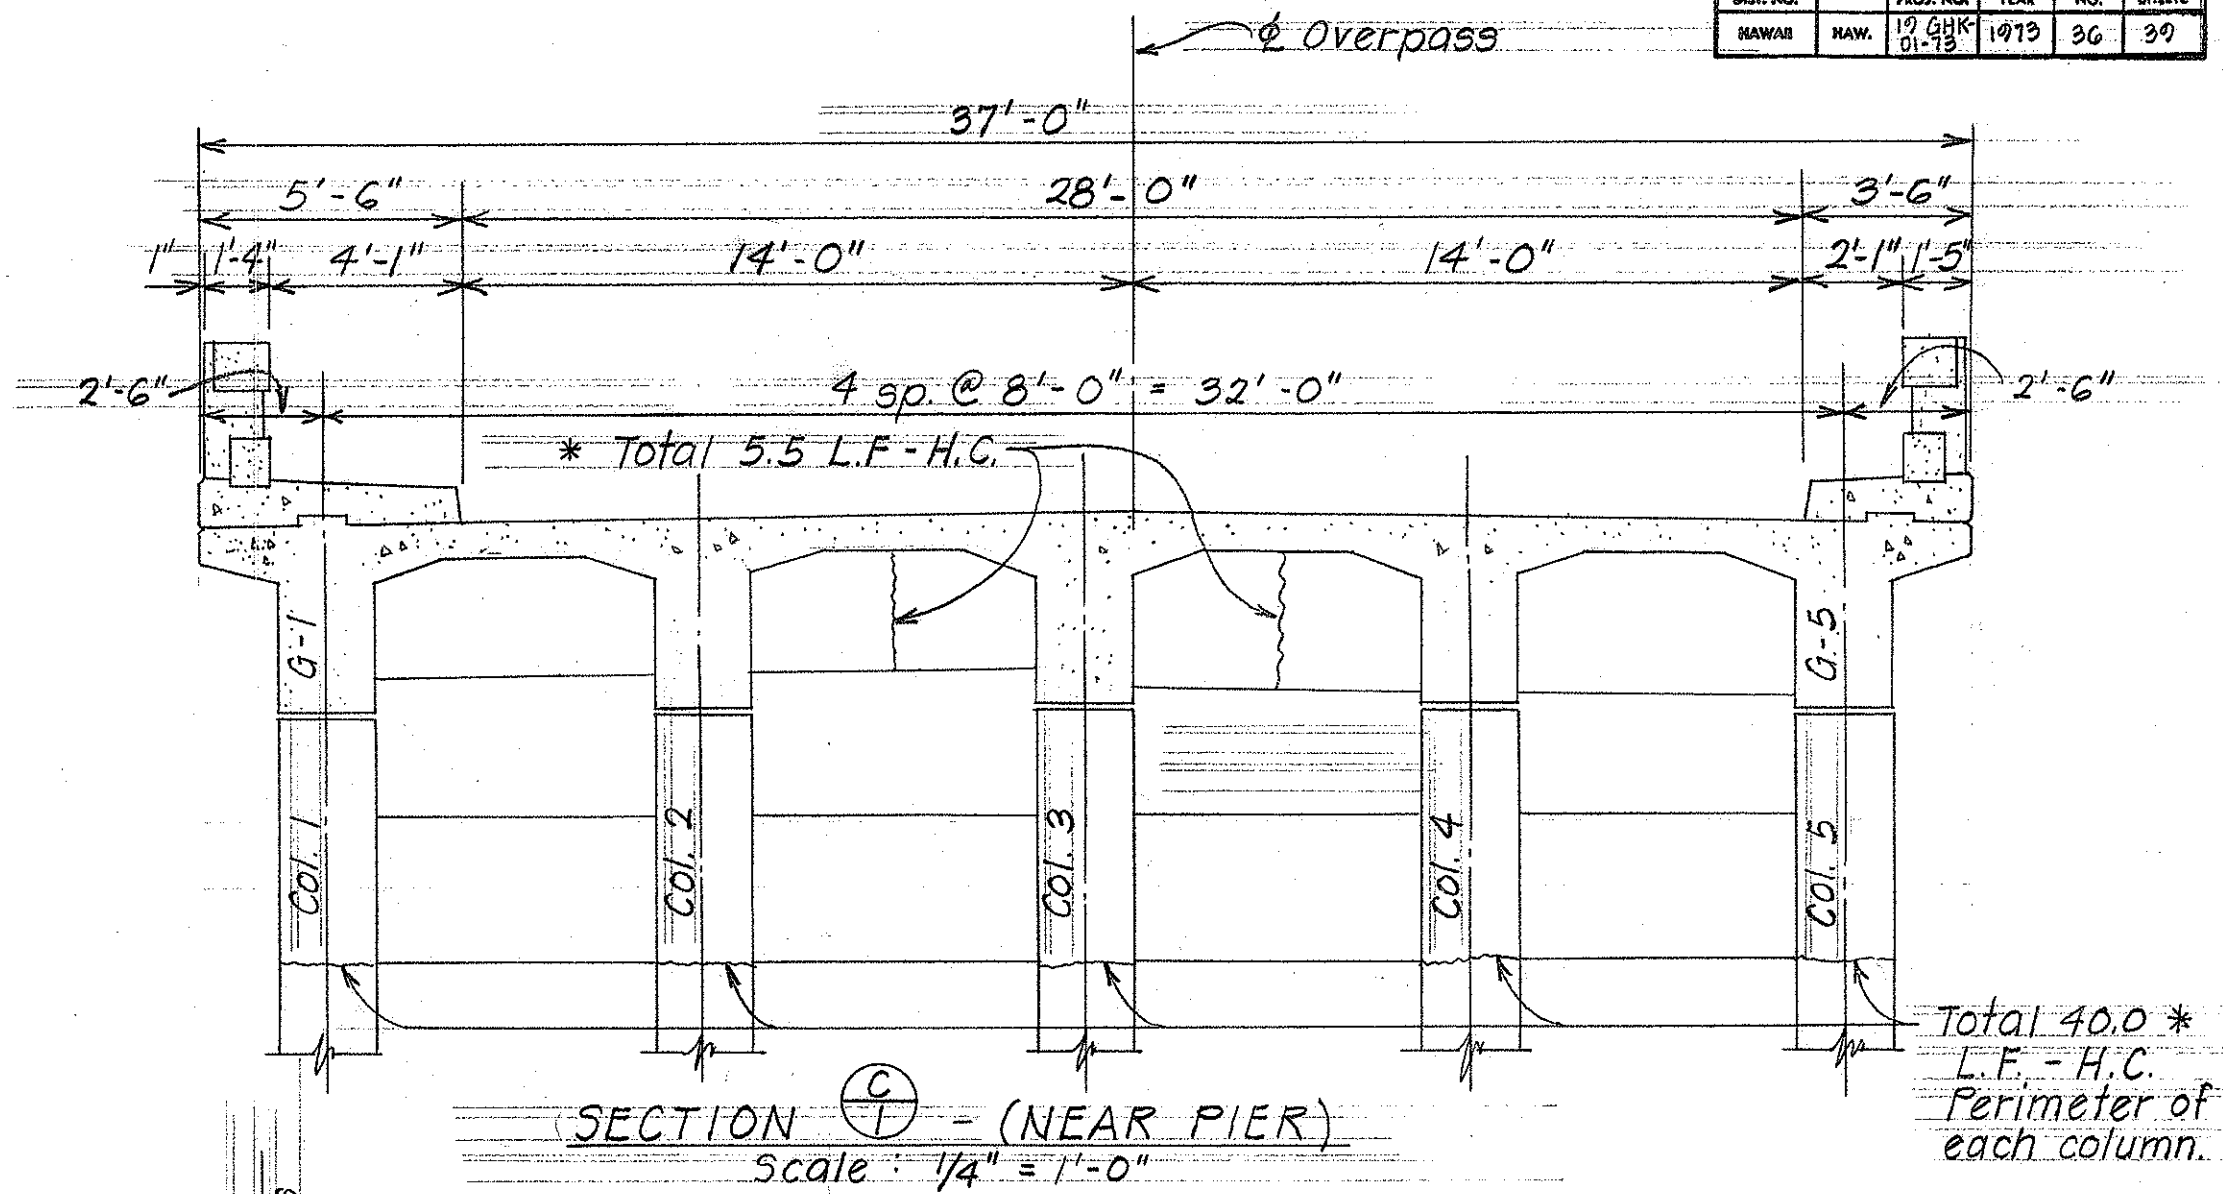

STATE OF HAWAII
DEPARTMENT OF TRANSPORTATION
HIGHWAYS DIVISION
REHABILITATION & REPAIRS
WAINAKU TRUCK OVERPASS
PROJ. No. 19 GHK-01-73 Nov. 1973
SHEET No. 1 OF 3 SHEETS

FED. ROAD DIST. NO.	STATE	FED. AID PROJ. NO.	FISCAL YEAR	SHEET NO.	TOTAL SHEETS
HAWAII	HAW.	19 GHK-01-73	1973	37	39

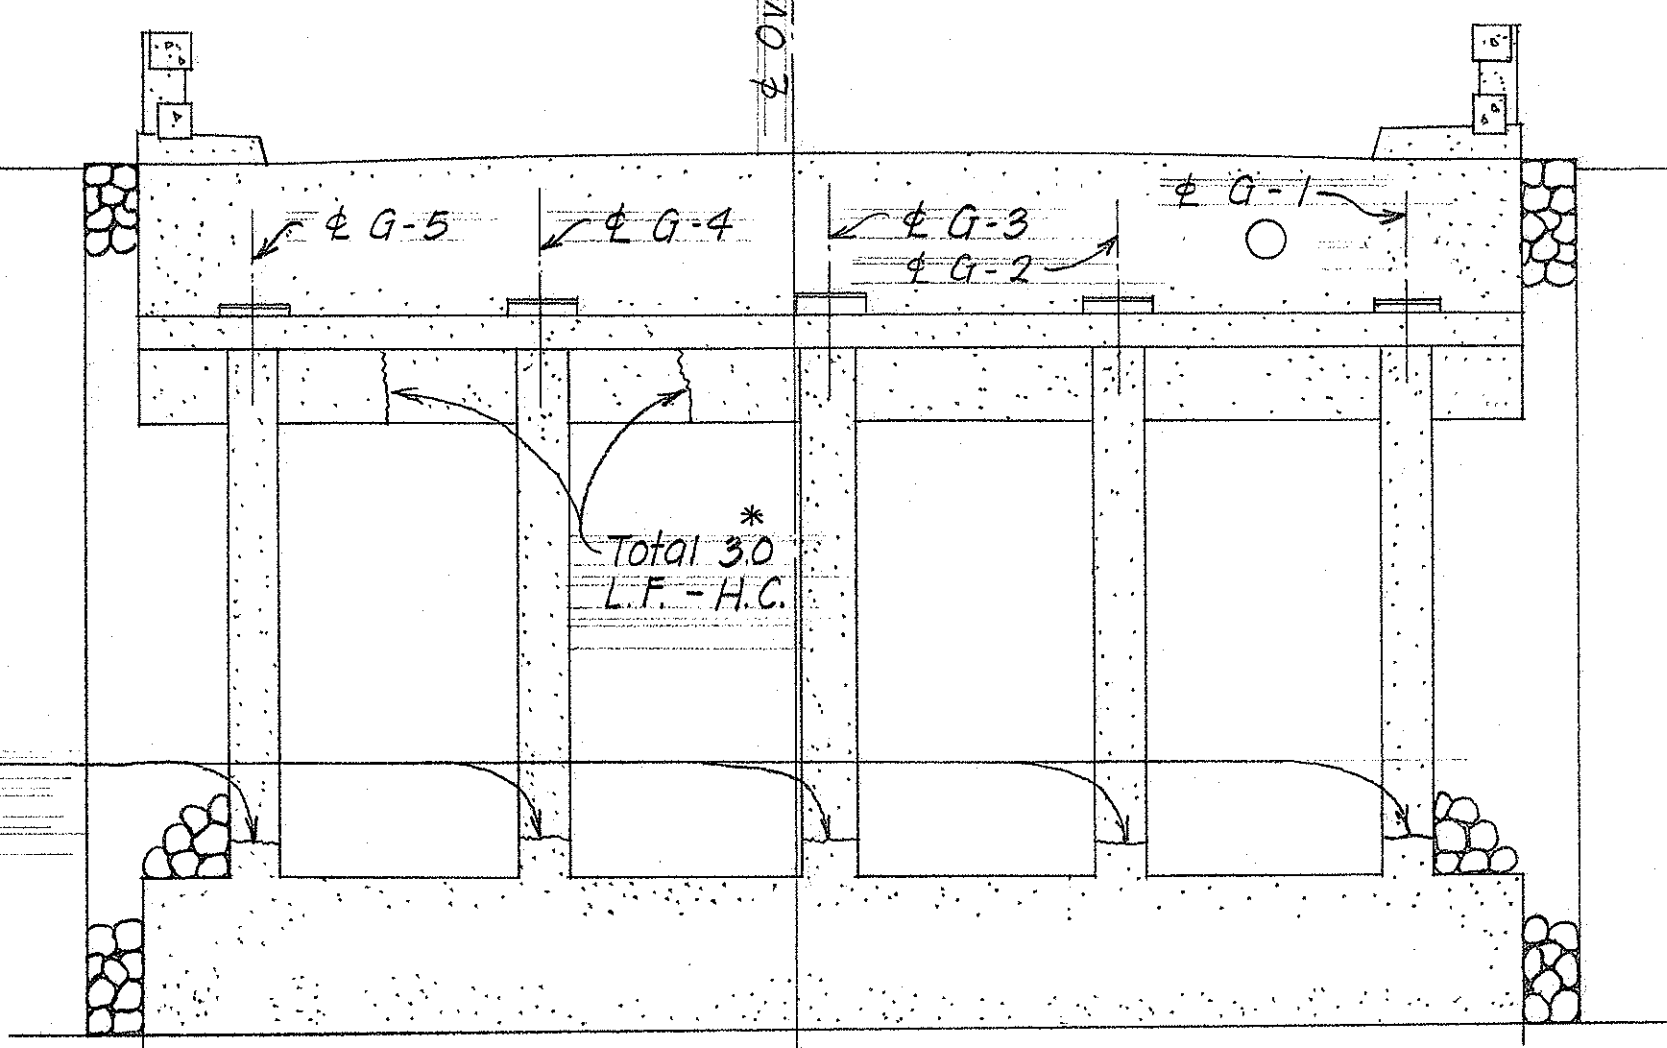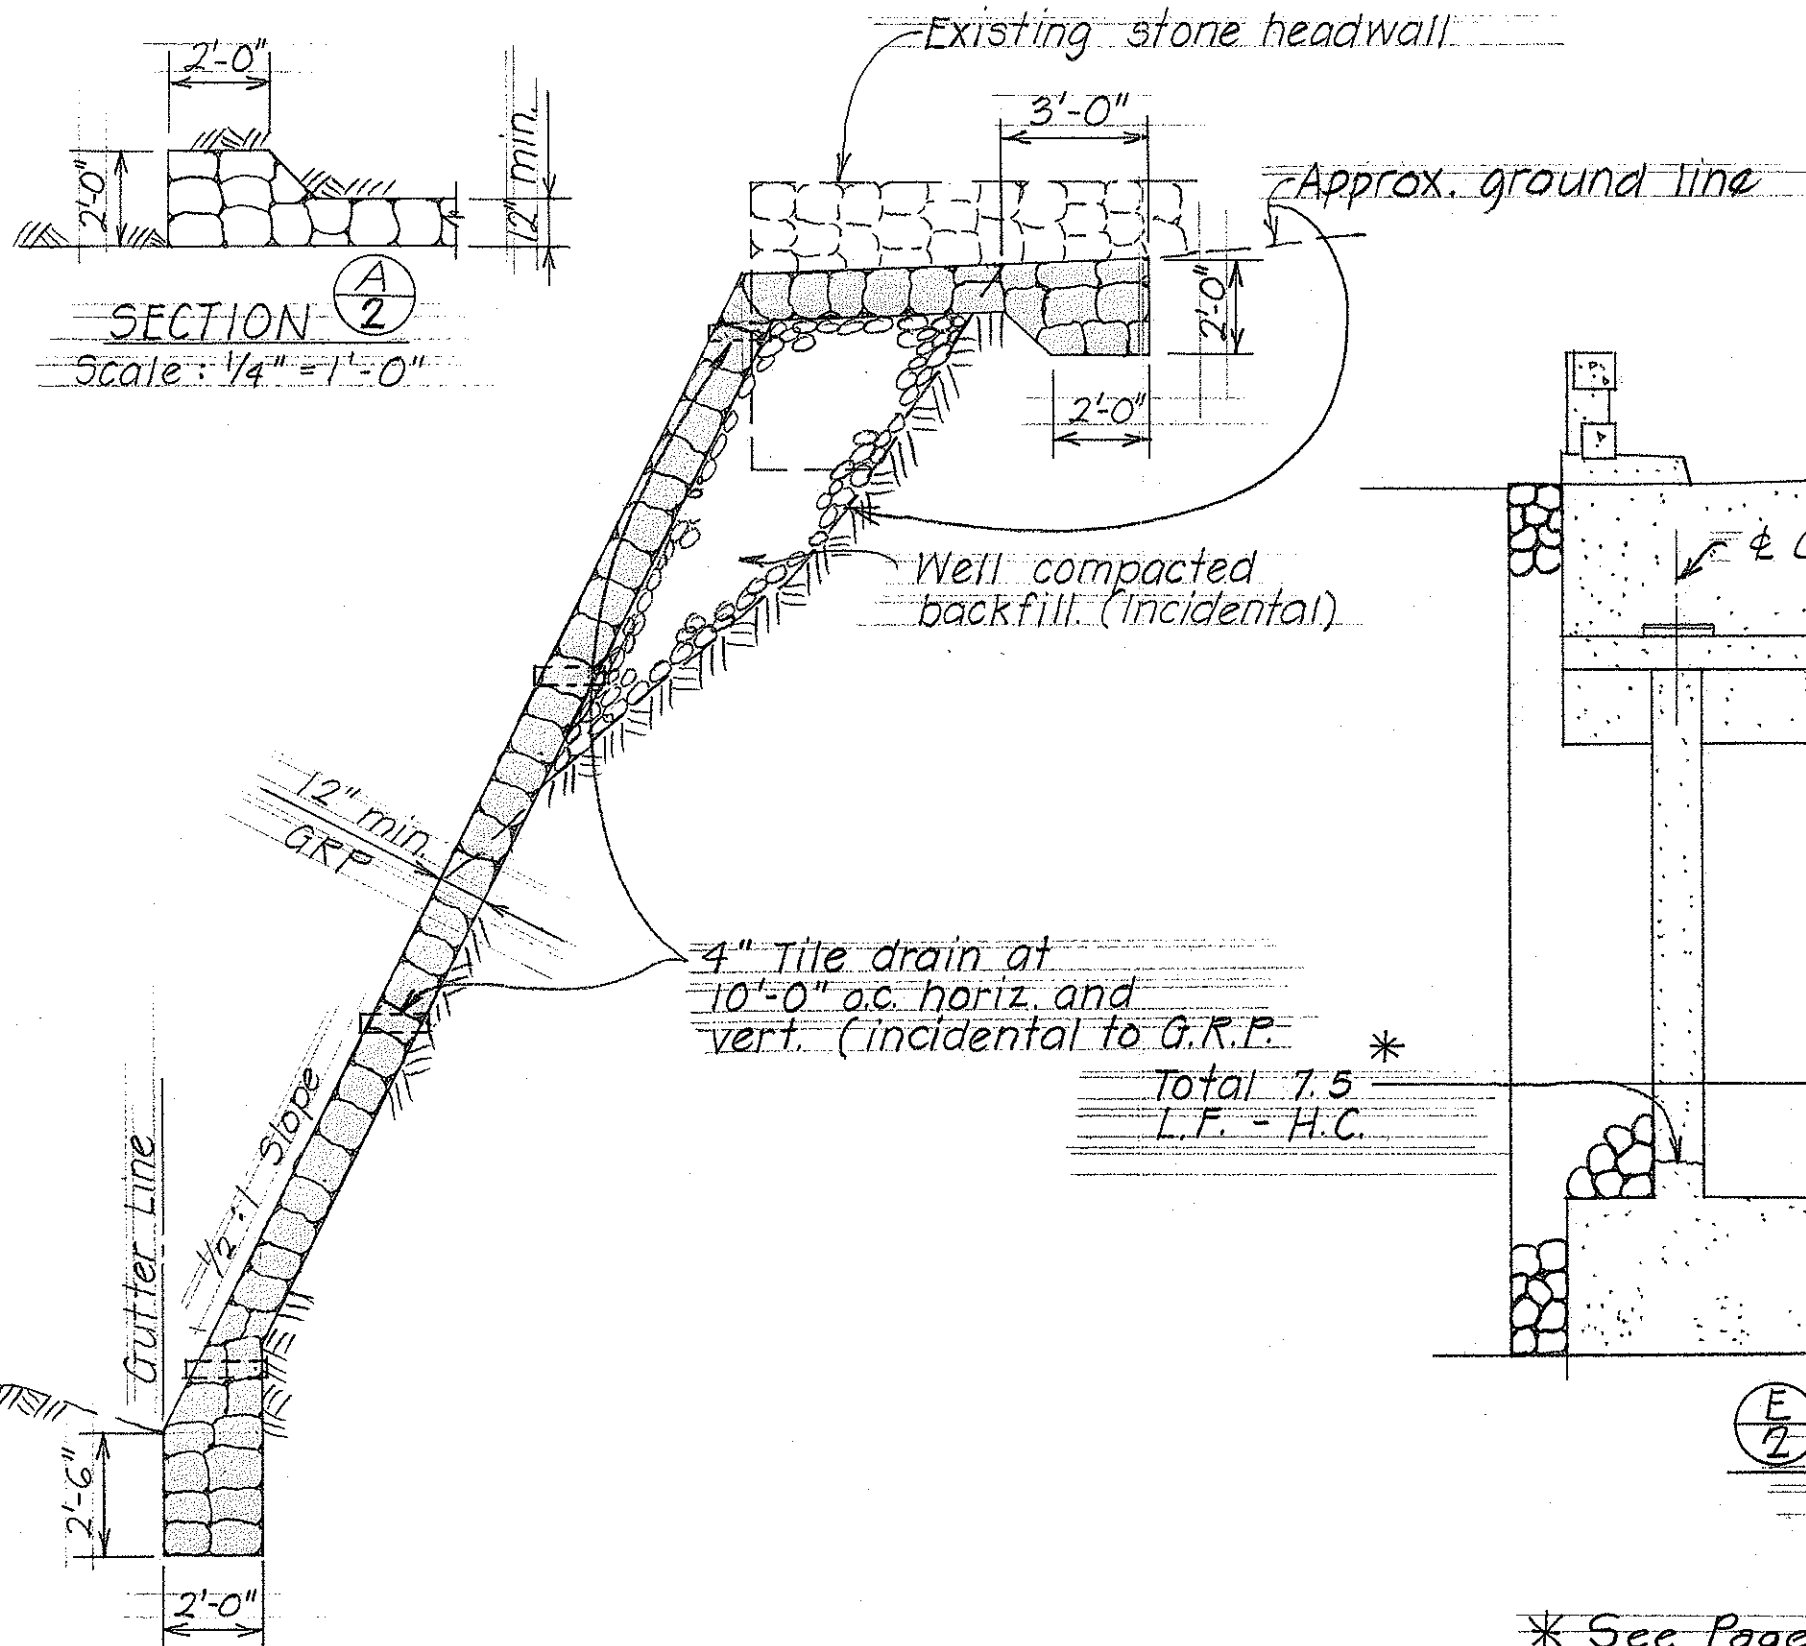

E/2 ELEVATION ABUTMENT No. 2
Scale: 1/4" = 1'-0"


* See Page 38.

DESIGNED BY	DATE
DRAWN BY	
CHECKED BY	
NOTED BY	
APPROVED BY	

SECTION B/2
Scale: 1/4" = 1'-0"

STATE OF HAWAII
DEPARTMENT OF TRANSPORTATION
HIGHWAYS DIVISION
REHABILITATION & REPAIRS
WAINAKU TRUCK
OVERPASS
PROJ. No. 19 GHK-01-73 Nov. 1973
SHEET No. 2 OF 3 SHEETS

FED. ROAD DIST. NO.	STATE	FED-AID PROJ. NO.	FISCAL YEAR	SHEET NO.	TOTAL SHEETS
HAWAII	HAW.	19 GHK-01-73	1973	38	39

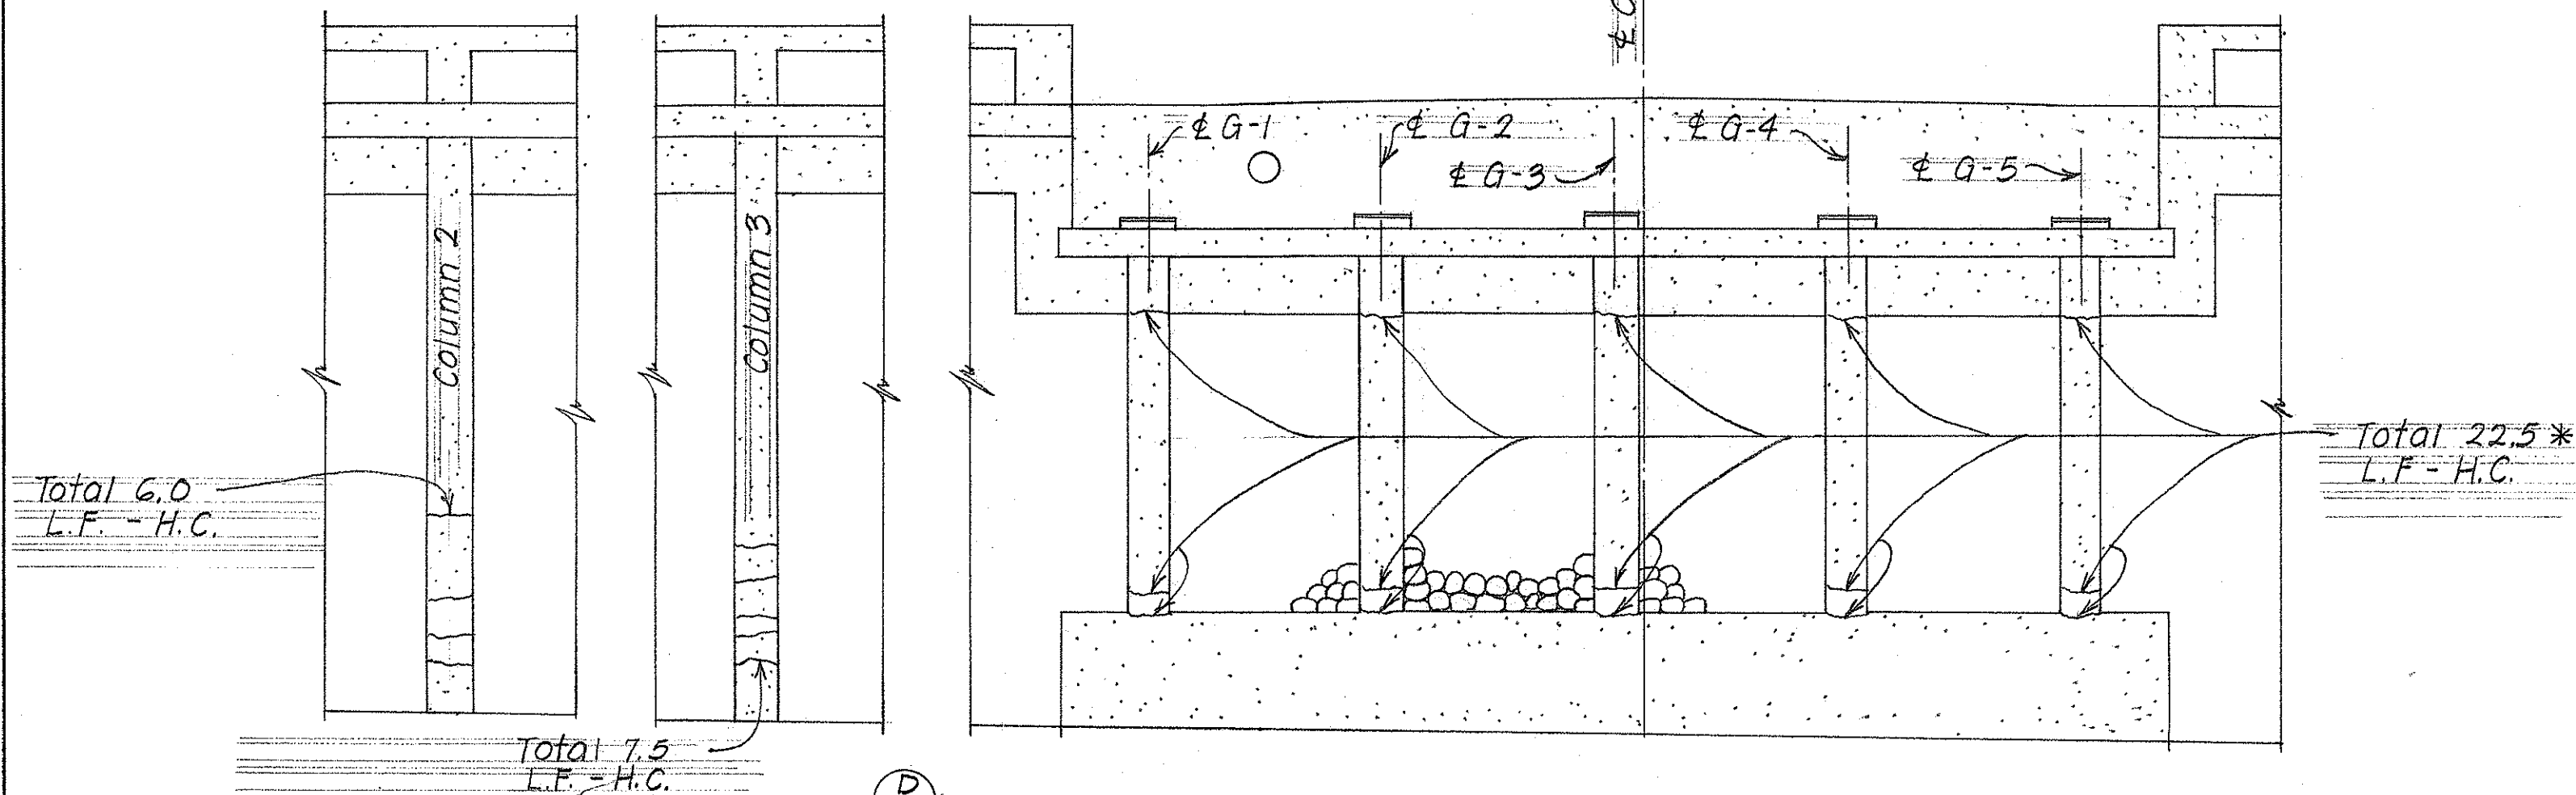

(D)
3 ELEVATION ABUTMENT No. 1
Scale: $\frac{3}{16}'' = 1' - 0''$

SUMMARY

* Sealing of Cracks: 230.0 L.F.

Grouted Rubble Paving: 31.4 cu. yd.

Note:

The locations of the areas sealed with epoxy are only partially shown on these plans.

DESIGNED BY	DATE
DRAWN BY	
CHECKED BY	
IN CHARGE	

STATE OF HAWAII DEPARTMENT OF TRANSPORTATION HIGHWAYS DIVISION
REHABILITATION & REPAIRS
WAINAKU TRUCK
OVERPASS
PROJ. No. 19 GHK-01-73 Nov. 1973
SHEET No. 3 OF 3 SHEETS