
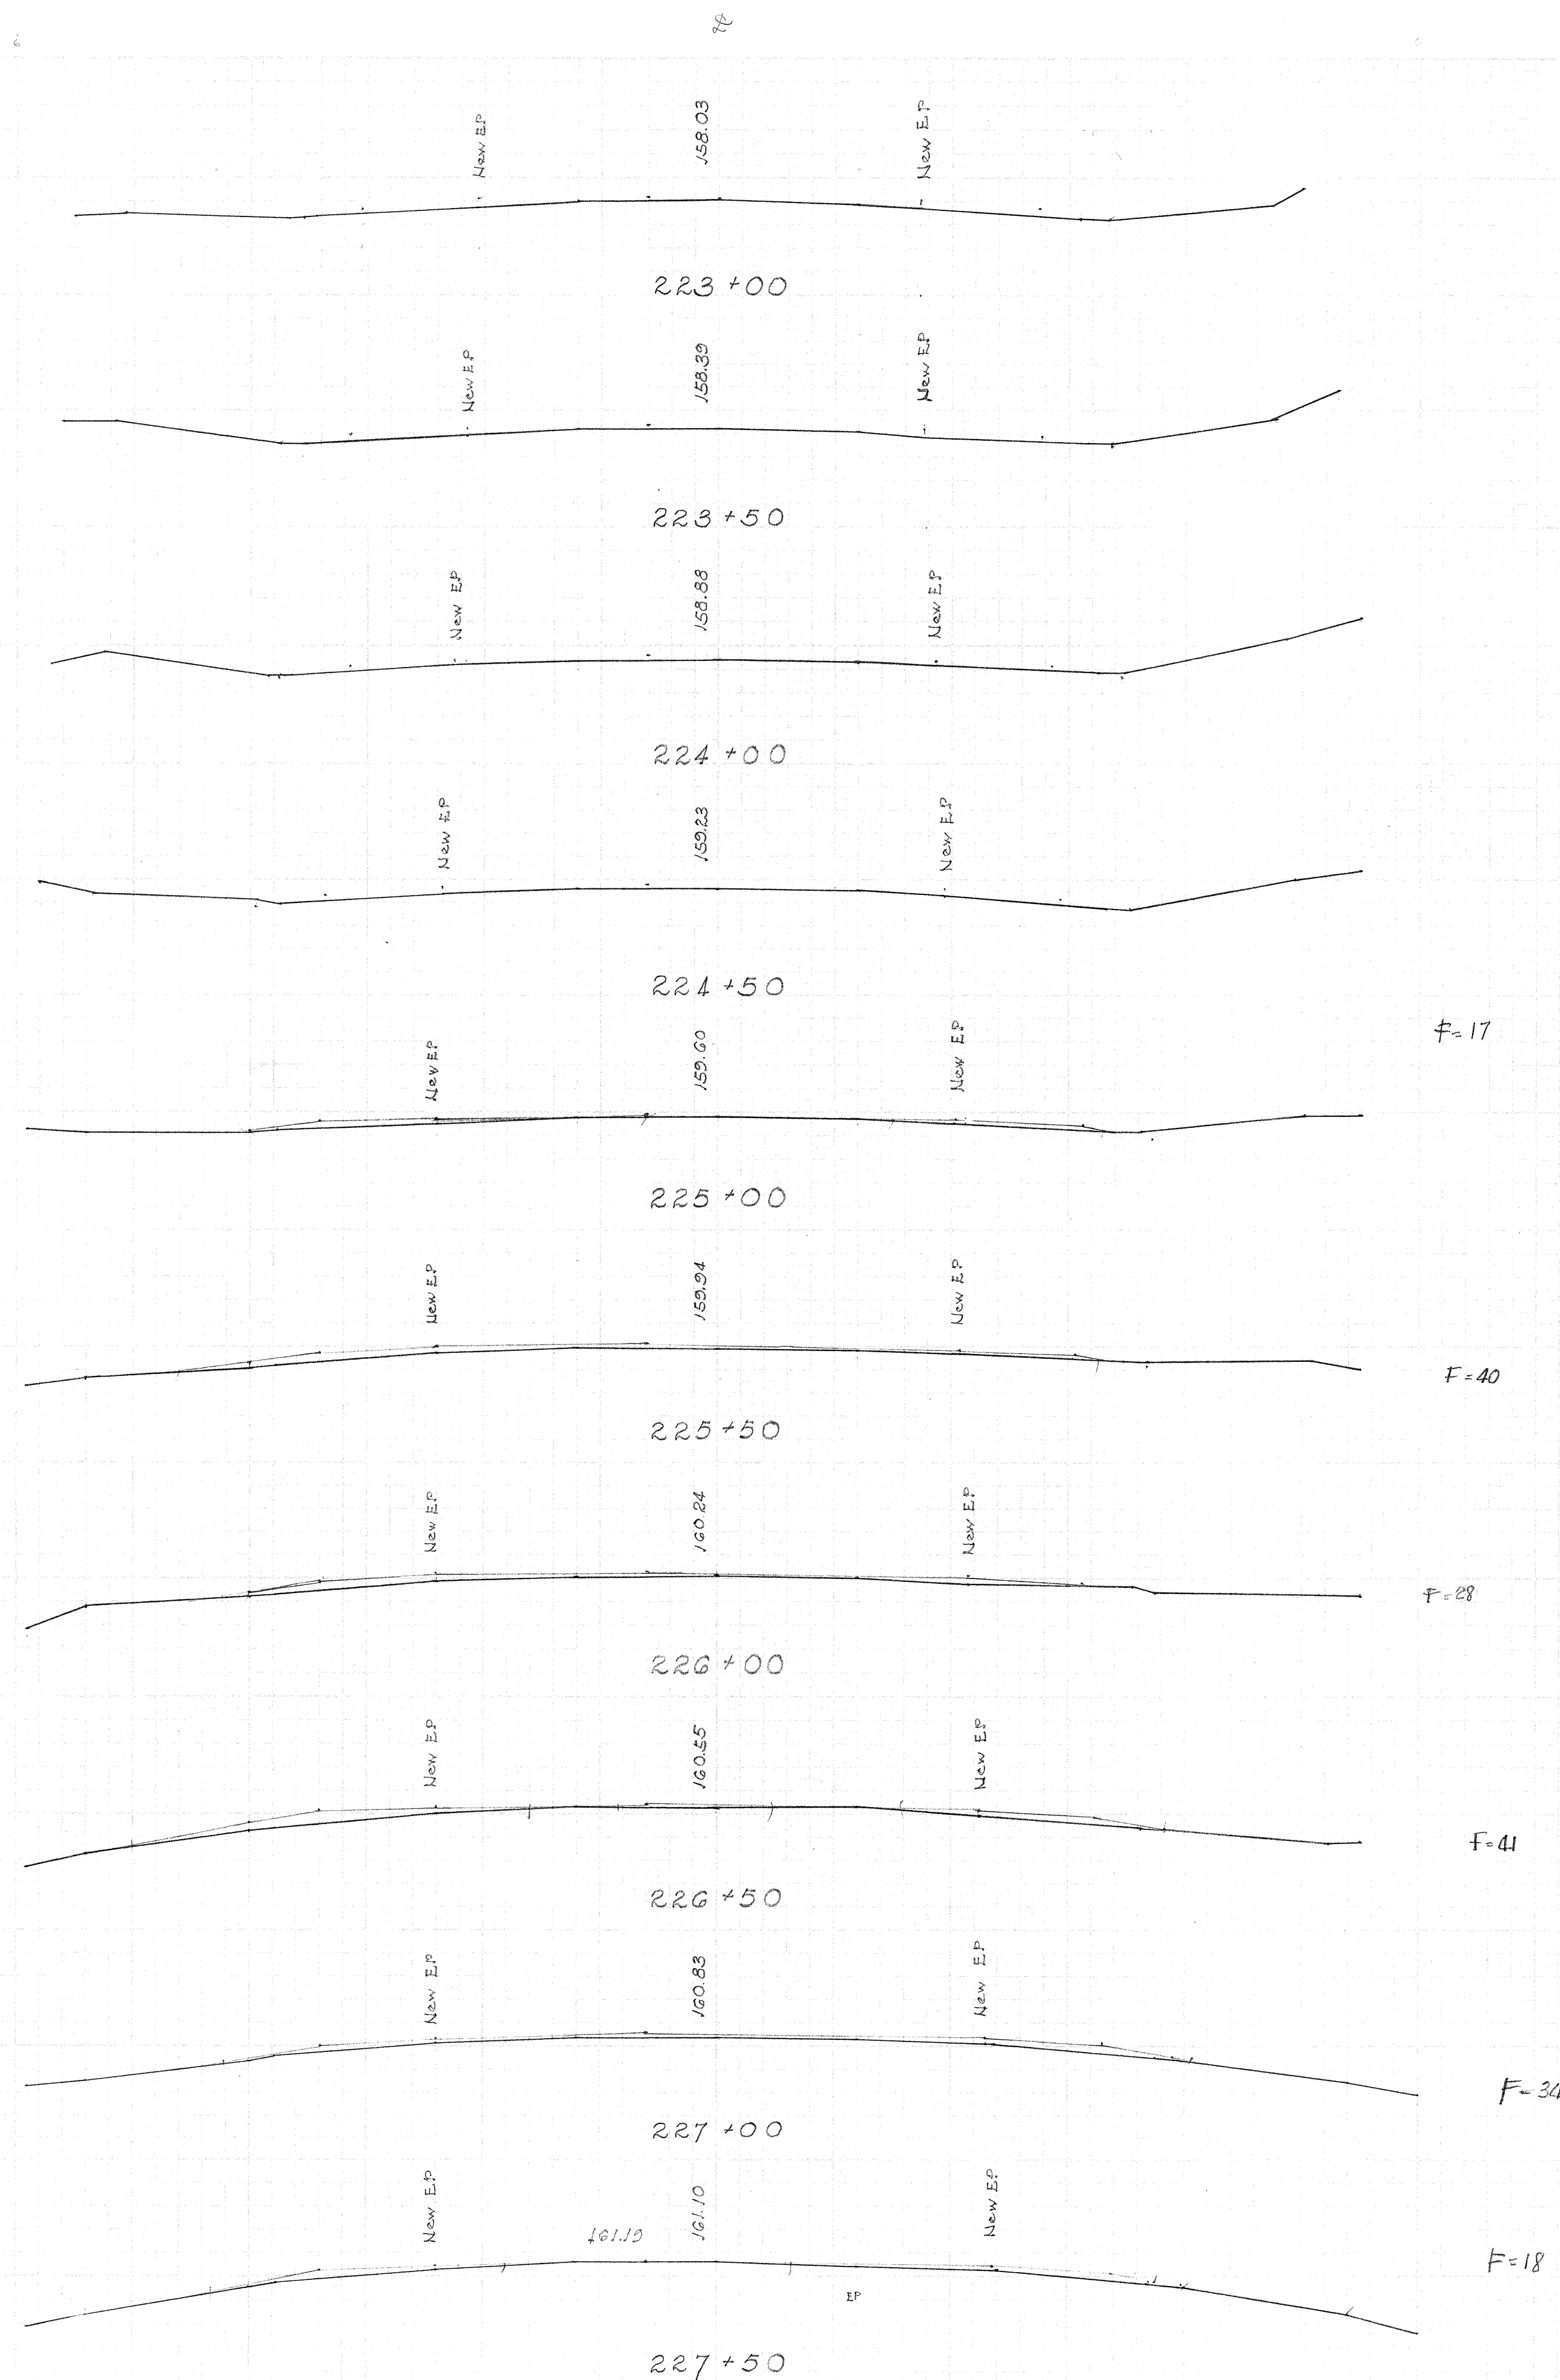


FINAL	SUP-810	DATE
SURVEY	PORTED	
NOTE BOOK	1/1/74	
NO.	JACOB CHECKED	

ORIGINAL	SURVEY	DATE
SURVEY	PORTED	7-10-74
NOTE BOOK	1/1/74	7-15-74
NO.	81-2	


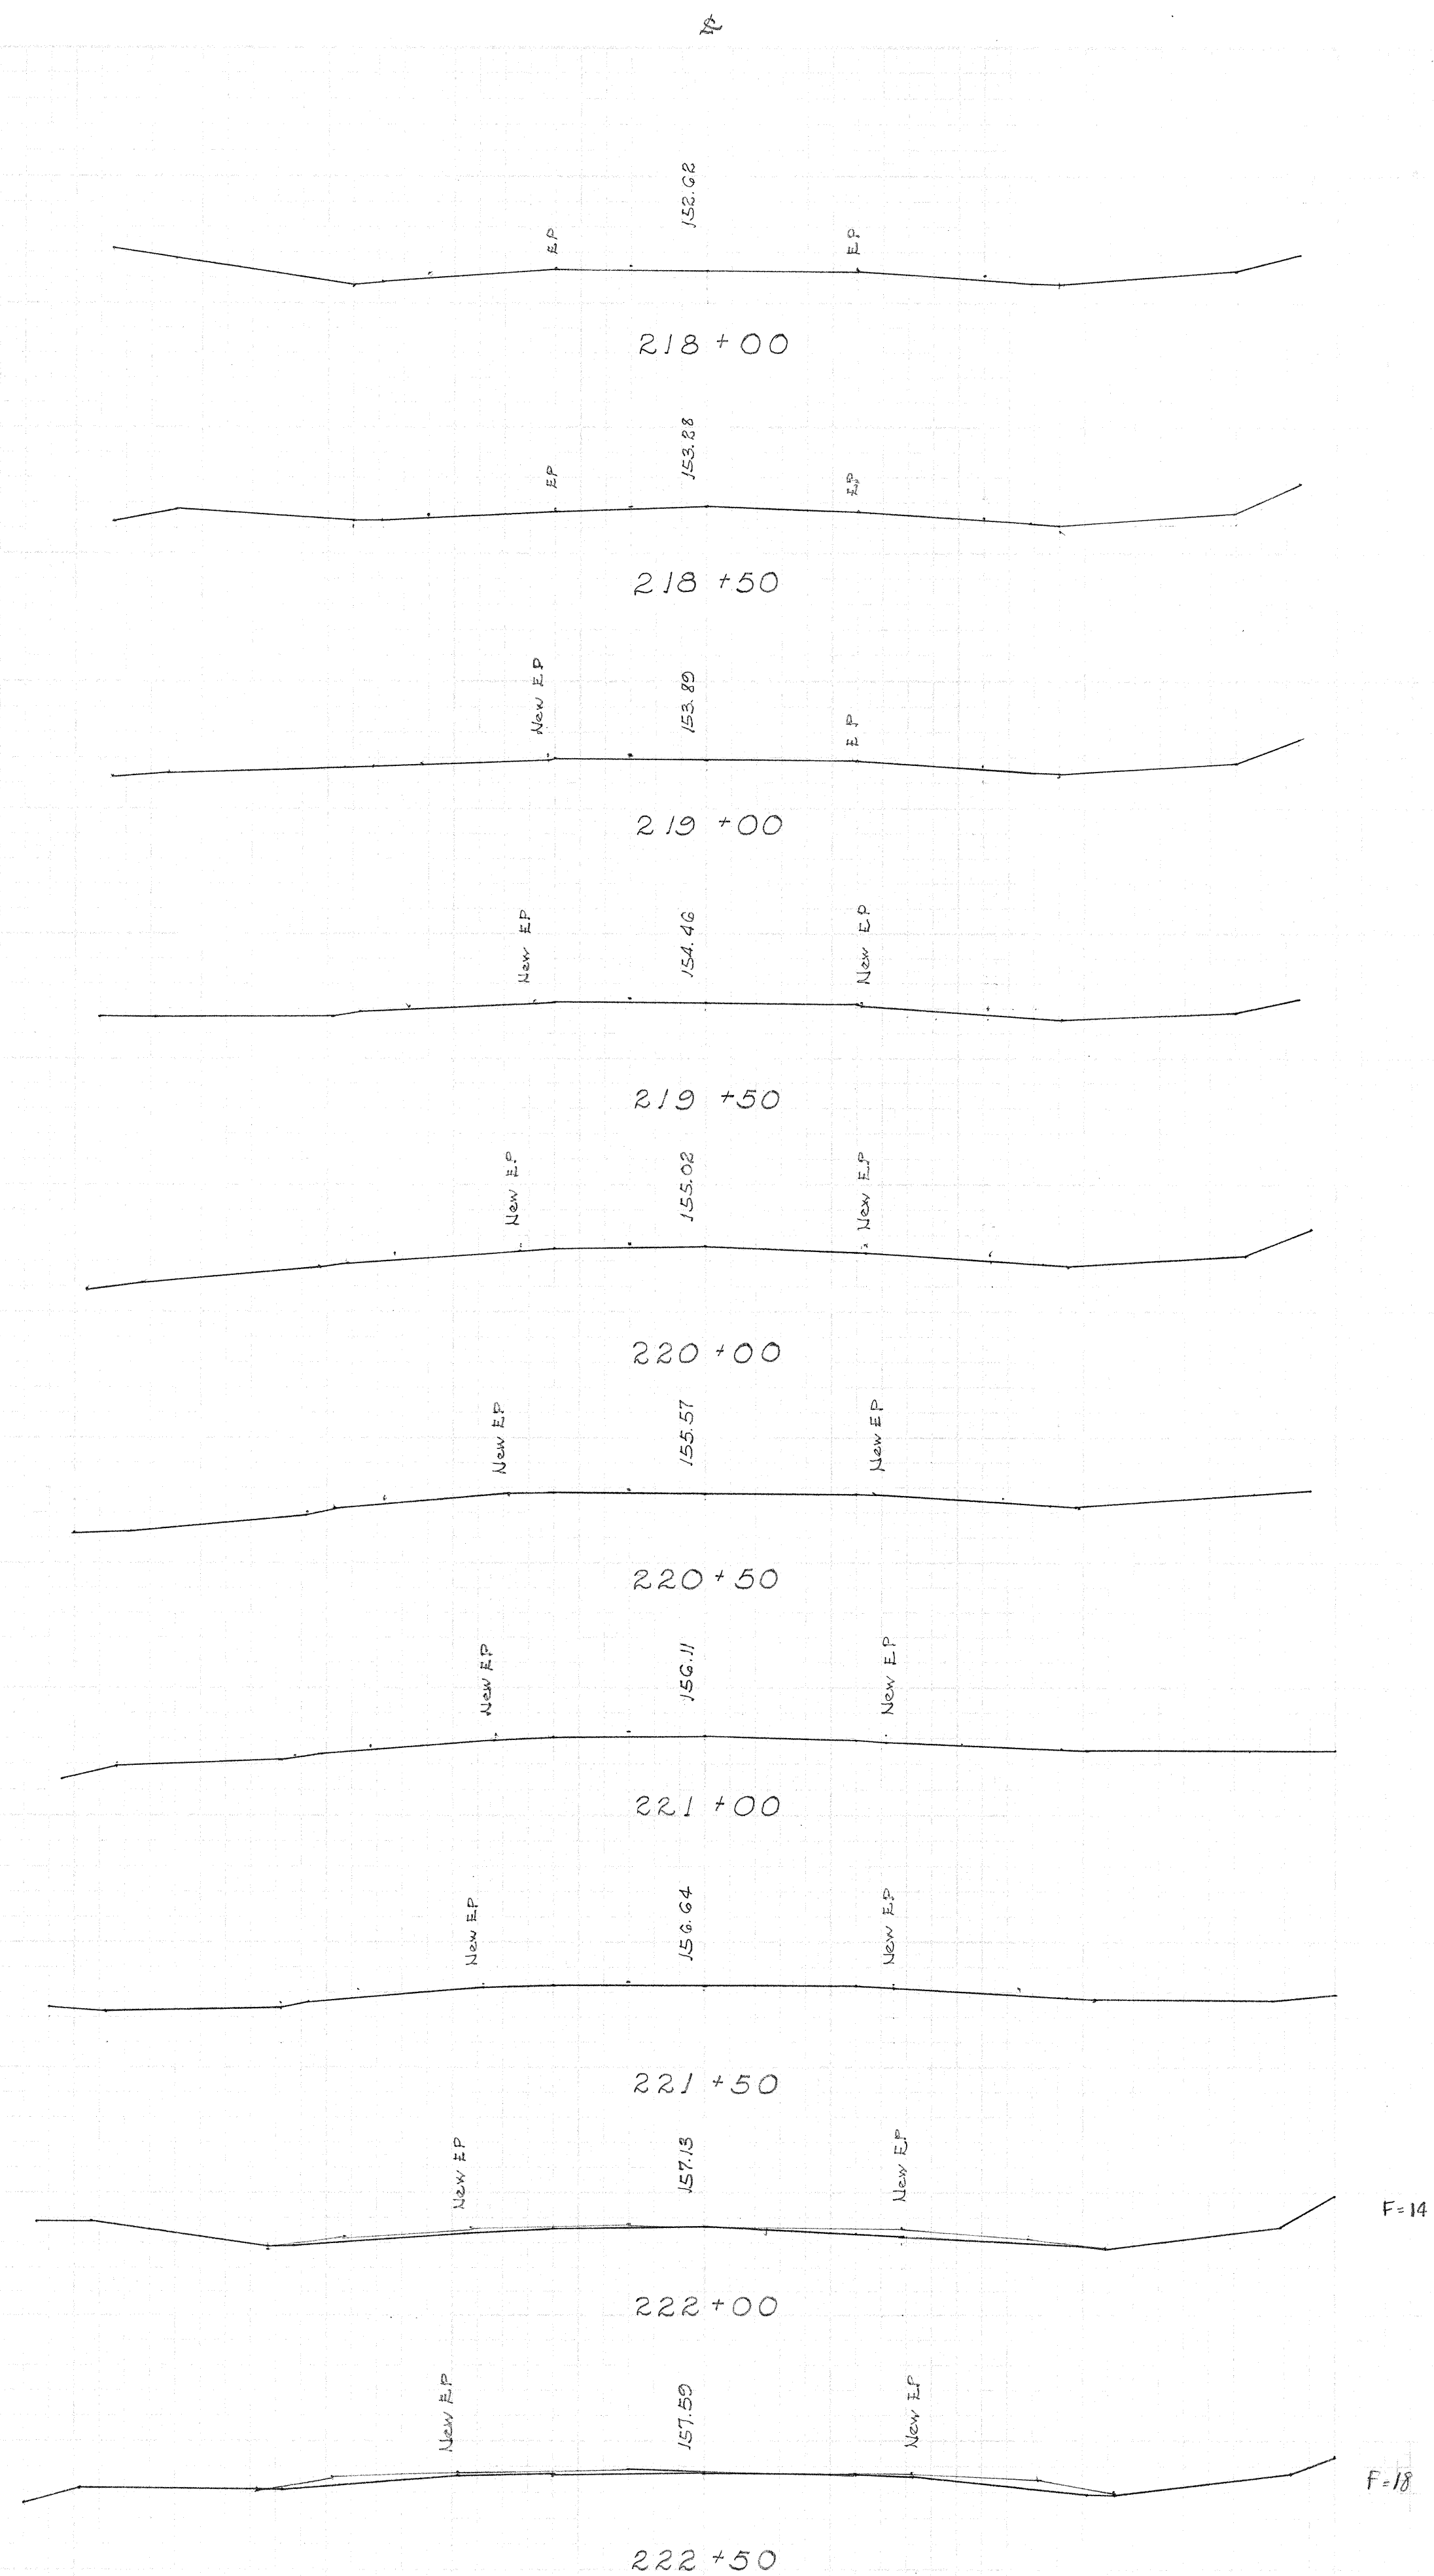


Kailua-Kawaihae Road Phase III B
Project No. 19BC-01-71

DATE: 9-10-71
SURVEY: 1000
NOTE BOOK: 1000
BY: J. W. H. H. H.

DATE: 9-10-71
SURVEY: 1000
NOTE BOOK: 1000
BY: J. W. H. H. H.

DATE: 9-10-71
SURVEY: 1000
NOTE BOOK: 1000
BY: J. W. H. H. H.

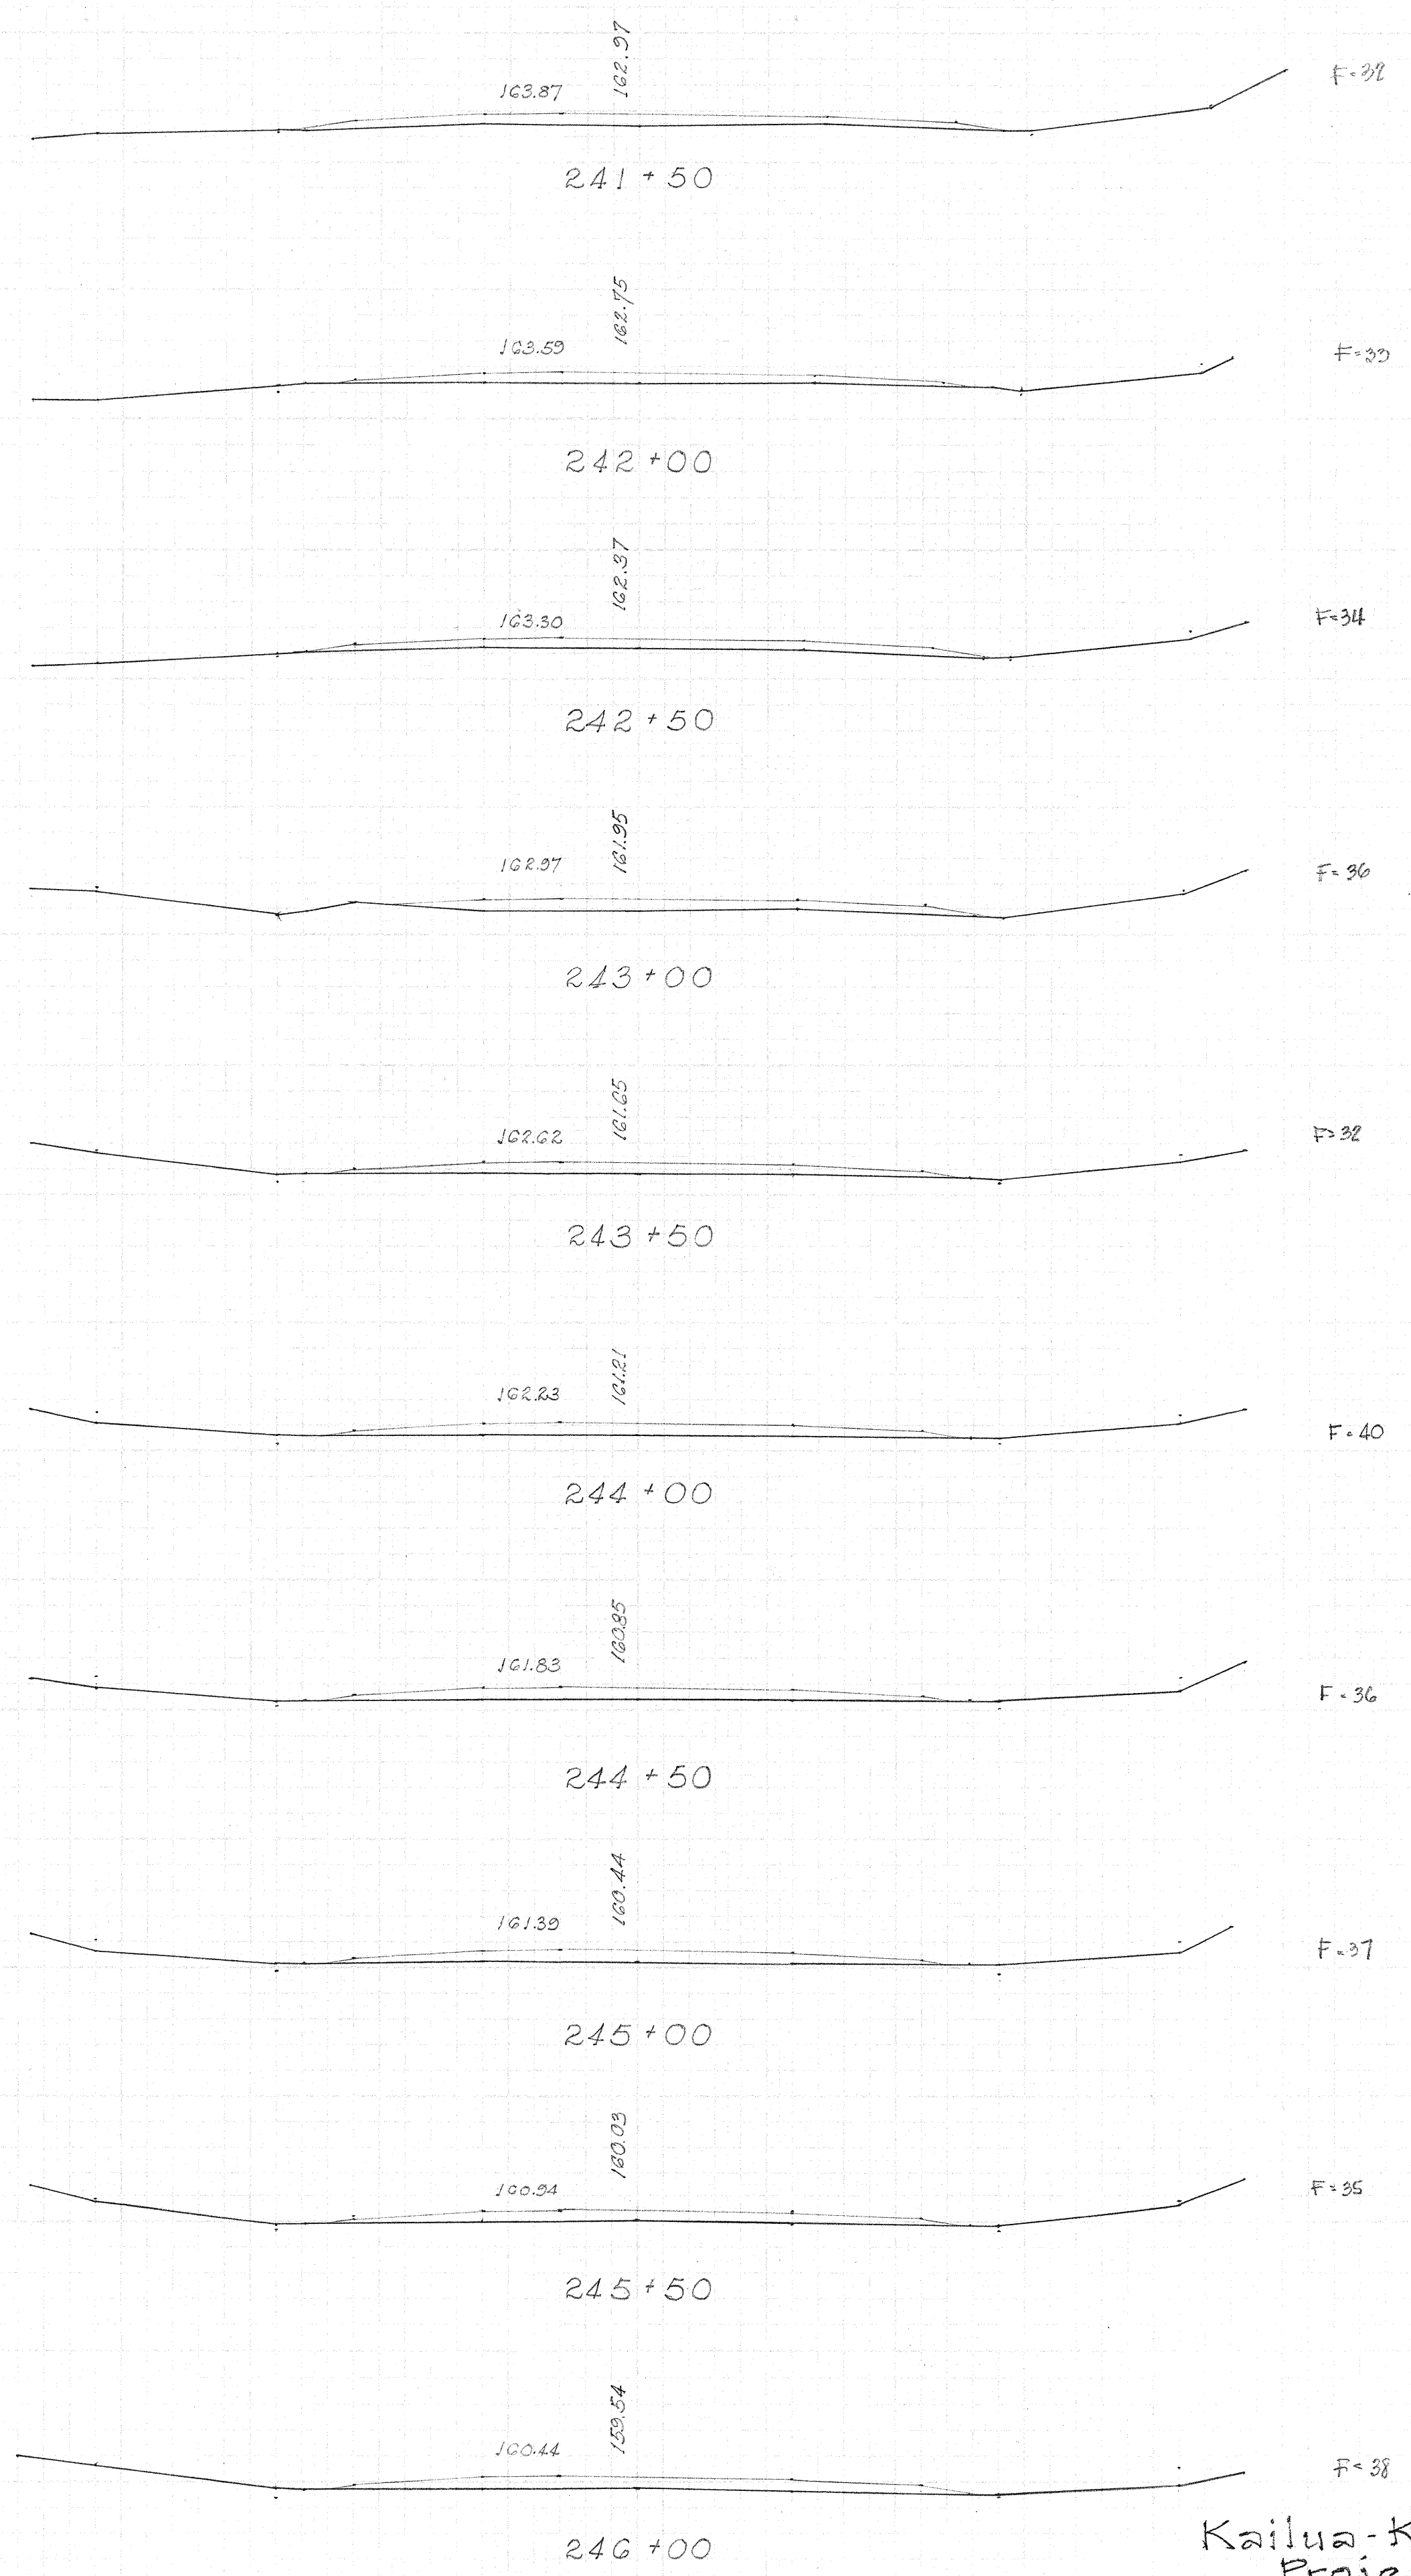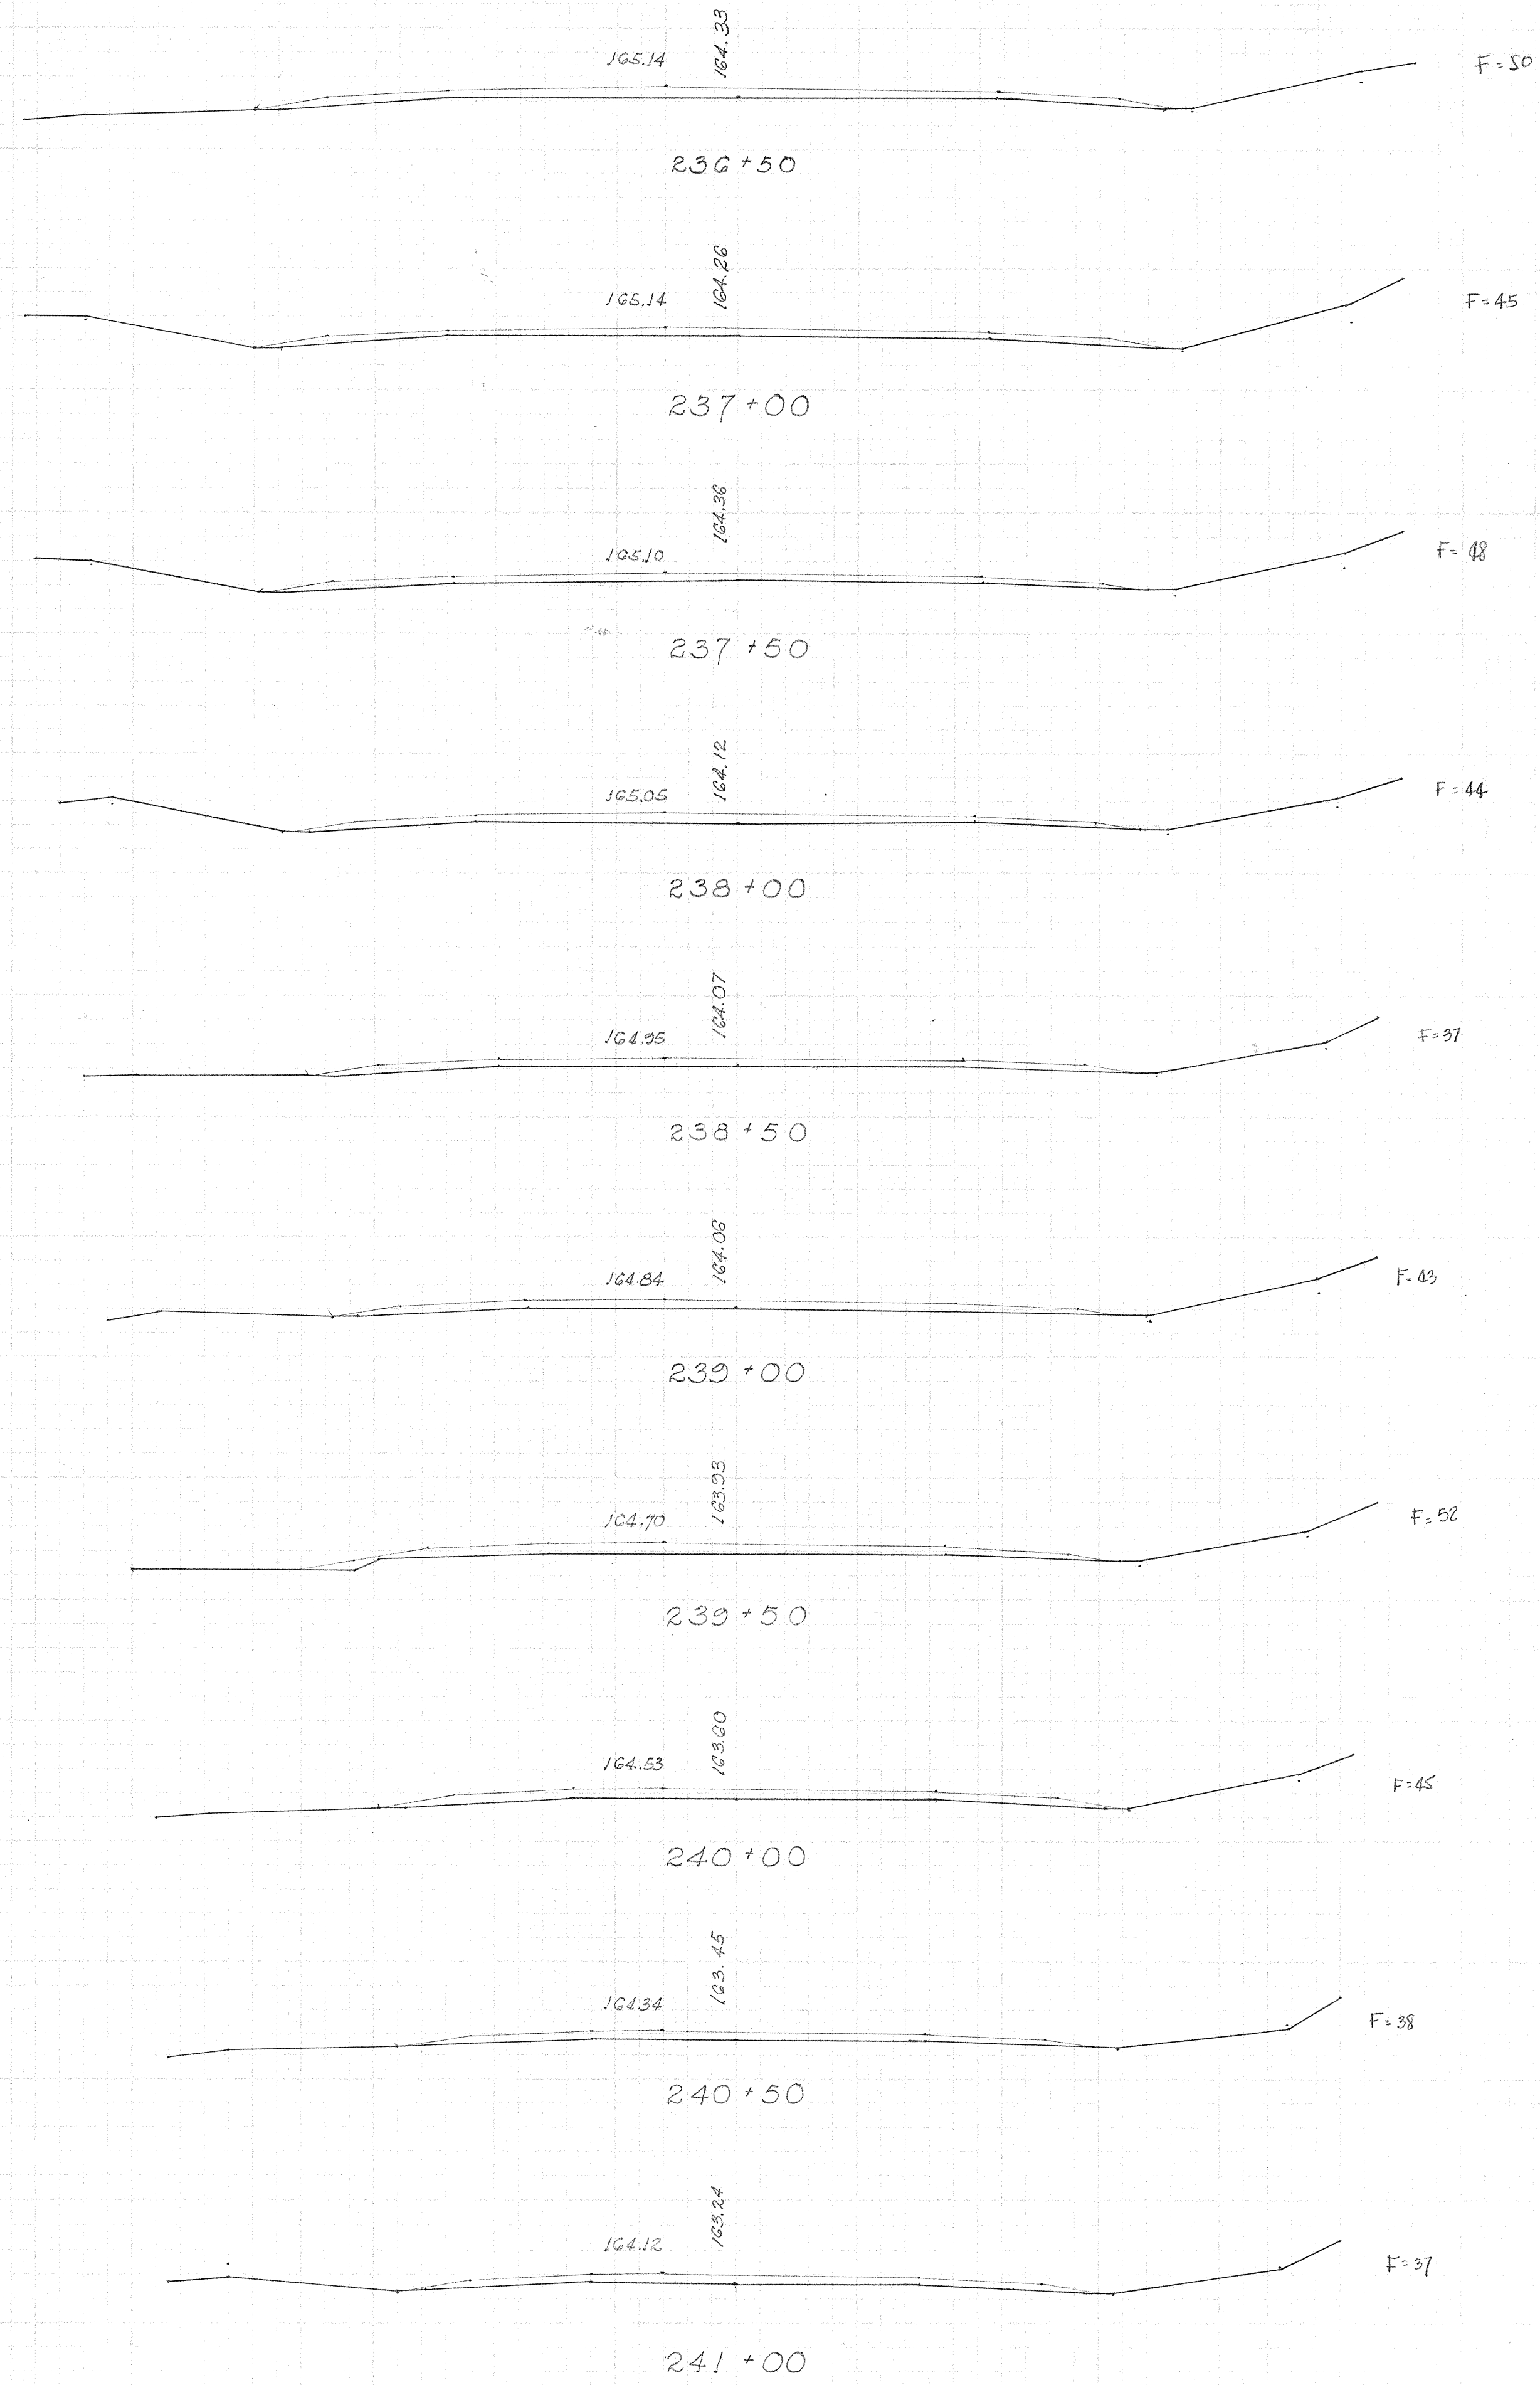



Kailua-Kawaihae Road Phase III B
Project No. 103C-01-71

FINAL	SURVEYED	DATE
SURVEY	PLOTTED	
NOTE BOOK	DATE	
NO.	REAS. CHECKED	

ORIGINAL	SUPPLY	DATE
SURVEY	PLOTTED	9-10-74
NOTE BOOK	DATE	9-17-74
NO.	REAS. CHECKED	9-19-74



Horizontal Control
Vertical Control
K. P. K.

9.8%

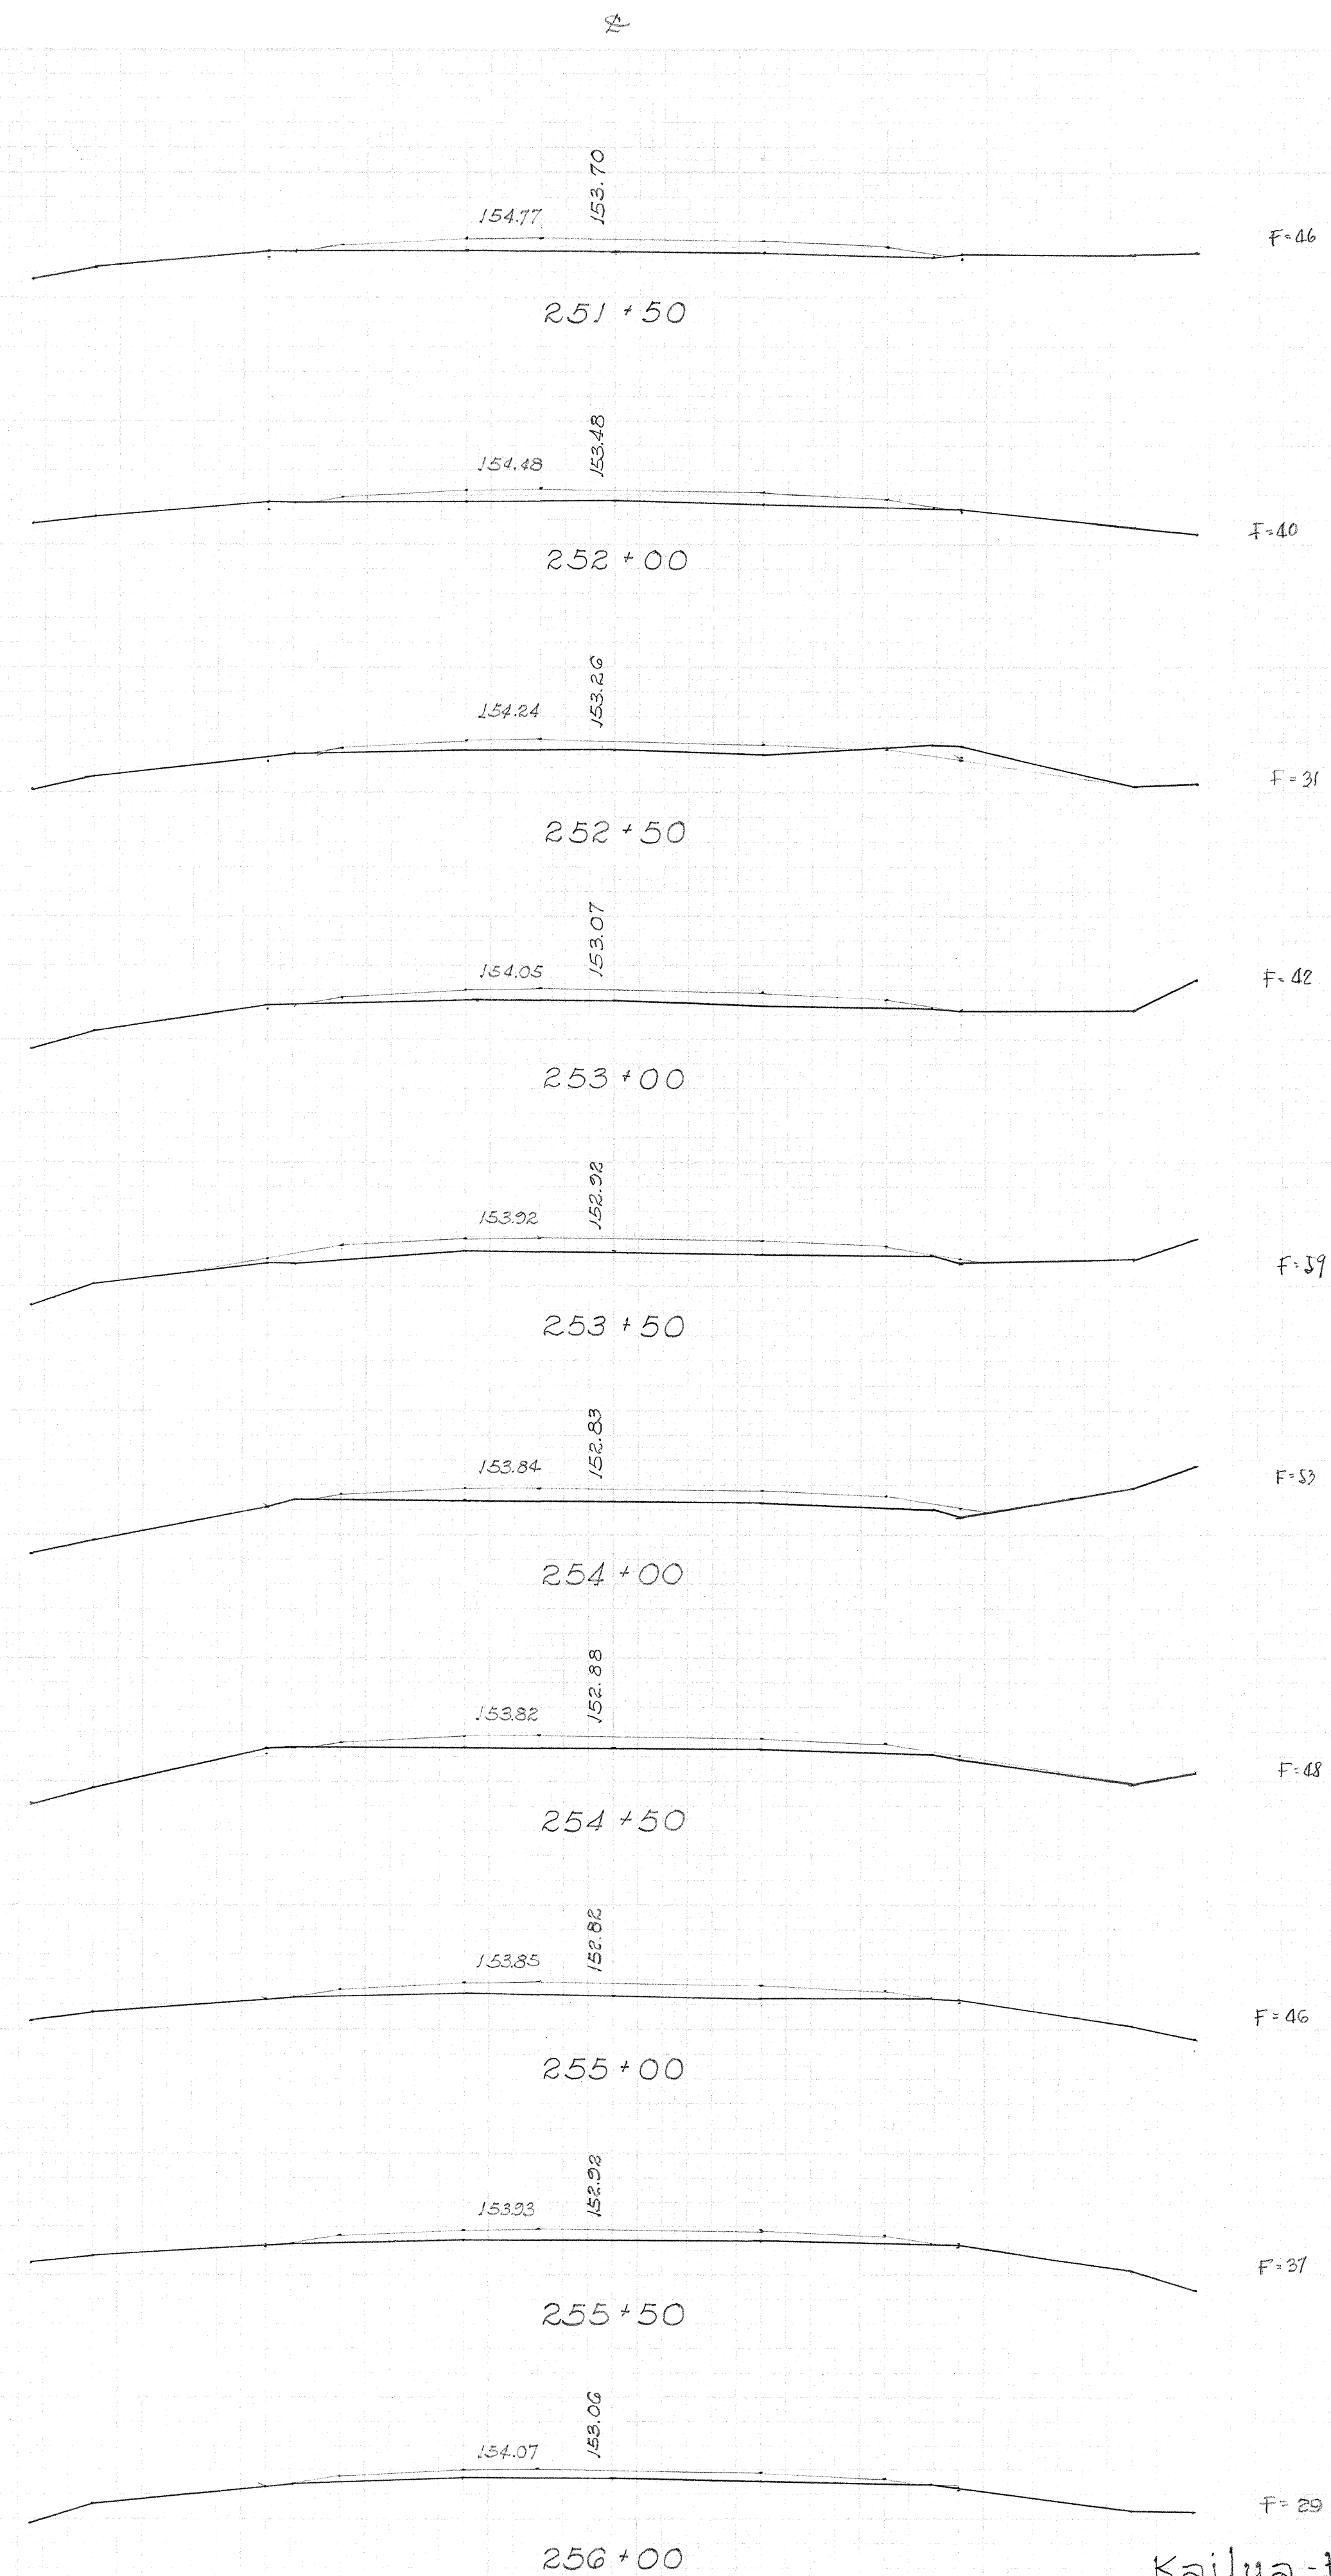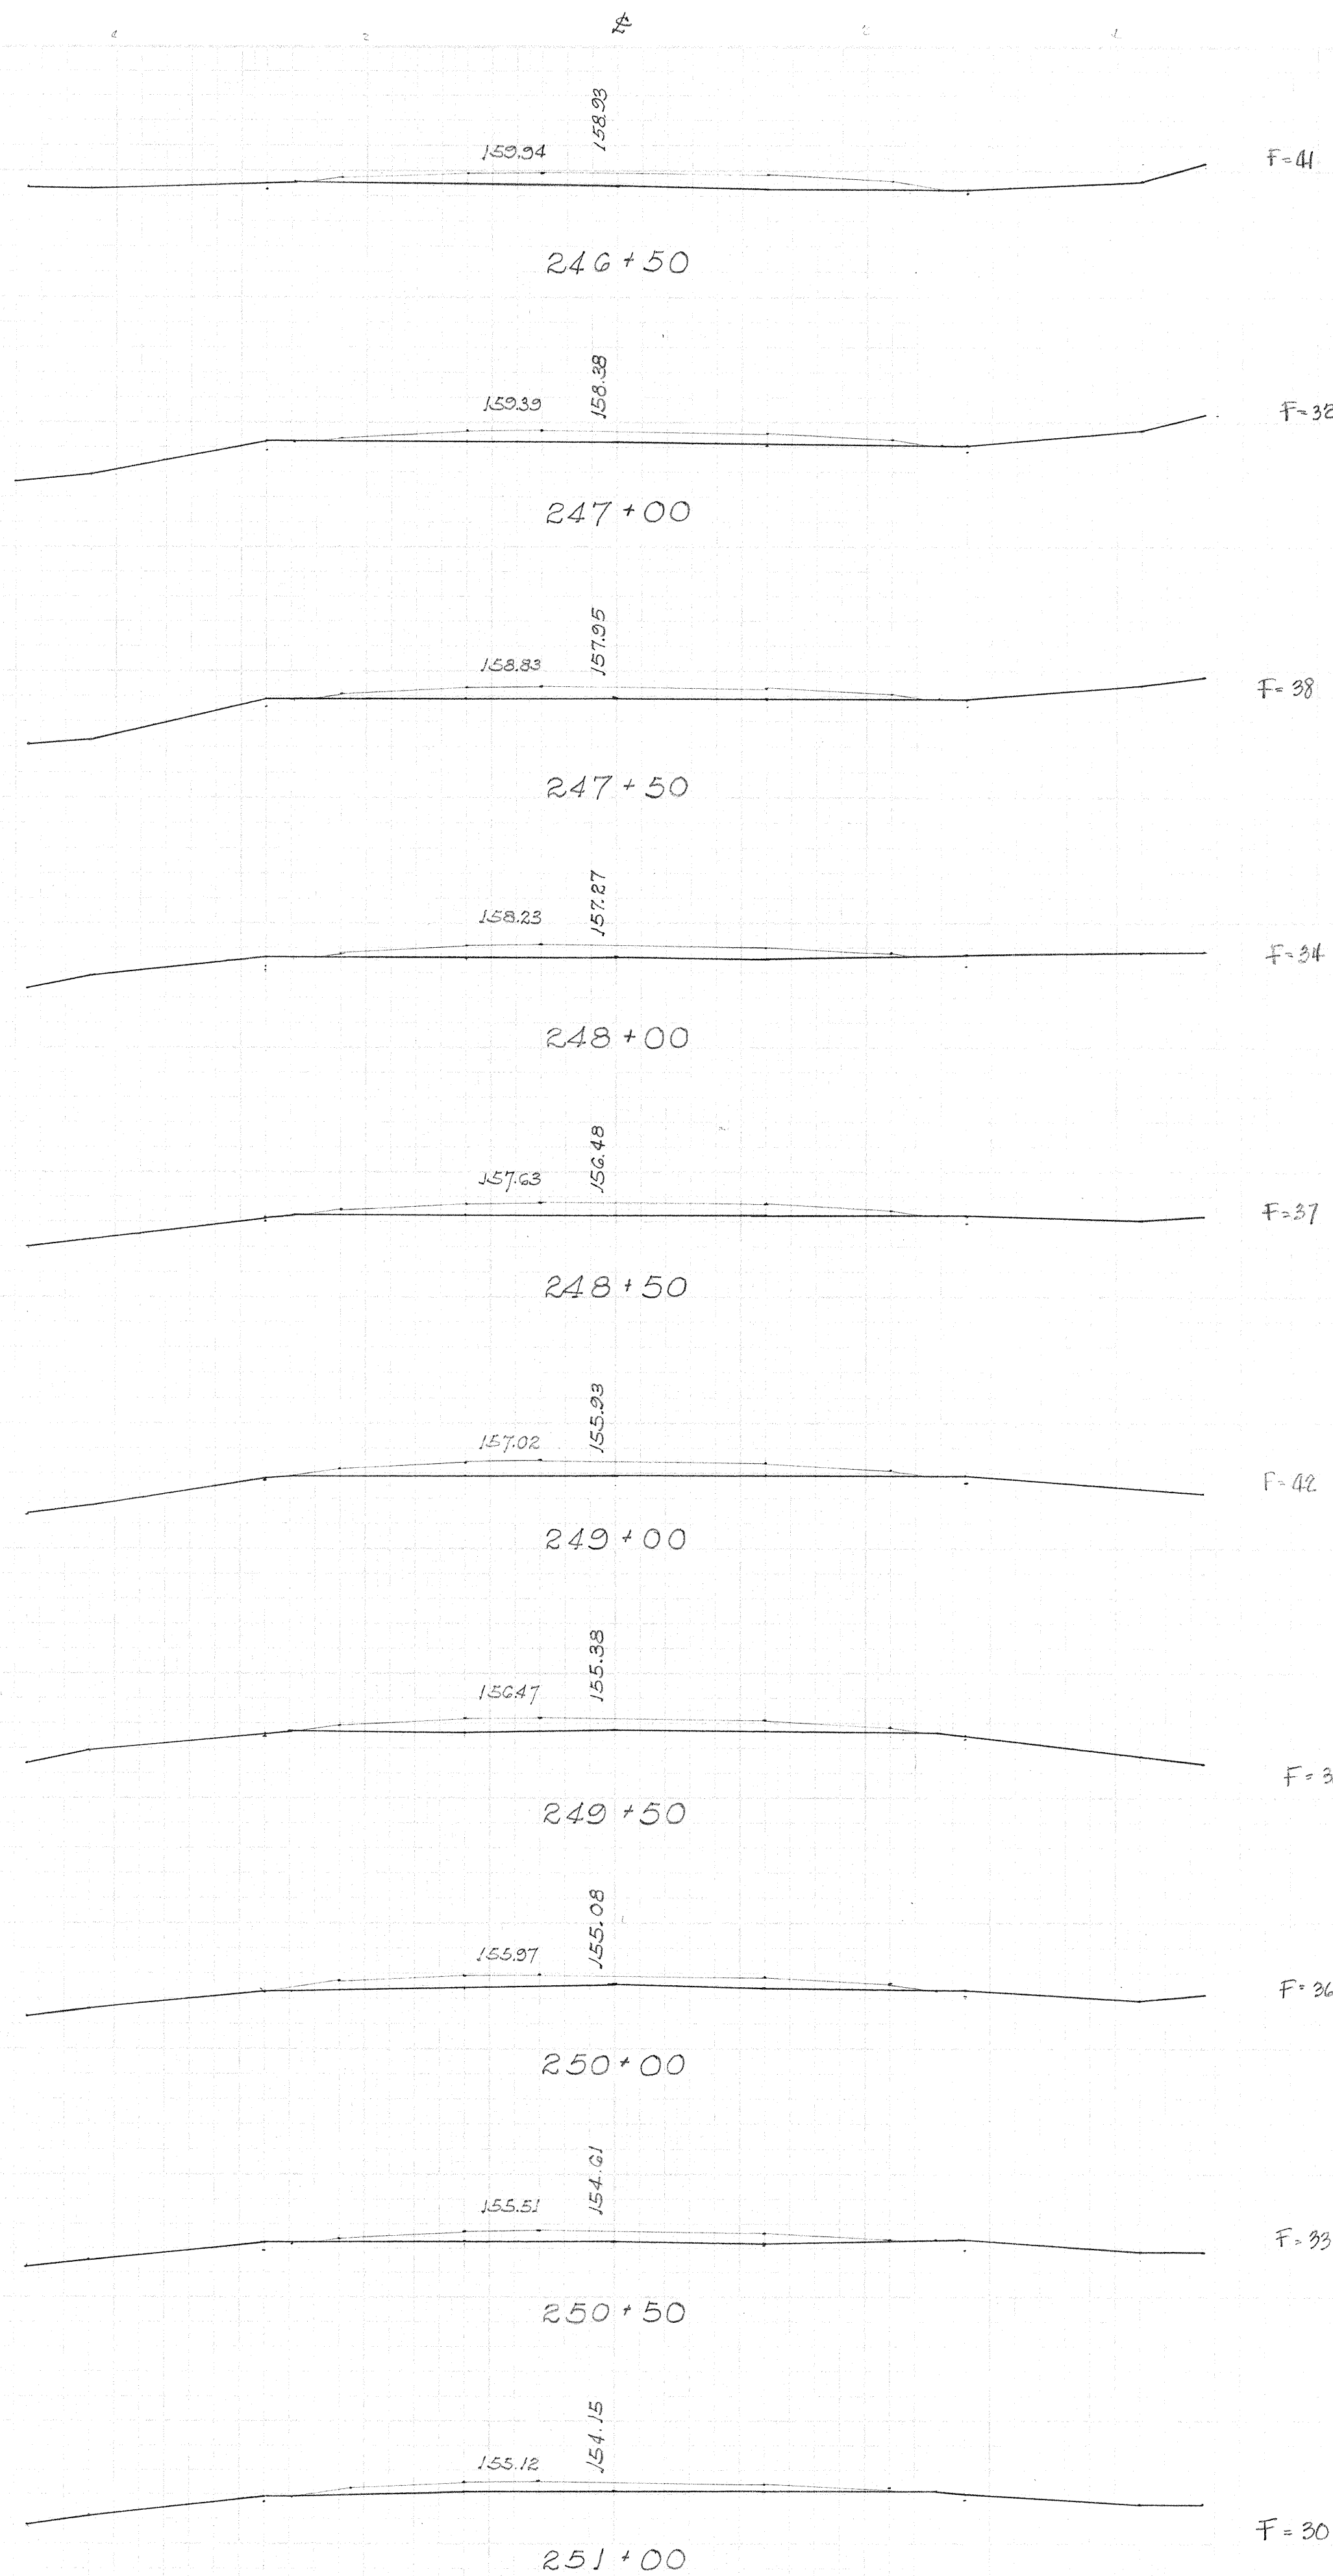

Kailua-Kawaihae Road Phase III B
Project No. 17BC-01-71


ORIGINAL	REF. NO.	DATE
SUPPLY	100-30	7-11-74
NOTE BOOK	100-30	9-17-74
Gr. 2143	100-30	9-17-74
	100-30	9-19-74

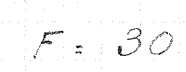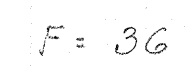

Kailua-Kawaihae Road Phase III B
Project No. 19BC-01-71

FINAL	SUPPLEMENT	DATE
SURVEY	NO. 2267	11/14
	NO. 2267	11/14
	NO. 2267	11/14

ORIGINAL	SUPPLEMENT	DATE
SURVEY	NO. 2267	11/14
	NO. 2267	11/14
	NO. 2267	11/14

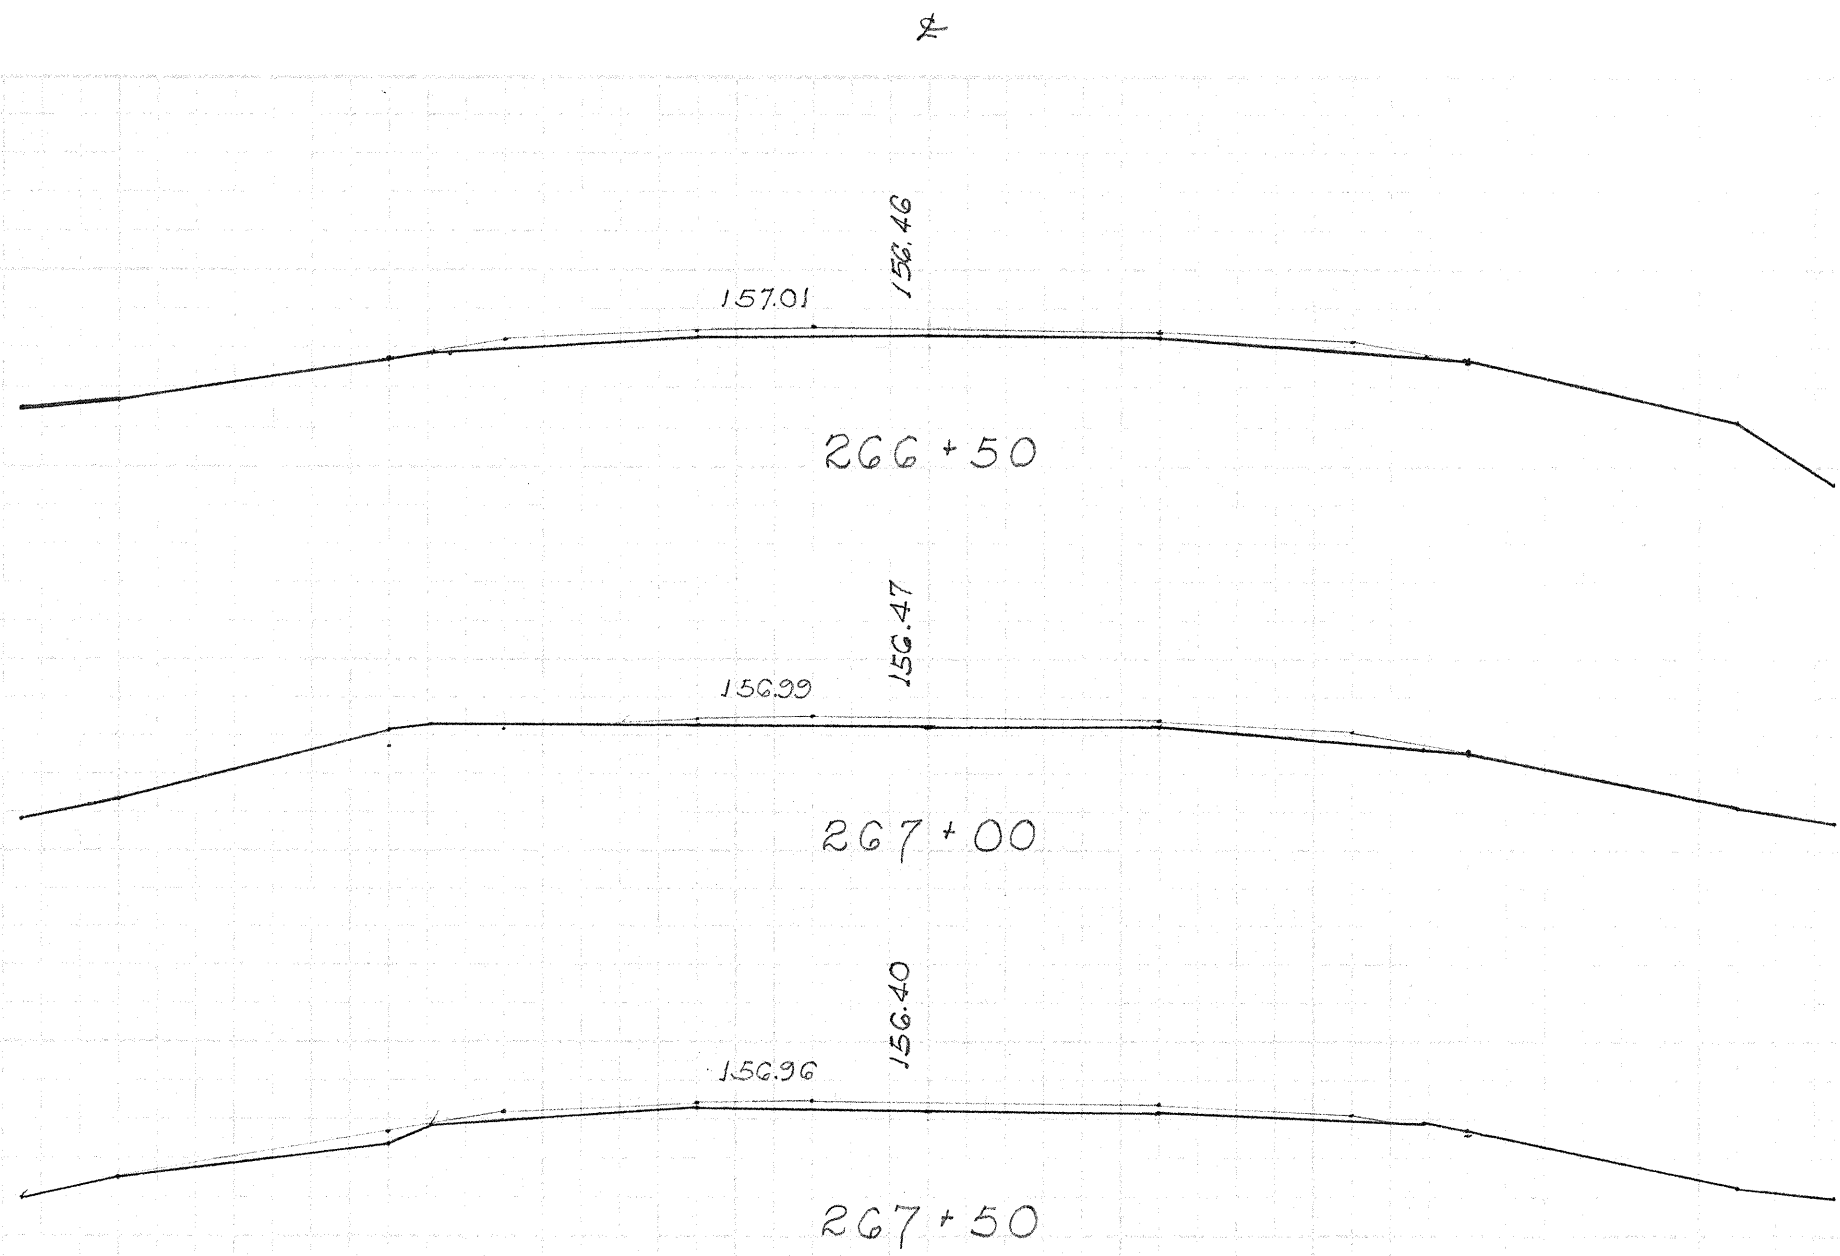

F=28

F=22

F=23

Kailua-Kawaihae Road Phase III B
Project No. 19BC-01-71