


DATE	
BY	
CHECKED	
DESIGNED	
IN CHARGE	
APPROVED	

DATE	
BY	
CHECKED	
DESIGNED	
IN CHARGE	
APPROVED	


CRM Detail: 3/4" = 1'

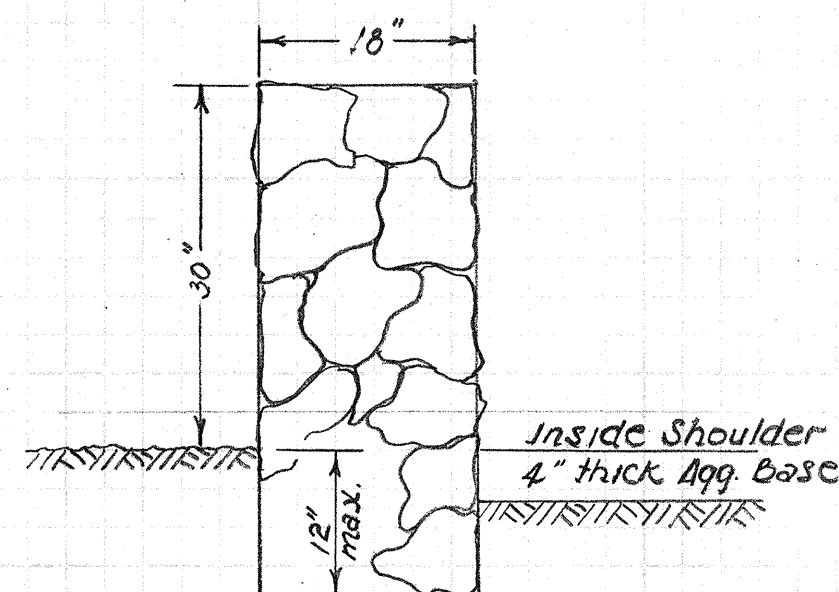

Note: Structural Exc Incidental

TYPICAL SECTION A-A


Scale: 1/4" = 1'

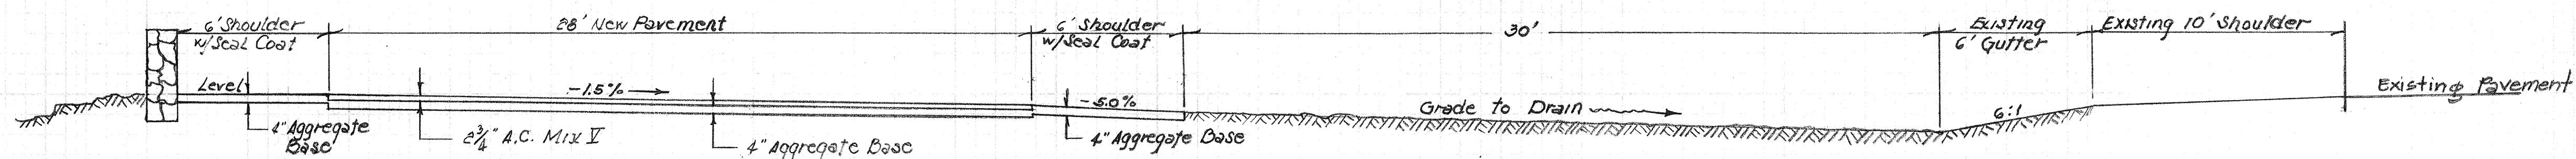

Sta. 815+40 Lt.
Furnish & Install
w/ 2 - 2" 39. Tubular Post.

Scenic Point →

Sta. 811+24
Provide Back to
back Sign w/ post
1 ea RG-1 Rt. (One Way)
1 ea RG-1 Lt.

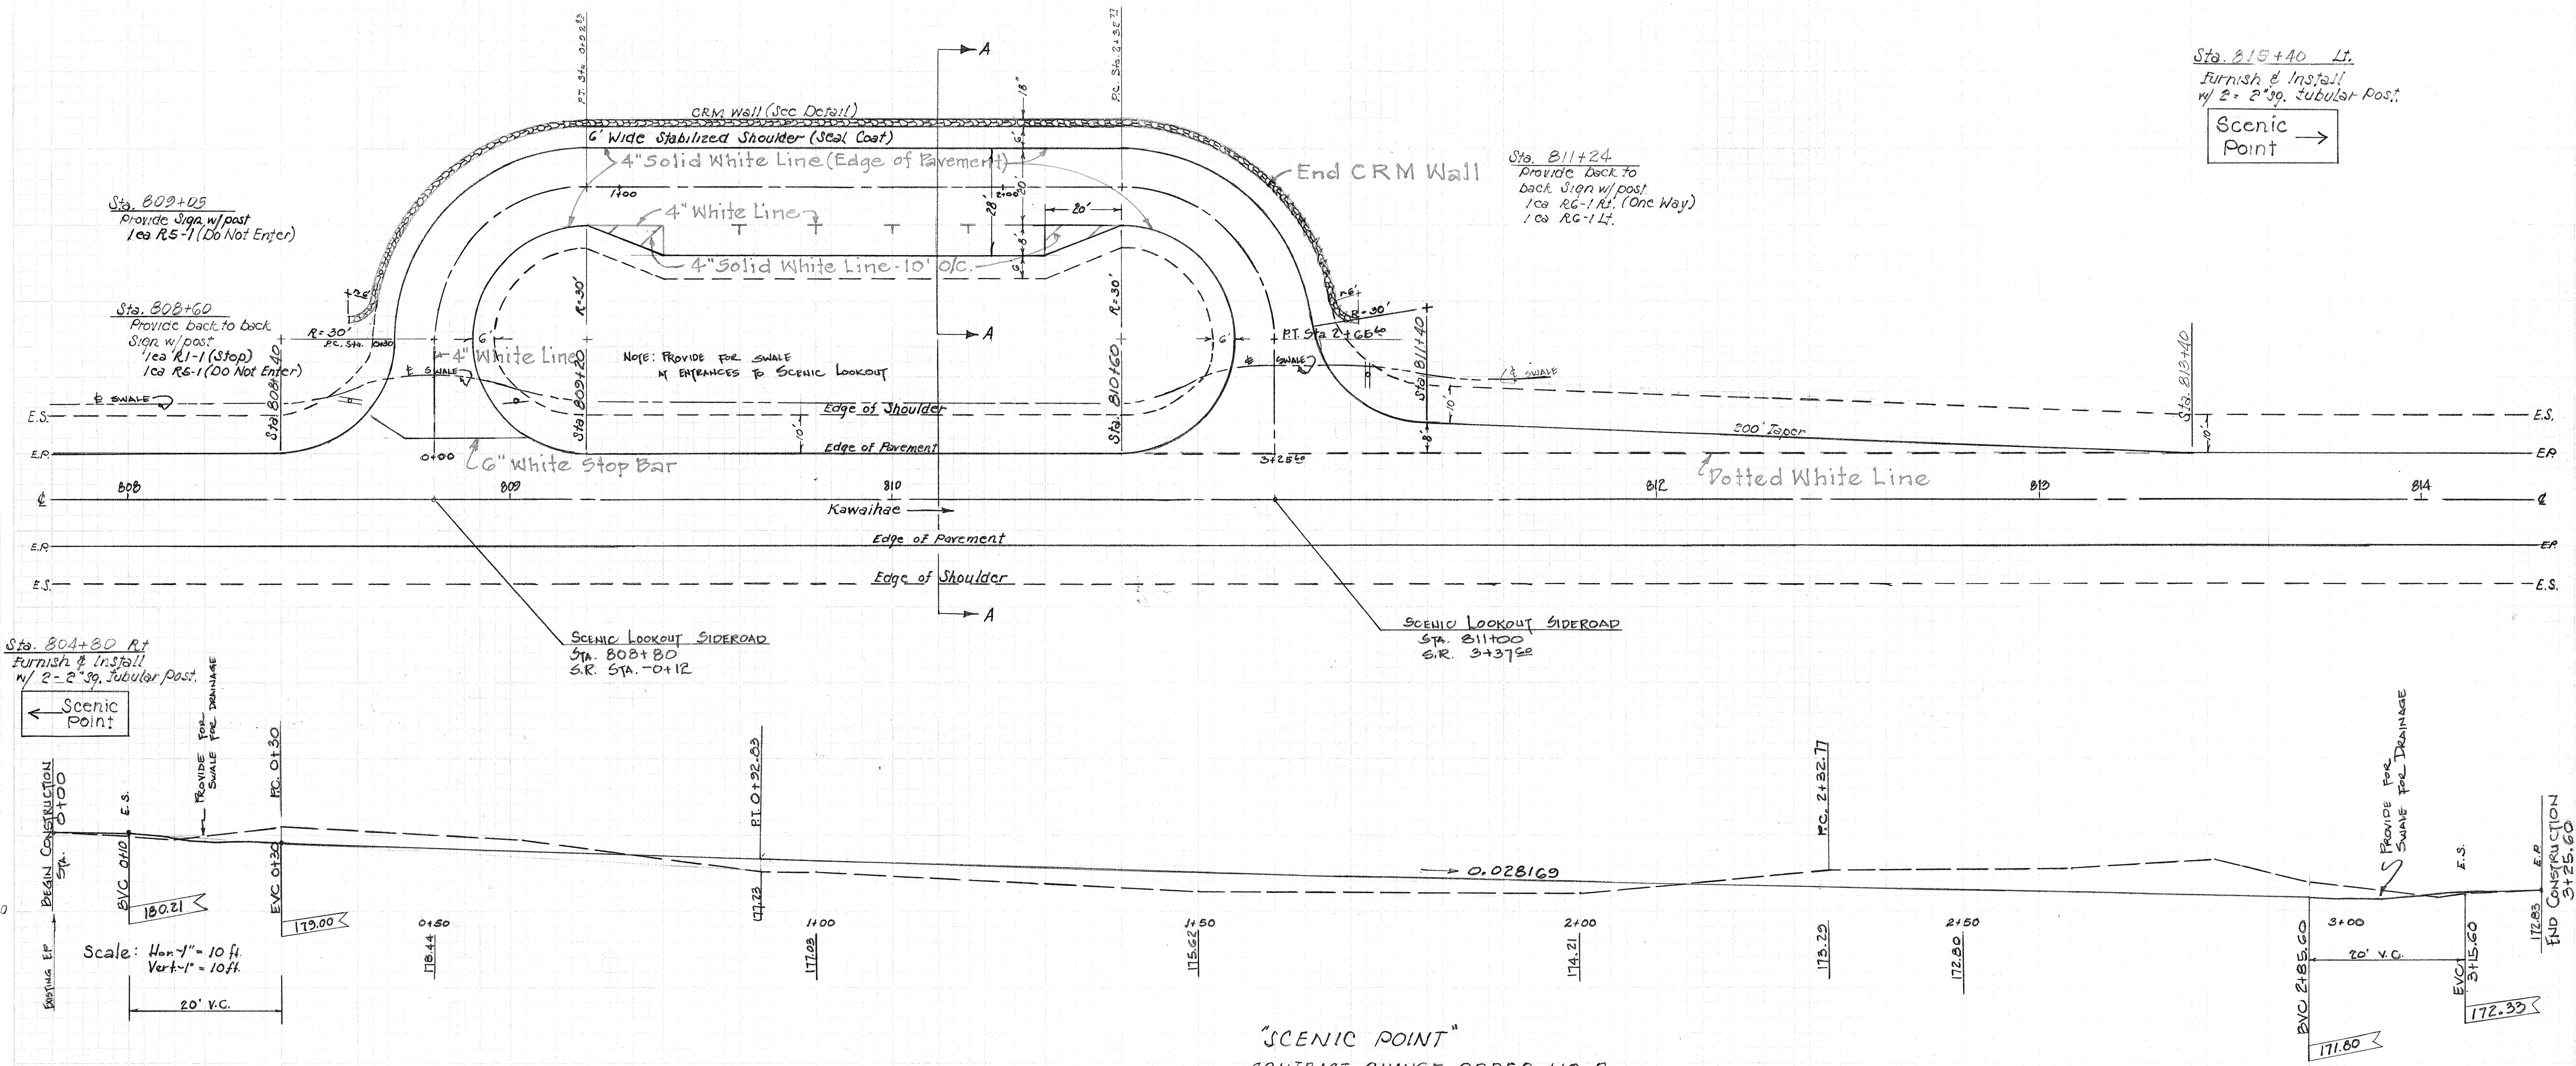

Sta. 804+80 Rt
Furnish & Install
w/ 2 - 2" 39. Tubular Post.

Scenic Point ←

SCENIC LOOKOUT SIDEROAD
Sta. 808+80
S.R. STA. -0+12

SCENIC LOOKOUT SIDEROAD
Sta. 811+00
S.R. 3+37.52

Scale: Hor-1" = 10 ft.
Vert-1" = 10 ft.

"SCENIC POINT"
CONTRACT CHANGE ORDER NO. 2
Kailua-Kowai Road, Phase III B
Project No. 10 BC-01-71