



STATE	PROJ. NO.	FISCAL YEAR	SHEET NO.	TOTAL SHEETS
HAW.	1980-01-71	1974	64	64

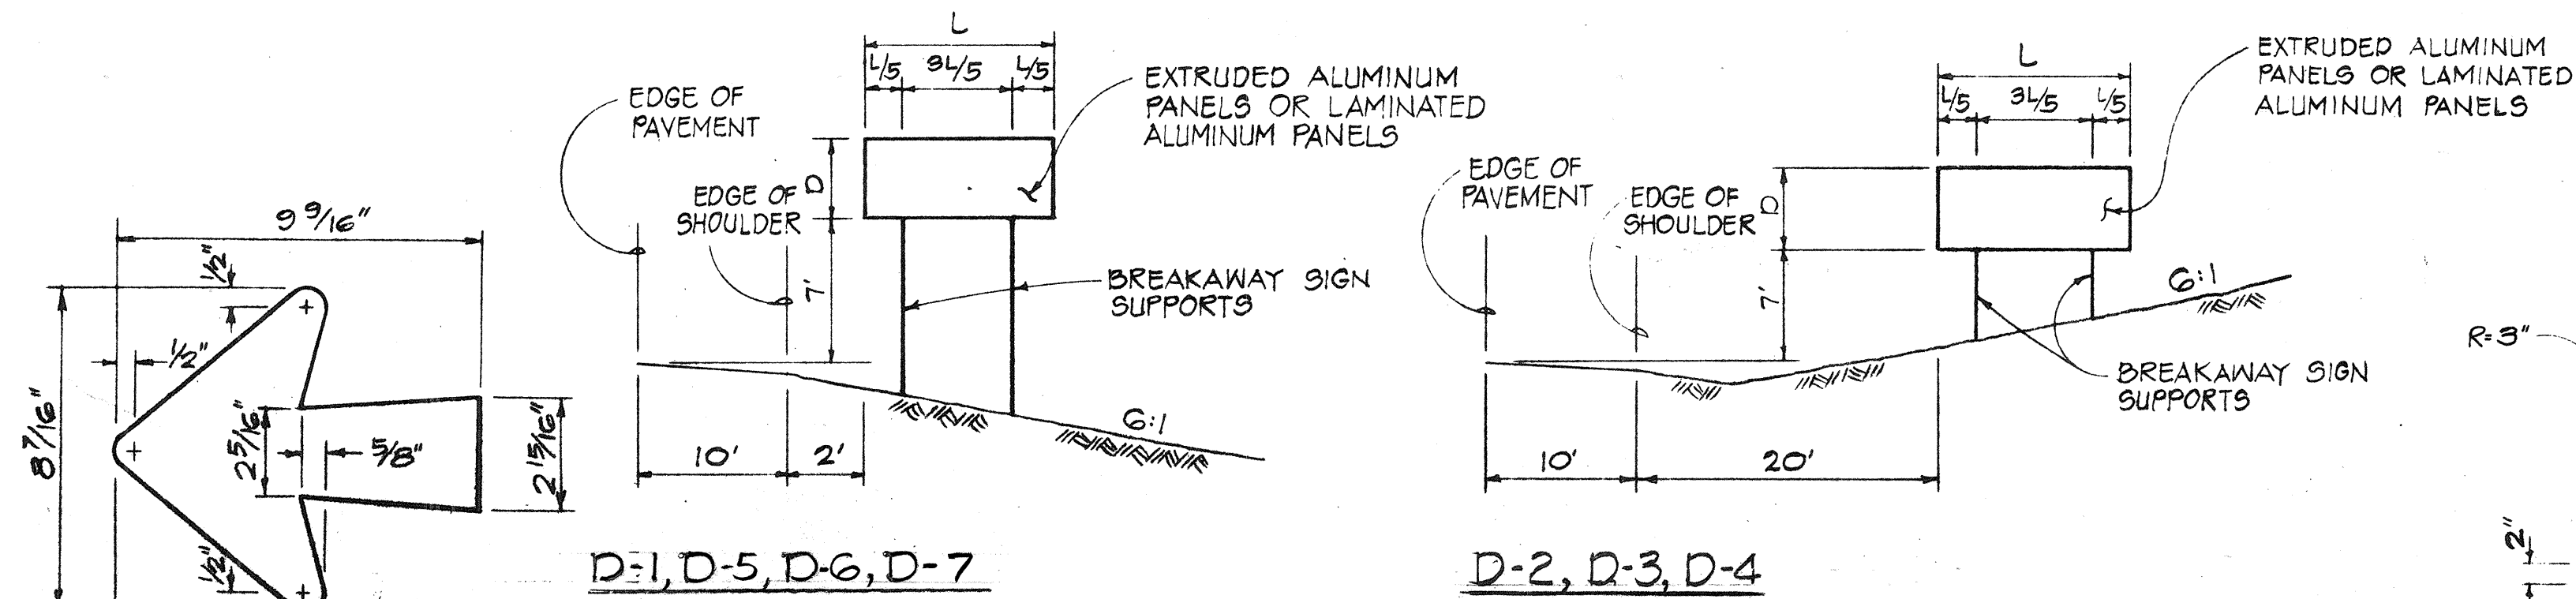


PLACEMENT OF DESTINATION SIGNS
NOT TO SCALE

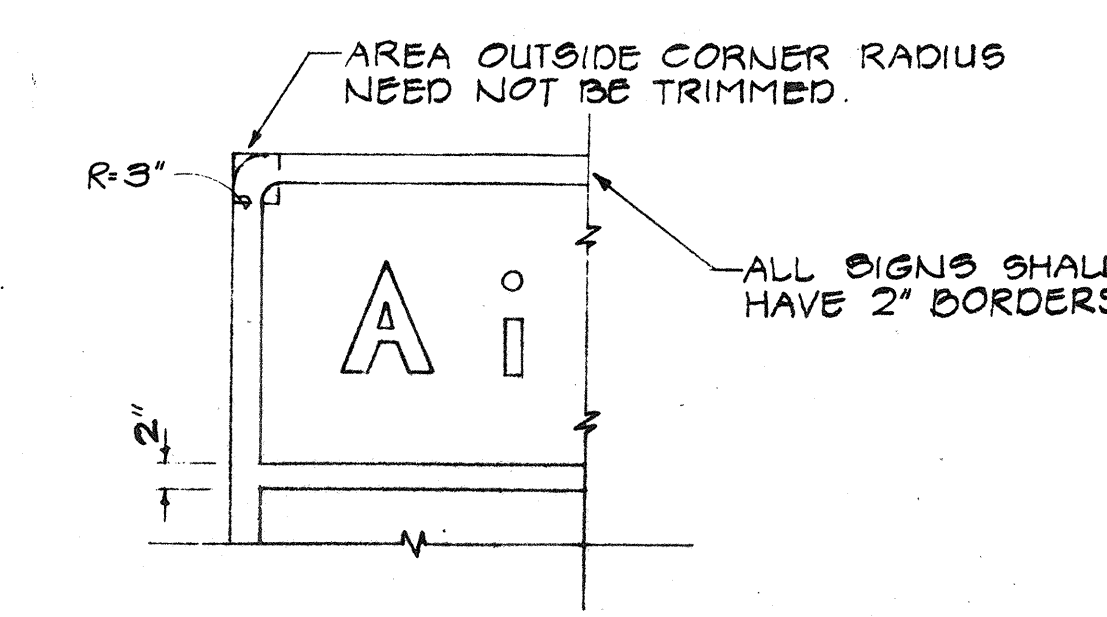

TYPICAL BORDER DETAIL
NOT TO SCALE

SIGN NO.	DESCRIPTION	EQ. FT.	TYPE POST
D-1	← Kawaihae 27 Kailua 8 →	40	4177
D-2	↑ Kawaihae 27 ← Airport	38	4177
D-3	↑ Kailua 8 Airport →	30	3157
D-4	← Anaehoomalu	20	315.7
D-5	↑ Kawaihae 21 ← Kaupulehu 2	38	417.7
D-6	← Kawaihae 21 Kailua 14 →	38	417.7
D-7	↑ Kailua 14 Kaupulehu 2 →	38	417.7

- GENERAL NOTES:
- LETTERS & NUMERALS SHALL CONFORM TO THE MANUAL "STANDARD ALPHABETS FOR HIGHWAY SIGNS," BUREAU OF PUBLIC ROADS 1966, USE SERIES "E" MODIFIED LETTERS & NUMERALS.
 - ARROWS & BORDERS SHALL CONFORM WITH DETAILS AS SHOWN ON PLANS.
 - SIGN MESSAGE & BORDERS SHALL HAVE WHITE REFLECTIVE SHEETING ON DEMOUNTABLE ALUMINUM CUT-OUTS ON GREEN REFLECTIVE SHEETING BACKGROUND.
 - CUT-OUTS SHALL BE FASTENED TO SIGN PANEL WITH ALUMINUM BLIND RIVETS.
 - ALL DESTINATION SIGNS SHALL BE MOUNTED ON BREAKAWAY POSTS. SEE STANDARD DETAILS DT 203 AND DT 204 (SHTS. 52 & 53)

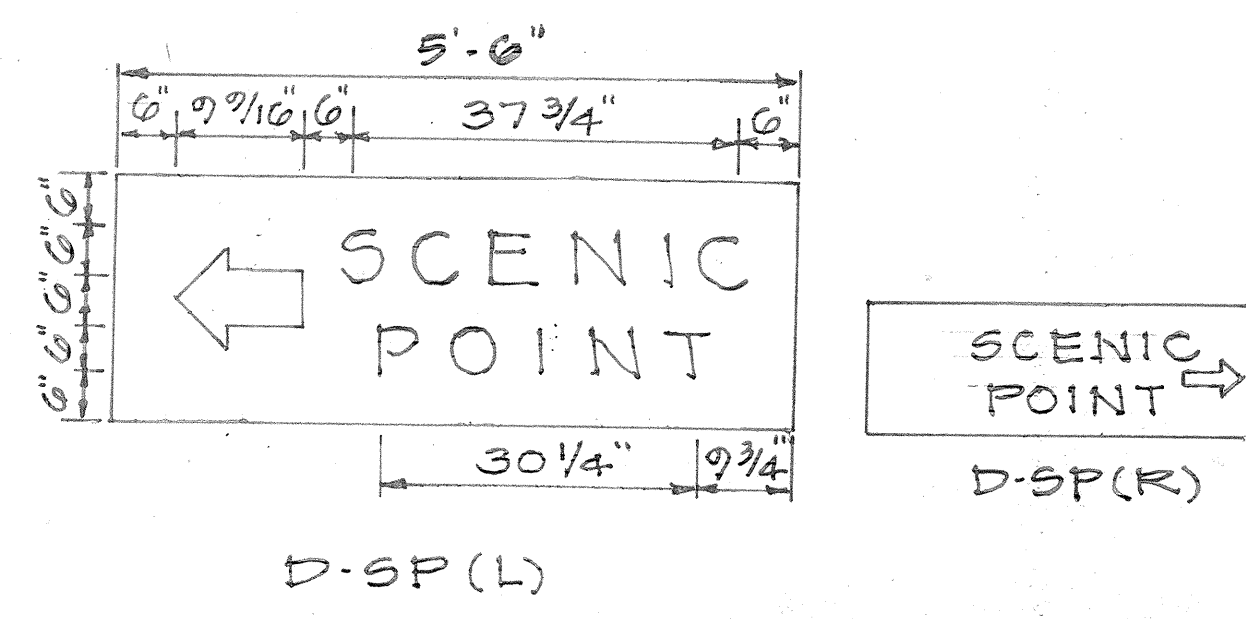

SUMMARY OF REGULATORY AND WARNING SIGNS			
TYPE	DESCRIPTION	WITHOUT POST	WITH POST
R1-1	STOP		3
R1-2	YIELD		1
R5-1	DO NOT ENTER		2
R5-9	WRONG WAY	2	
W4-1 (R)	MERGE		2
R2-1(50)	SPEED LIMIT 50		18
	SCENIC POINT		
R1-1	STOP		1
R5-1	DO NOT ENTER	1	1
R6-1 (1-2)	ONE WAY	1	1

SUMMARY OF GUIDE SIGNS			
SIZE	LOCATIONS	% POST	W/POST
16"	Sta. 233+00 Ke-Ahole Airport Intersection		2
24"	"		1
16"	Sta. 543+80 Kukio Sideroad Intersection		2
16"	Sta. 1143+50 Anaehoomalu Bay Intersection		2
24"	"		1
16"	Sta. 1197+60 Boise Cascade Intersection		2
24"	"		1

SUMMARY OF CONSTRUCTION SIGNS			
TYPE	DESCRIPTION	WITHOUT POST	WITH POST
CW20-1a	ROAD CONSTRUCTION (1500 FT)		2

FRANK J. DOYE
REGISTERED PROFESSIONAL ENGINEER
No. 2719
HAWAII, U.S.A.

THIS WORK WAS PREPARED BY ME OR UNDER MY SUPERVISION.
Frank J. Doye
SIGNATURE

STATE OF HAWAII
DEPARTMENT OF TRANSPORTATION
HIGHWAYS DIVISION

**DESTINATION SIGNS
AND SUMMARY OF SIGNS**

KAILUA - KAWAIIHAE ROAD
KE-AHOLE TO ANAEHOOMALU
PROJ. NO. 19 BC-01-71

SHEET No. 1 OF 1 SHEETS

DATE	
SURVEY PLANNED BY	
DRAWN BY	
CHECKED BY	
QUANTITIES BY	
NOTED BY	
ORIGINAL PLAN	
NOTE BOOK	
NO.	

