



STATE	PROJ. NO.	FISCAL YEAR	SHEET NO.	TOTAL SHEETS
HAW.	1000-01-71	1974	4	64

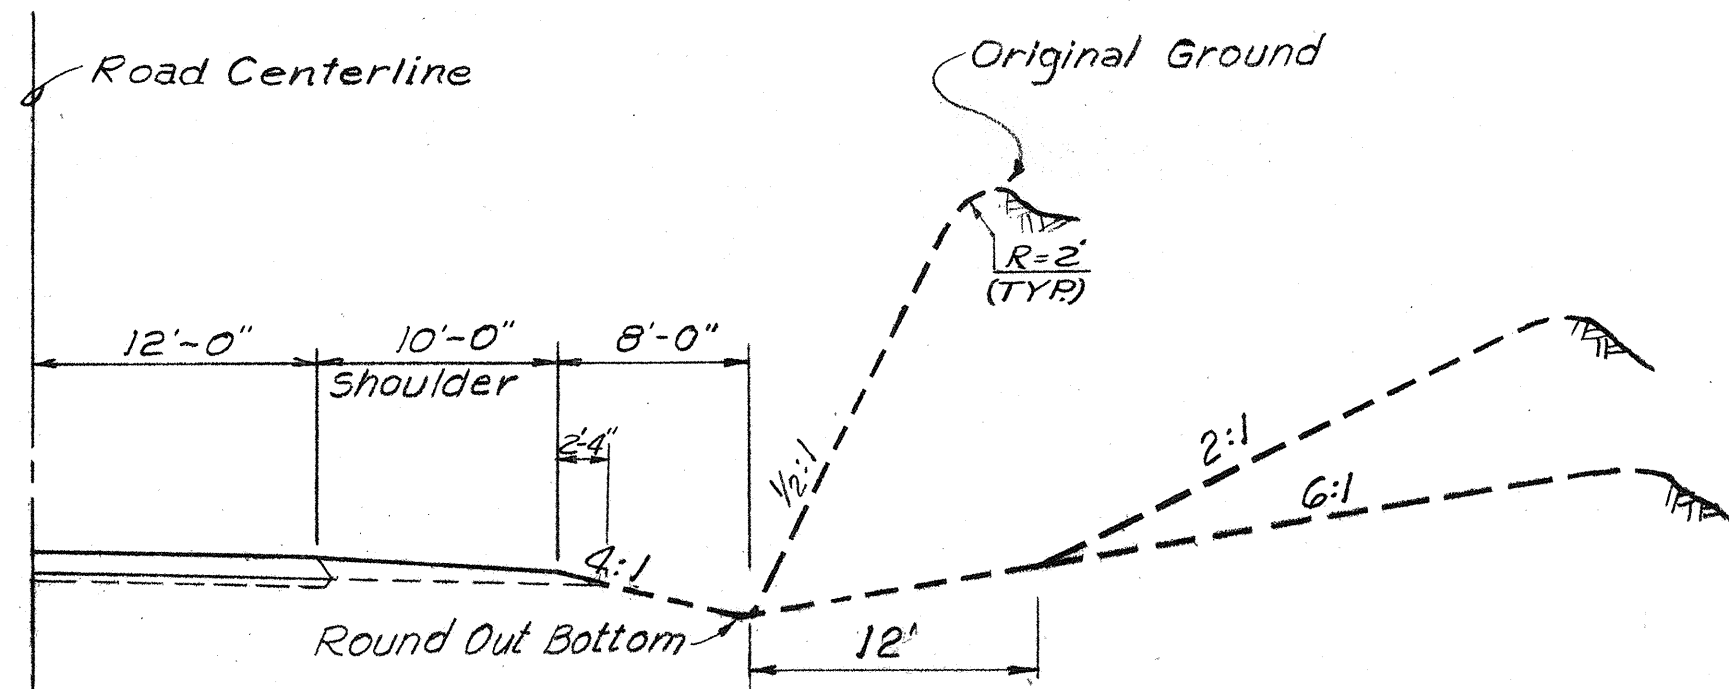

TYPE I


STA. 297+50 TO 310+00
480+00 TO 489+00
525+00 TO 534+00
657+50 TO 666+50

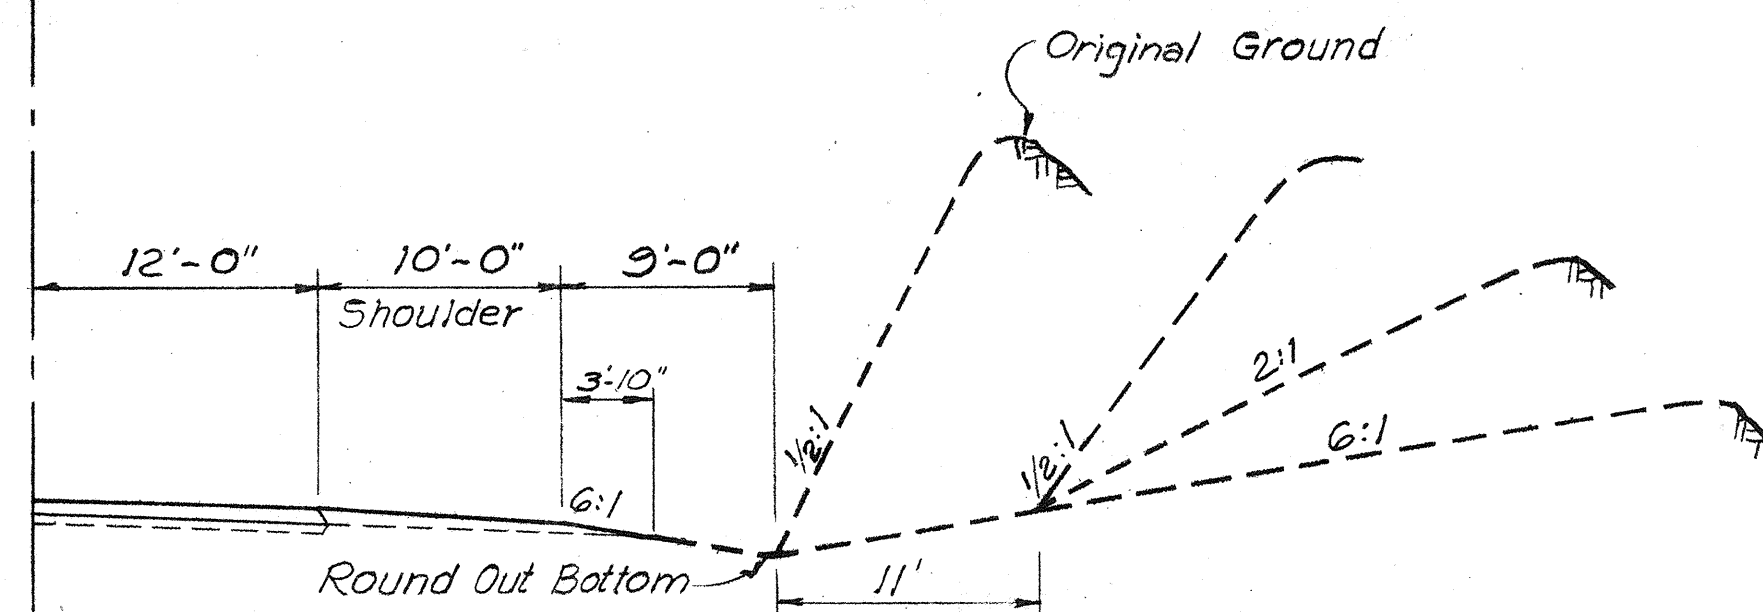

TYPE II

STA. 613+00 TO 632+00
730+00 TO 752+00
758+50 TO 761+50
790+50 TO 797+50

STA. 996+50 TO 1009+00
1036+00 TO 1037+50
~~1101+00 TO 1118+50~~
1100+00 TO 1107+50
1110+50 TO 1117+71.06

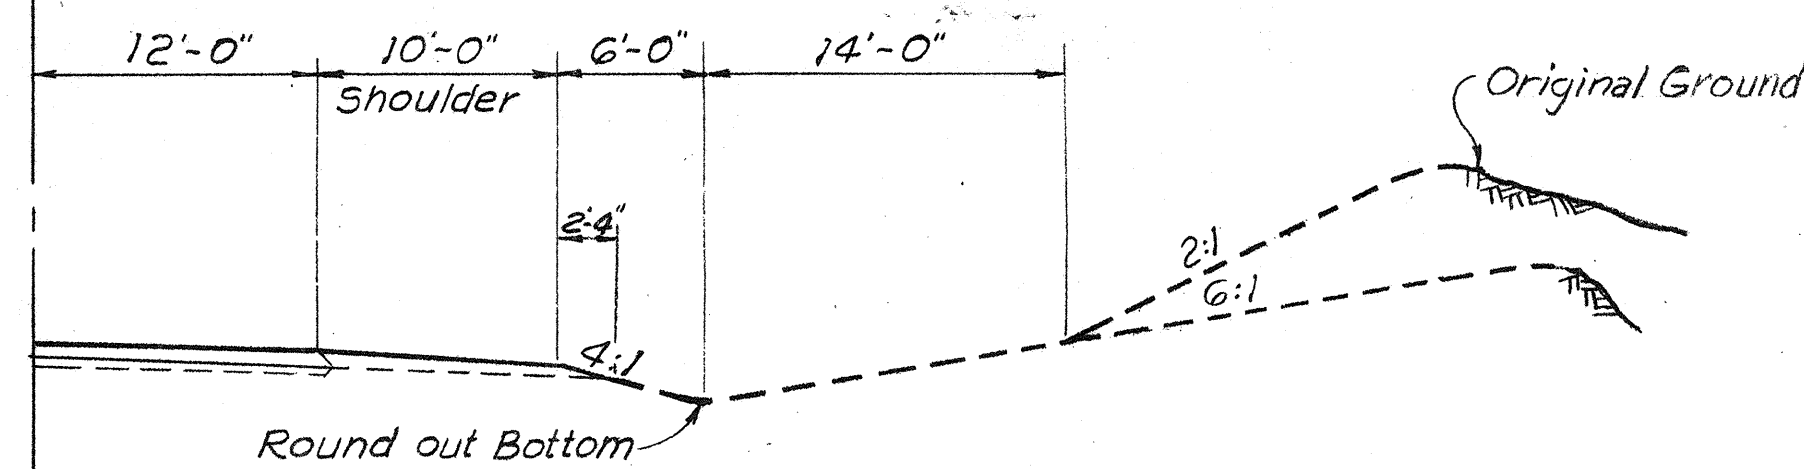


TYPE III

STA. 392+00 TO 407+00
679+00 TO 683+00
397+00 TO 397+50
399+00 TO 407+00


NOTES:

- For detail section of road, see typical ROADWAY SECTIONS, sheets 2 & 3.
- If conflict occurs between TYPICAL ROADWAY SECTIONS and SPECIAL ROADSIDE DITCH SECTIONS, the SPECIAL ROADSIDE DITCH SECTIONS shall govern.
- See Sht. 2 of 64 for Legend.

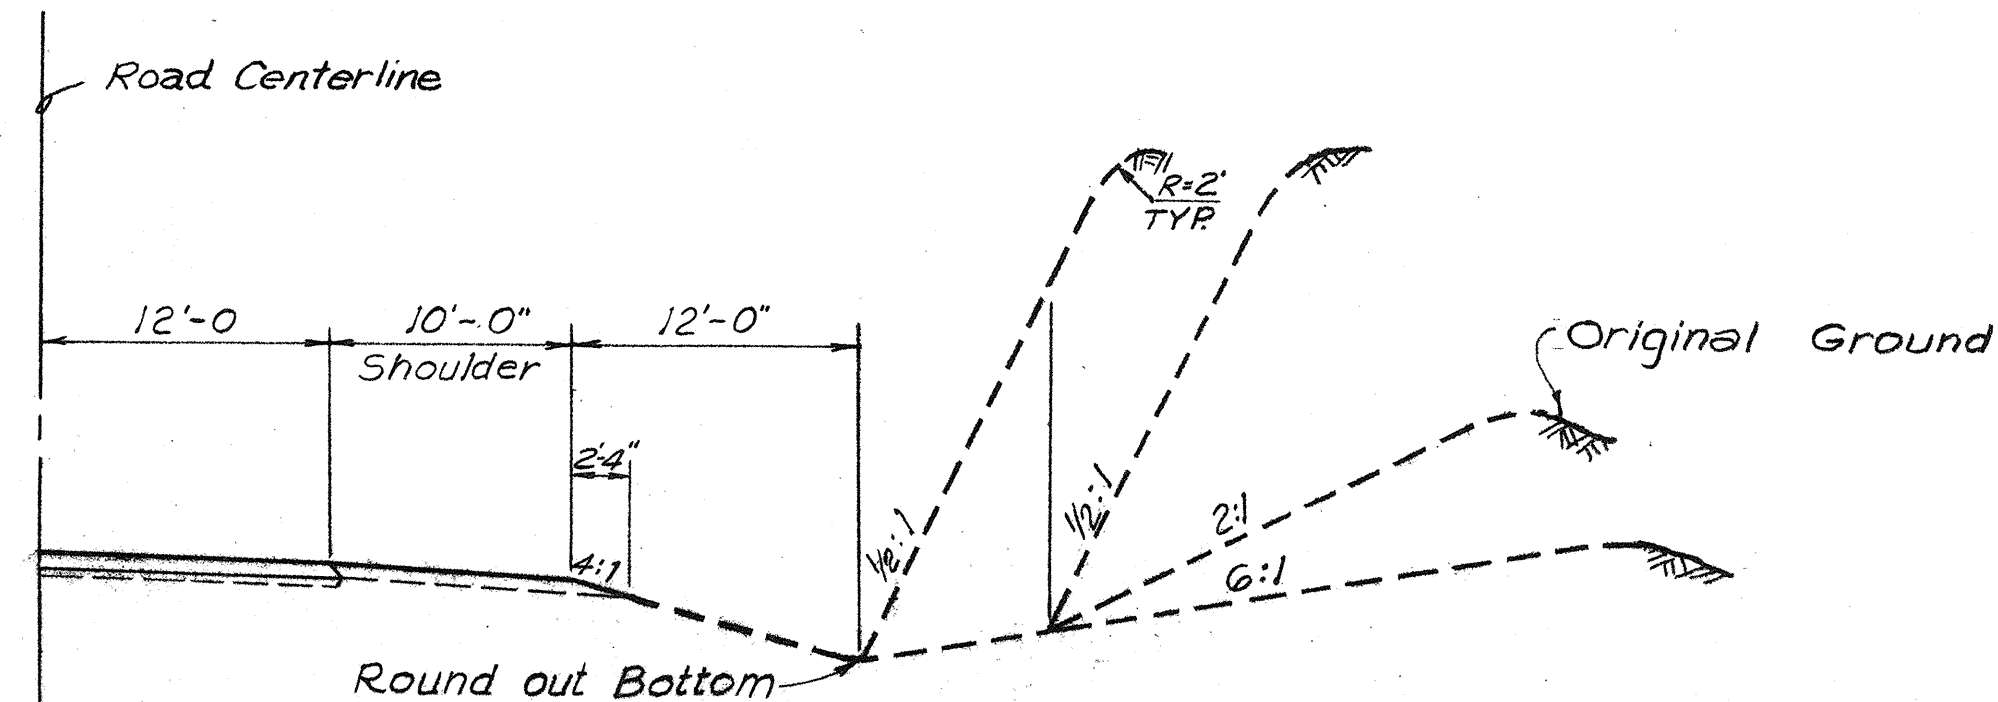


TYPE IV

STA. 271+00 TO 277+50
325+25 TO 369+75
456+75 TO 473+75
949+45 TO 973+80
947+25 TO 966+50

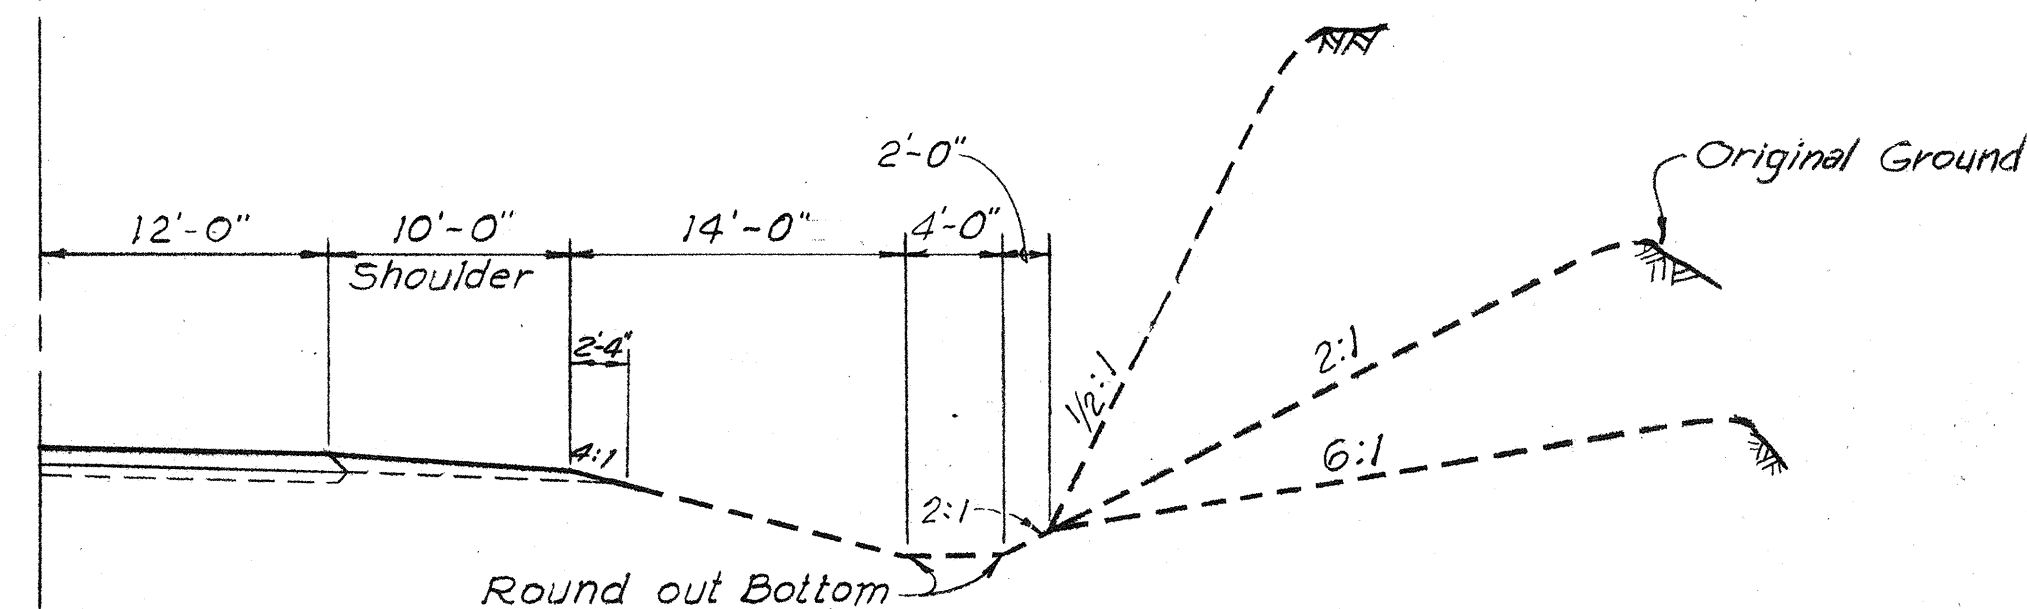


TYPE V

STA. 707+00 TO 725+00

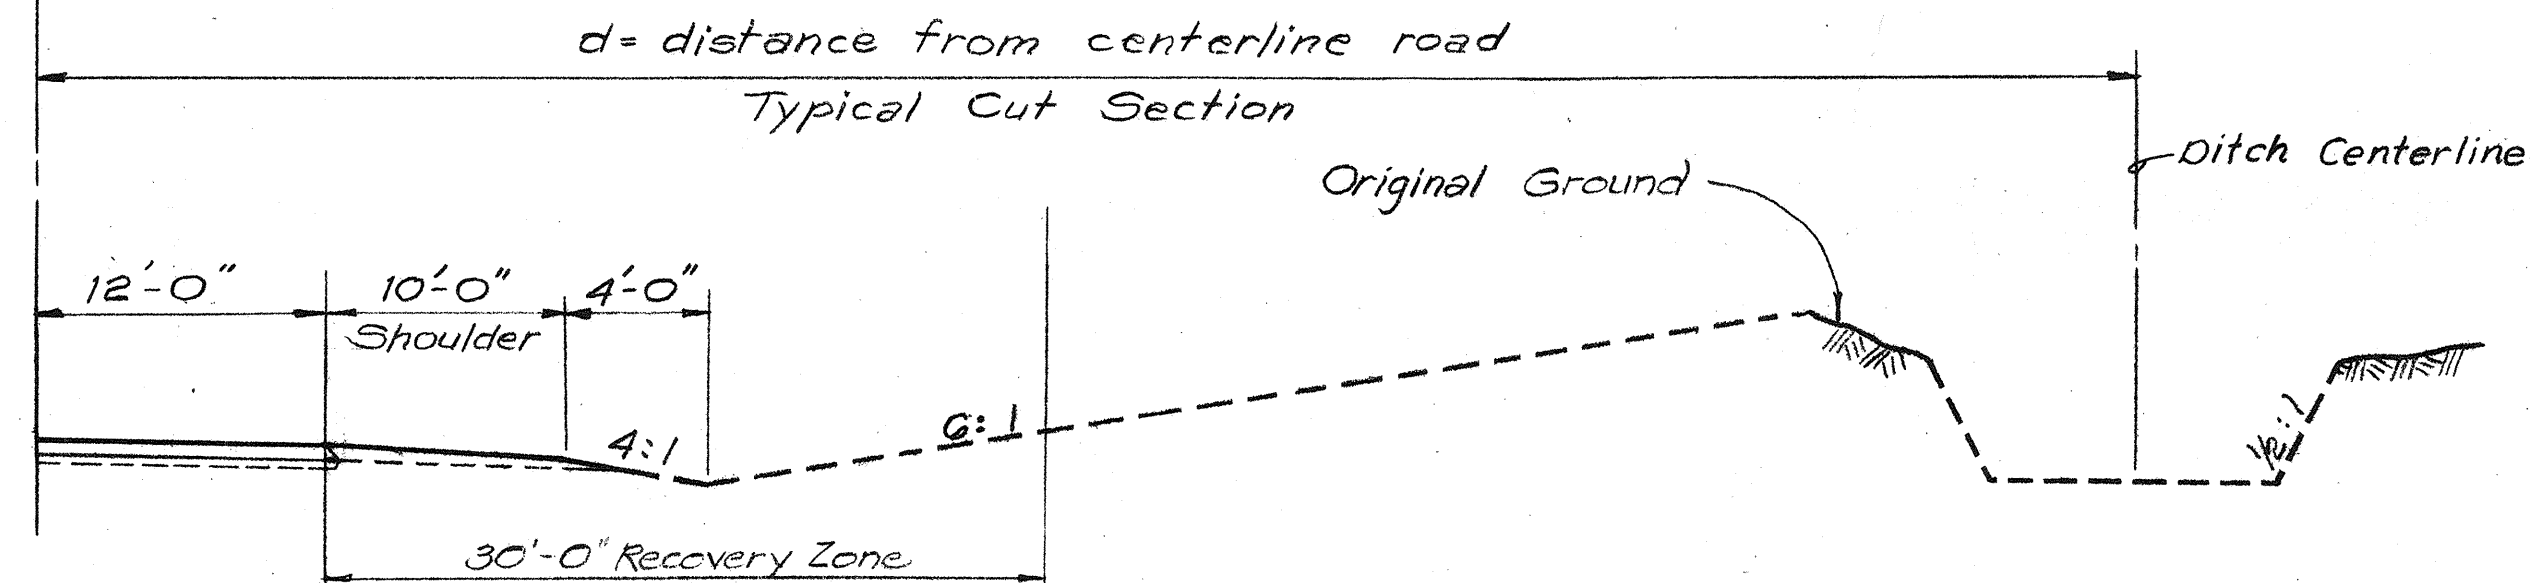

TYPE VI

STA. 602+00 TO 609+00 (d=80)
~~610+00 TO 613+00 (d=80)~~

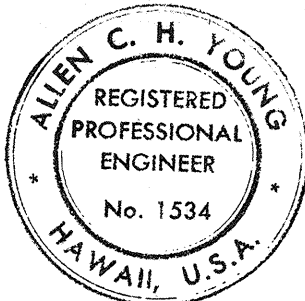

THIS WORK WAS PREPARED BY
ME OR UNDER MY SUPERVISION.
Allen C. H. Young
Signature

STATE OF HAWAII
DEPARTMENT OF TRANSPORTATION
HIGHWAYS DIVISION

SPECIAL ROADSIDE DITCH
SECTIONS

KAILUA-KAWAIHAE ROAD
(KE-AHOLE TO ANAEHOOMALU)

SCALE: AS NOTED

SHEET No. 3 OF 3 SHEETS

