
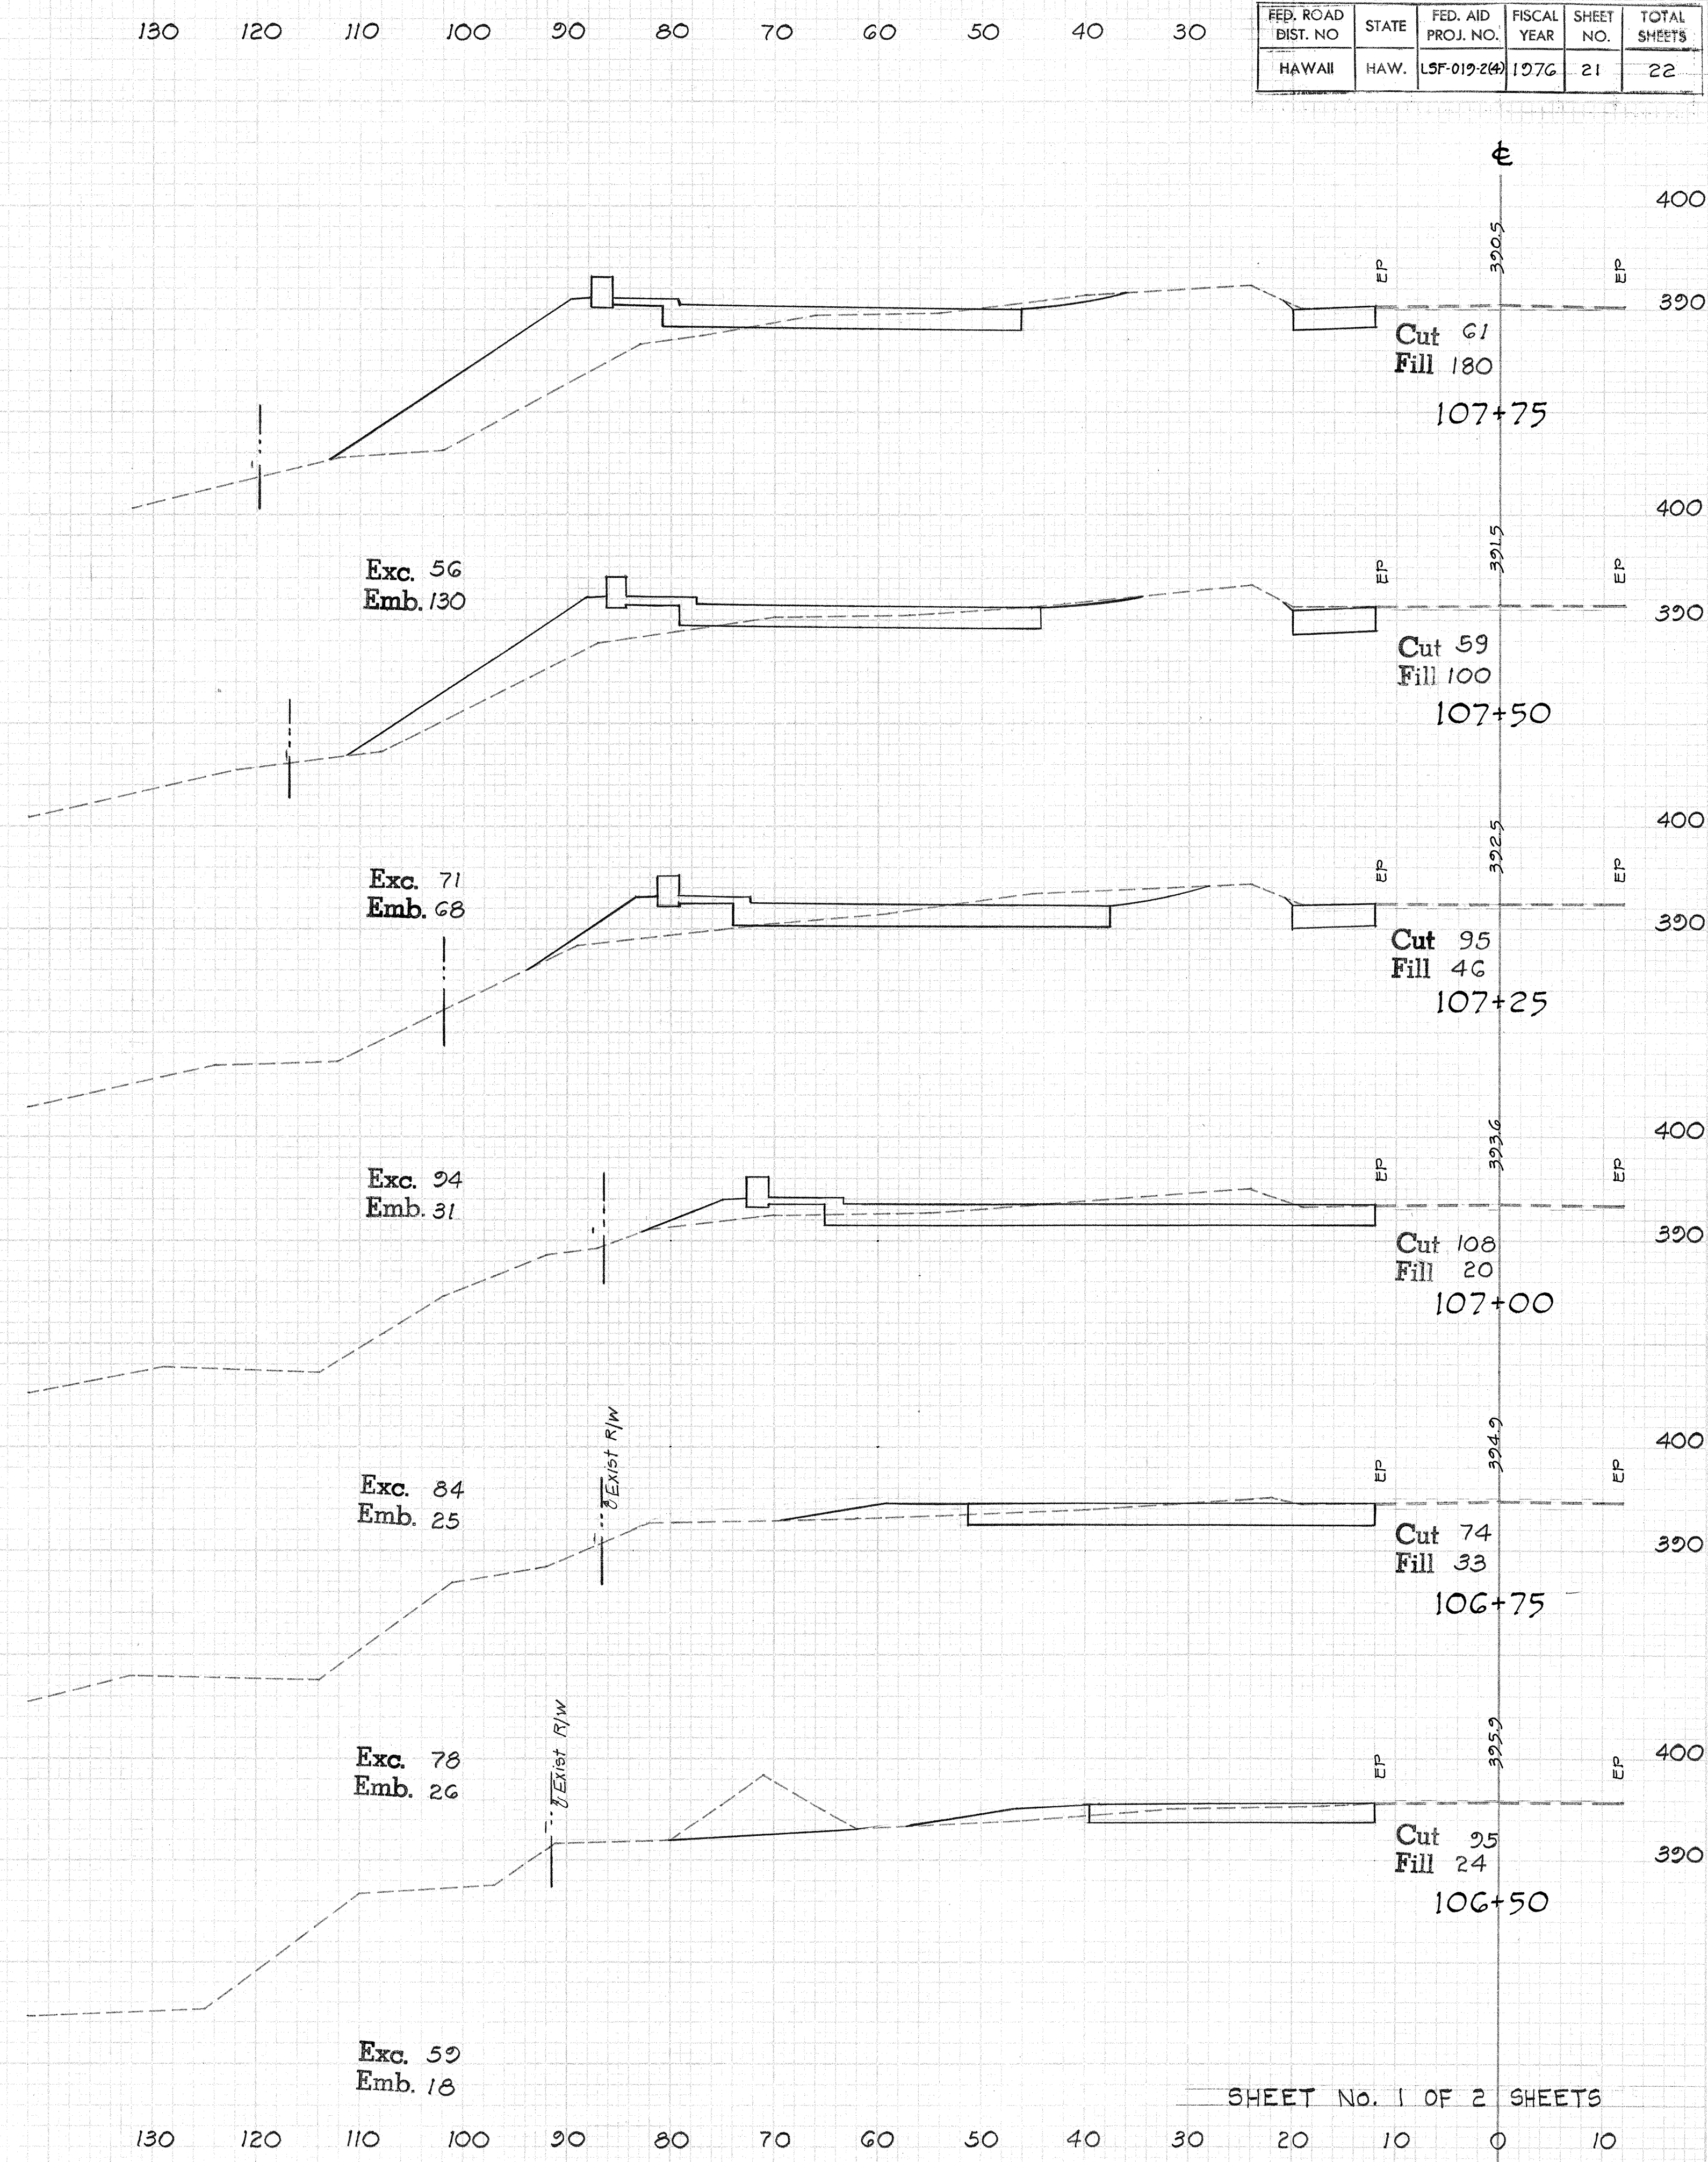


FED. ROAD DIST. NO.	STATE	FED. AID PROJ. NO.	FISCAL YEAR	SHEET NO.	TOTAL SHEETS
HAWAII	HAW.	LSF-019-240	1976	21	22

FINAL SURVEY	BY	DATE
SURVEYED	G.K.	5/18/75
PLOTTED		
NOTE BOOK AREAS		
AREAS CHECKED		

ORIGINAL SURVEY	BY	DATE
SURVEYED	H.O.	
PLOTTED	C.S.	
NOTE BOOK AREAS		
AREAS CHECKED		

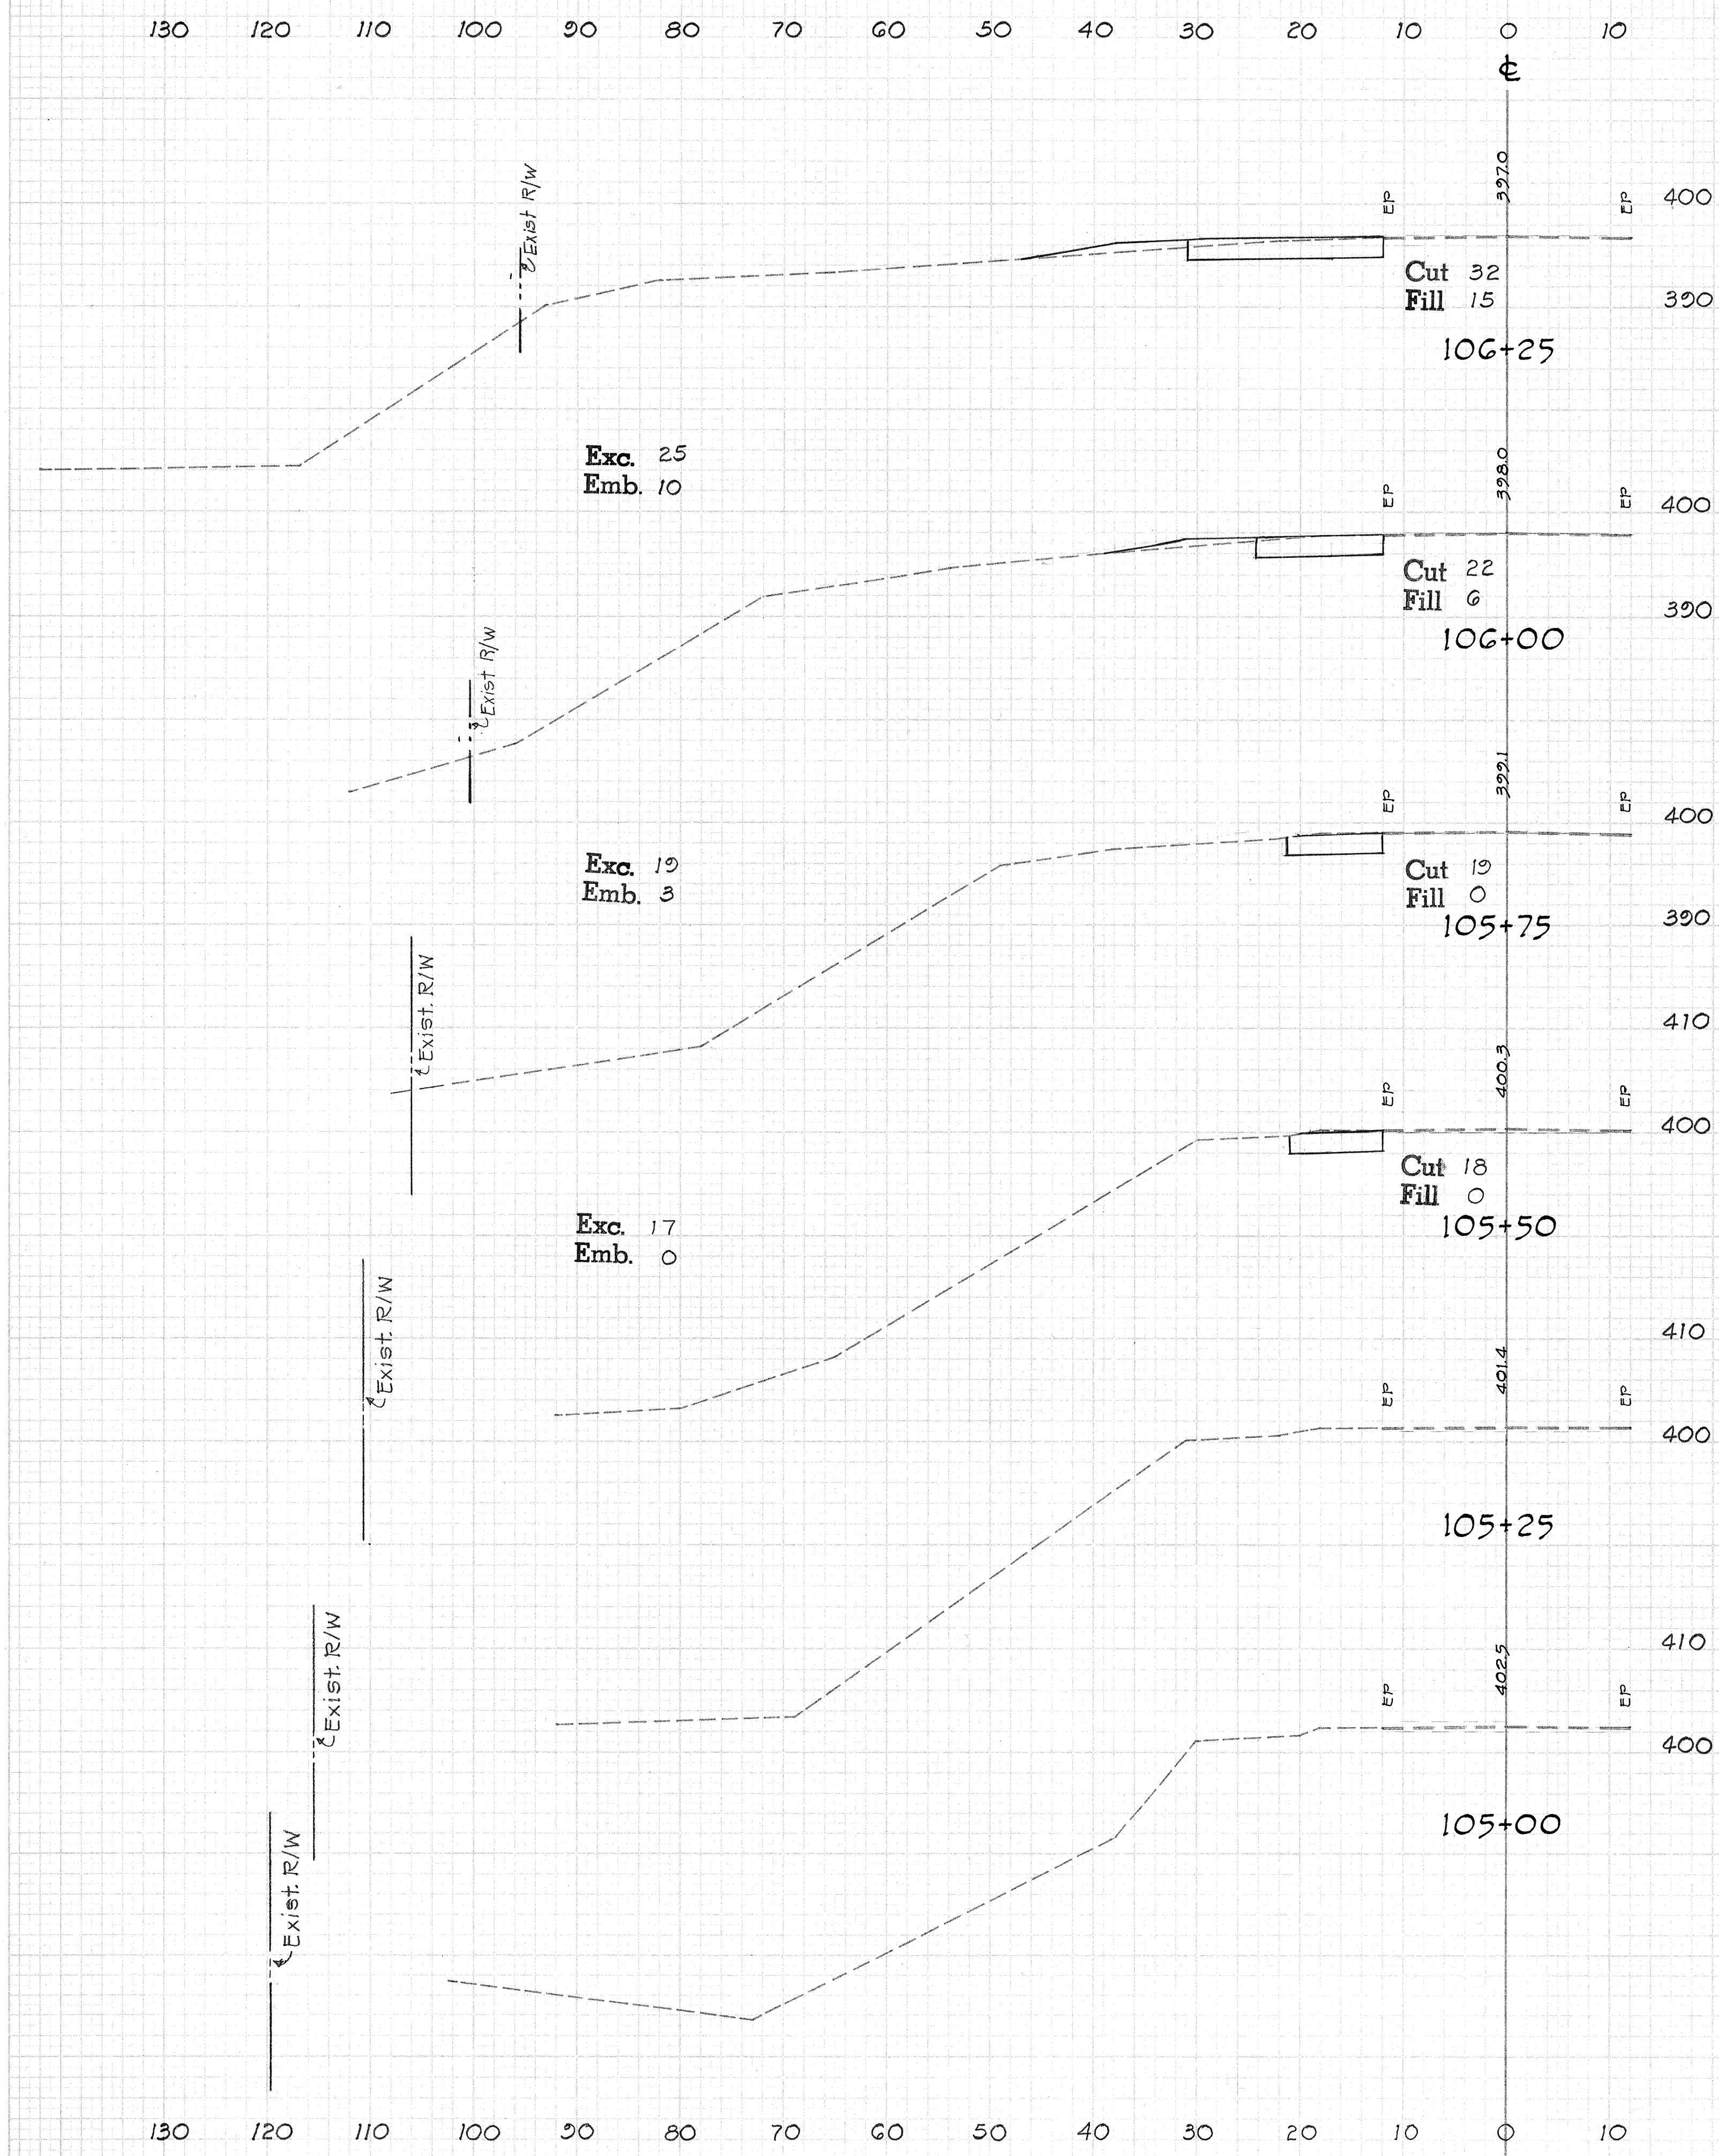

SHEET No. 1 OF 2 SHEETS

FINAL					
SURVEY	SURVEYED				
NOTE BOOK	PLOTTED				
	TEMPLATE	G.K.	BY		DATE
	AREAS				5-5-75
- 1083	AREAS CHECKED				

ORIGINAL SURVEY	SURVEYED	BY	DATE
NOTE BOOK	PLOTTED		
	TEMPLATE	#0.	
	AREAS	C.S., C.	
	AREAS CHECKED		

