

INDEX TO DRAWINGS	
SHEET NO.	DESCRIPTION
1	TITLE SHEET
2	TYPICAL SECTIONS
3	PLAN AND PROFILE
4-5	MISCELLANEOUS DETAILS
6-20	STANDARD DETAILS
21-22	CROSS SECTIONS

STATE OF HAWAII

DEPARTMENT OF TRANSPORTATION

HIGHWAYS DIVISION

"AS BUILT"

PLANS FOR

HAWAII BELT ROAD

LAUPAHOEHOE SCENIC LOOKOUT

PROJECT NO. LSF-019-2(4)

DISTRICT OF NORTH HILO

ISLAND OF HAWAII

NOTE:



ALL CHANGES MADE DURING CONSTRUCTION HAVE BEEN NOTED IN RED ON THESE TRACINGS AND CHECKED BY:

E. Shawa

PROJECT ENGINEER

Aug. 10, 1976

DATE

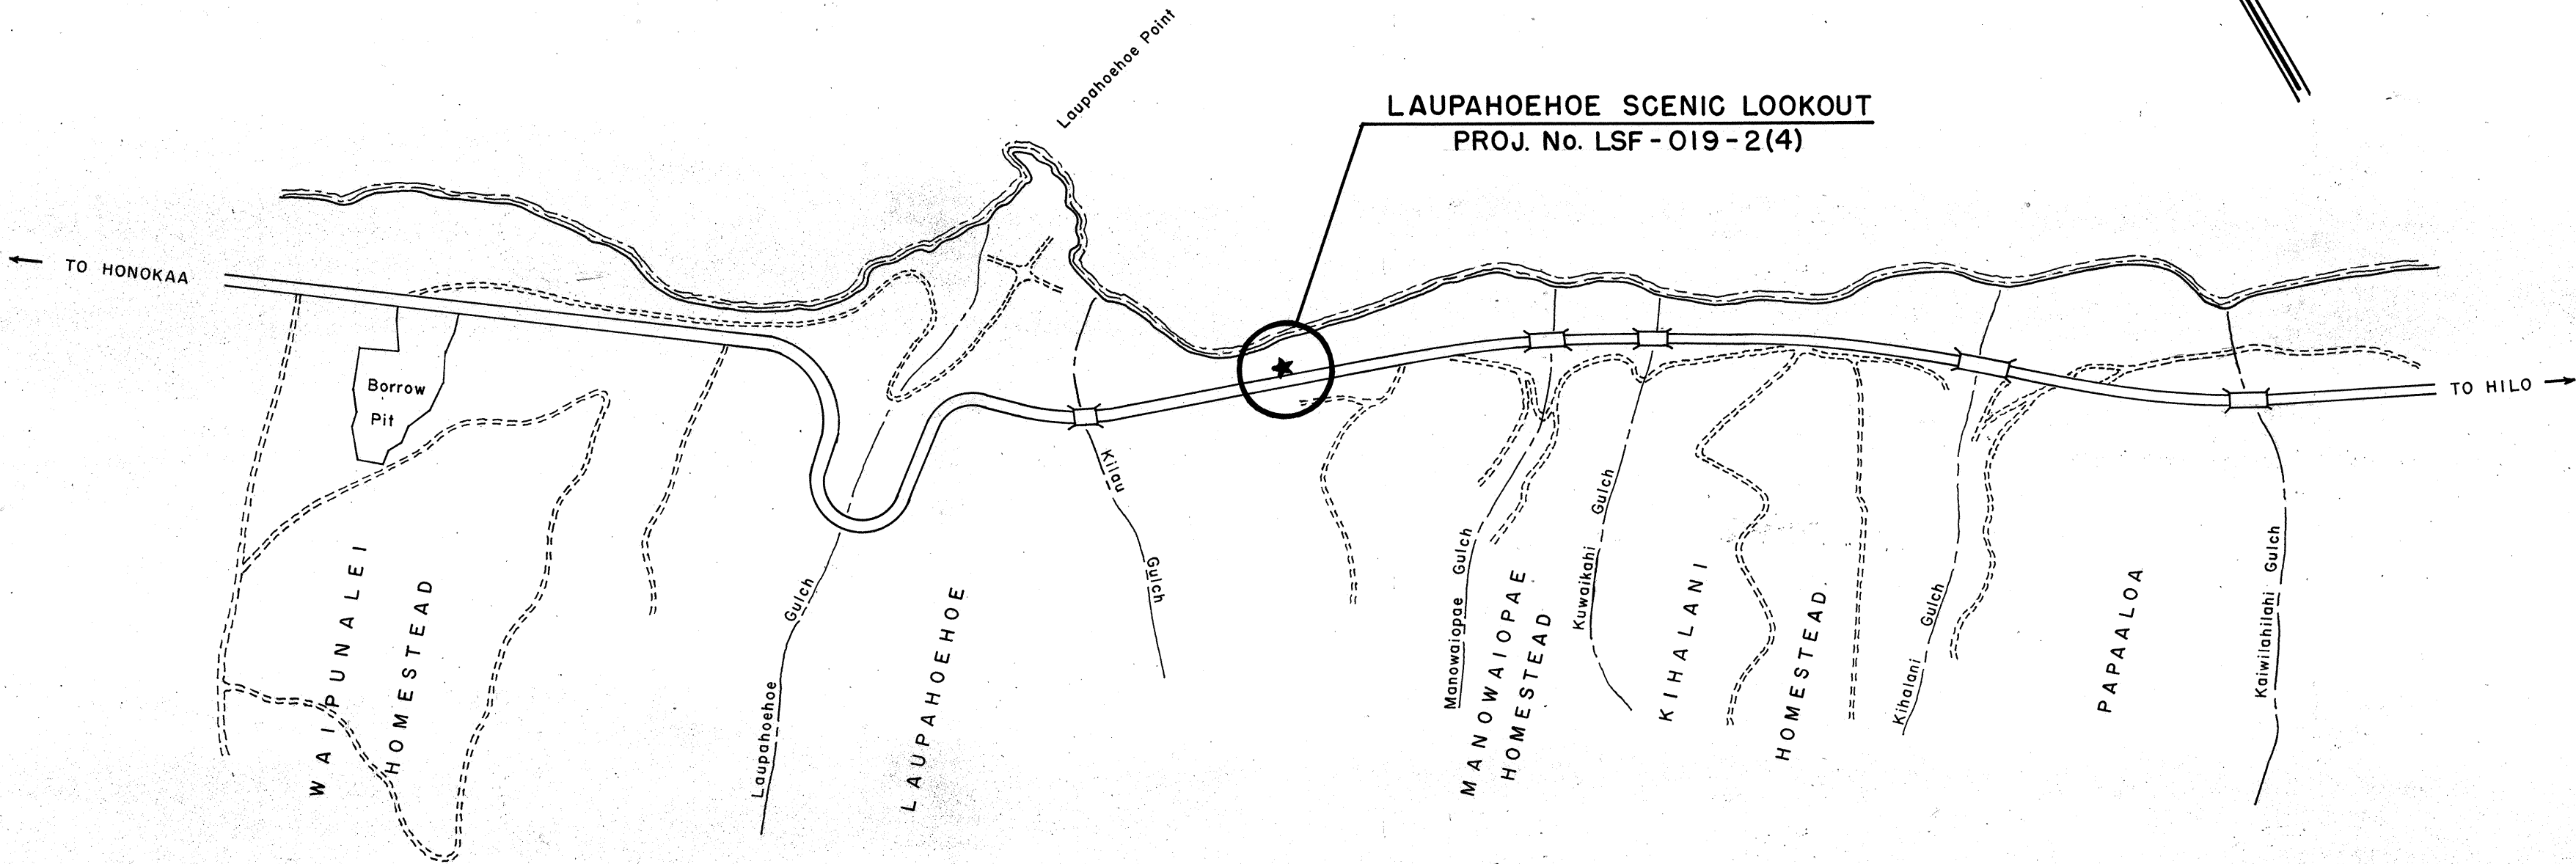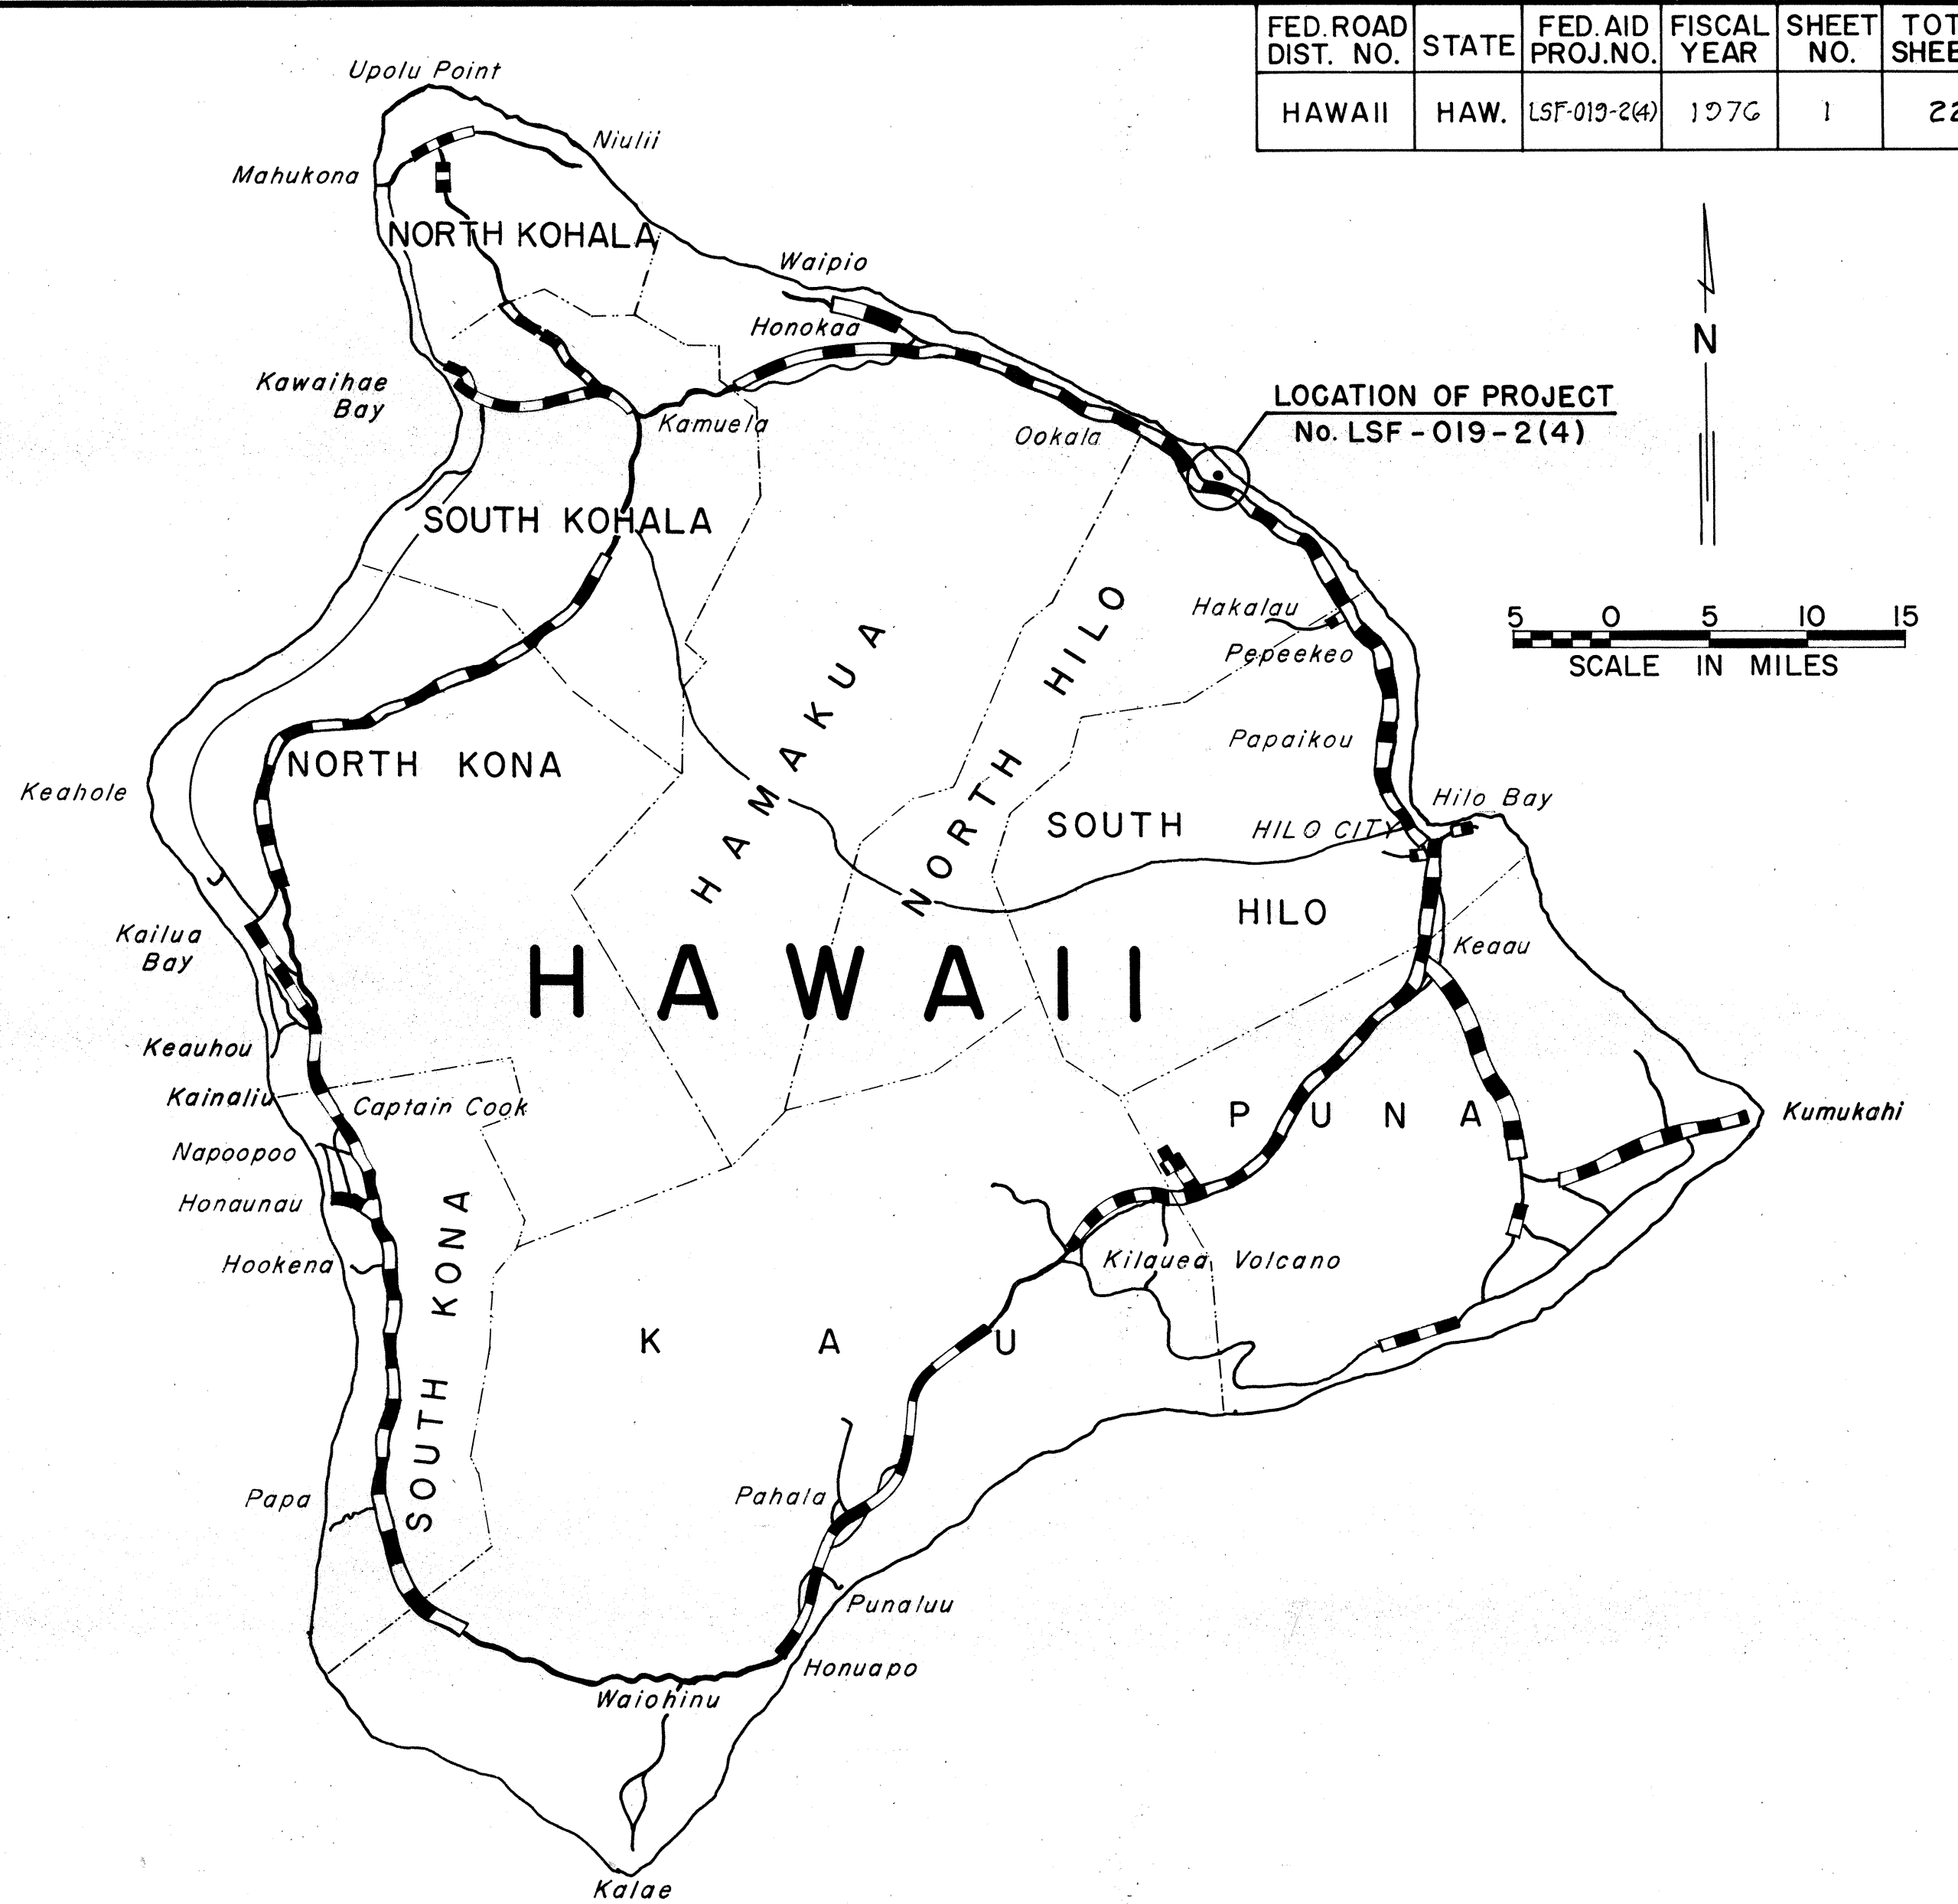

LOCATION OF PROJECT

Scale: 1"=1000'

LENGTH OF PROJECT.0.085 MI.

GENERAL LOCATION

DESIGN CLASSIFICATION

ADT (1975).2,960

ADT (1995).4,760

DHV430

D.55/45

T.5%

V.50M.P.H.

SCALES

PLAN1"= 20'

PROFILEHOR. 1"= 20'

VER. 1"= 2.5'

CROSS SECTIONS. HOR. 1"= 10'

VER. 1"= 10'

HAWAII DISTRICT

DESIGNED BY

A. NISHIMURA

548-7537

JUNE, 1975

PHONE

DATE

DEPARTMENT OF TRANSPORTATION

FEDERAL HIGHWAY ADMINISTRATION

APPROVED:

[Signature]

11-6-75

DIVISION ENGINEER

DATE

DEPARTMENT OF TRANSPORTATION

STATE OF HAWAII

APPROVED:

R. Higashionna

10-2-75

for DIR. OF TRANSPORTATION

DATE