

FED. ROAD DIST. NO.	STATE	FED. AID PROJ. NO.	FISCAL YEAR	SHEET NO.	TOTAL SHEETS
HAWAII	HAW.	BR-019-2(58)	2008	6	26


## INDEX TO STRUCTURAL DRAWINGS

[illegible]

## ESTIMATED QUANTITIES

[illegible]

ORIGINAL PLAN	SURVEY PLOTTED BY _____	DATE _____
NOTE BOOK	DRAWN BY _____	_____
	TRACED BY _____	_____
	DESIGNED BY _____	_____
	QUANTITIES BY _____	_____
No. _____	CHECKED BY _____	_____

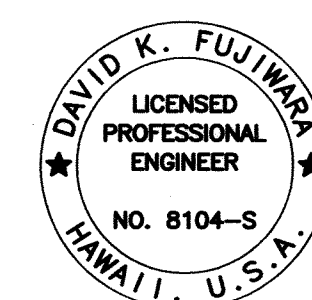

THIS WORK WAS PREPARED BY  
ME OR UNDER MY SUPERVISION

*David K. Ferguson* 4-30-10  
SIGNATURE EXPIRATION DATE OF THE LICENSE

STATE OF HAWAII  
DEPARTMENT OF TRANSPORTATION  
HIGHWAYS DIVISION

INDEX TO STRUCTURAL DRAWINGS  
AND ESTIMATED QUANTITIES  
HAWAII BELT ROAD  
SEISMIC RETROFIT OF VARIOUS BRIDGES  
Vicinity Of Papaikou, Phase 2  
Federal-aid Project No. Br-019-2(58)  
Scale: NONE Date: Mar. 2007

SHEET No. 501 OF 12 SHEETS