


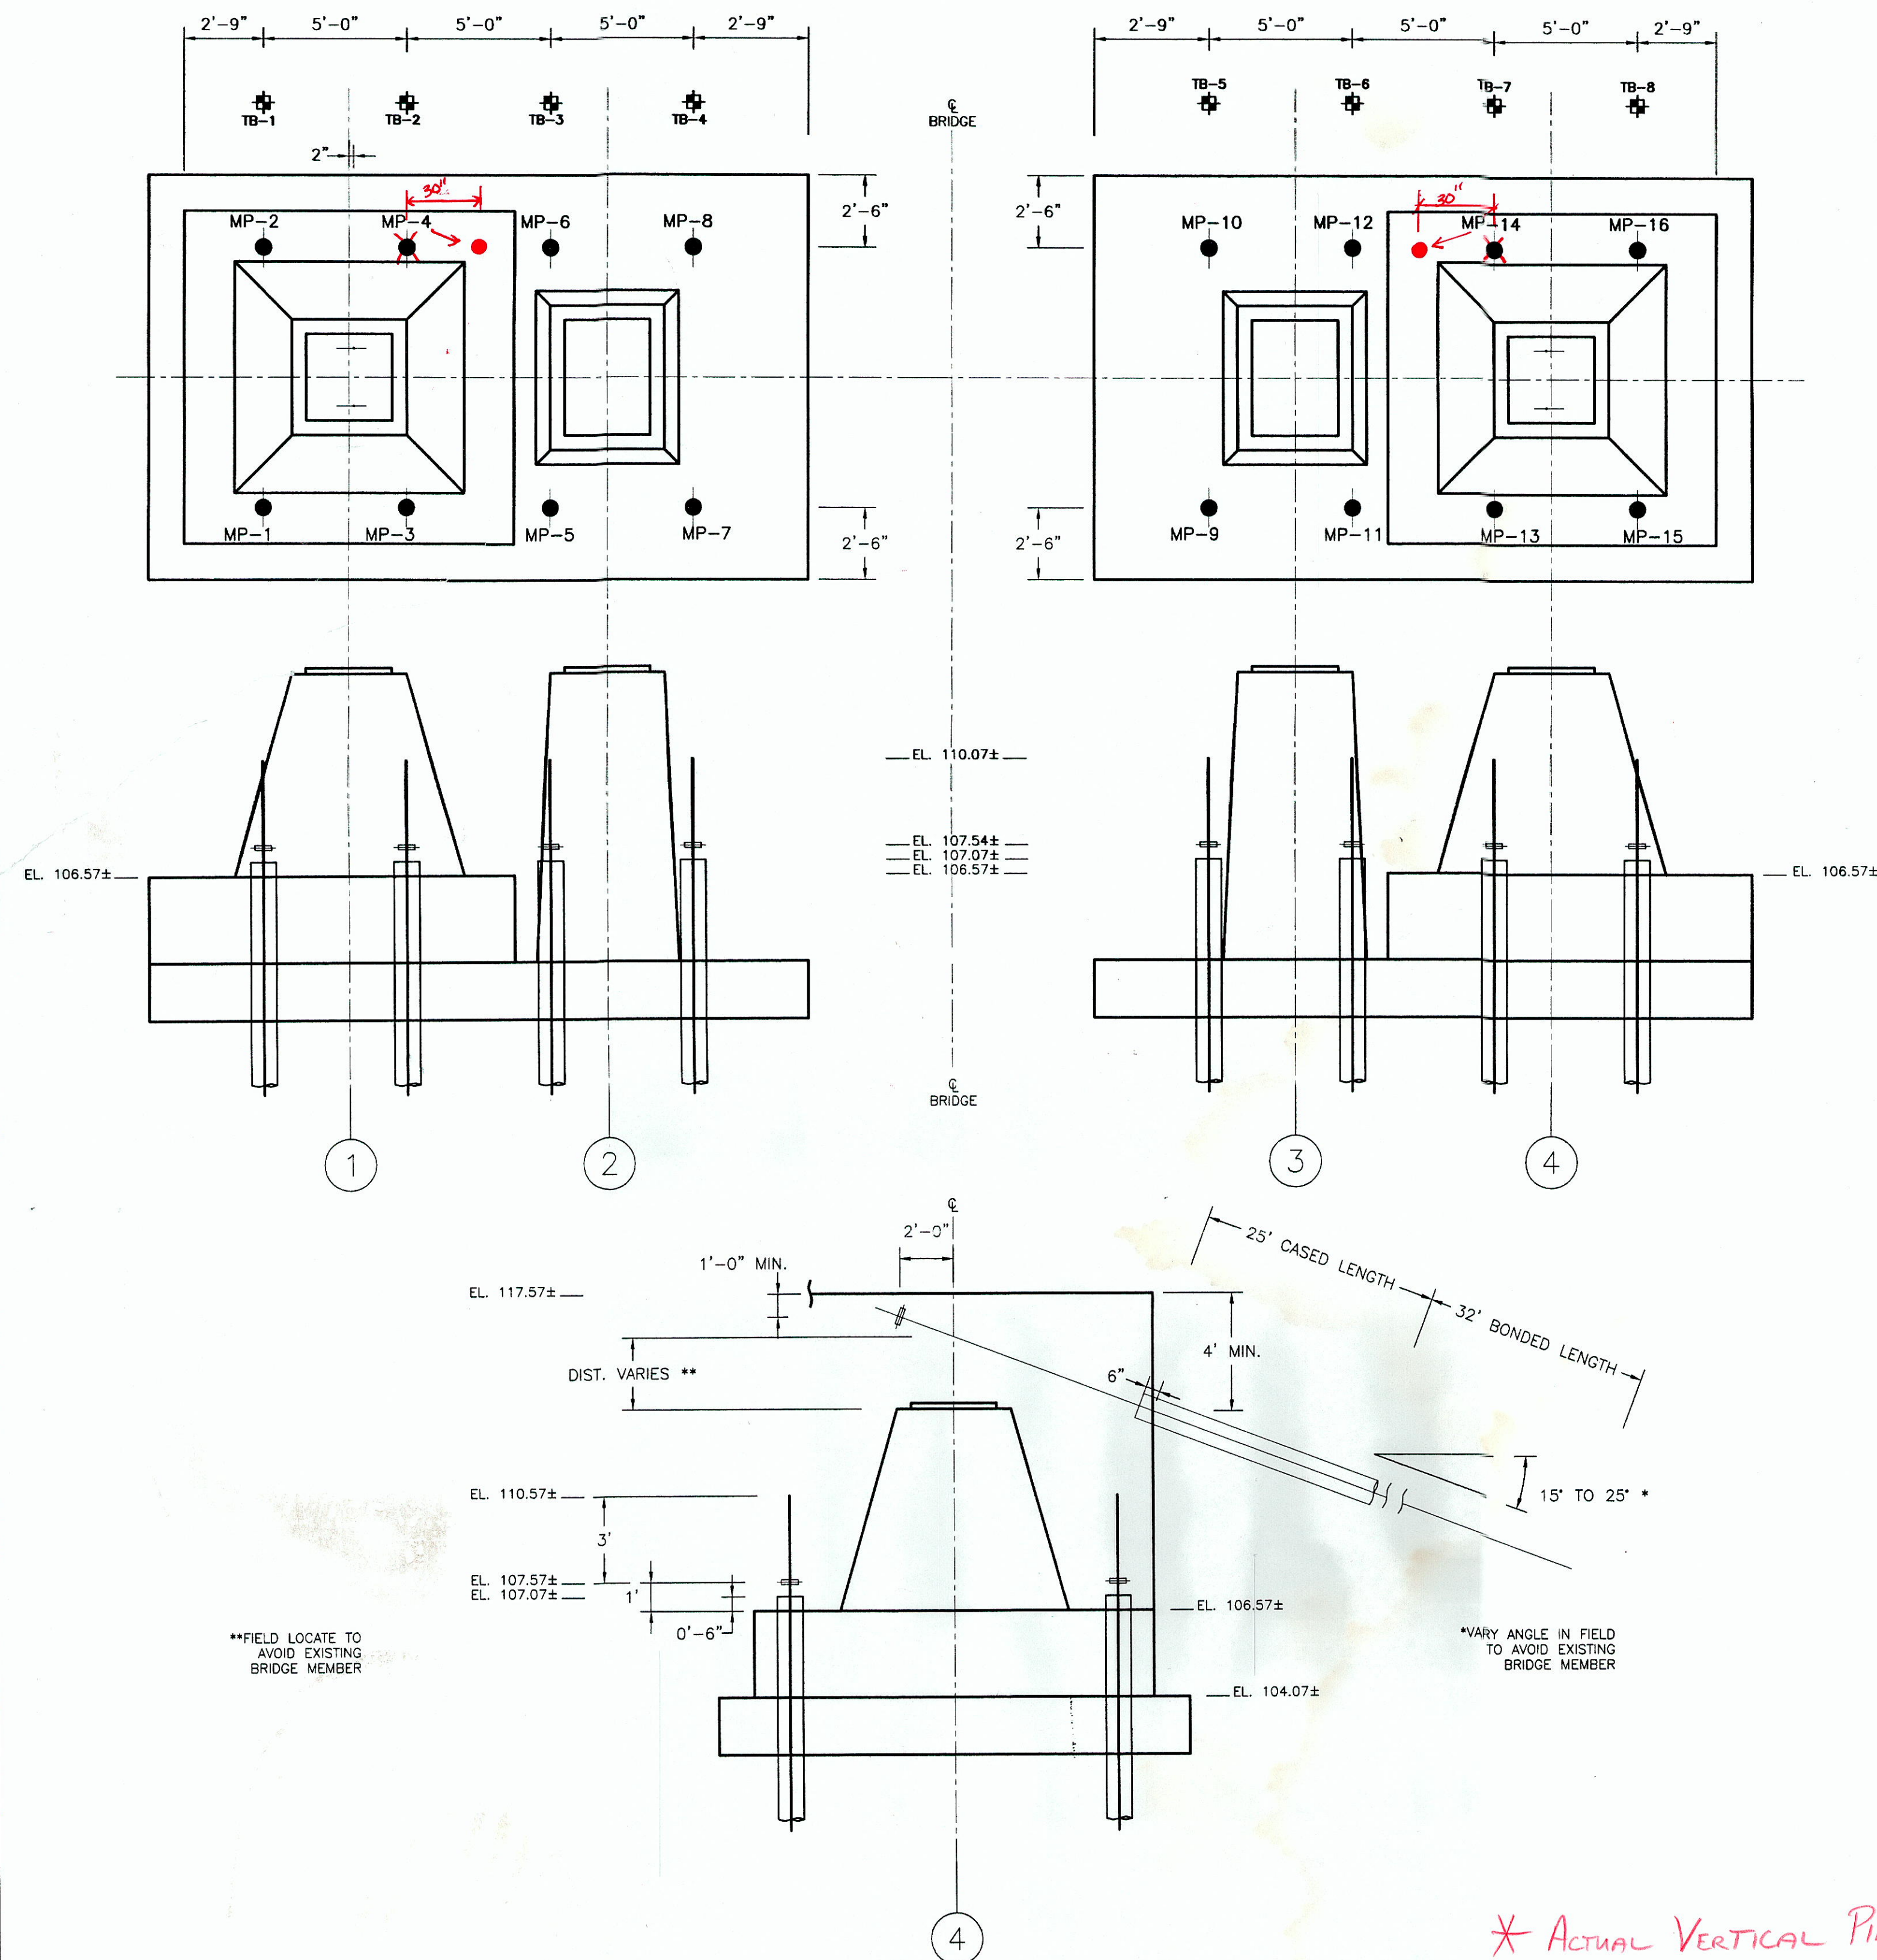


1 BENT 12 PLAN AND SECTIONS
SCALE: 1"=4'-0"

HAWAII UNDERGROUND UTILITY INFORMATION			
UTILITY	NAME	PHONE	COMMENTS
WATER	BOARD OF WATER SUPPLY PLANNING & ENGINEERING DIV., CONSTR. SECTION	808-527-5204	ONE WEEK NOTICE
GAS	BHP GAS CO.	808-526-0066	5 WORKING DAYS NOTICE
ELECTRICAL	HECO	808-543-7086	3 DAYS NOTICE
SEWER	WWM	808-527-5842 OR 808-523-4345	7 DAYS NOTICE SUBMIT 4 PLAN SETS
TELEPHONE	GTE	808-483-8085	3 DAYS NOTICE

THE CONSTRUCTION OF THIS WALL UTILIZING THESE DRAWINGS SHALL BE BY SCHNABEL FOUNDATION COMPANY OR ITS DESIGNATED SUBCONTRACTORS AND SUPPLIERS.

THESE DRAWINGS (CALCULATIONS) ARE THE PROPERTY OF SCHNABEL FOUNDATION COMPANY. THEY MAY NOT BE COPIED, REPRODUCED OR USED WITHOUT SCHNABEL FOUNDATION COMPANY'S EXPRESSED WRITTEN PERMISSION.

COPYRIGHT 2009, SCHNABEL FOUNDATION COMPANY

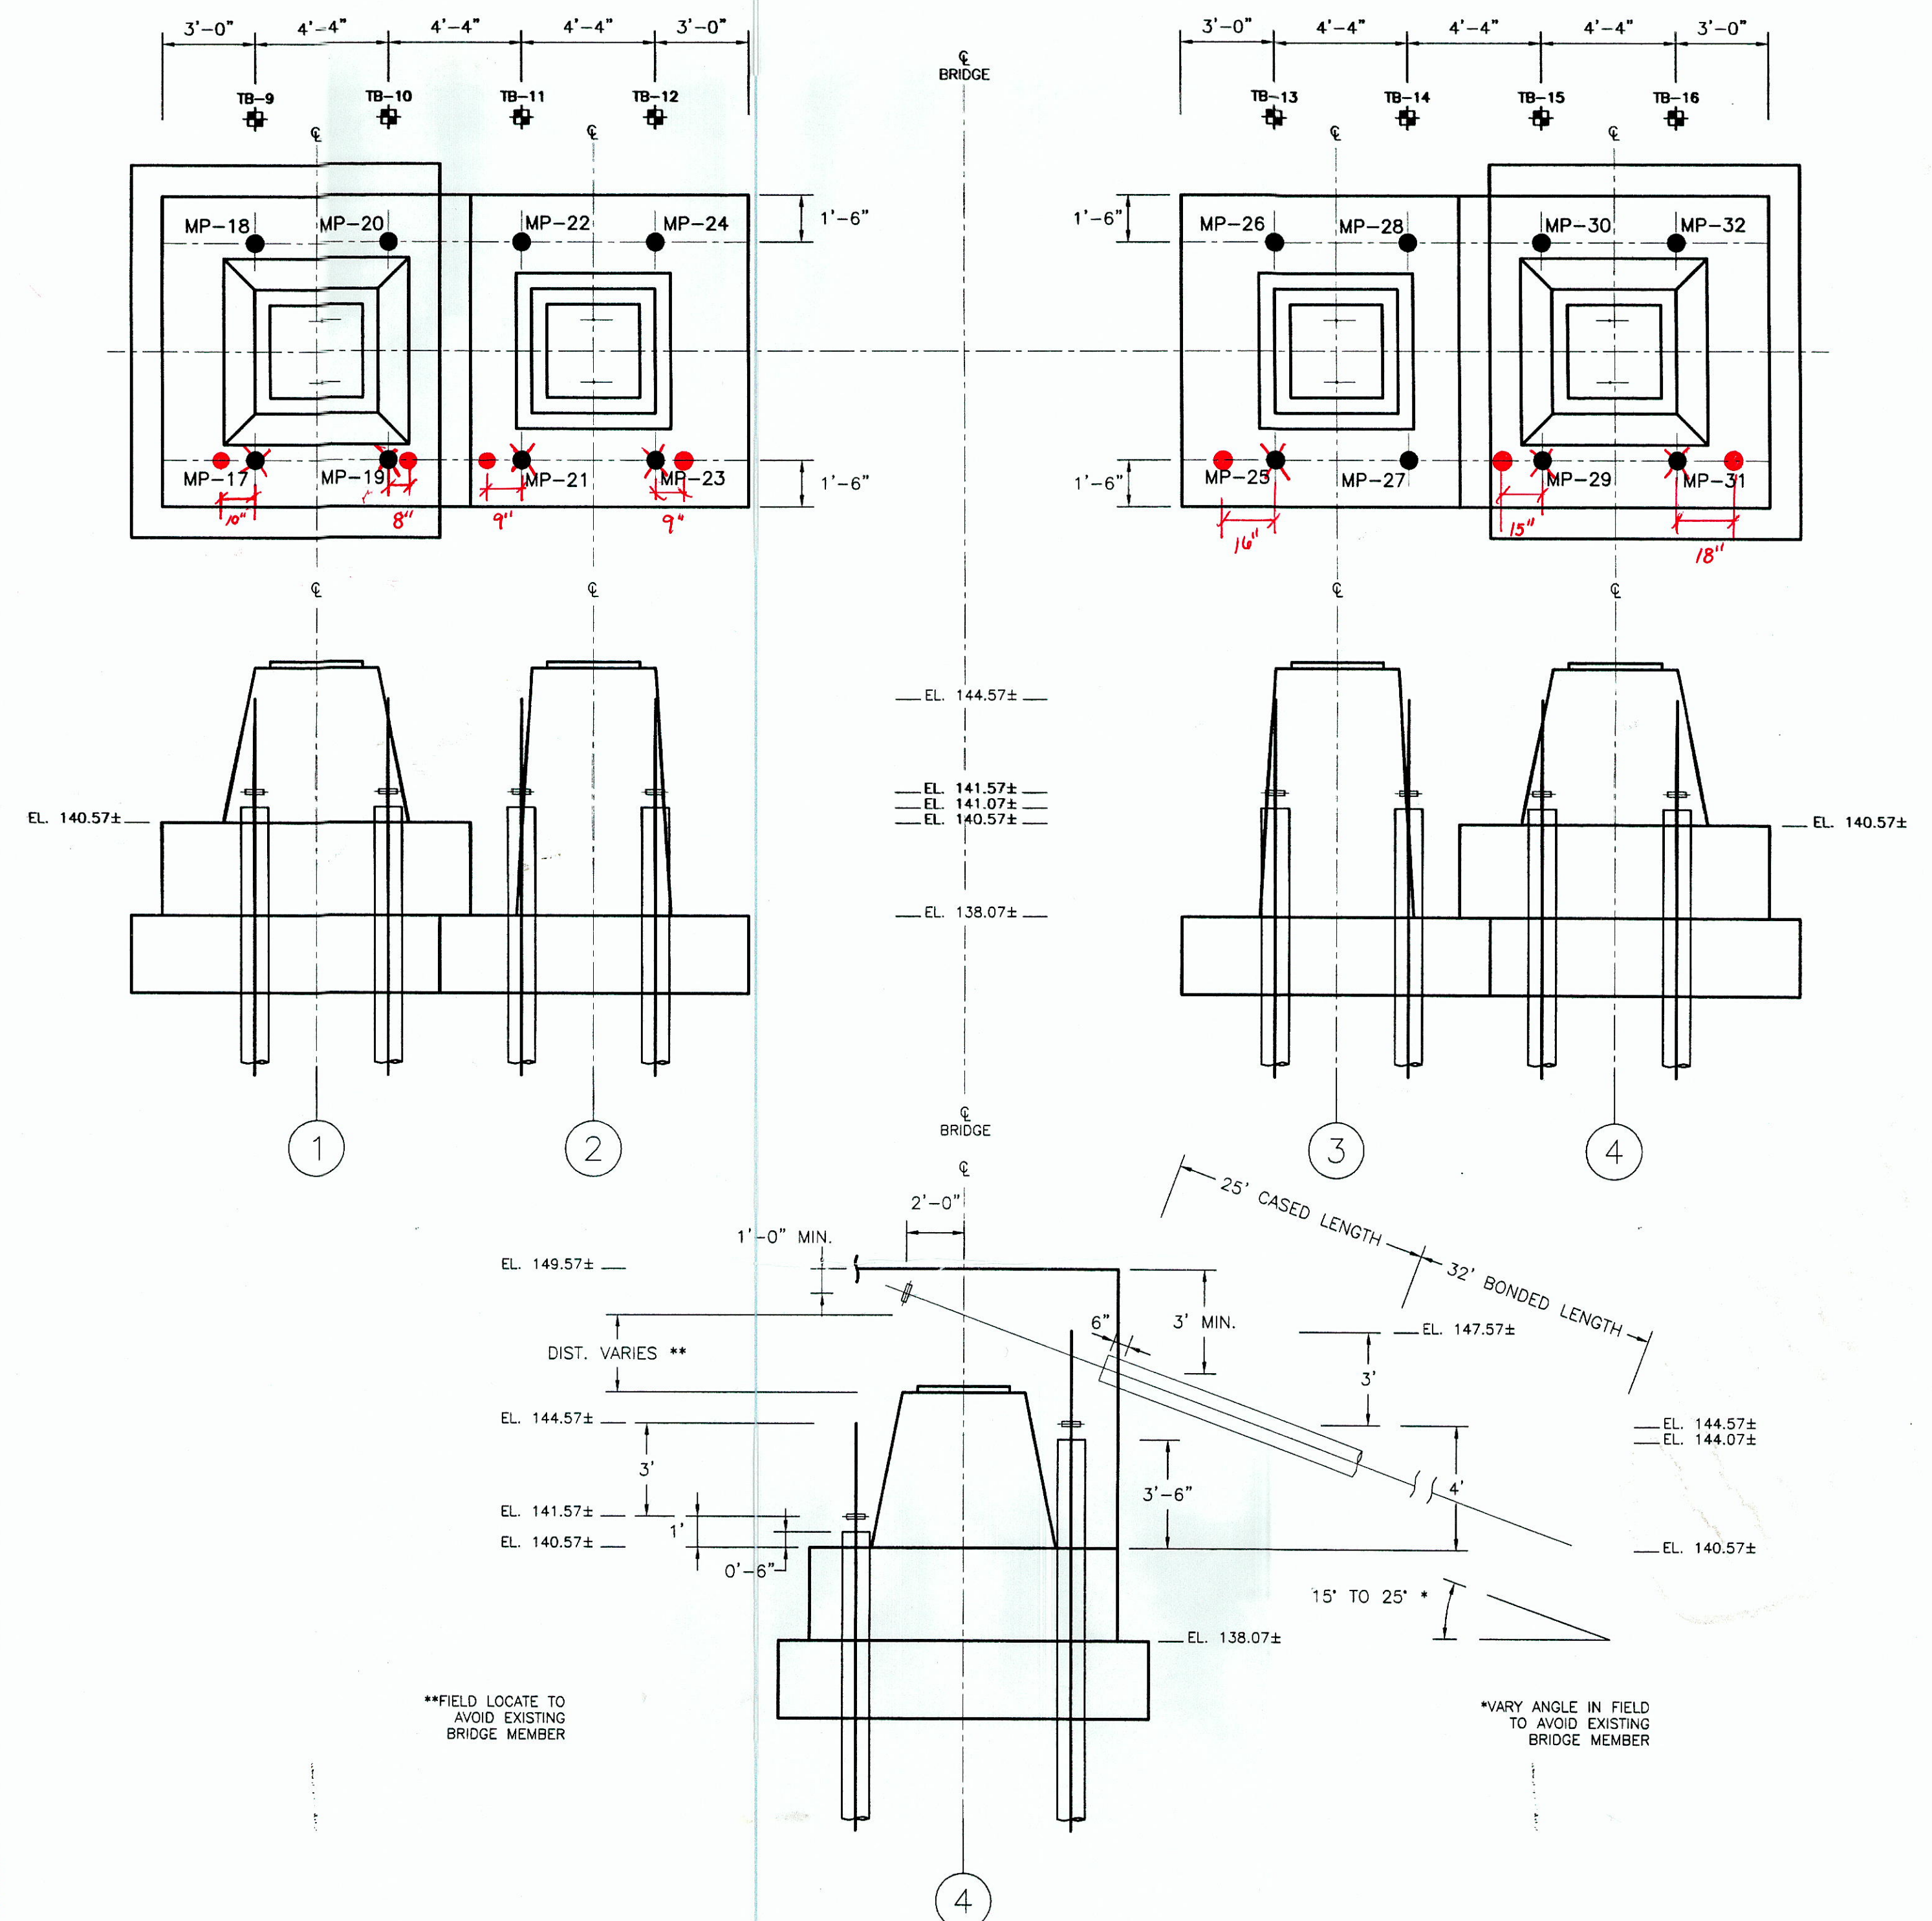

1 BENT 13 PLAN AND SECTIONS
SCALE: 1"=4'-0"

REFERENCE: SHEET NO. S1.4 OF 12
SHEET NO. S1.6 OF 12
SHEET NO. S1.7 OF 12
SHEET NO. S1.8 OF 12
STATE OF HAWAII
DEPT. OF TRANSPORTATION PROJECT PLANS

REVISIONS	
3/13/09	SHOP DRAWING SUBMITTAL

HAWAII BELT ROAD-SEISMIC RETROFIT OF VARIOUS BRIDGES
VICINITY OF PAPAIOU - PHASE 2
FOOTING PLAN AND SECTIONS

Schnabel Engineers and Contractors
FOUNDATION COMPANY
ATLANTA • BOSTON • CHICAGO • HOUSTON • DENVER
PHILADELPHIA • SAN FRANCISCO • WASHINGTON, D.C.

09-4280 DATE: 3/13/09 SCALE: AS SHOWN
DRAWN BY: KAJ DWG. NO.: SH-4