
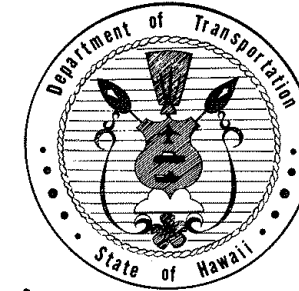




INDEX TO DRAWINGS	
SHEET NO.	DESCRIPTION
1	TITLE SHEET
2	PLAN
3-5	STRUCTURE DETAIL PLANS INFORMATION ONLY
6	STANDARD DETAIL

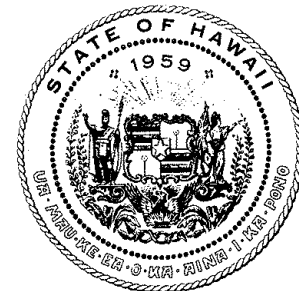

STATE OF HAWAII
DEPARTMENT OF TRANSPORTATION
HIGHWAYS DIVISION
"AS BUILT"
PLANS FOR


HAWAII BELT ROAD
REMOVAL OF
HAKALAU FLUME OVERPASS
KAMAE E STATION
PROJECT NO. 19H-01-76
DISTRICT OF NORTH HILO
ISLAND OF HAWAII

FED. ROAD DIST. NO.	STATE	PROJ. NO.	FISCAL YEAR	SHEET NO.	TOTAL SHEETS
HAWAII	HAW.	19H-01-76	1976	1	6

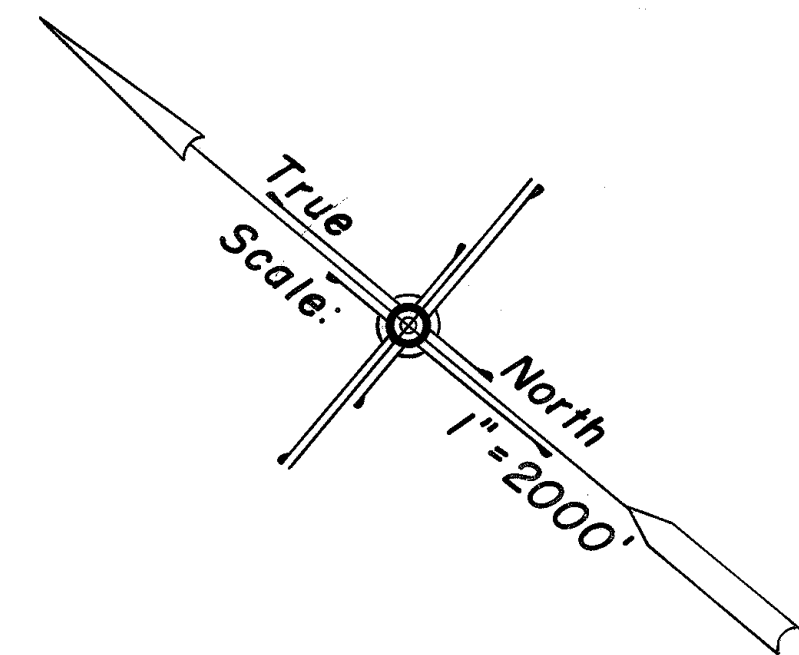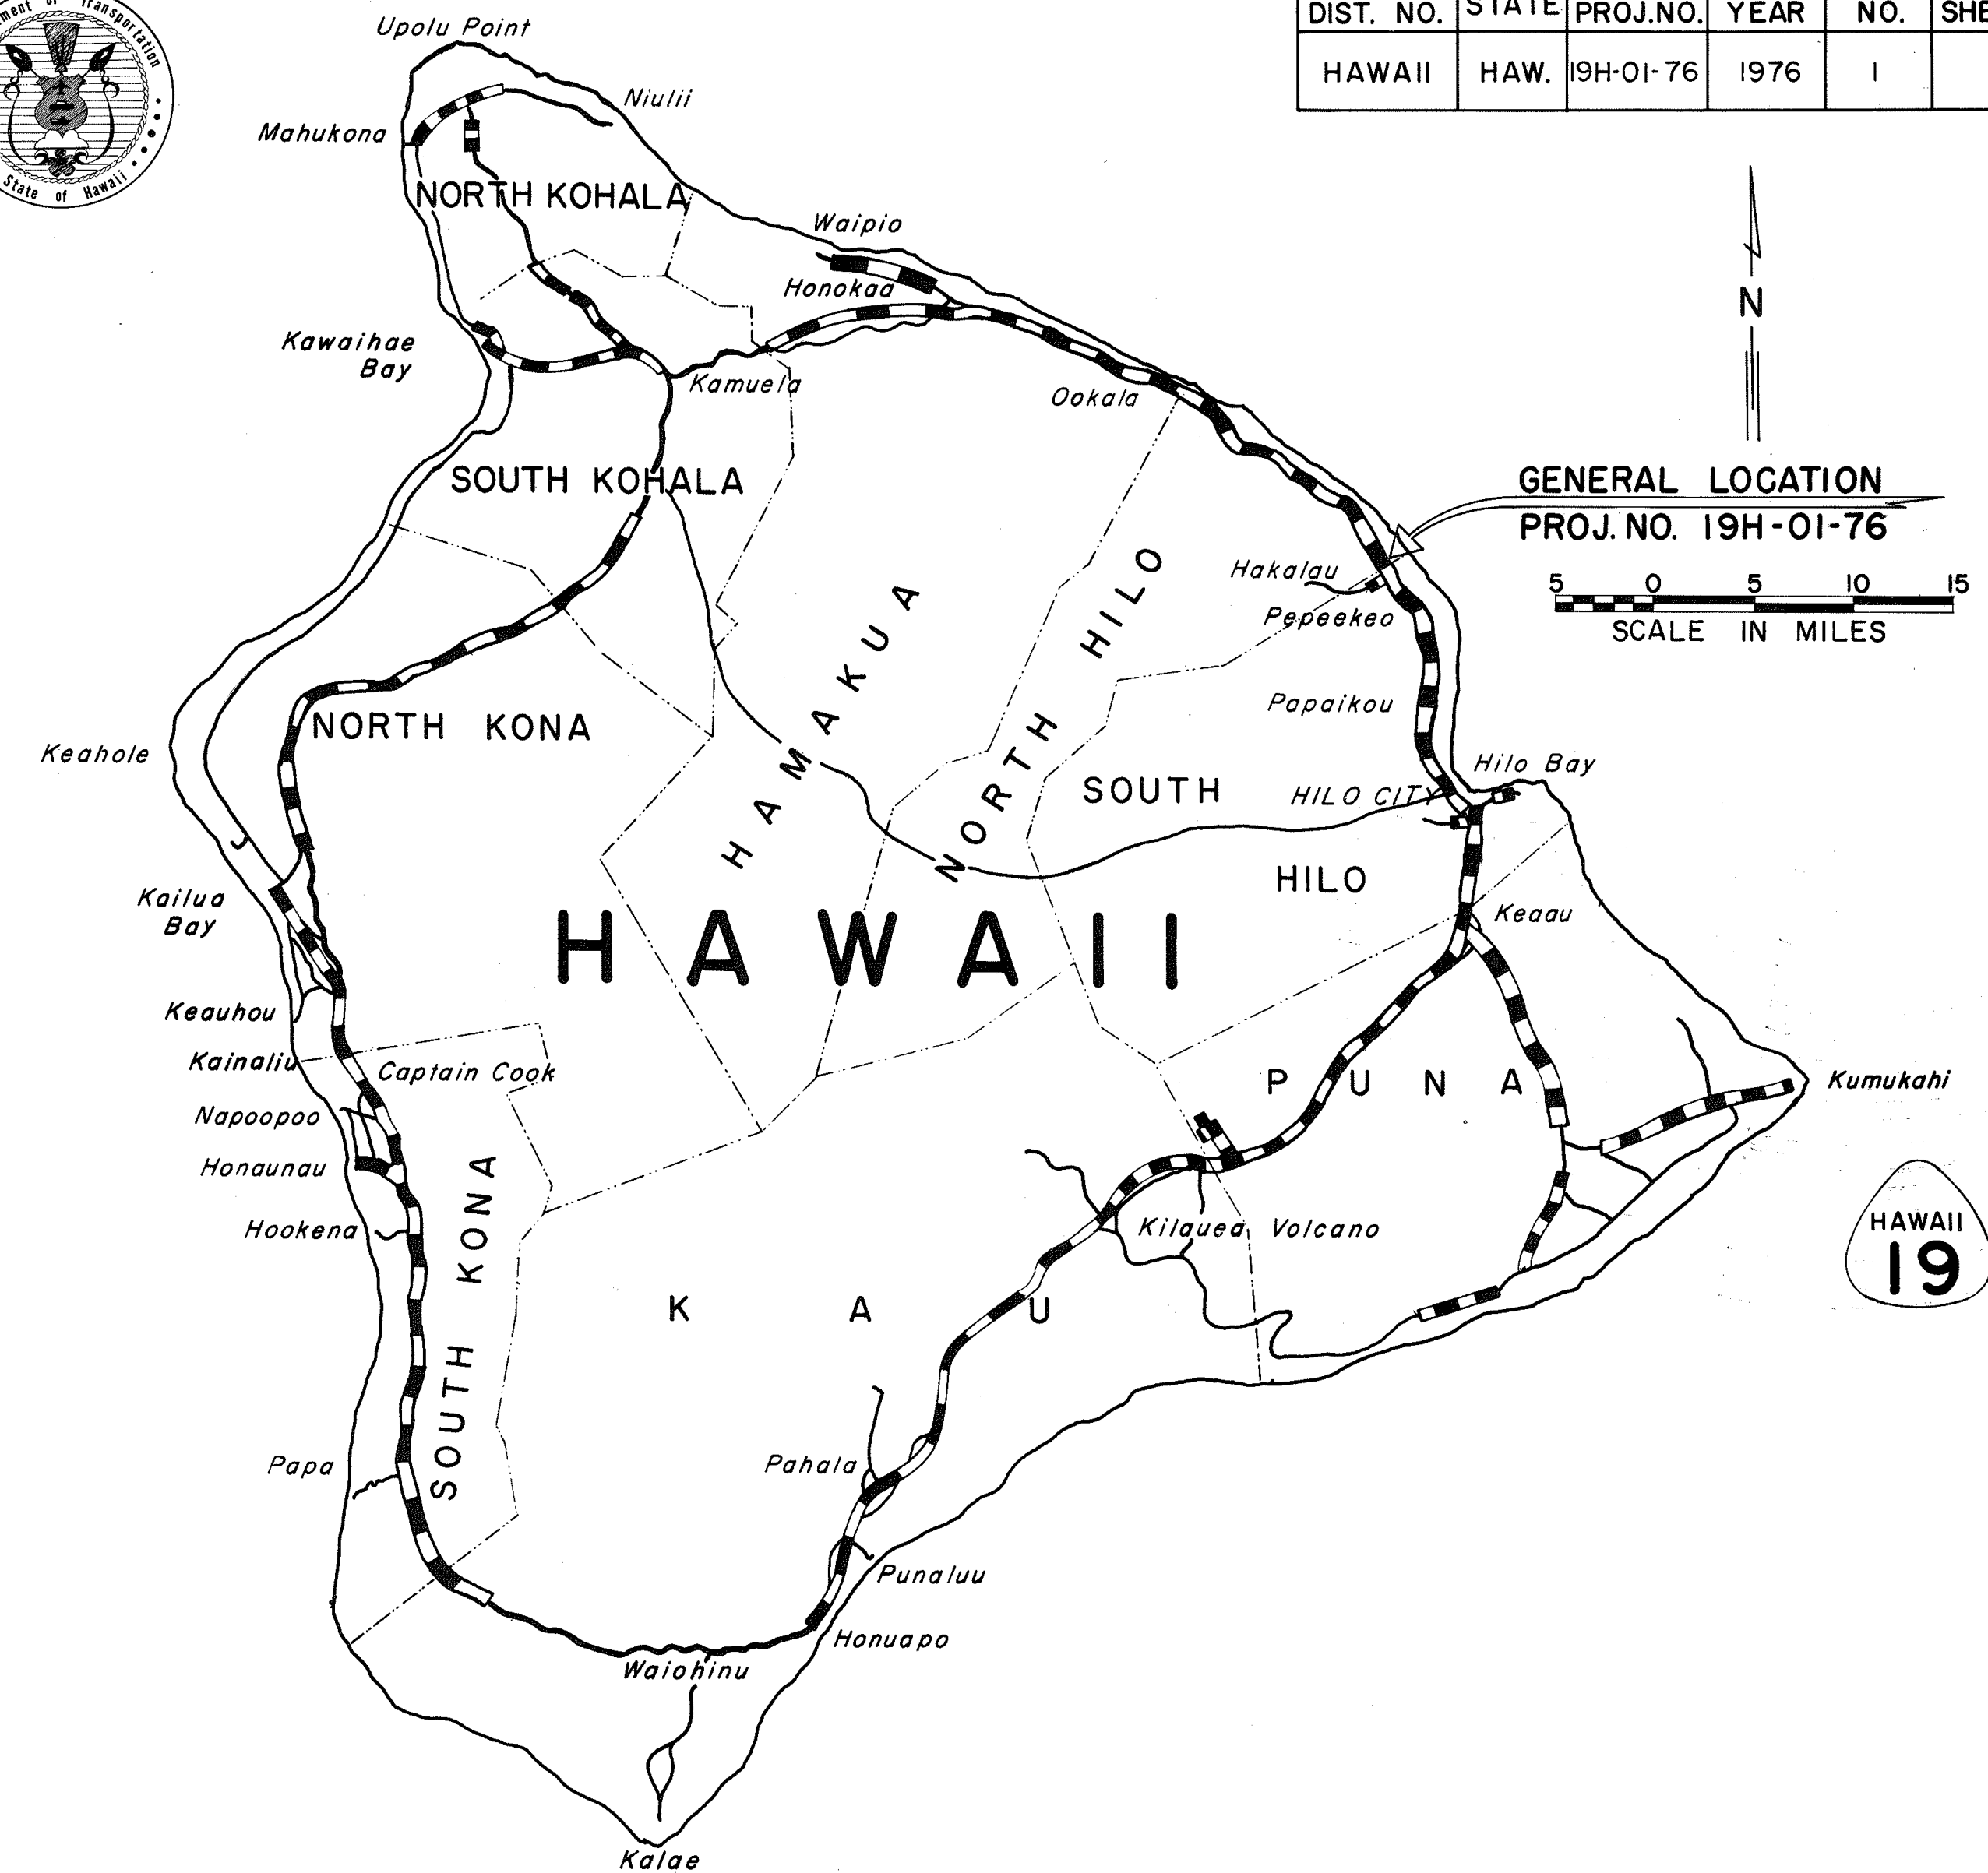

P A C I F I C O C E A N

PROJECT NO. 19H-01-76

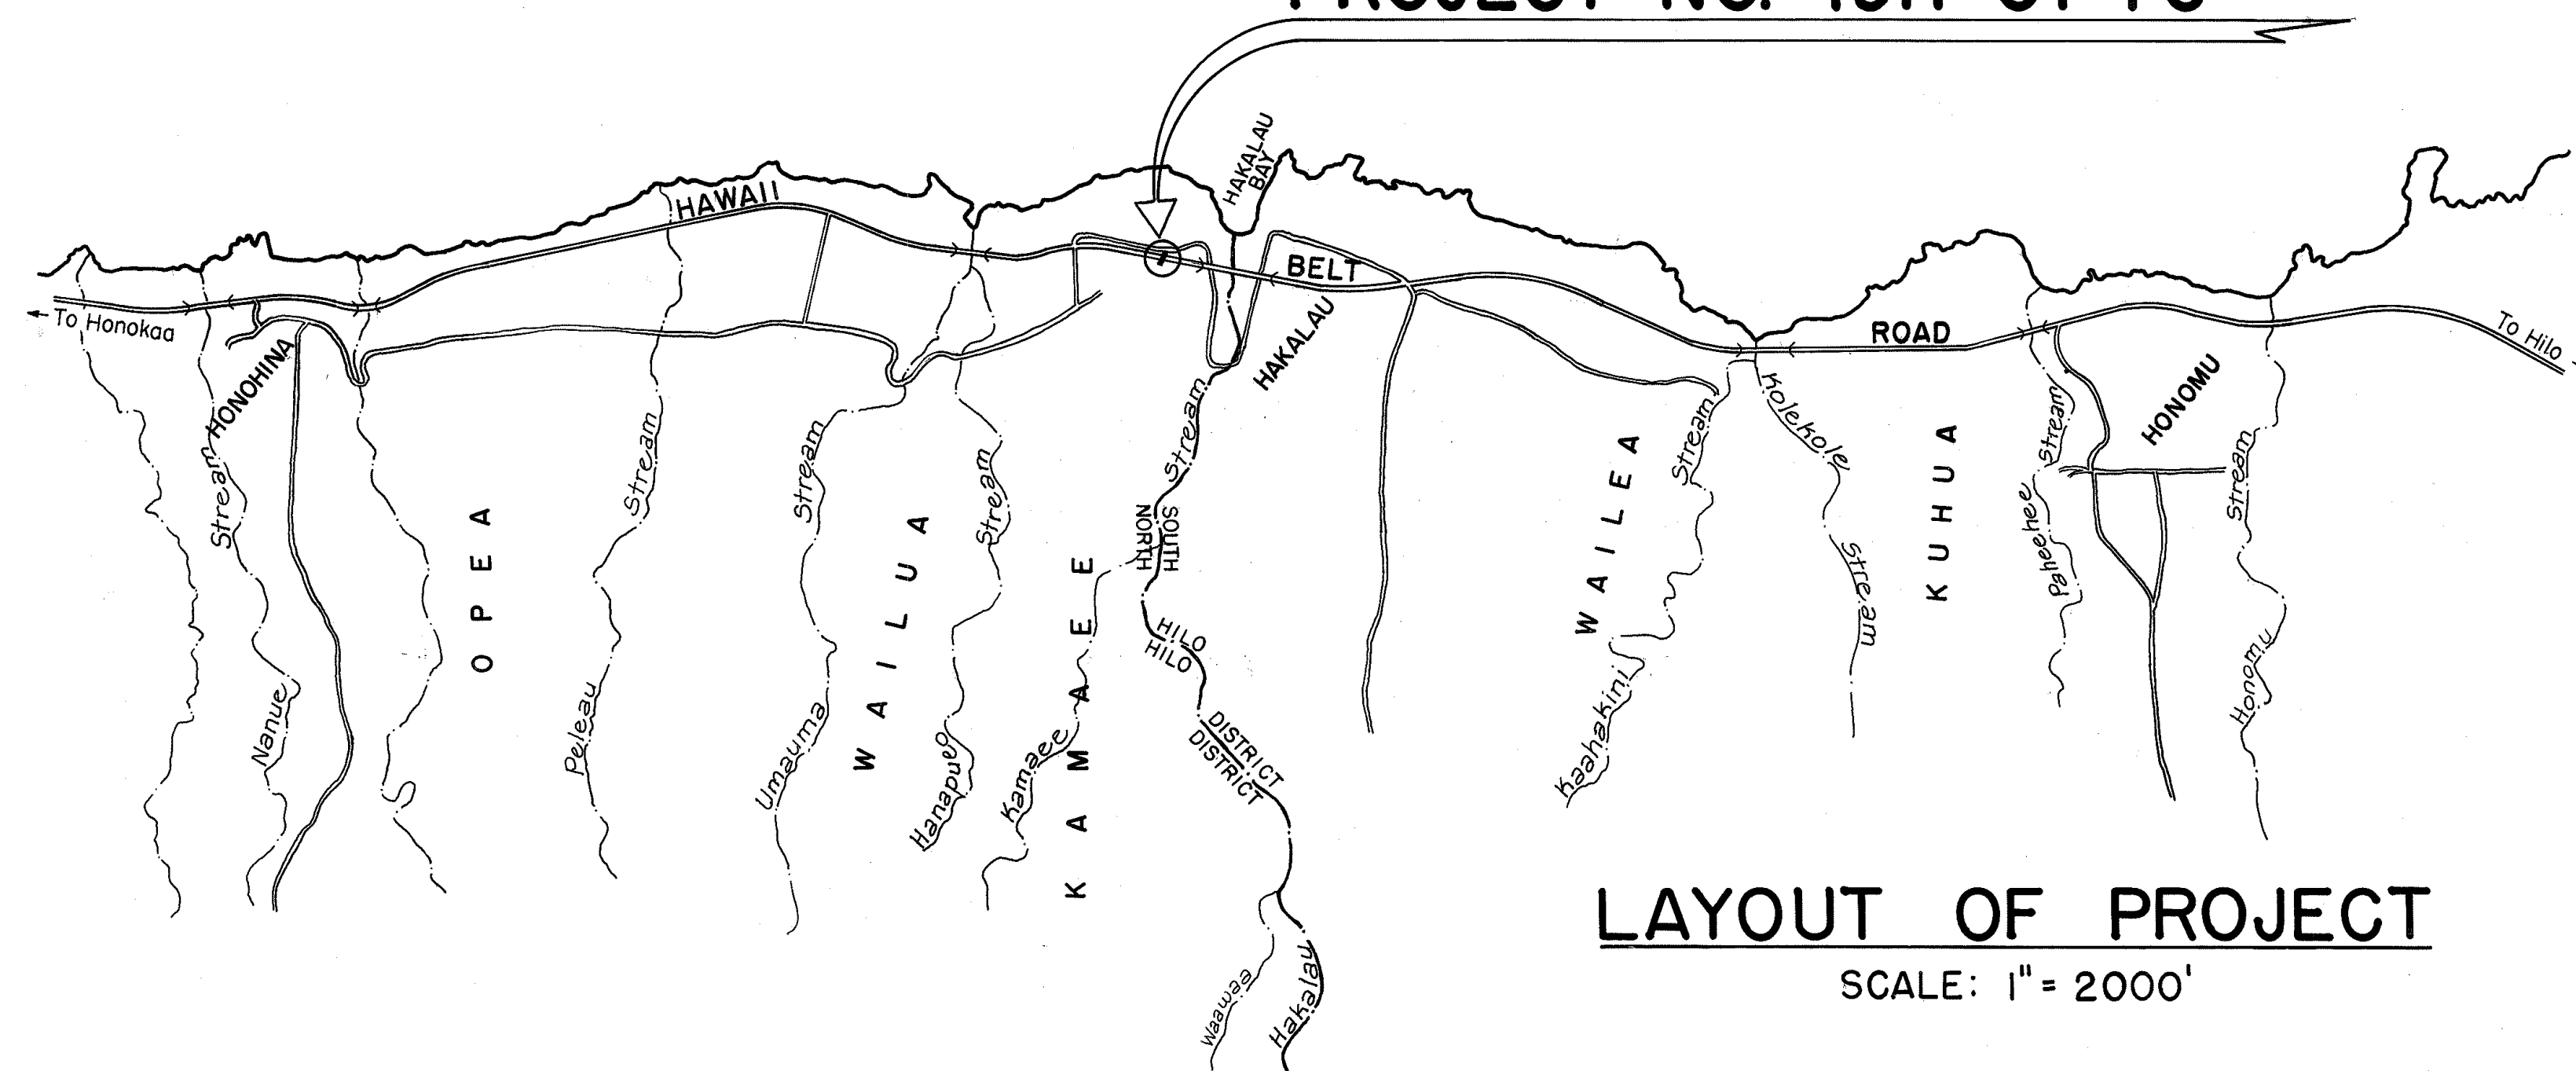

LAYOUT OF PROJECT
SCALE: 1" = 2000'

NO CHANGES WERE MADE DURING CONSTRUCTION ON THESE PLANS EXCEPT CHANGES IN THE ORIGINAL THEORETICAL QUANTITIES. FOR ACTUAL QUANTITIES, REFER TO PROJECT LEDGER AND/OR COMPUTATION BOOK.

Berny K. K. K.
RESIDENT ENGINEER

4-18-82
DATE

DEPARTMENT OF TRANSPORTATION STATE OF HAWAII	
APPROVED:	
<i>R. Higashionna</i>	4/21/76
for DIR. OF TRANSPORTATION	DATE

HAWAII DISTRICT M. Miura - Unit C 548-7400 Mar. 1976
DESIGNED BY P. S. & E. BY PHONE DATE