


FED. ROAD DIST. NO.	STATE	PROJ. NO.	FISCAL YEAR	SHEET NO.	TOTAL SHEETS
HAWAII	HAW.	19H-02-04M	2004	5	7

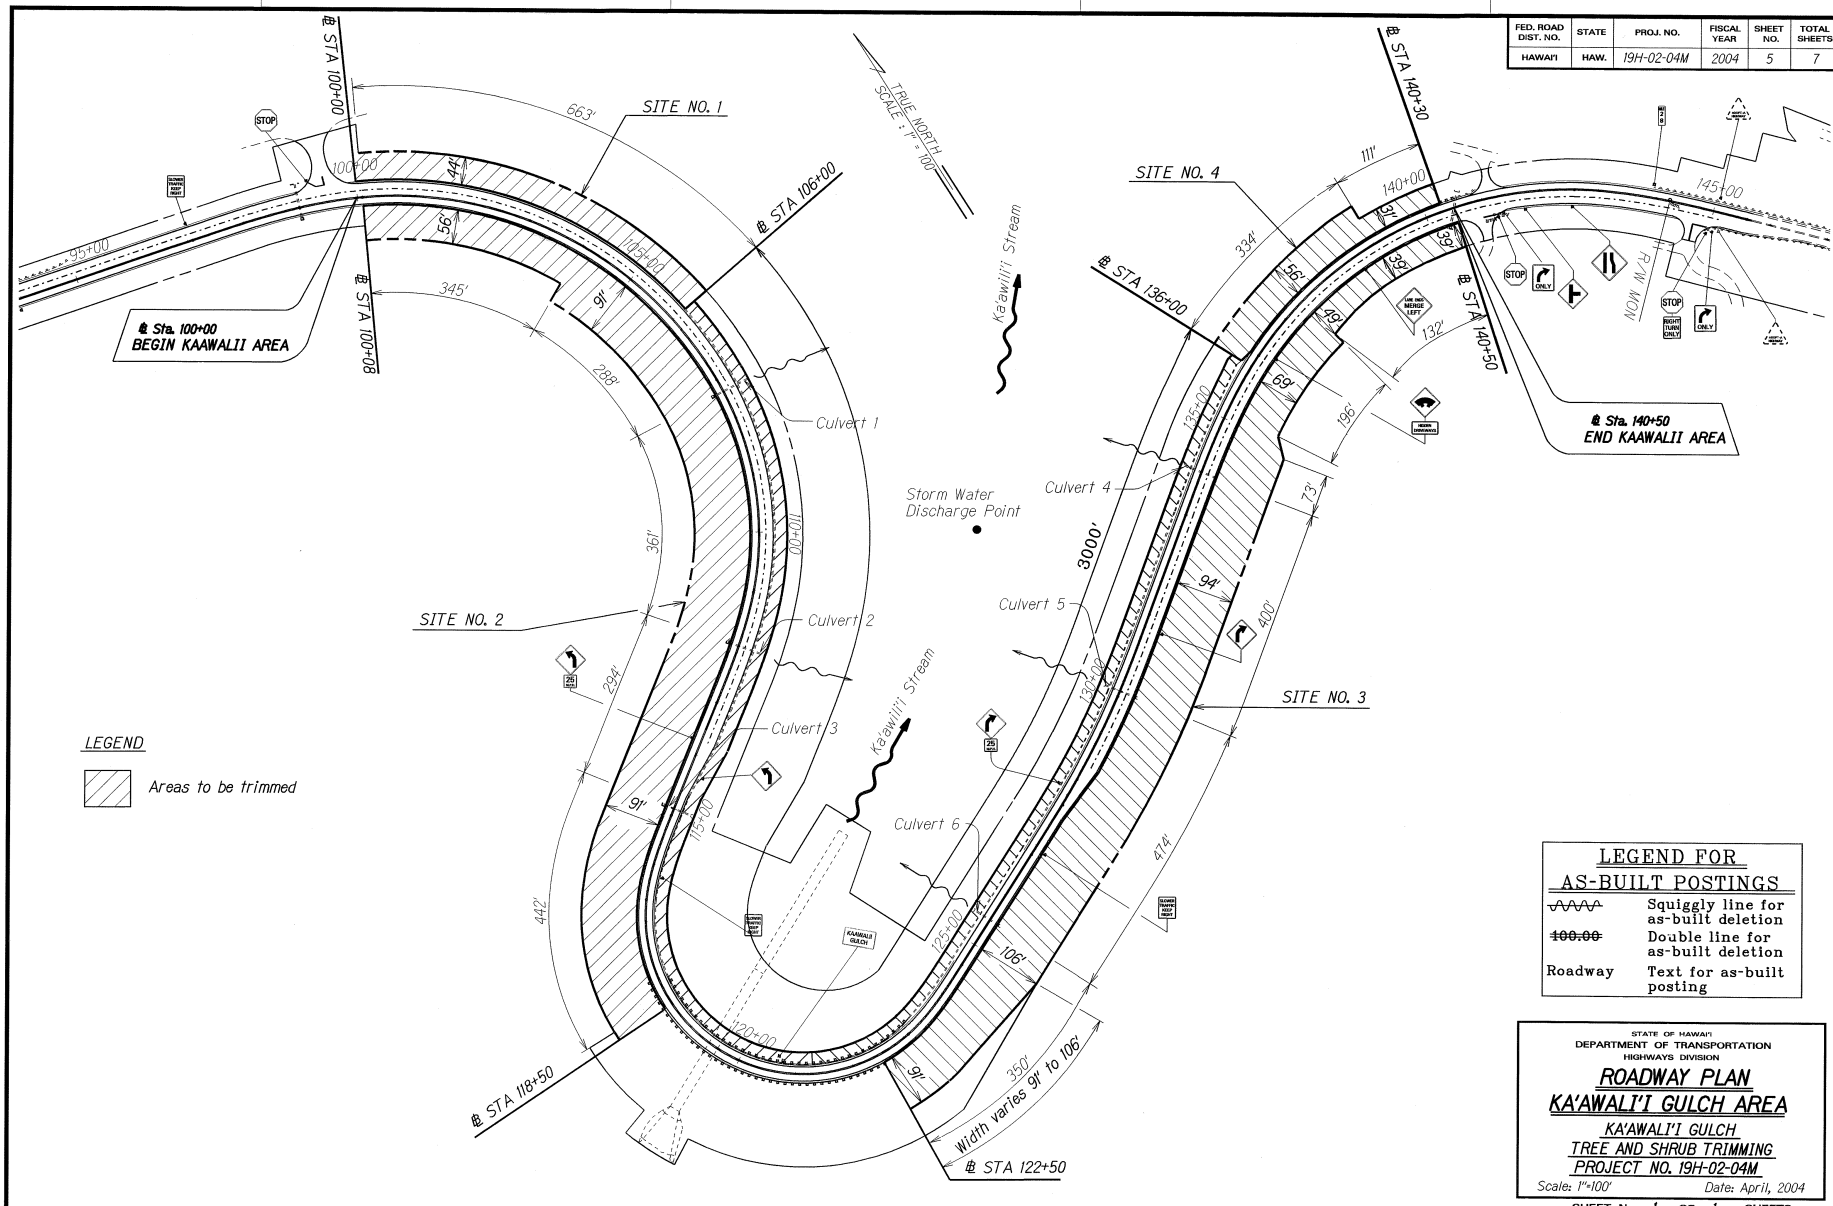

LEGEND FOR AS-BUILT POSTINGS	
~~~~~	Squiggly line for as-built deletion
==	Double line for as-built deletion
Roadway	Text for as-built posting

STATE OF HAWAII  
DEPARTMENT OF TRANSPORTATION  
HIGHWAYS DIVISION

**ROADWAY PLAN**  
**KA'AWALI'I GULCH AREA**  
KA'AWALI'I GULCH  
TREE AND SHRUB TRIMMING  
PROJECT NO. 19H-02-04M

Scale: 1"=100' Date: April, 2004

SHEET No. 1 OF 7 SHEETS

"AS-BUILT"