





[illegible]

STATE OF HAWAII
DEPARTMENT OF TRANSPORTATION
HIGHWAYS DIVISION
HONOLULU, HAWAII
"AS-BUILT"
PLANS FOR

KA'AWALI'I GULCH TREE & SHRUB TRIMMING

PROJECT NO. 19H-02-04M

**DISTRICT OF NORTH HILO
ISLAND OF HAWAI'I**

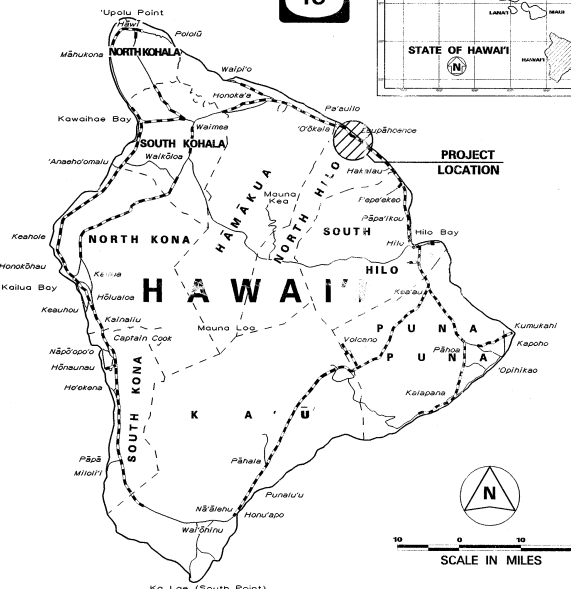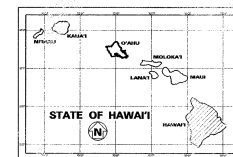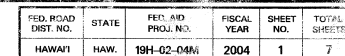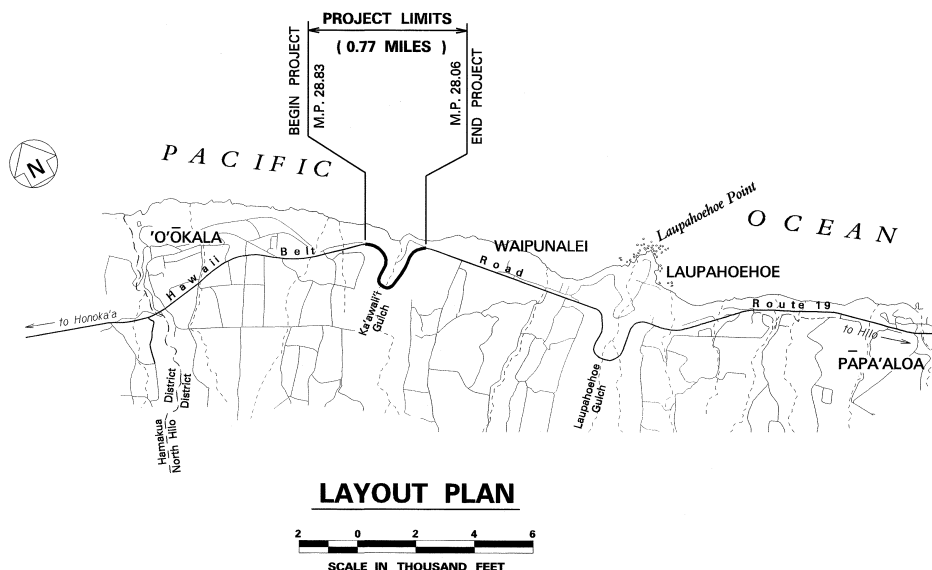

--- FEDERAL AID PROJECTS PREVIOUSLY CONSTRUCTED
OR UNDER CONSTRUCTION

MILE POST 28.06 TO MILE POST 28.83 , ROUTE 19

CHANGES MADE DURING CONSTRUCTION HAVE BEEN INCORPORATED ON THESE PLANS EXCEPT CHANGE IN THE ORIGINAL THEORETICAL QUANTITIES. FOR ACTUAL QUANTITIES, REFER TO PROJECT LOGS AND/OR COMPUTATION BOOK.

AND/OR COMPUTATION BOOK

V. J. [Signature] 1/3/07

[Signature] DATE

April, 1995
DATE

33-8866
PHONE

HWY-HE	MANAGED BY
1	1
2	2
3	3
100	100

HAWAII DISTRICT
DESIGNED BY