



ORIGINAL PLAN	SURVEY PLOTTED BY _____	DATE _____
NOTE BOOK	DRAWN BY _____	" _____
	TRACED BY _____	" _____
	DESIGNED BY _____	" _____
	QUANTITIES BY _____	" _____
No. _____	CHECKED BY _____	" _____

ORIGINAL PLAN	SURVEY PLOTTED BY _____	DATE _____
NOTE BOOK	DRAWN BY _____	" _____
	TRACED BY _____	" _____
	DESIGNED BY _____	" _____
	QUANTITIES BY _____	" _____
No. _____	CHECKED BY _____	" _____

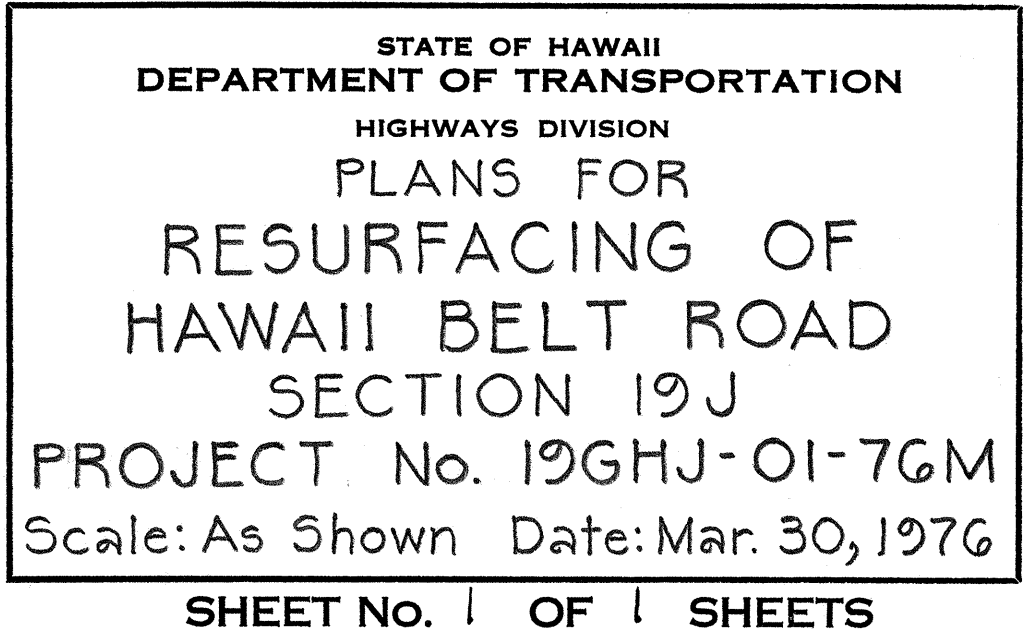

STATE OF HAWAII
DEPARTMENT OF TRANSPORTATION
HIGHWAYS DIVISION
PLANS FOR
RESURFACING OF
HAWAII BELT ROAD
SECTION 19J
PROJECT No. 19GHJ-01-76M
Scale: As Shown Date: Mar. 30, 1976
SHEET No. 1 OF 1 SHEETS

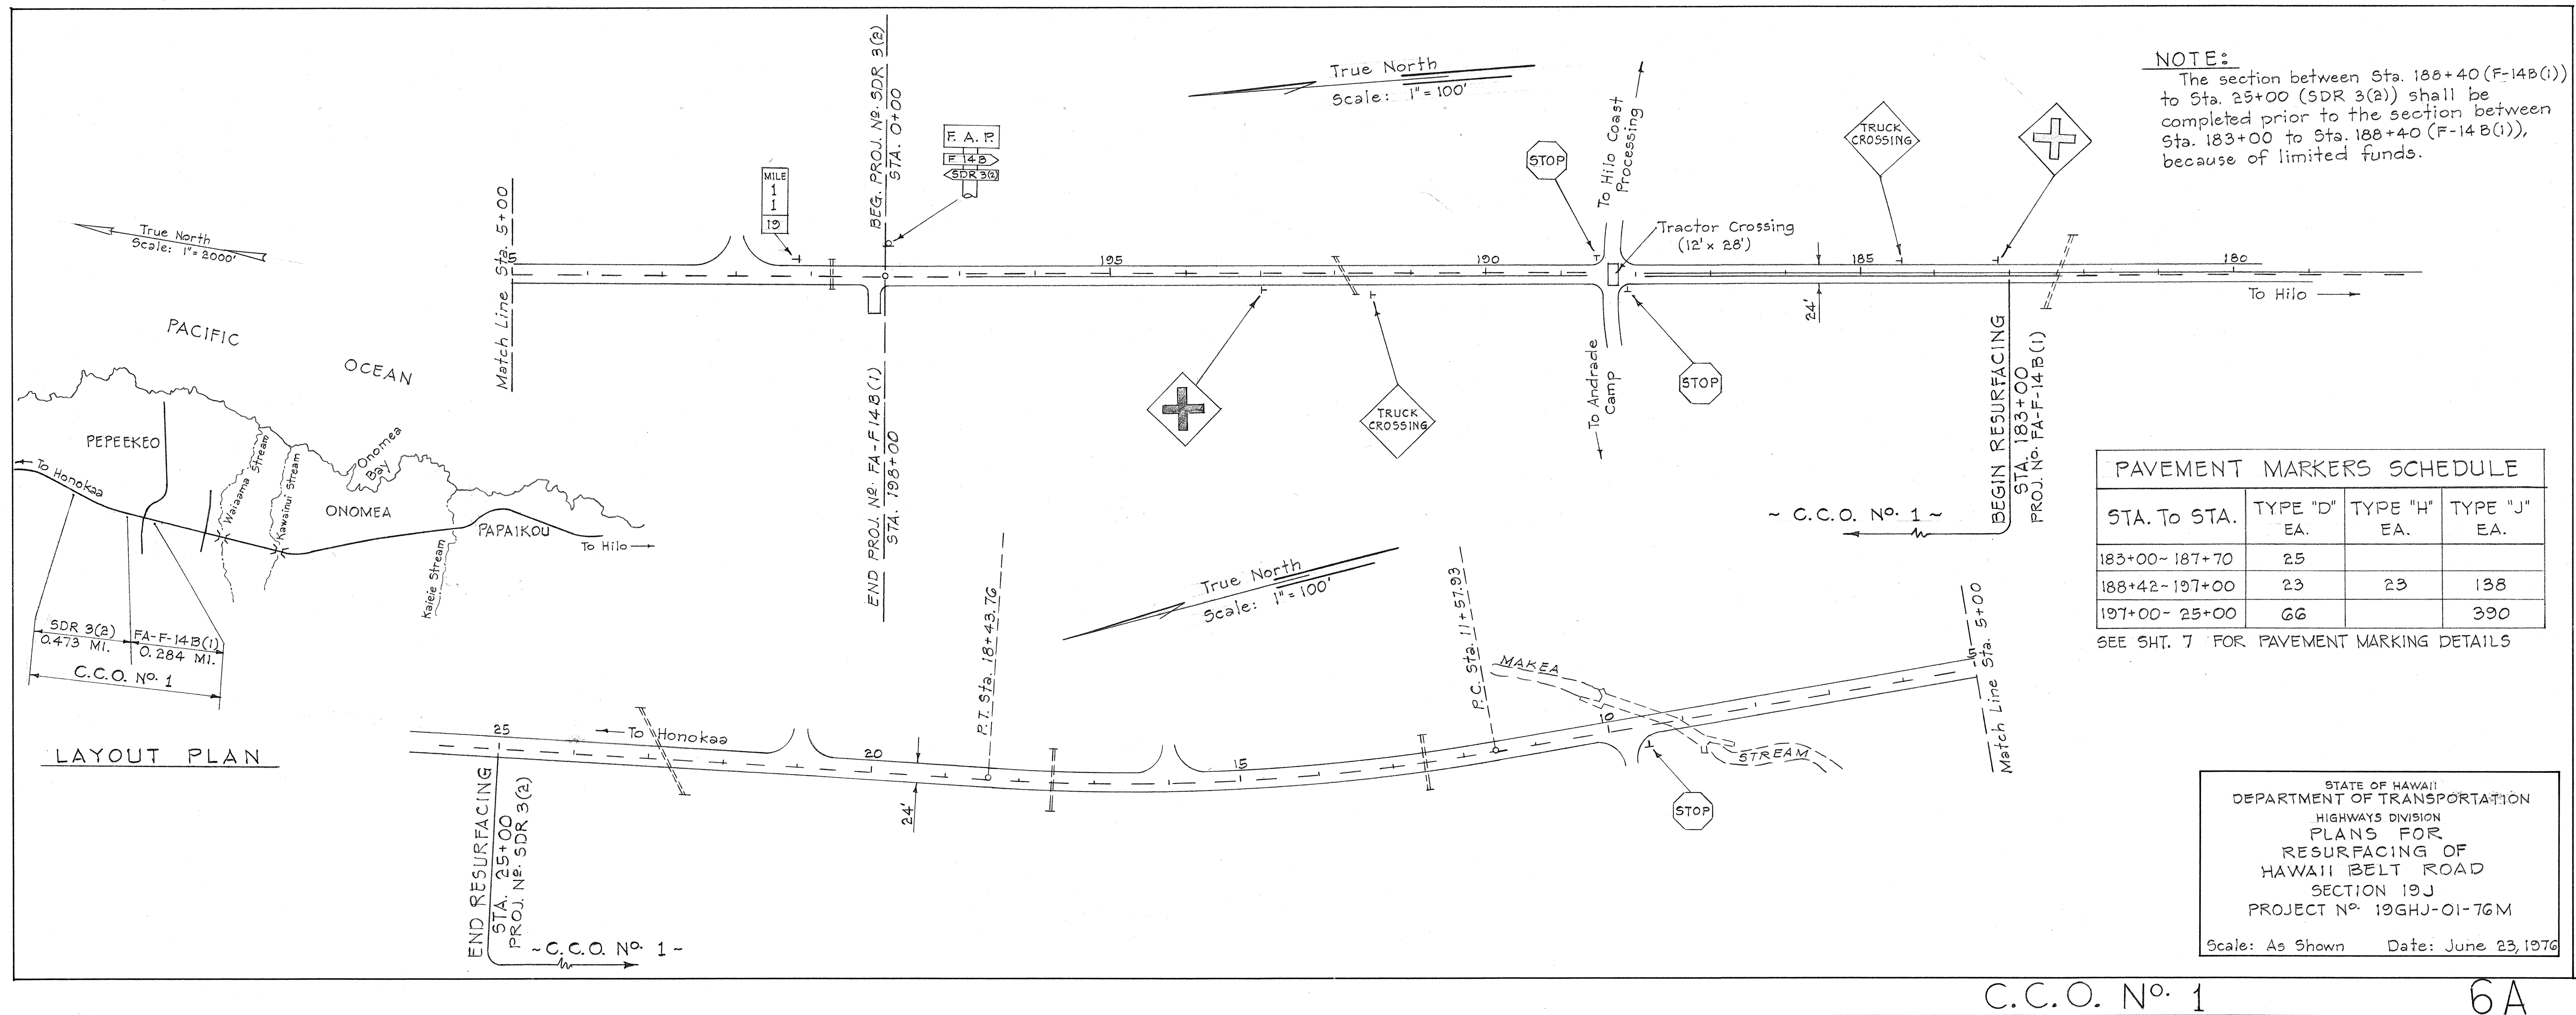

NOTE:
 The section between Sta. 188+40 (F-14B(1)) to Sta. 25+00 (SDR 3(2)) shall be completed prior to the section between Sta. 183+00 to Sta. 188+40 (F-14B(1)), because of limited funds.

PAVEMENT MARKERS SCHEDULE			
STA. TO STA.	TYPE "D" EA.	TYPE "H" EA.	TYPE "J" EA.
183+00~187+70	25		
188+42~197+00	23	23	138
197+00~25+00	66		390

SEE SHT. 7 FOR PAVEMENT MARKING DETAILS