
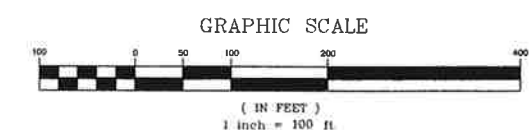


FED. ROAD DIST. NO.	STATE	FED. AID PROJ. NO.	FISCAL YEAR	SHEET NO.	TOTAL SHEETS
HAWAII	HAW.	NH-019-1(20)	2005	18	315

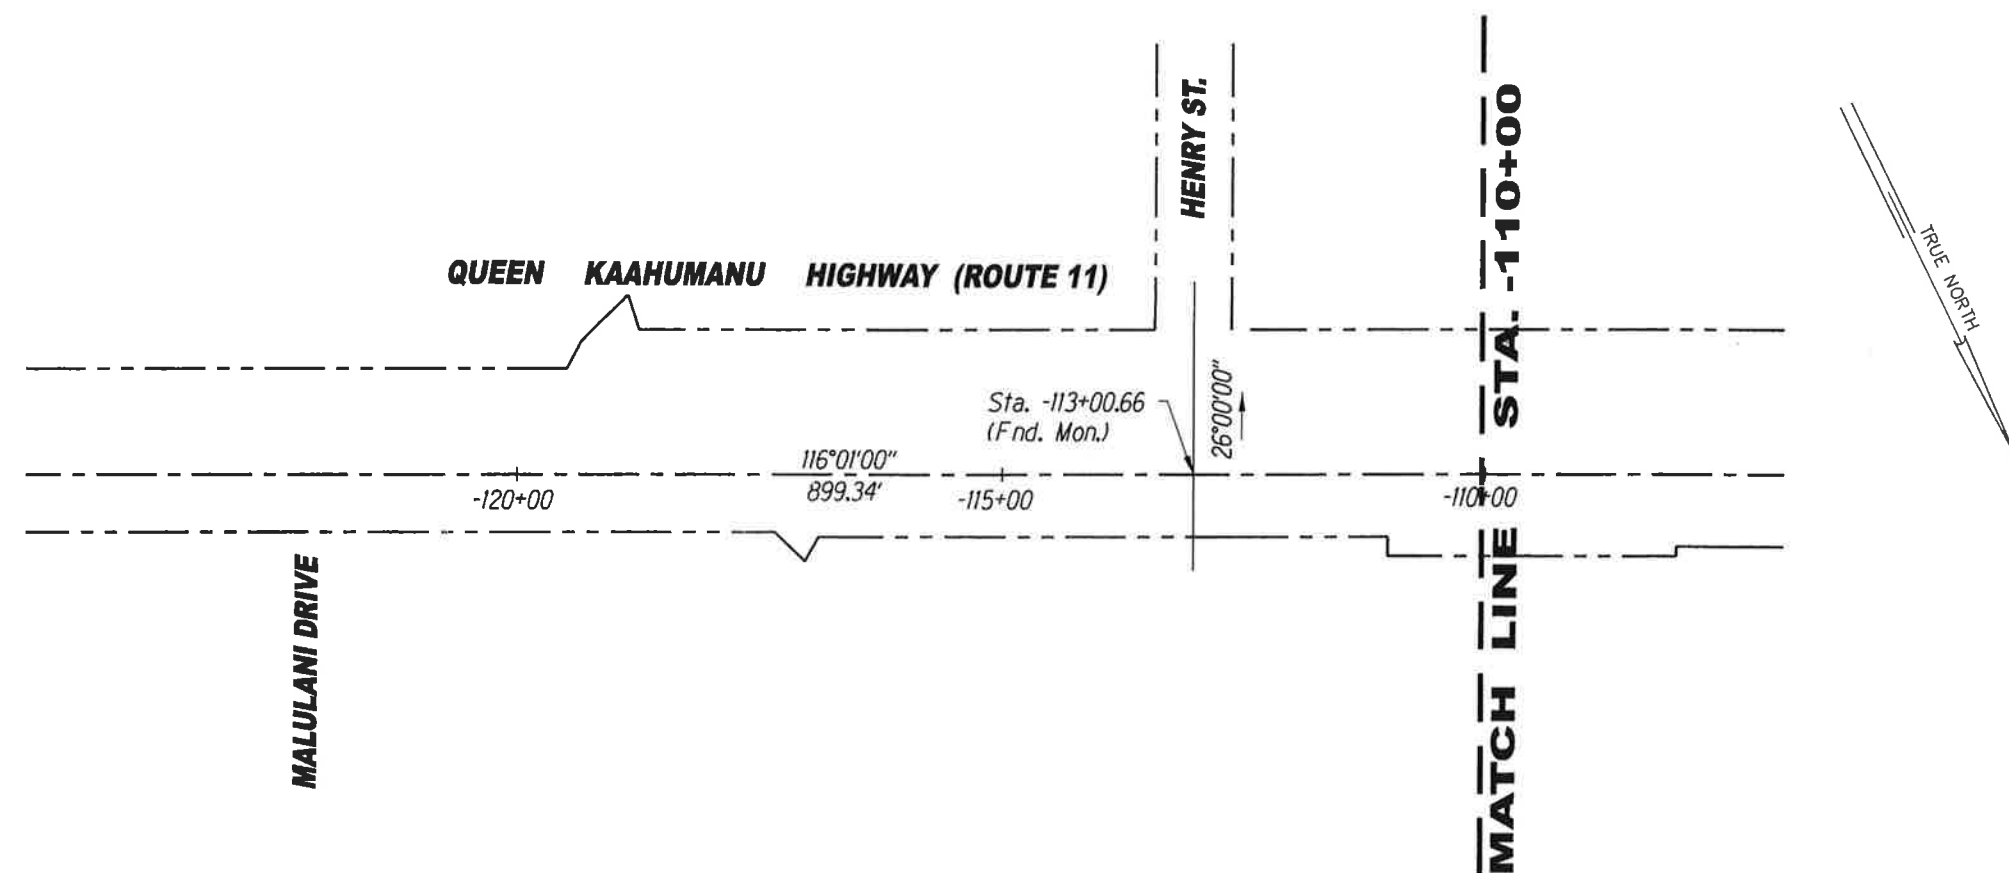

This work was prepared by me
or under my supervision.
Exp. 04-30-10
Neal S. Fukunoto
Wesley R. Segawa & Associates, Inc.

STATE OF HAWAII
DEPARTMENT OF TRANSPORTATION
HIGHWAYS DIVISION

BASELINE DATA

QUEEN KAAHUMANU HIGHWAY WIDENING
HENRY ST. to KEALAKEHE PKWY - PHASE I
Federal Aid Project No. NH-019-1(20)


Scale: 1" = 100' Date: November 2009

SHEET No. 1 OF 4 SHEETS


ORIGINAL PLAN	SURVEY PLOTTED BY	DATE
NOTE BOOK	DRAWN BY	
	DESIGNED BY	
	CHECKED BY	

AS-BUILT


FED. ROAD DIST. NO.	STATE	FED. AID PROJ. NO.	FISCAL YEAR	SHEET NO.	TOTAL SHEETS
HAWAII	HAW.	NH-019-1(20)	2005	19	315

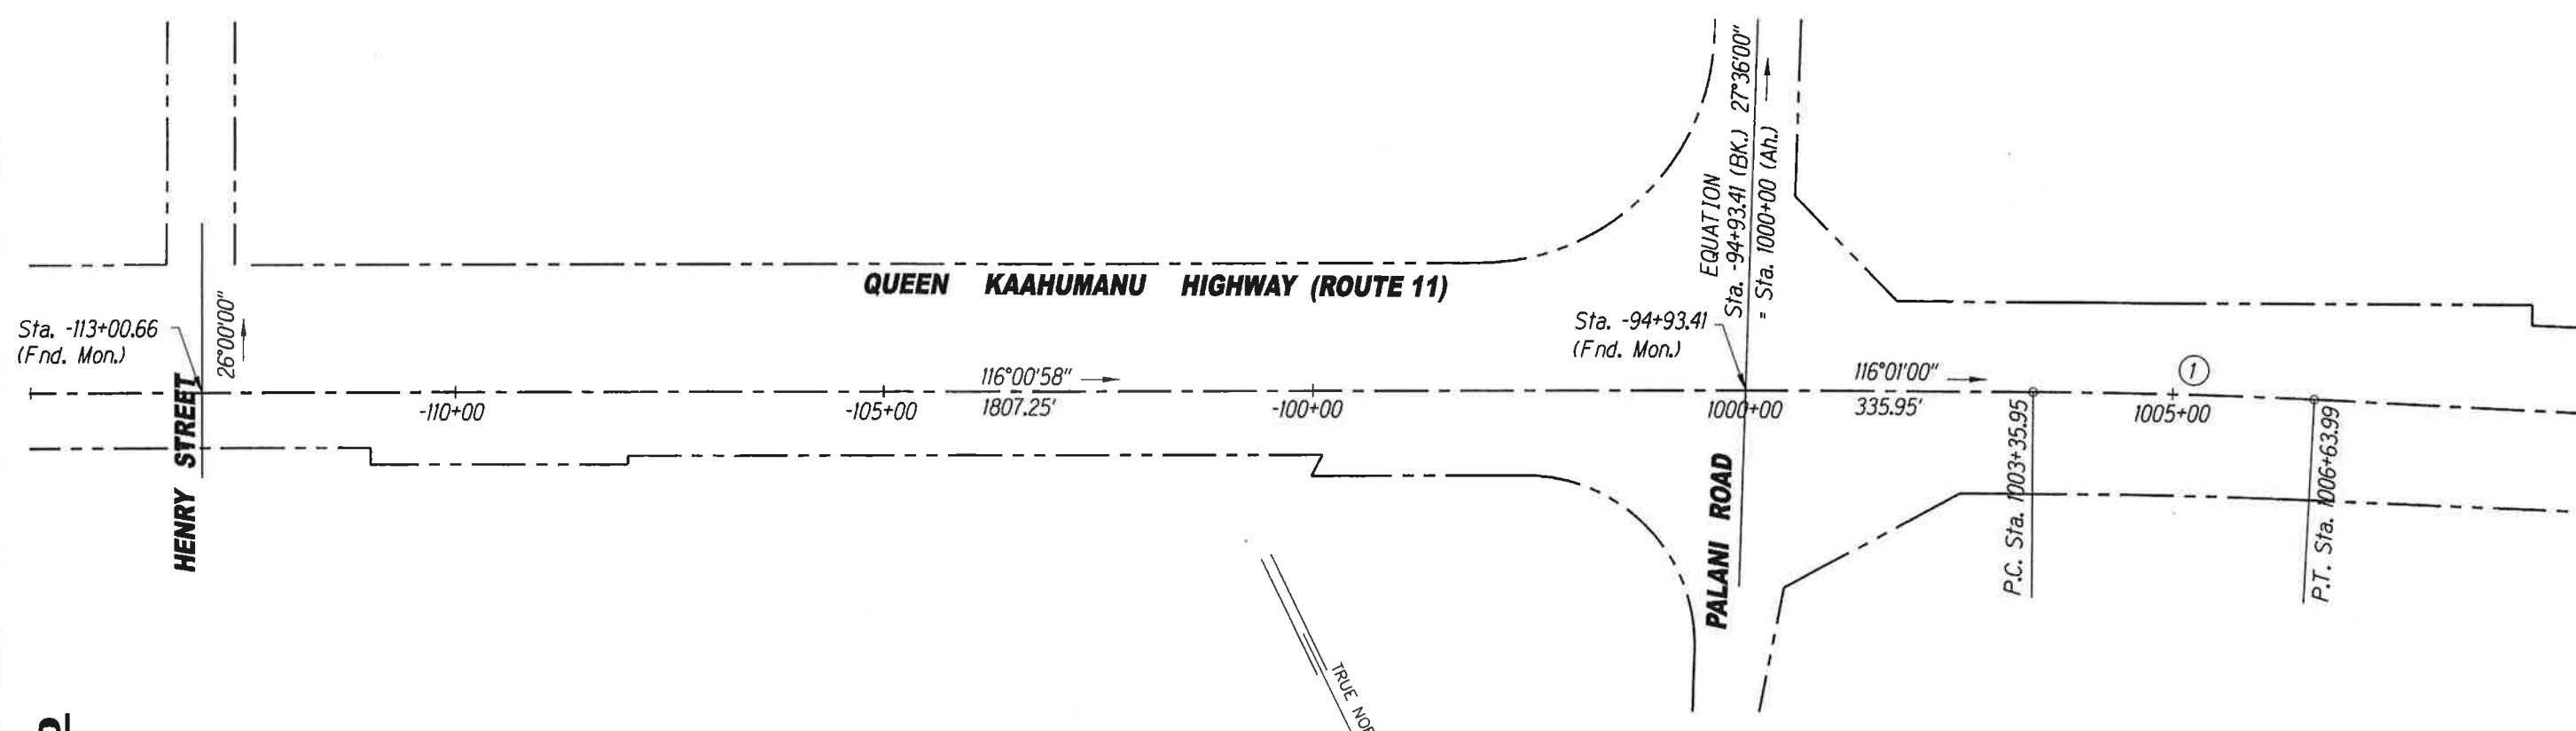

SEE ABOVE
MATCH LINE STA. 1010+00

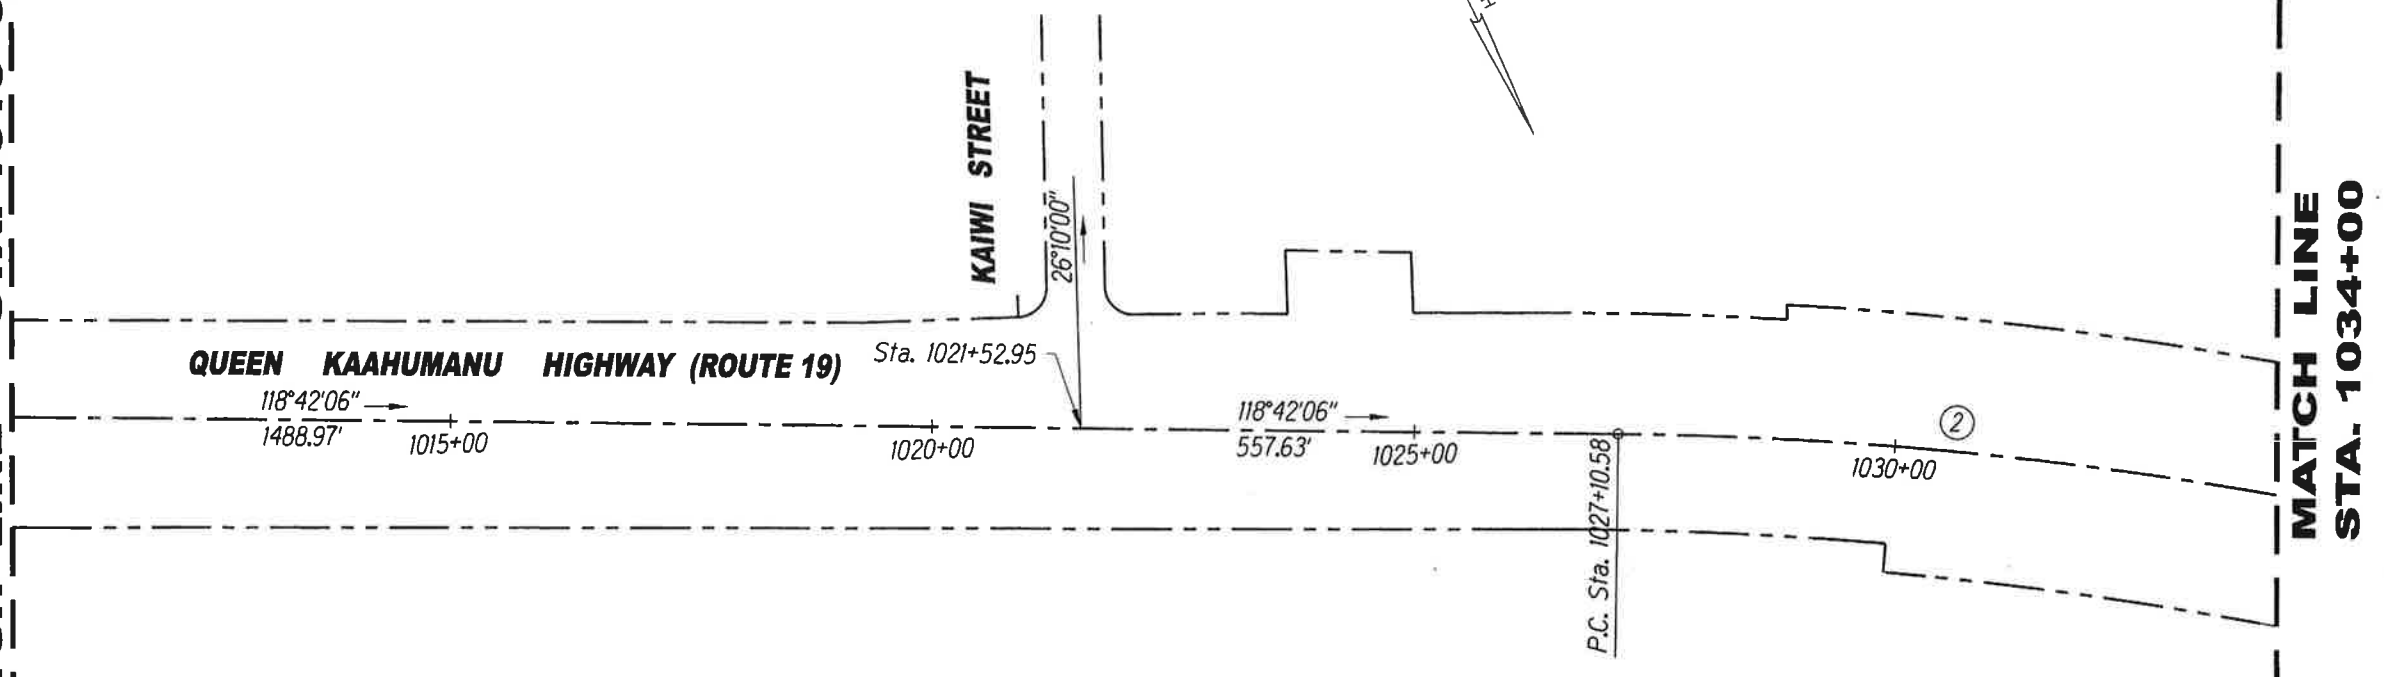

#	CURVE DATA	①
Δ	2°41'06"	
R	7000.00'	
L	328.03'	
T	164.05'	
L _c	328.00'	
#	CURVE DATA	②
Δ	37°12'54"	
R	4500.00'	
L	2922.86'	
T	1515.07'	
L _c	2871.75'	

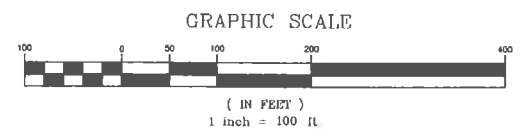

This work was prepared by me or under my supervision.
Exp. 04-30-10
Wesley R. Sagawa
Wesley R. Sagawa & Associates, Inc.

STATE OF HAWAII
DEPARTMENT OF TRANSPORTATION
HIGHWAYS DIVISION



BASELINE DATA

QUEEN KAAHUMANU HIGHWAY WIDENING
HENRY ST. to KEALAKEHE PKWY - PHASE I
Federal Aid Project No. NH-019-1(20)
Scale: As Noted Date: November 2009


ORIGINAL PLAN	SURVEY PLOTTED BY	DATE
NOTE BOOK	DRAWN BY	
	CHECKED BY	
	QUANTITIES BY	
	DESIGNED BY	
	APPROVED BY	

AS-BUILT

FED. ROAD DIST. NO.	STATE	FED. AID PROJ. NO.	FISCAL YEAR	SHEET NO.	TOTAL SHEETS
HAWAII	HAW.	NH-019-1(20)	2005	20	315

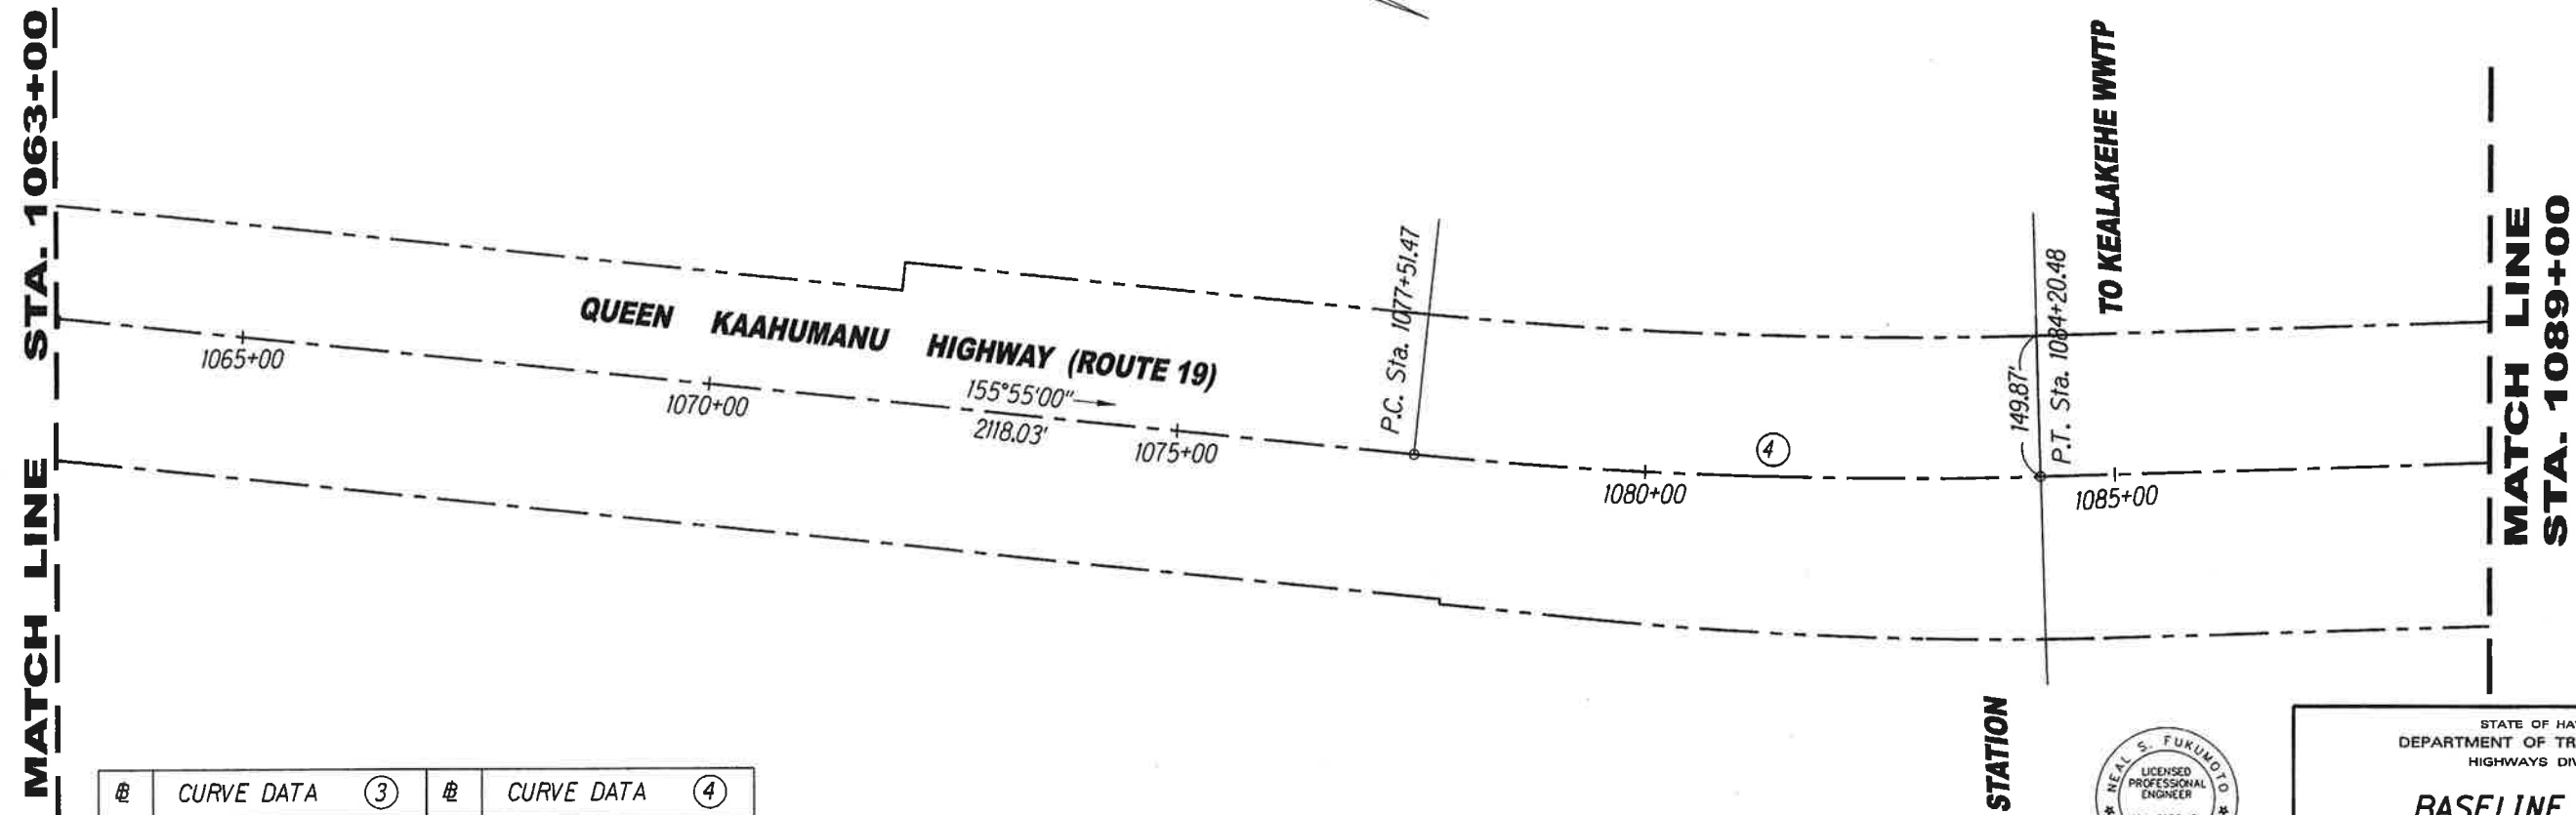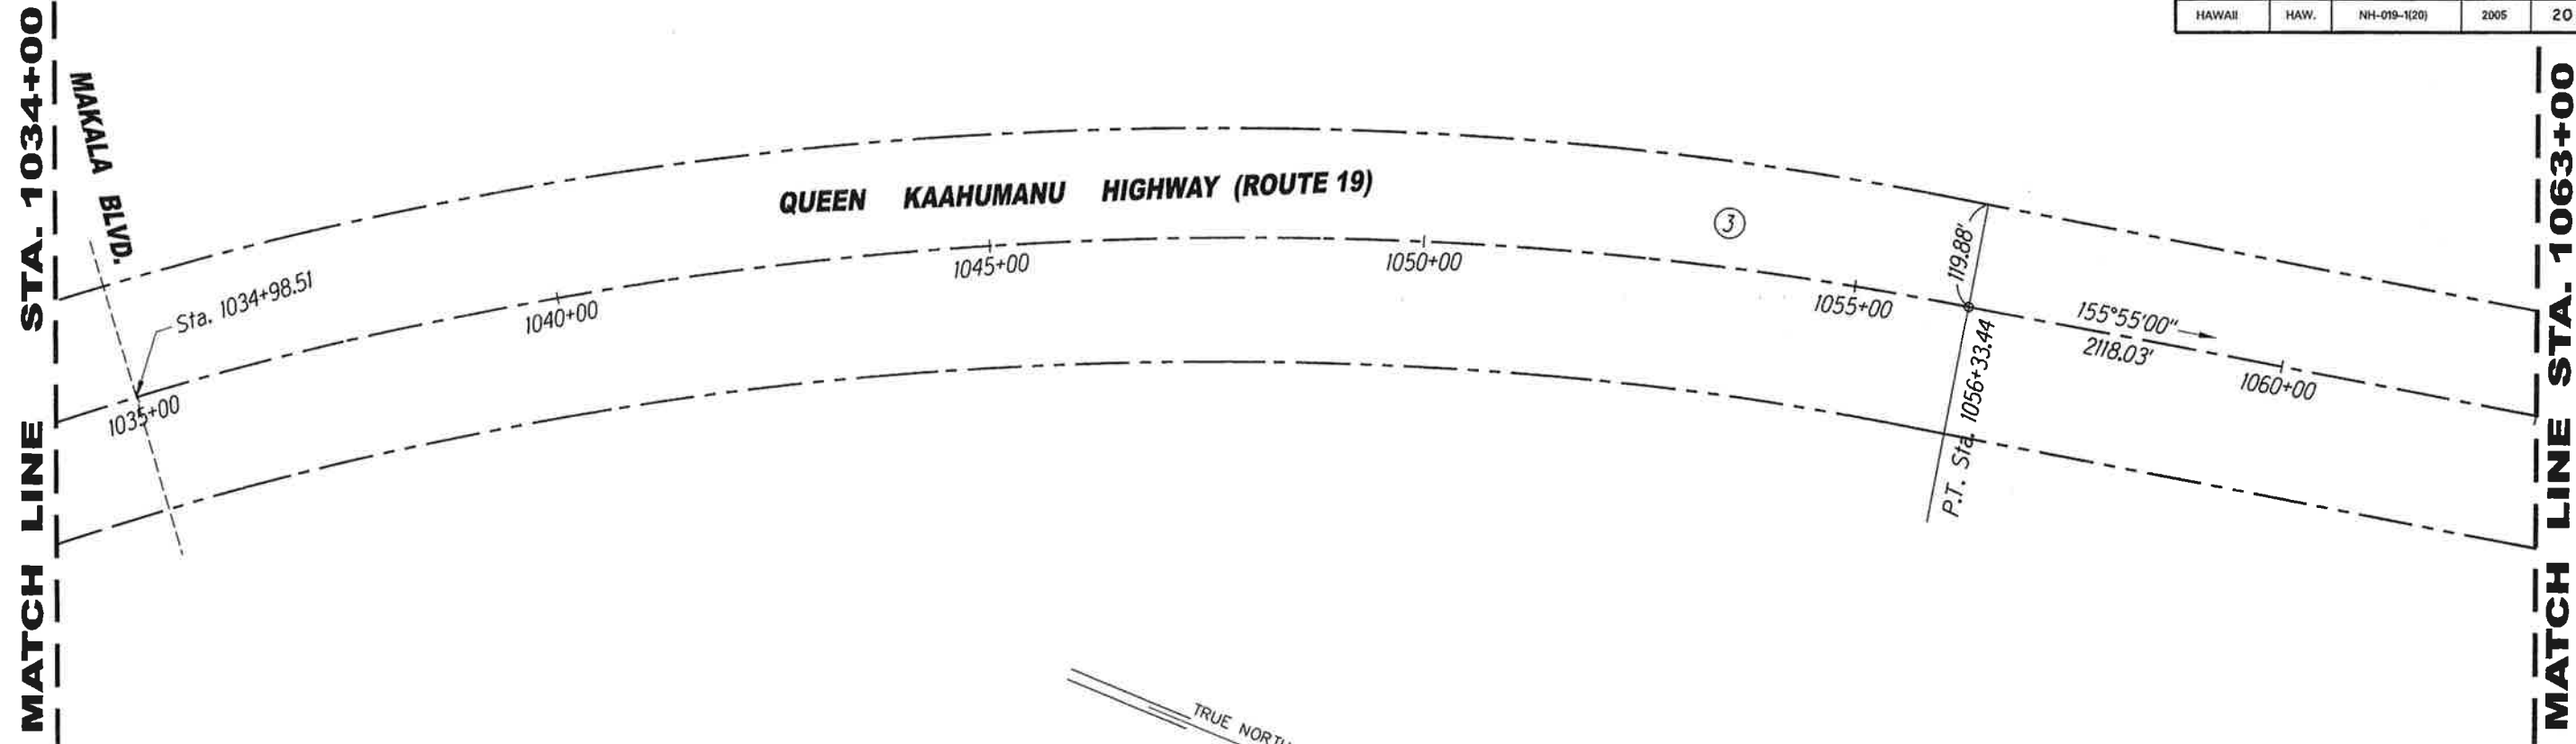

#	CURVE DATA ③	#	CURVE DATA ④
Δ	37°12'54"	Δ	7°45'00"
R	4500.00'	R	4946.00'
L	2922.86'	L	669.01'
T	1515.07'	T	335.02'
℄	2871.75'	℄	668.50'

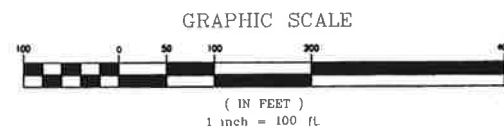

This work was prepared by me or under my supervision.
Exp. 04-30-10
Neal S. Fukunaga
Wesley R. Segawa & Associates, Inc.

STATE OF HAWAII
DEPARTMENT OF TRANSPORTATION
HIGHWAYS DIVISION

BASELINE DATA

**QUEEN KAAHUMANU HIGHWAY WIDENING
HENRY ST. to KEALAKEHE PKWY - PHASE I**

Federal Aid Project No. NH-019-1(20)


Scale: As Noted Date: November 2009

SHEET No. 3 OF 4 SHEETS


ORIGINAL PLAN	SURVEY PLOTTED BY	DATE
NOTE BOOK	DRAWN BY	
	DESIGNED BY	
	CHECKED BY	

AS-BUILT

FED. ROAD DIST. NO.	STATE	FED. AID PROJ. NO.	FISCAL YEAR	SHEET NO.	TOTAL SHEETS
HAWAII	HAW.	NH-019-1(20)	2005	21	315

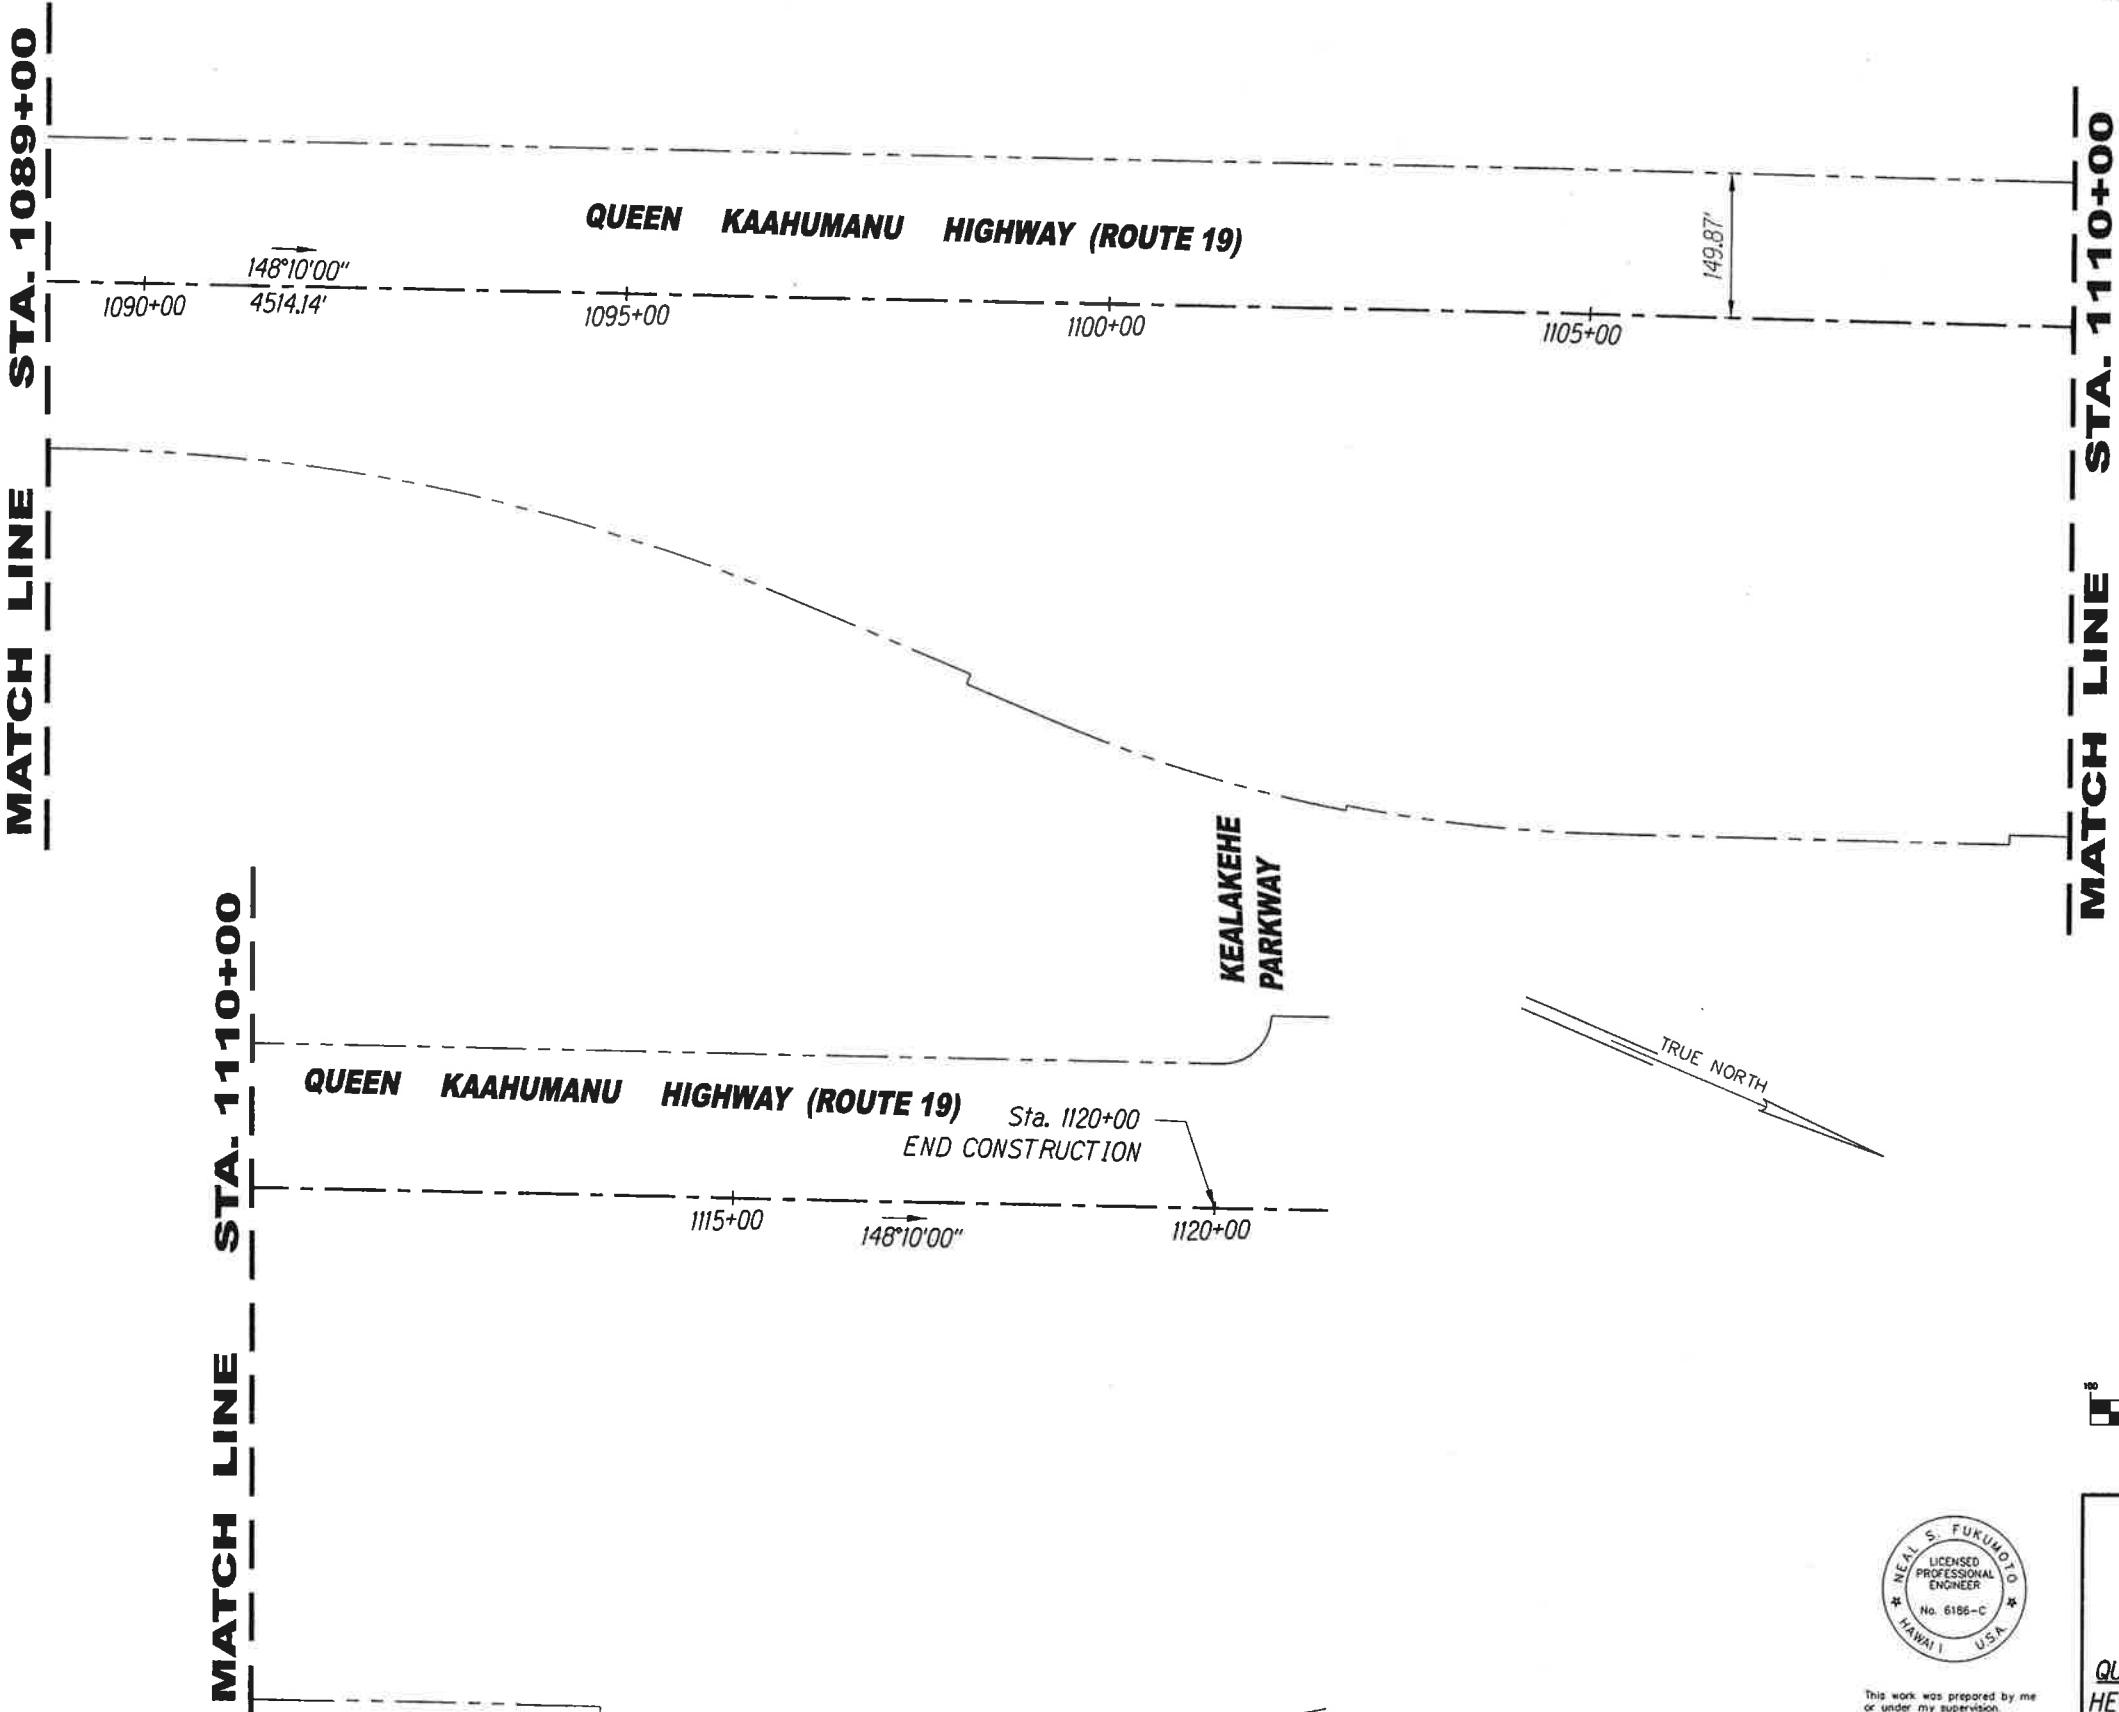

SURVEY PLOTTED BY	DATE
DRAWN BY	
DESIGNED BY	
QUANTITIES BY	
CHECKED BY	
ORIGINAL PLAN	
NOTE BOOK	
NO.	

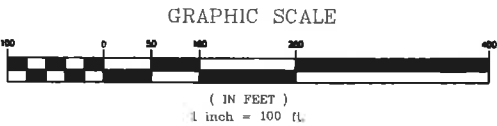

This work was prepared by me or under my supervision.
Exp. 04-30-10
Neal S. Fukunoto
Wesley R. Segovia & Associates, Inc.

STATE OF HAWAII
DEPARTMENT OF TRANSPORTATION
HIGHWAYS DIVISION

BASELINE DATA

QUEEN KAAHUMANU HIGHWAY WIDENING
HENRY ST. to KEALAKEHE PKWY - PHASE I
Federal Aid Project No. NH-019-1(20)
Scale: 1" = 100' Date: November 2009

SHEET No. 4 OF 4 SHEETS

AS-BUILT