


FED. ROAD DIST. NO.	STATE	FED. AID PROJ. NO.	FISCAL YEAR	SHEET NO.	TOTAL SHEETS
HAWAII	HAW.	NH-019-1(20)	2005	39	315



SURVEY PLOTTED BY	DATE
DRAWN BY	
DESIGNED BY	
NOTED BY	
CHECKED BY	

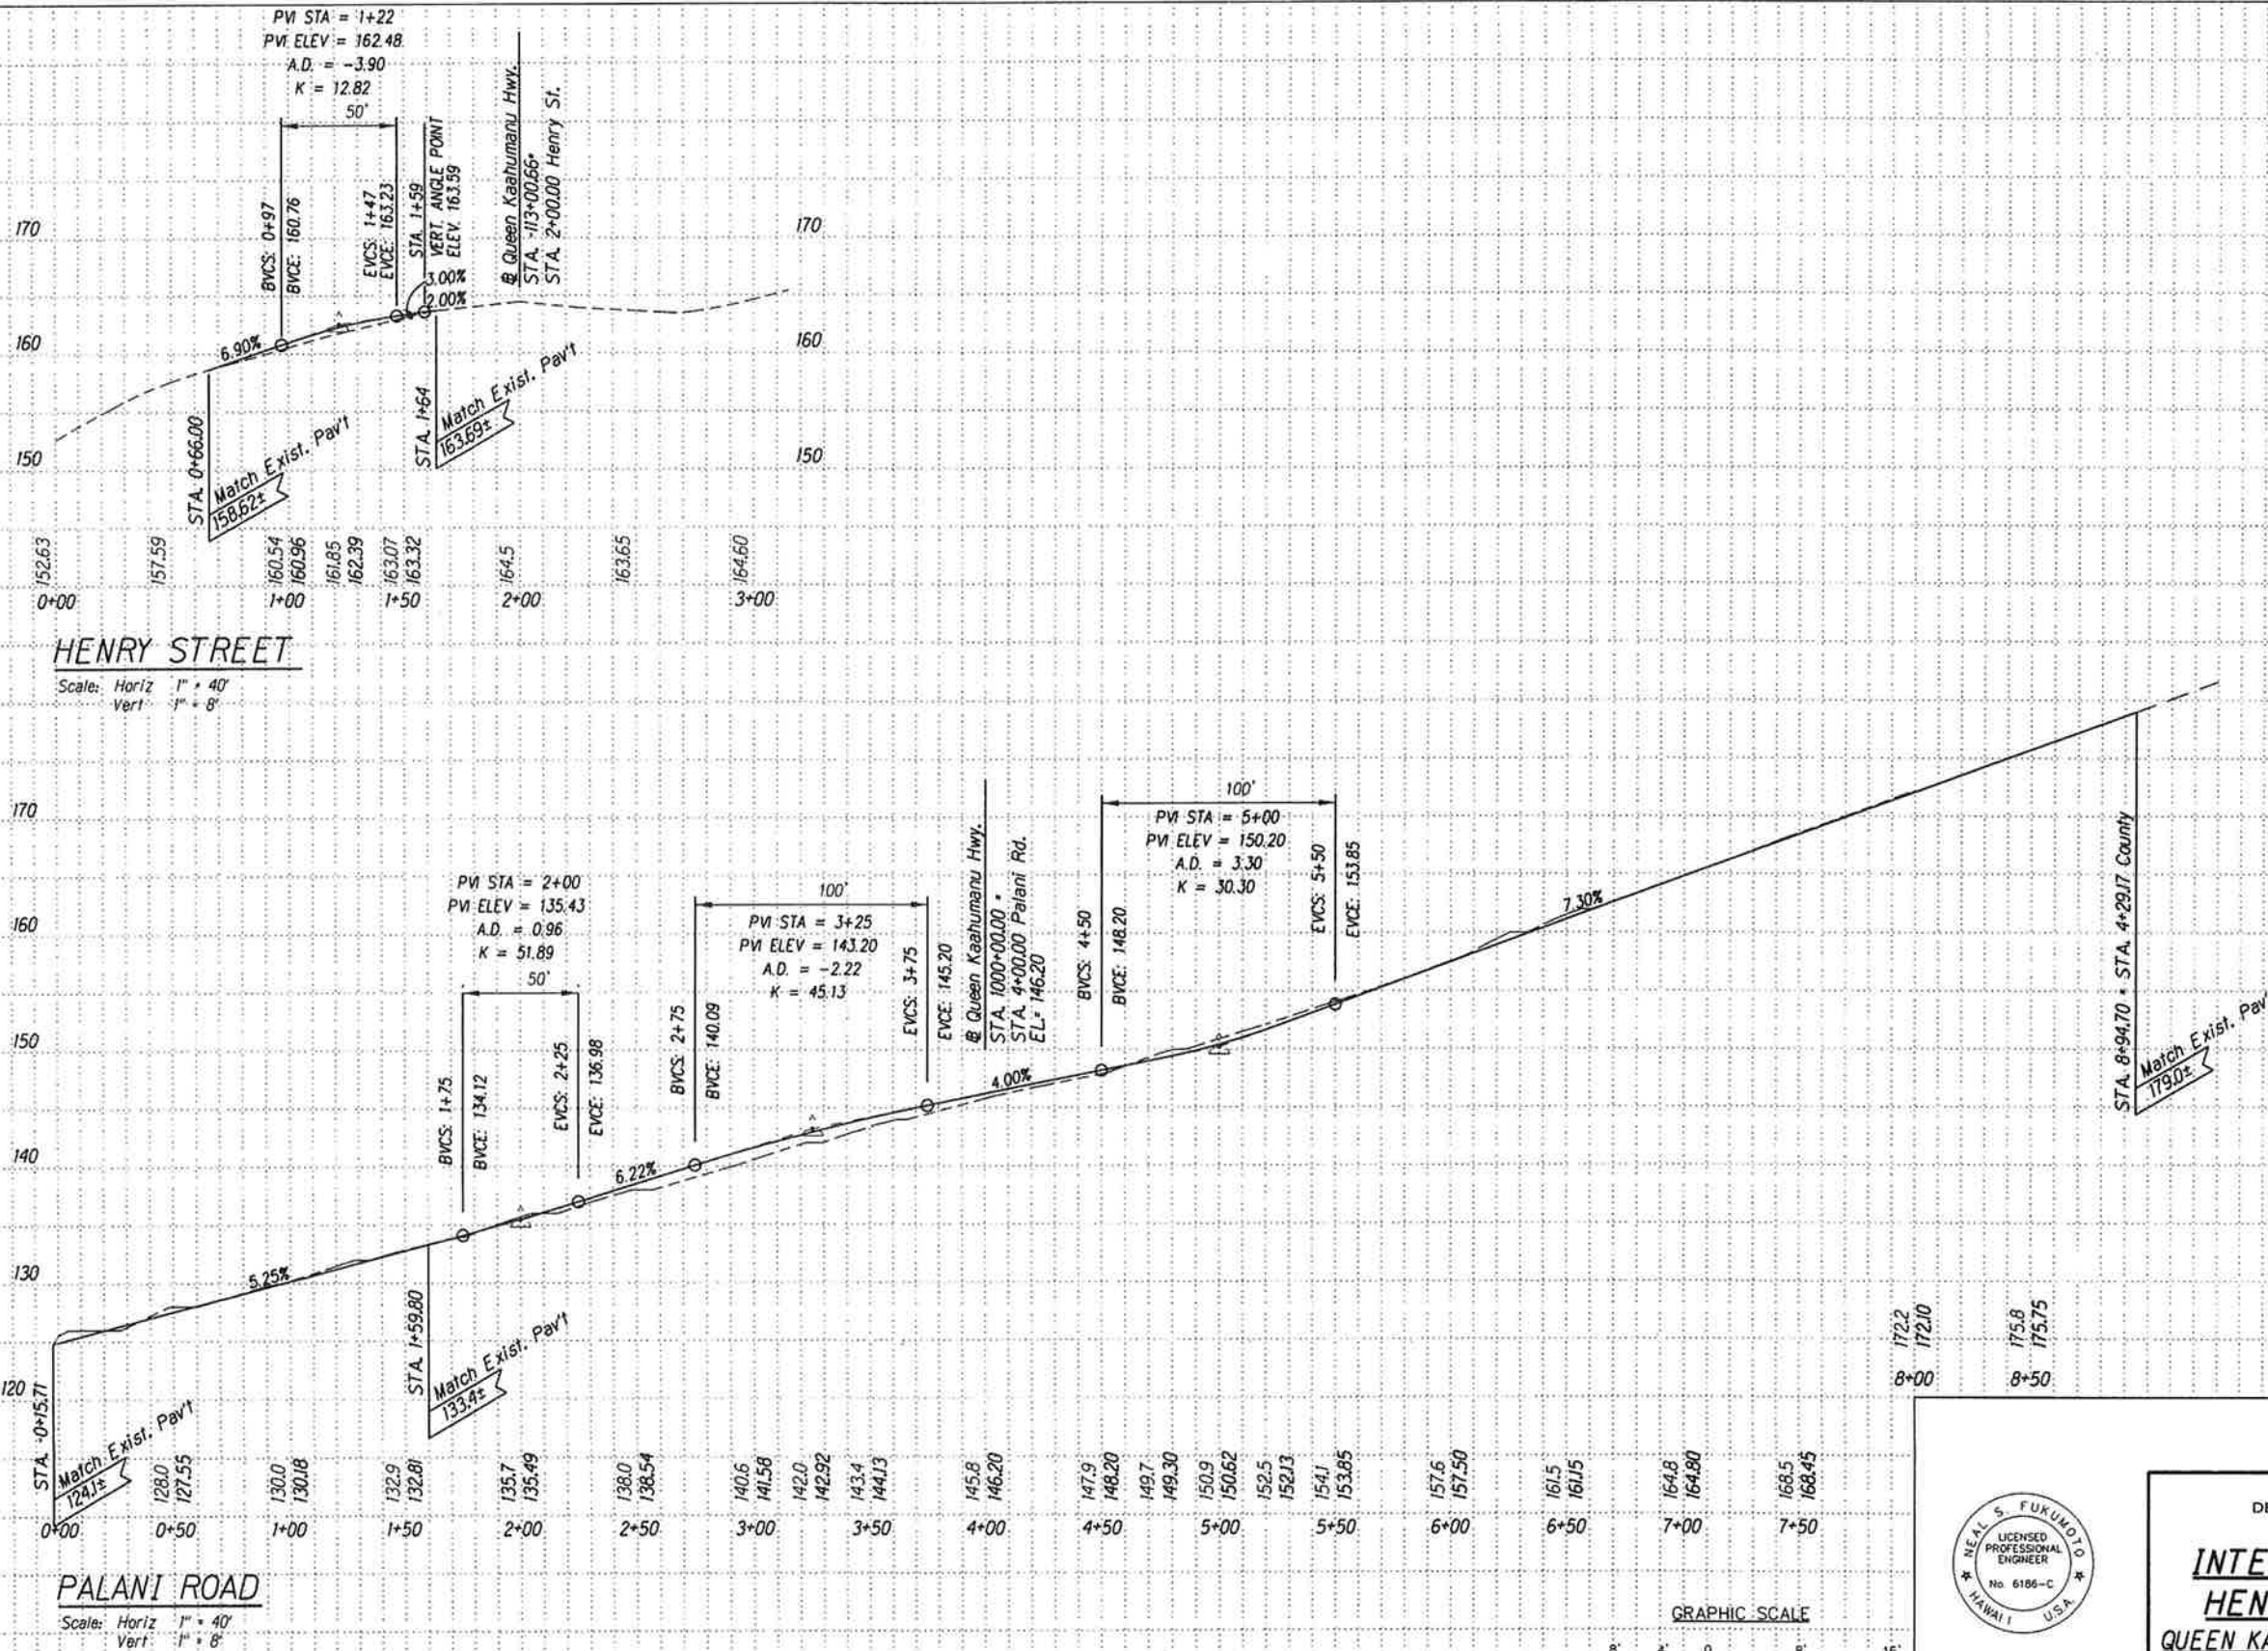

This work was prepared by me or under my supervision.
Exp. 04-30-10
Neal S. Fukumoto
Neely R. Segura & Associates, Inc.


STATE OF HAWAII
DEPARTMENT OF TRANSPORTATION
HIGHWAYS DIVISION

INTERSECTION PROFILE
HENRY ST., PALANI RD.
QUEEN KAAHUMANU HIGHWAY WIDENING
HENRY ST. to KEALAKEHE PKWY - PHASE I
Federal Aid Project No. NH-019-1(20)

Scale: As Noted Date: November 2009


SHEET No. 1 OF 3 SHEETS

AS-BUILT

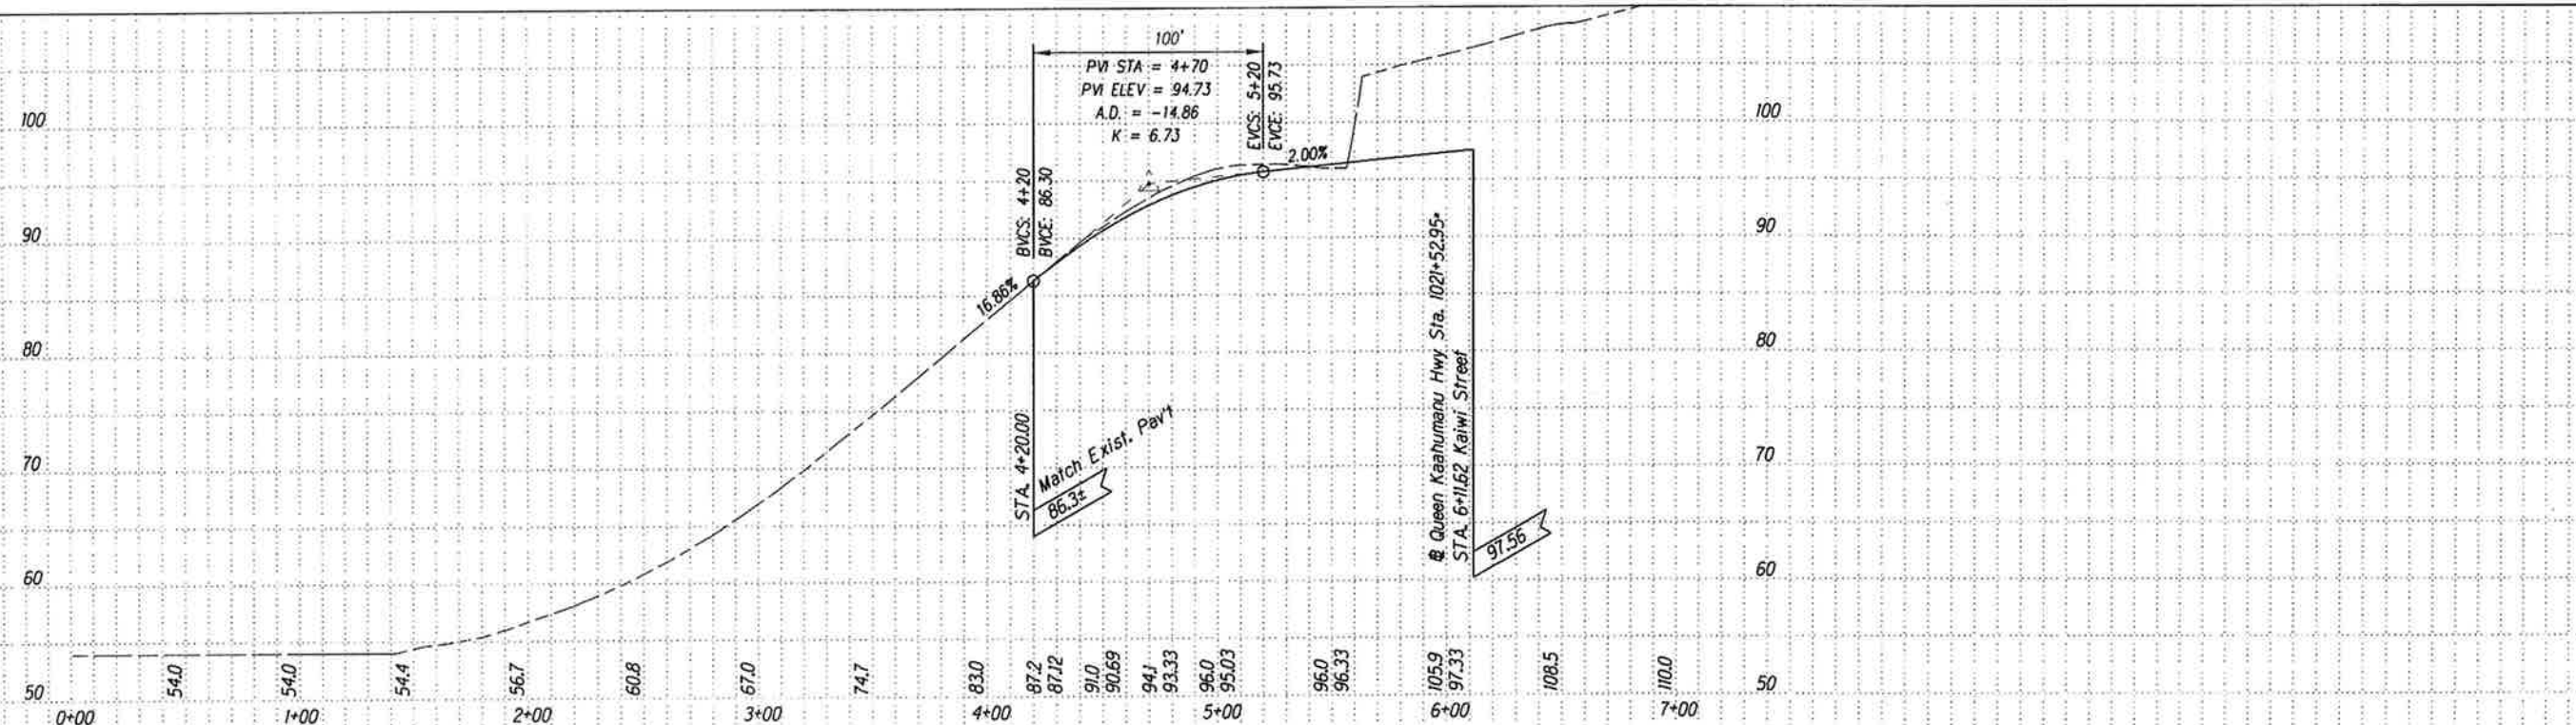


KAIWI STREET

Scale: Horiz 1" = 40'
Vert 1" = 8'

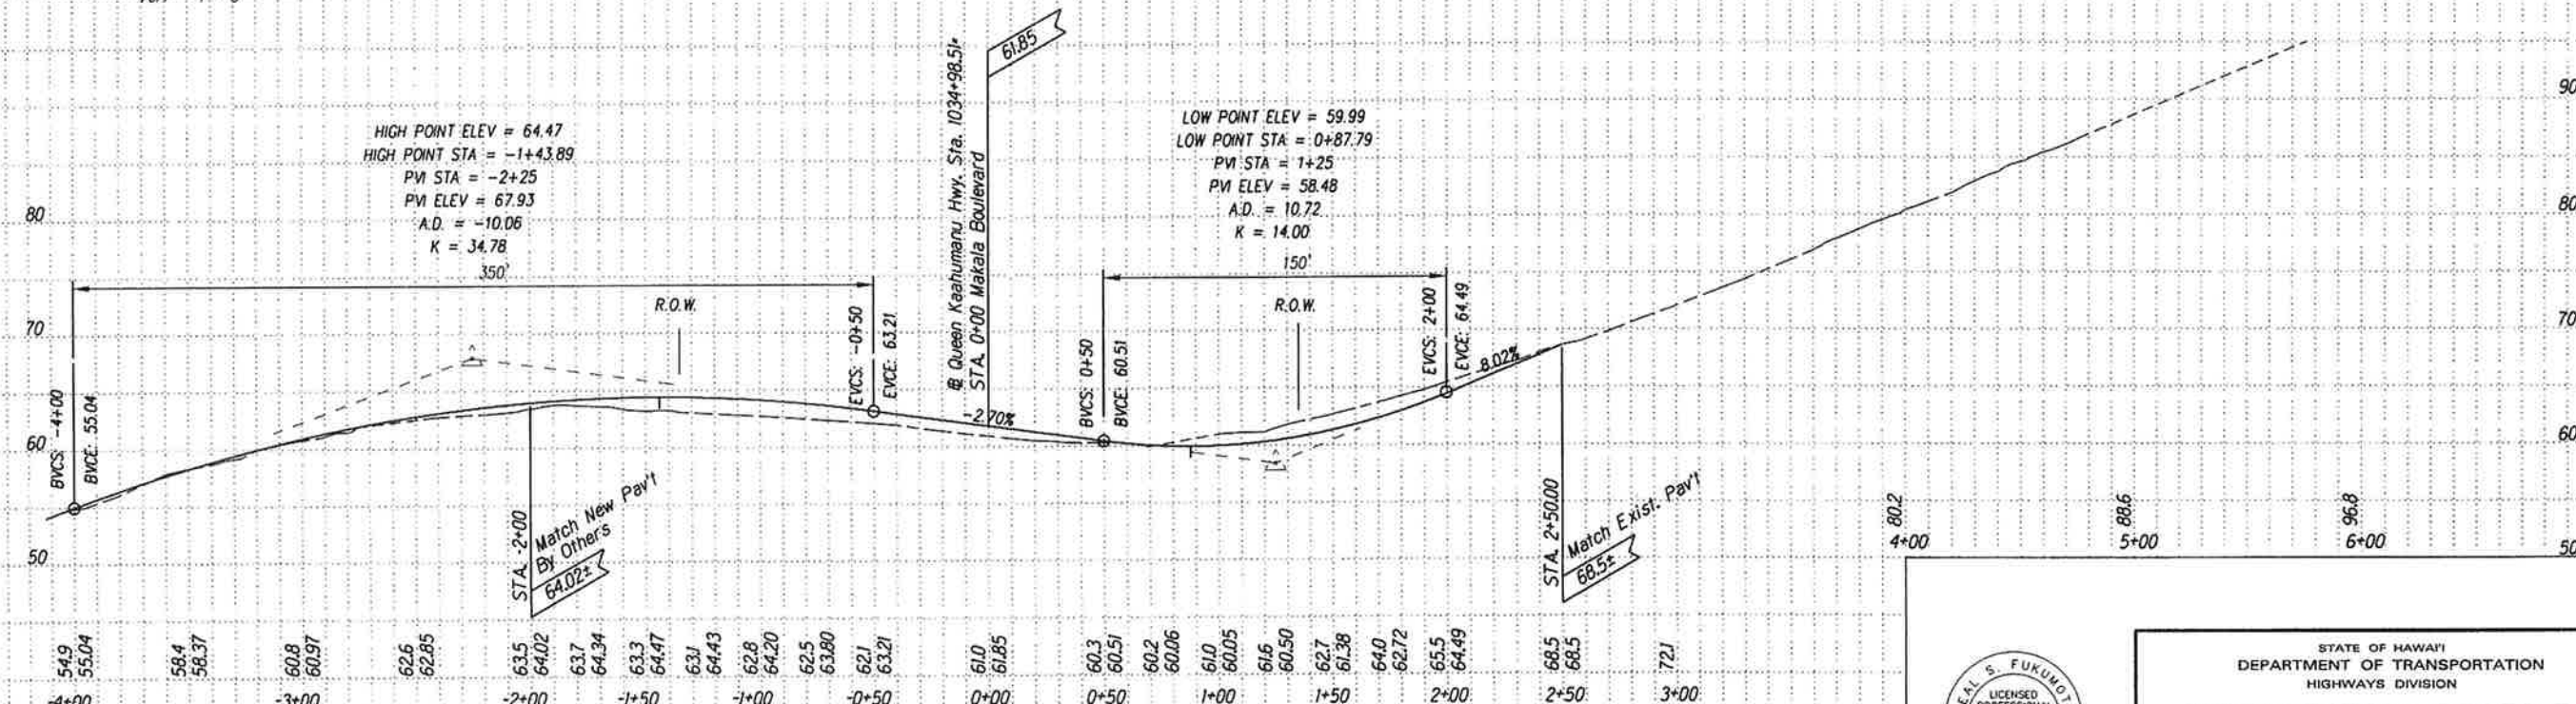

MAKALA BLVD.

Scale: Horiz 1" = 40'
Vert 1" = 8'

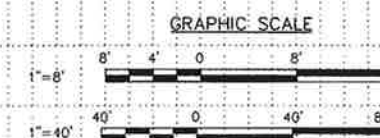


This work was prepared by me
or under my supervision
Exp. 04-30-10
Wesley R. Segawa & Associates, Inc.

STATE OF HAWAII
DEPARTMENT OF TRANSPORTATION
HIGHWAYS DIVISION

INTERSECTION PROFILE

KAIWI STREET, MAKALA BLVD.
QUEEN KAAHUMANU HIGHWAY WIDENING
HENRY ST. to KEALAKEHE PKWY - PHASE I
Federal Aid Project No. NH-019-1(20)
Scale: As Noted Date: November 2009

FED. ROAD DIST. NO.	STATE	FED. AID PROJ. NO.	FISCAL YEAR	SHEET NO.	TOTAL SHEETS
HAWAII	HAW.	NH-019-1(20)	2005	41	315

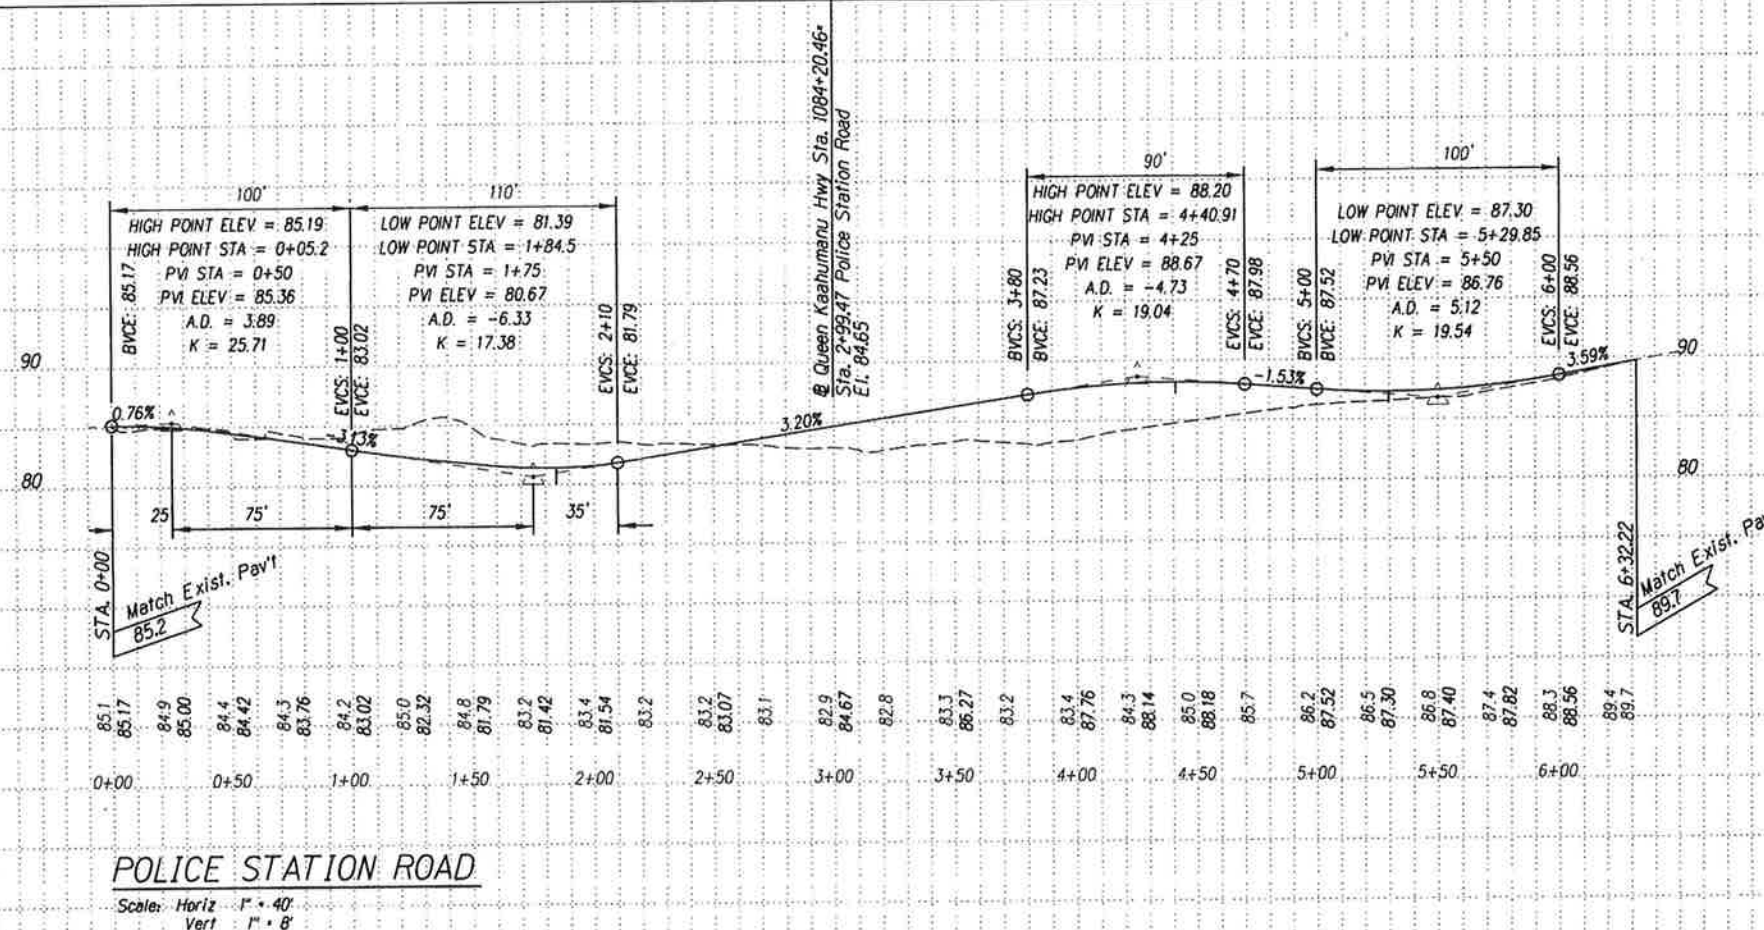


POLICE STATION ROAD

Scale: Horiz 1" = 40'
Vert 1" = 8'

DESIGNED BY	DATE
DRAWN BY	
CHECKED BY	
NOTED BY	
QUANTITIES BY	
CHECKED BY	

GRAPHIC SCALE

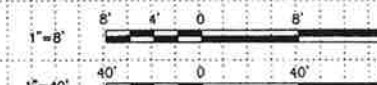

This work was prepared by me or under my supervision.
Exp. 04-30-10
Wesley R. Segawa & Associates, Inc.

STATE OF HAWAII
DEPARTMENT OF TRANSPORTATION
HIGHWAYS DIVISION

INTERSECTION PROFILE
POLICE STATION ROAD
QUEEN KAAHUMANU HIGHWAY WIDENING
HENRY ST. to KEALAKEHE PKWY - PHASE I
Federal Aid Project No. NH-019-1(20)

Scale: As Noted Date: November 2009

SHEET No. 3 OF 3 SHEETS

AS-BUILT

41