



FED. ROAD DIST. NO.	STATE	FED. AID PROJ. NO.	FISCAL YEAR	SHEET NO.	TOTAL SHEETS
HAWAII	HAW.	NH-019-1(20)	2005	115	315

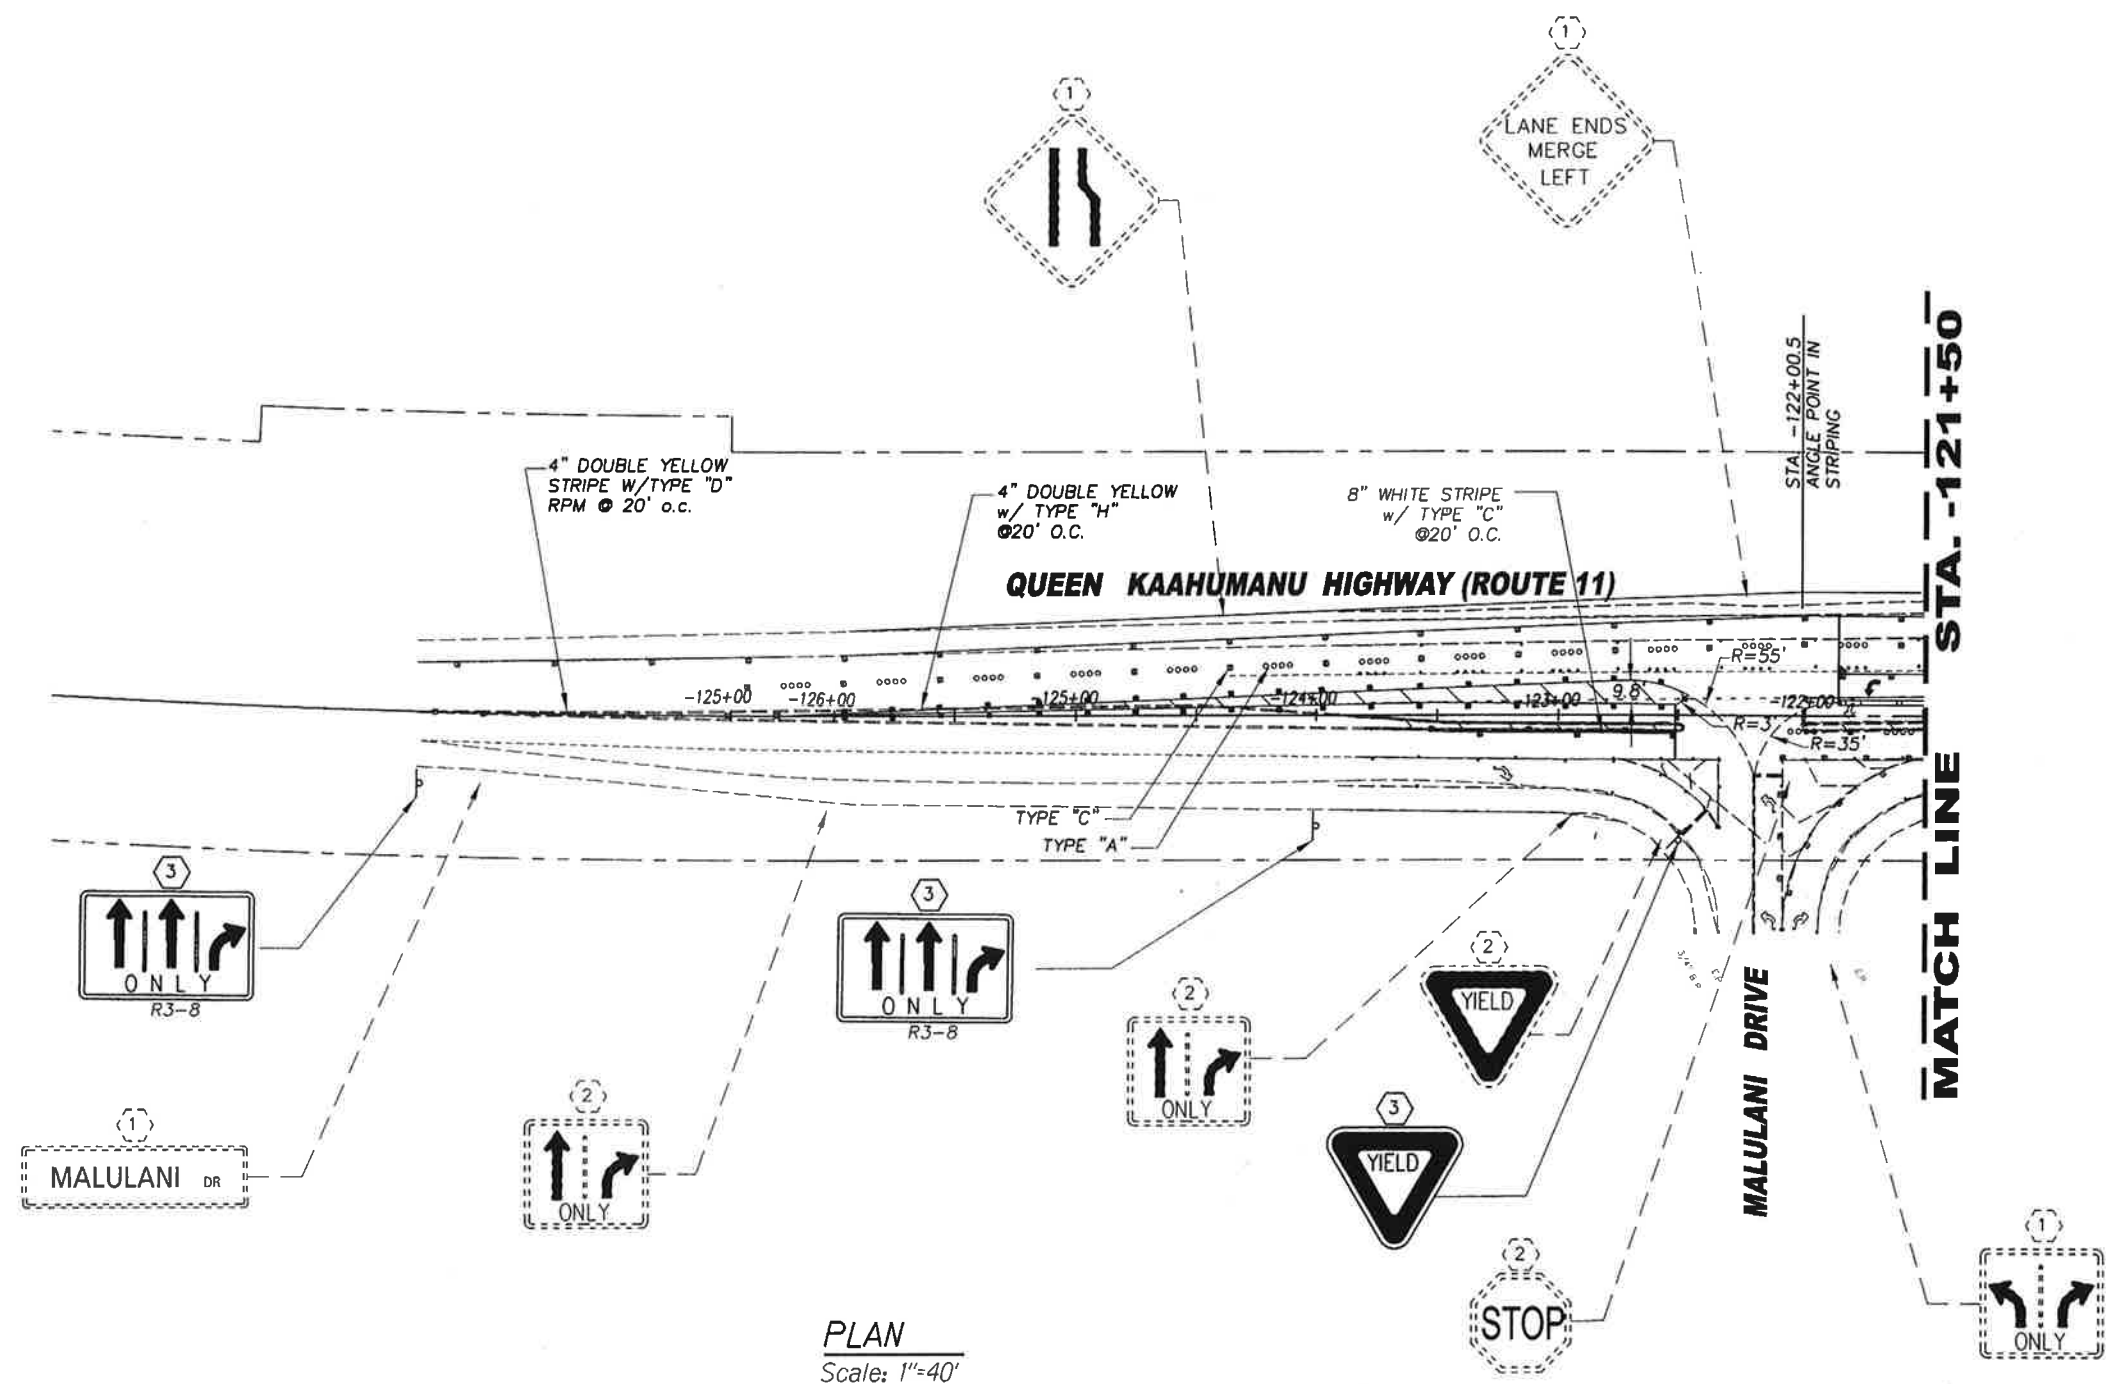

SURVEY PLOTTED BY	DATE
DESIGNED BY	
TRACED BY	
NOTE BOOK	
QUANTITIES BY	
CHECKED BY	

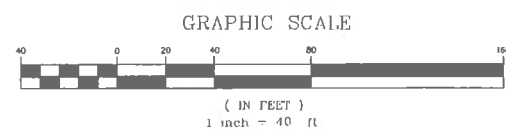

PLAN
Scale: 1"=40'



This work was prepared by me or under my supervision.
Exp. 04-30-10
Neal S. Fukumoto
Wesley R. Segawa & Associates, Inc.


STATE OF HAWAII
DEPARTMENT OF TRANSPORTATION
HIGHWAYS DIVISION
STRIPING PLAN
STA. -126+30 TO STA. -121+50
QUEEN KAAHUMANU HIGHWAY WIDENING
HENRY ST. to KEALAKEHE PKWY - PHASE I
Federal Aid Project No. NH-019-1(20)
Scale: 1" = 40' Date: November 2009
SHEET No. 1 OF 15 SHEETS

AS-BUILT


FED. ROAD DIST. NO.	STATE	FED. AID PROJ. NO.	FISCAL YEAR	SHEET NO.	TOTAL SHEETS
HAWAII	HAW.	NH-019-1(20)	2005	116	315

MATCH LINE STA. -121+50

MATCH LINE STA. -110+00

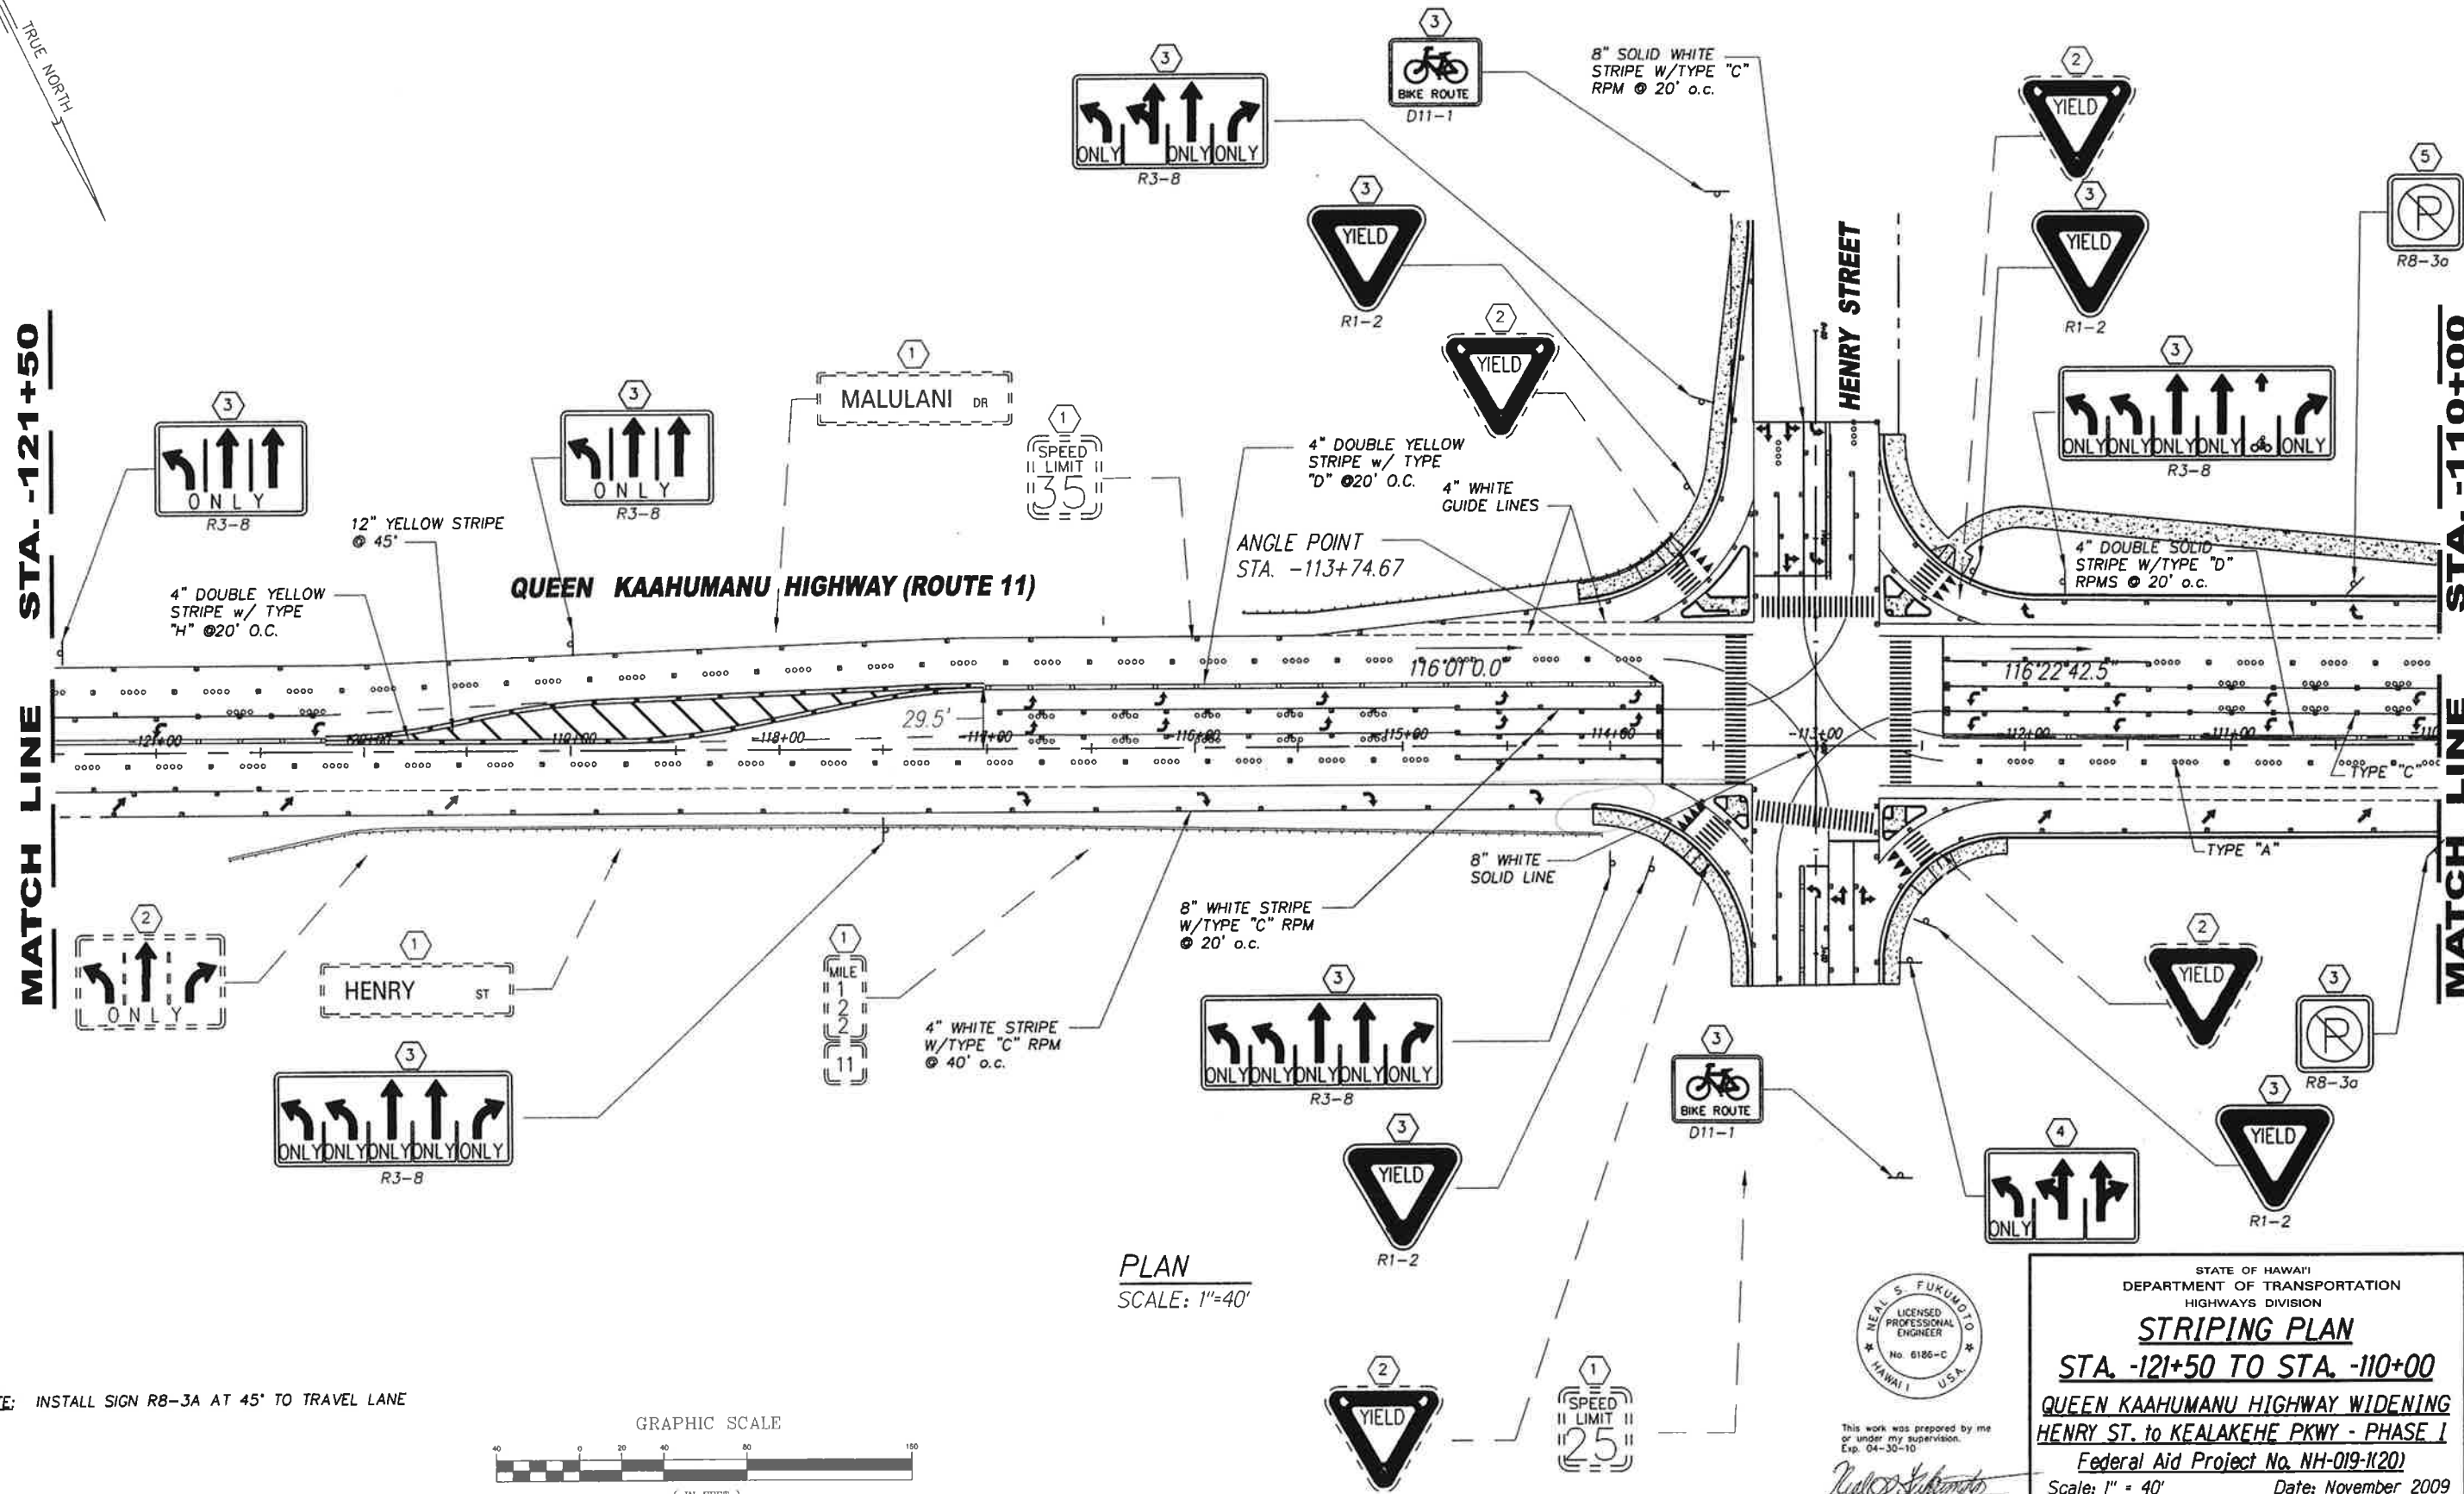

PLAN
SCALE: 1"=40'

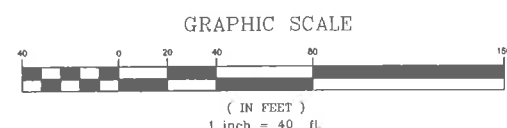

NOTE: INSTALL SIGN R8-3A AT 45' TO TRAVEL LANE

NEALS S. FUKUOKA
LICENSED PROFESSIONAL ENGINEER
No. 6186-C
HAWAII U.S.A.

This work was prepared by me or under my supervision.
Exp. 04-30-10

Wesley H. Segawa & Associates, Inc.

STATE OF HAWAII
DEPARTMENT OF TRANSPORTATION
HIGHWAYS DIVISION


STRIPING PLAN
STA. -121+50 TO STA. -110+00
QUEEN KAAHUMANU HIGHWAY WIDENING
HENRY ST. to KEALAKEHE PKWY - PHASE I
Federal Aid Project No. NH-019-1(20)
Scale: 1" = 40' Date: November 2009

AS-BUILT


116

DATE	_____
SURVEY PLOTTED BY	_____
DESIGNED BY	_____
TRACED BY	_____
NOTE BOOK	_____
QUANTITIES BY	_____
CHECKED BY	_____
N.	_____

FED. ROAD DIST. NO.	STATE	FED. AID PROJ. NO.	FISCAL YEAR	SHEET NO.	TOTAL SHEETS
HAWAII	HAW.	NH-019-1(20)	2005	117	315

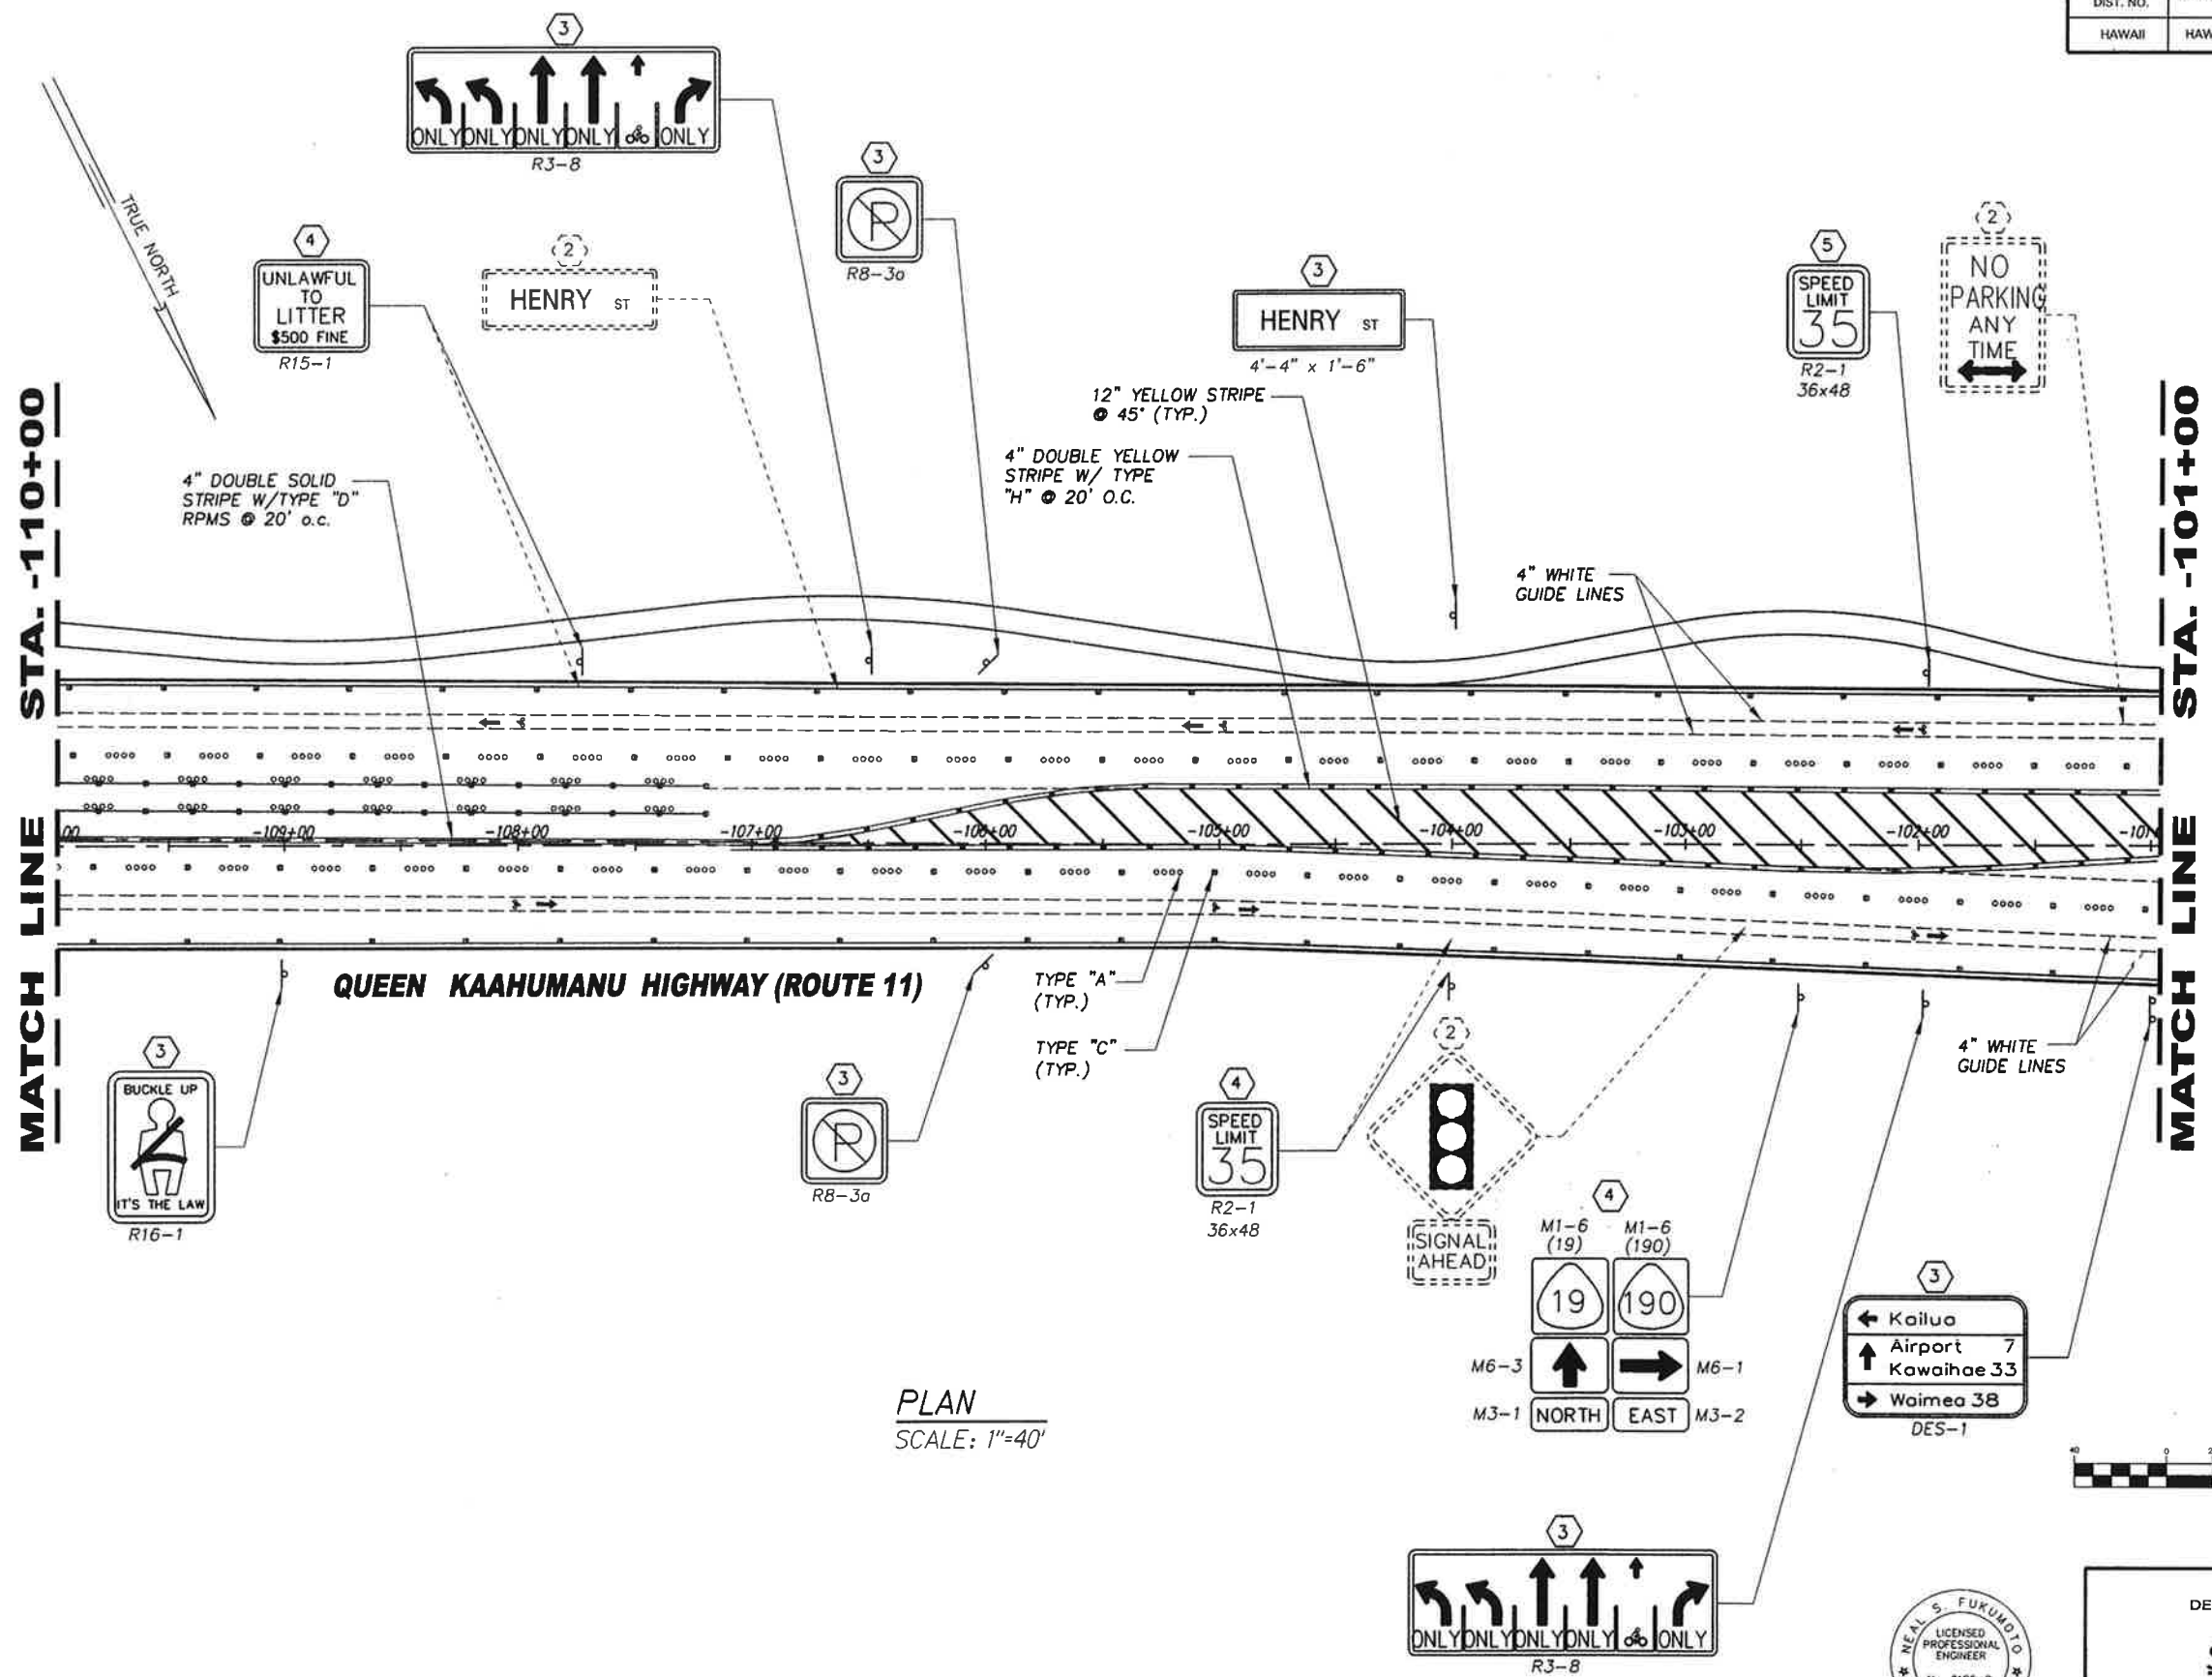

PLAN
SCALE: 1"=40'

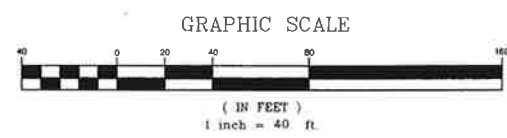

NOTE: INSTALL SIGN R8-3A AT 45' TO TRAVEL LANE

SURVEY PLOTTED BY	DATE
DRAWN BY	
DESIGNED BY	
CHECKED BY	
ORIGINAL PLAN	
NOTE BOOK	
N.	

NEAL S. FUKUNAGA
LICENSED PROFESSIONAL ENGINEER
No. 6185-C
HAWAII, U.S.A.

This work was prepared by me or under my supervision.
Exp. 04-30-10


Neal S. Fukunaga
Weasley & Segawa & Associates, Inc.

STATE OF HAWAII
DEPARTMENT OF TRANSPORTATION
HIGHWAYS DIVISION

STRIPING PLAN
STA. -110+00 TO STA. -101+00
QUEEN KAAHUMANU HIGHWAY WIDENING
HENRY ST. to KEALAKEHE PKWY - PHASE I
Federal Aid Project No. NH-019-1(20)
Scale: 1" = 40' Date: November 2009

AS-BUILT

FED. ROAD DIST. NO.	STATE	FED. AID PROJ. NO.	FISCAL YEAR	SHEET NO.	TOTAL SHEETS
HAWAII	HAW.	NH-019-1(20)	2005	118	315

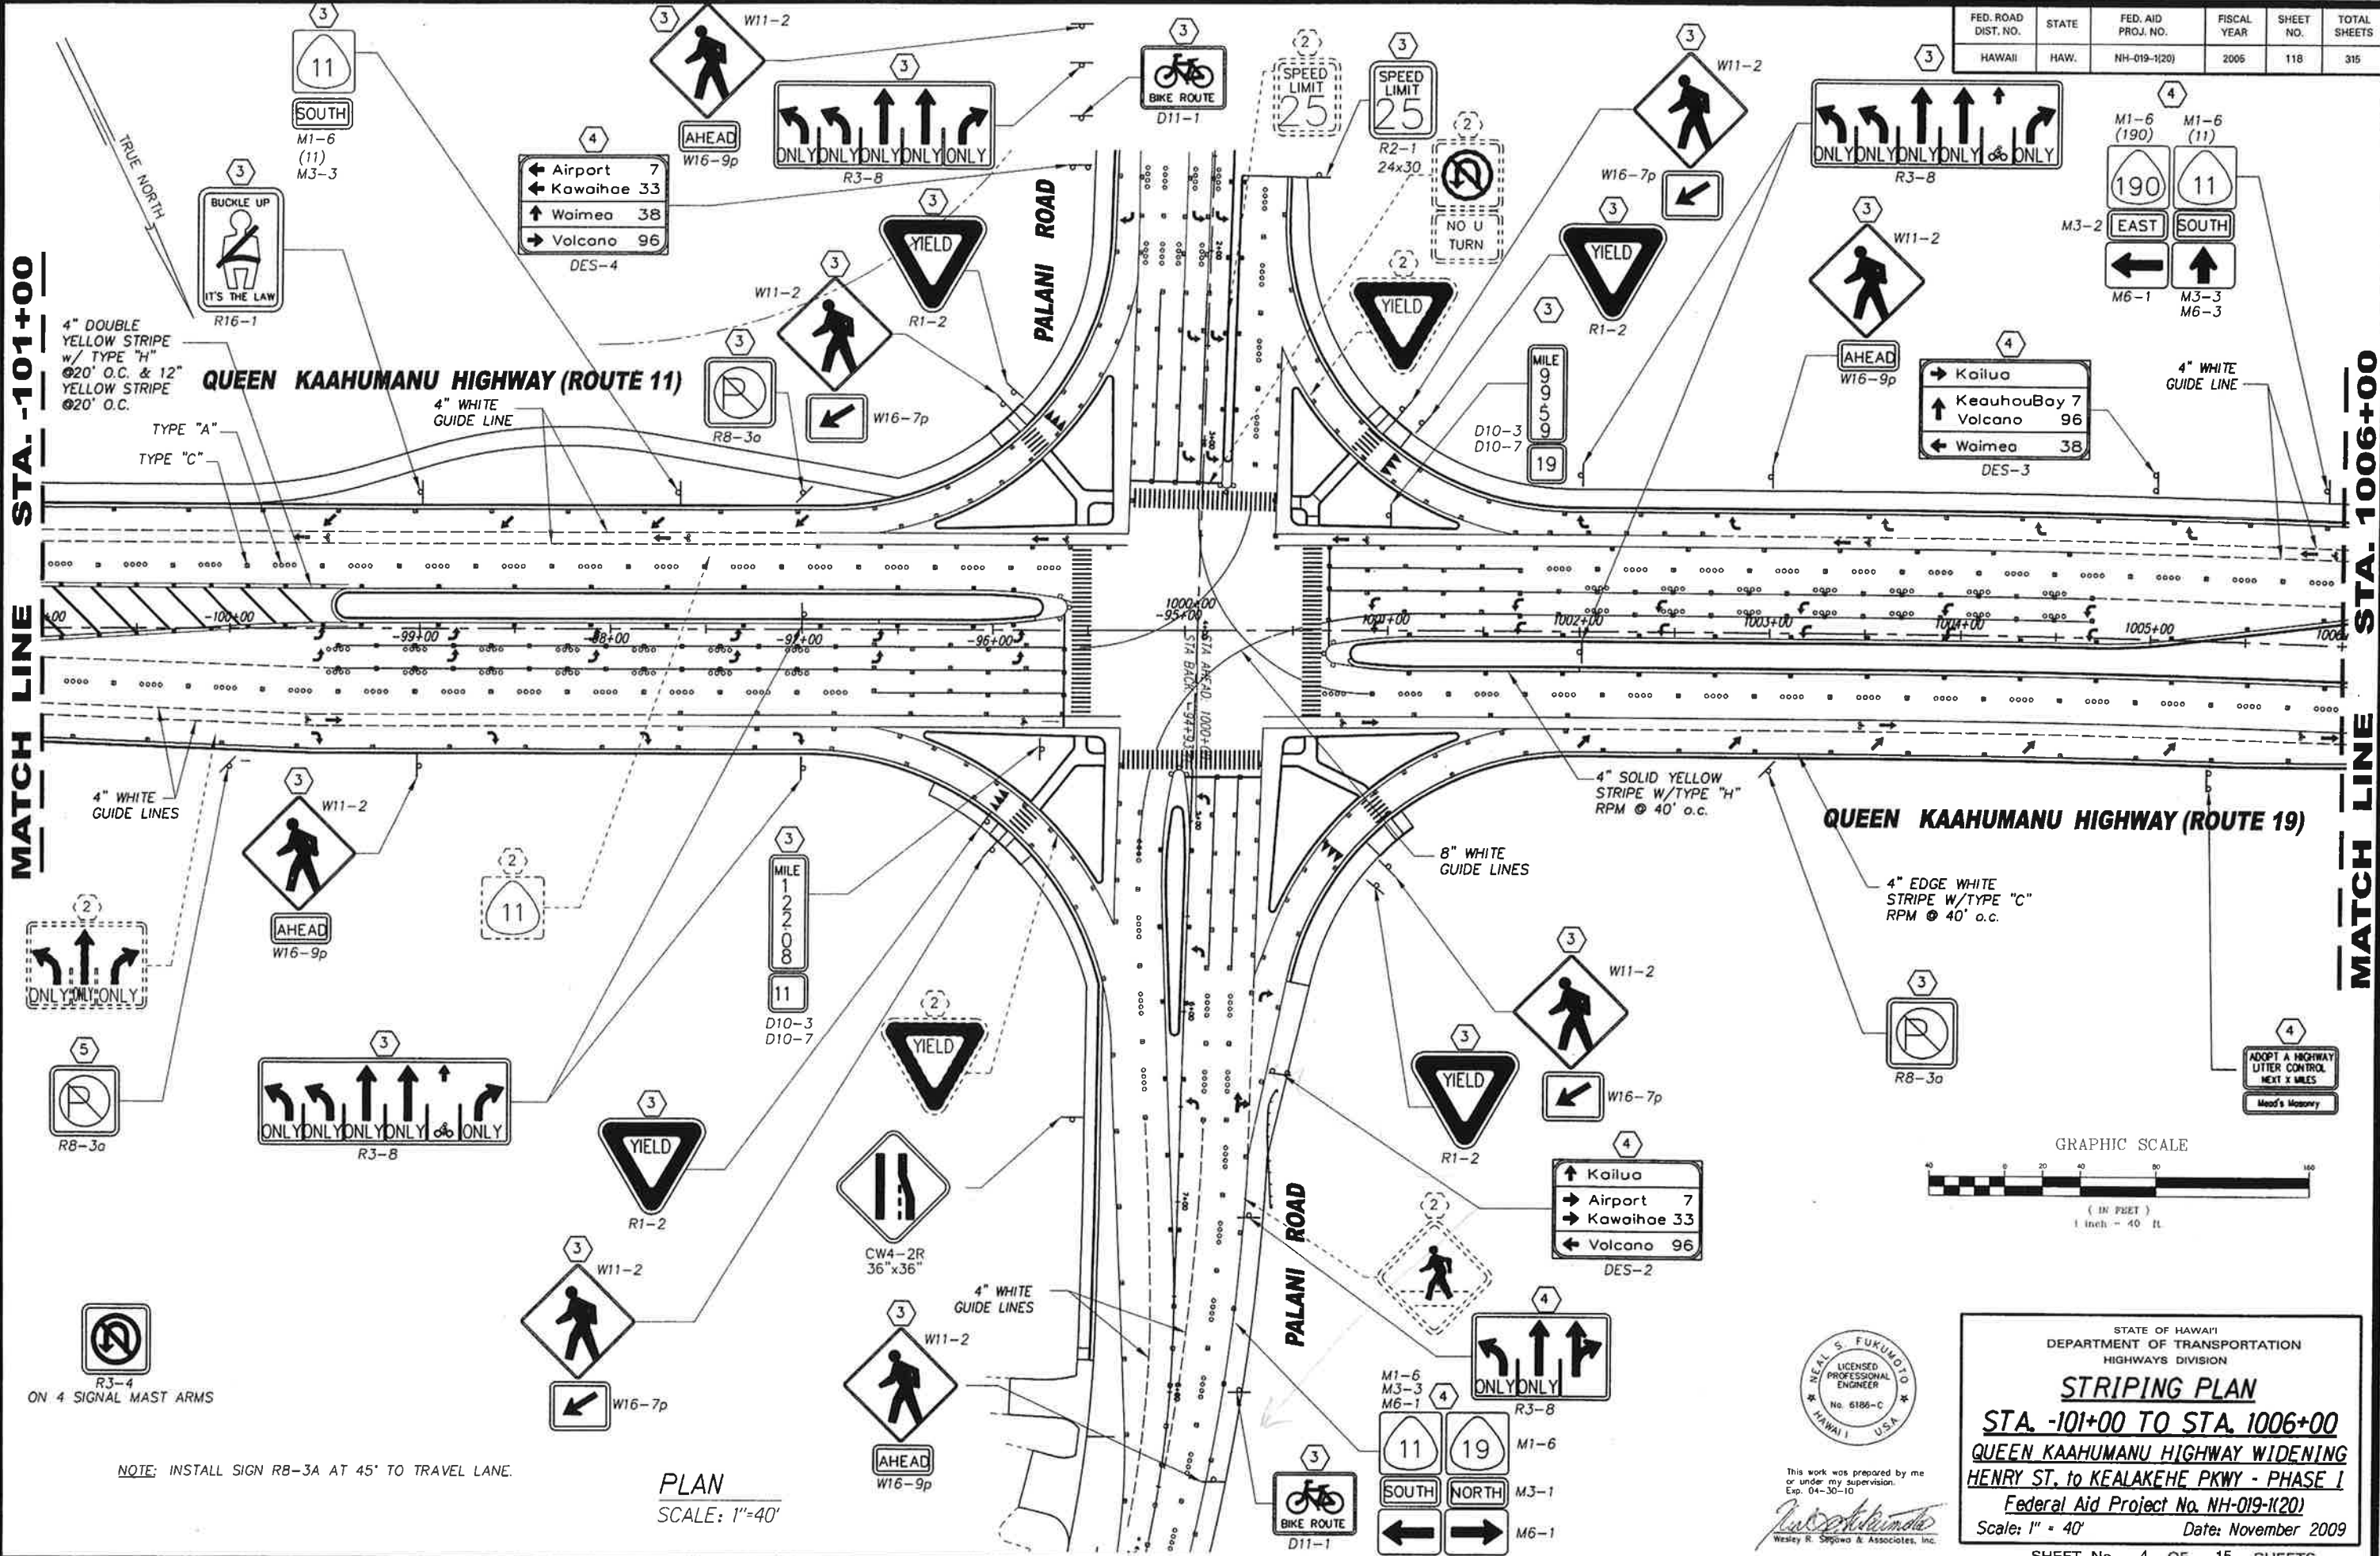


DESIGNED BY	DATE
DRAWN BY	
CHECKED BY	
NOTED BY	
APPROVED BY	

R3-4
ON 4 SIGNAL MAST ARMS

NOTE: INSTALL SIGN R8-3A AT 45' TO TRAVEL LANE.

PLAN
SCALE: 1"=40'

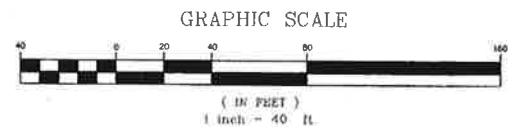

This work was prepared by me or under my supervision.
Exp. 04-30-10
Wesley R. Sogawa & Associates, Inc.



STATE OF HAWAII
DEPARTMENT OF TRANSPORTATION
HIGHWAYS DIVISION

STRIPING PLAN
STA. -101+00 TO STA. 1006+00
QUEEN KAAHUMANU HIGHWAY WIDENING
HENRY ST. to KEALAKEHE PKWY - PHASE I
Federal Aid Project No. NH-019-1(20)
Scale: 1" = 40' Date: November 2009

SHEET No. 4 OF 15 SHEETS

AS-BUILT

FED. ROAD DIST. NO.	STATE	FED. AID PROJ. NO.	FISCAL YEAR	SHEET NO.	TOTAL SHEETS
HAWAII	HAW.	NH-019-1(20)	2005	119	315

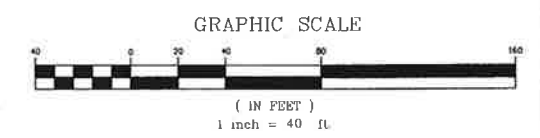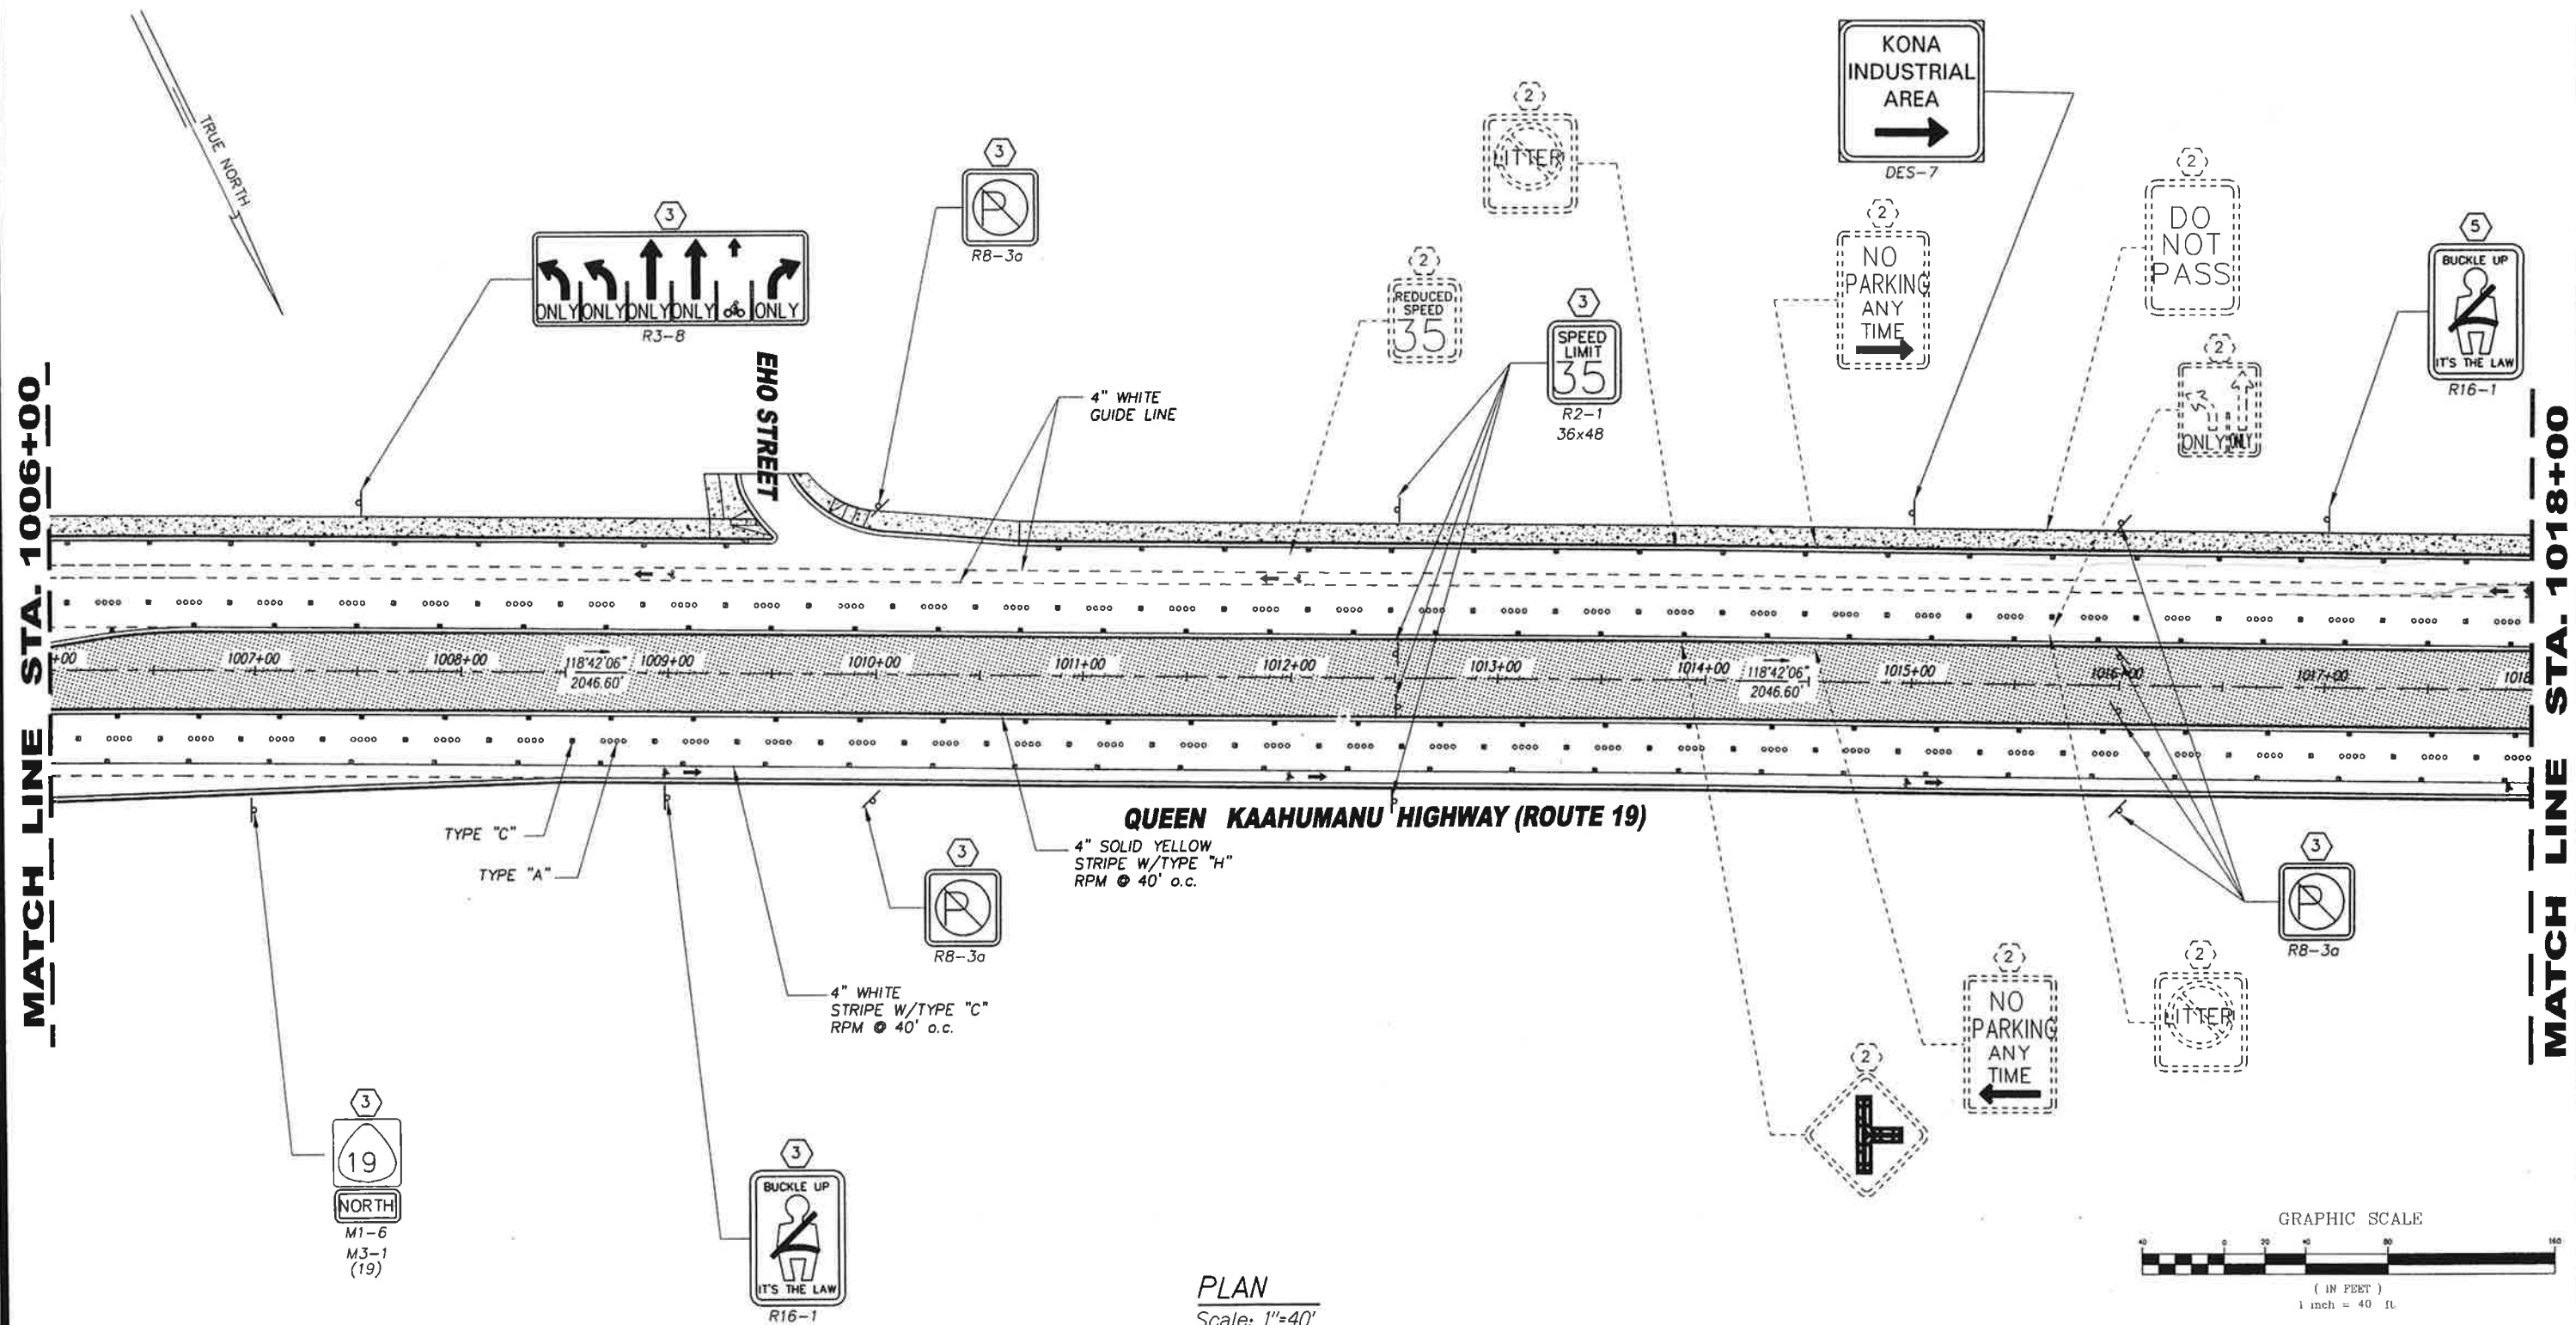

STATE OF HAWAII
DEPARTMENT OF TRANSPORTATION
HIGHWAYS DIVISION

STRIPING PLAN
STA. 1006+00 to STA. 1018+00
QUEEN KAAHUMANU HIGHWAY WIDENING
HENRY ST. to KEALAKEHE PKWY - PHASE I
Federal Aid Project No. NH-019-1(20)
Scale: 1" = 40' Date: November 2009

NEIL S. FUKUNAGA
LICENSED PROFESSIONAL ENGINEER
No. 6186-C
HAWAII, U.S.A.


This work was prepared by me
or under my supervision.
Exp. 04-30-10
Wesley R. Segawa & Associates, Inc.

SURVEY PLOTTED BY	DATE
DRAWN BY	
DESIGNED BY	
NOTE BOOK	
QUANTITIES BY	
CHECKED BY	
N.	

NOTE: INSTALL SIGN R8-3A AT 45' TO TRAVEL LANE

PLAN
Scale: 1"=40'


FED. ROAD DIST. NO.	STATE	FED. AID PROJ. NO.	FISCAL YEAR	SHEET NO.	TOTAL SHEETS
HAWAII	HAW.	NH-019-1(20)	2005	120	315

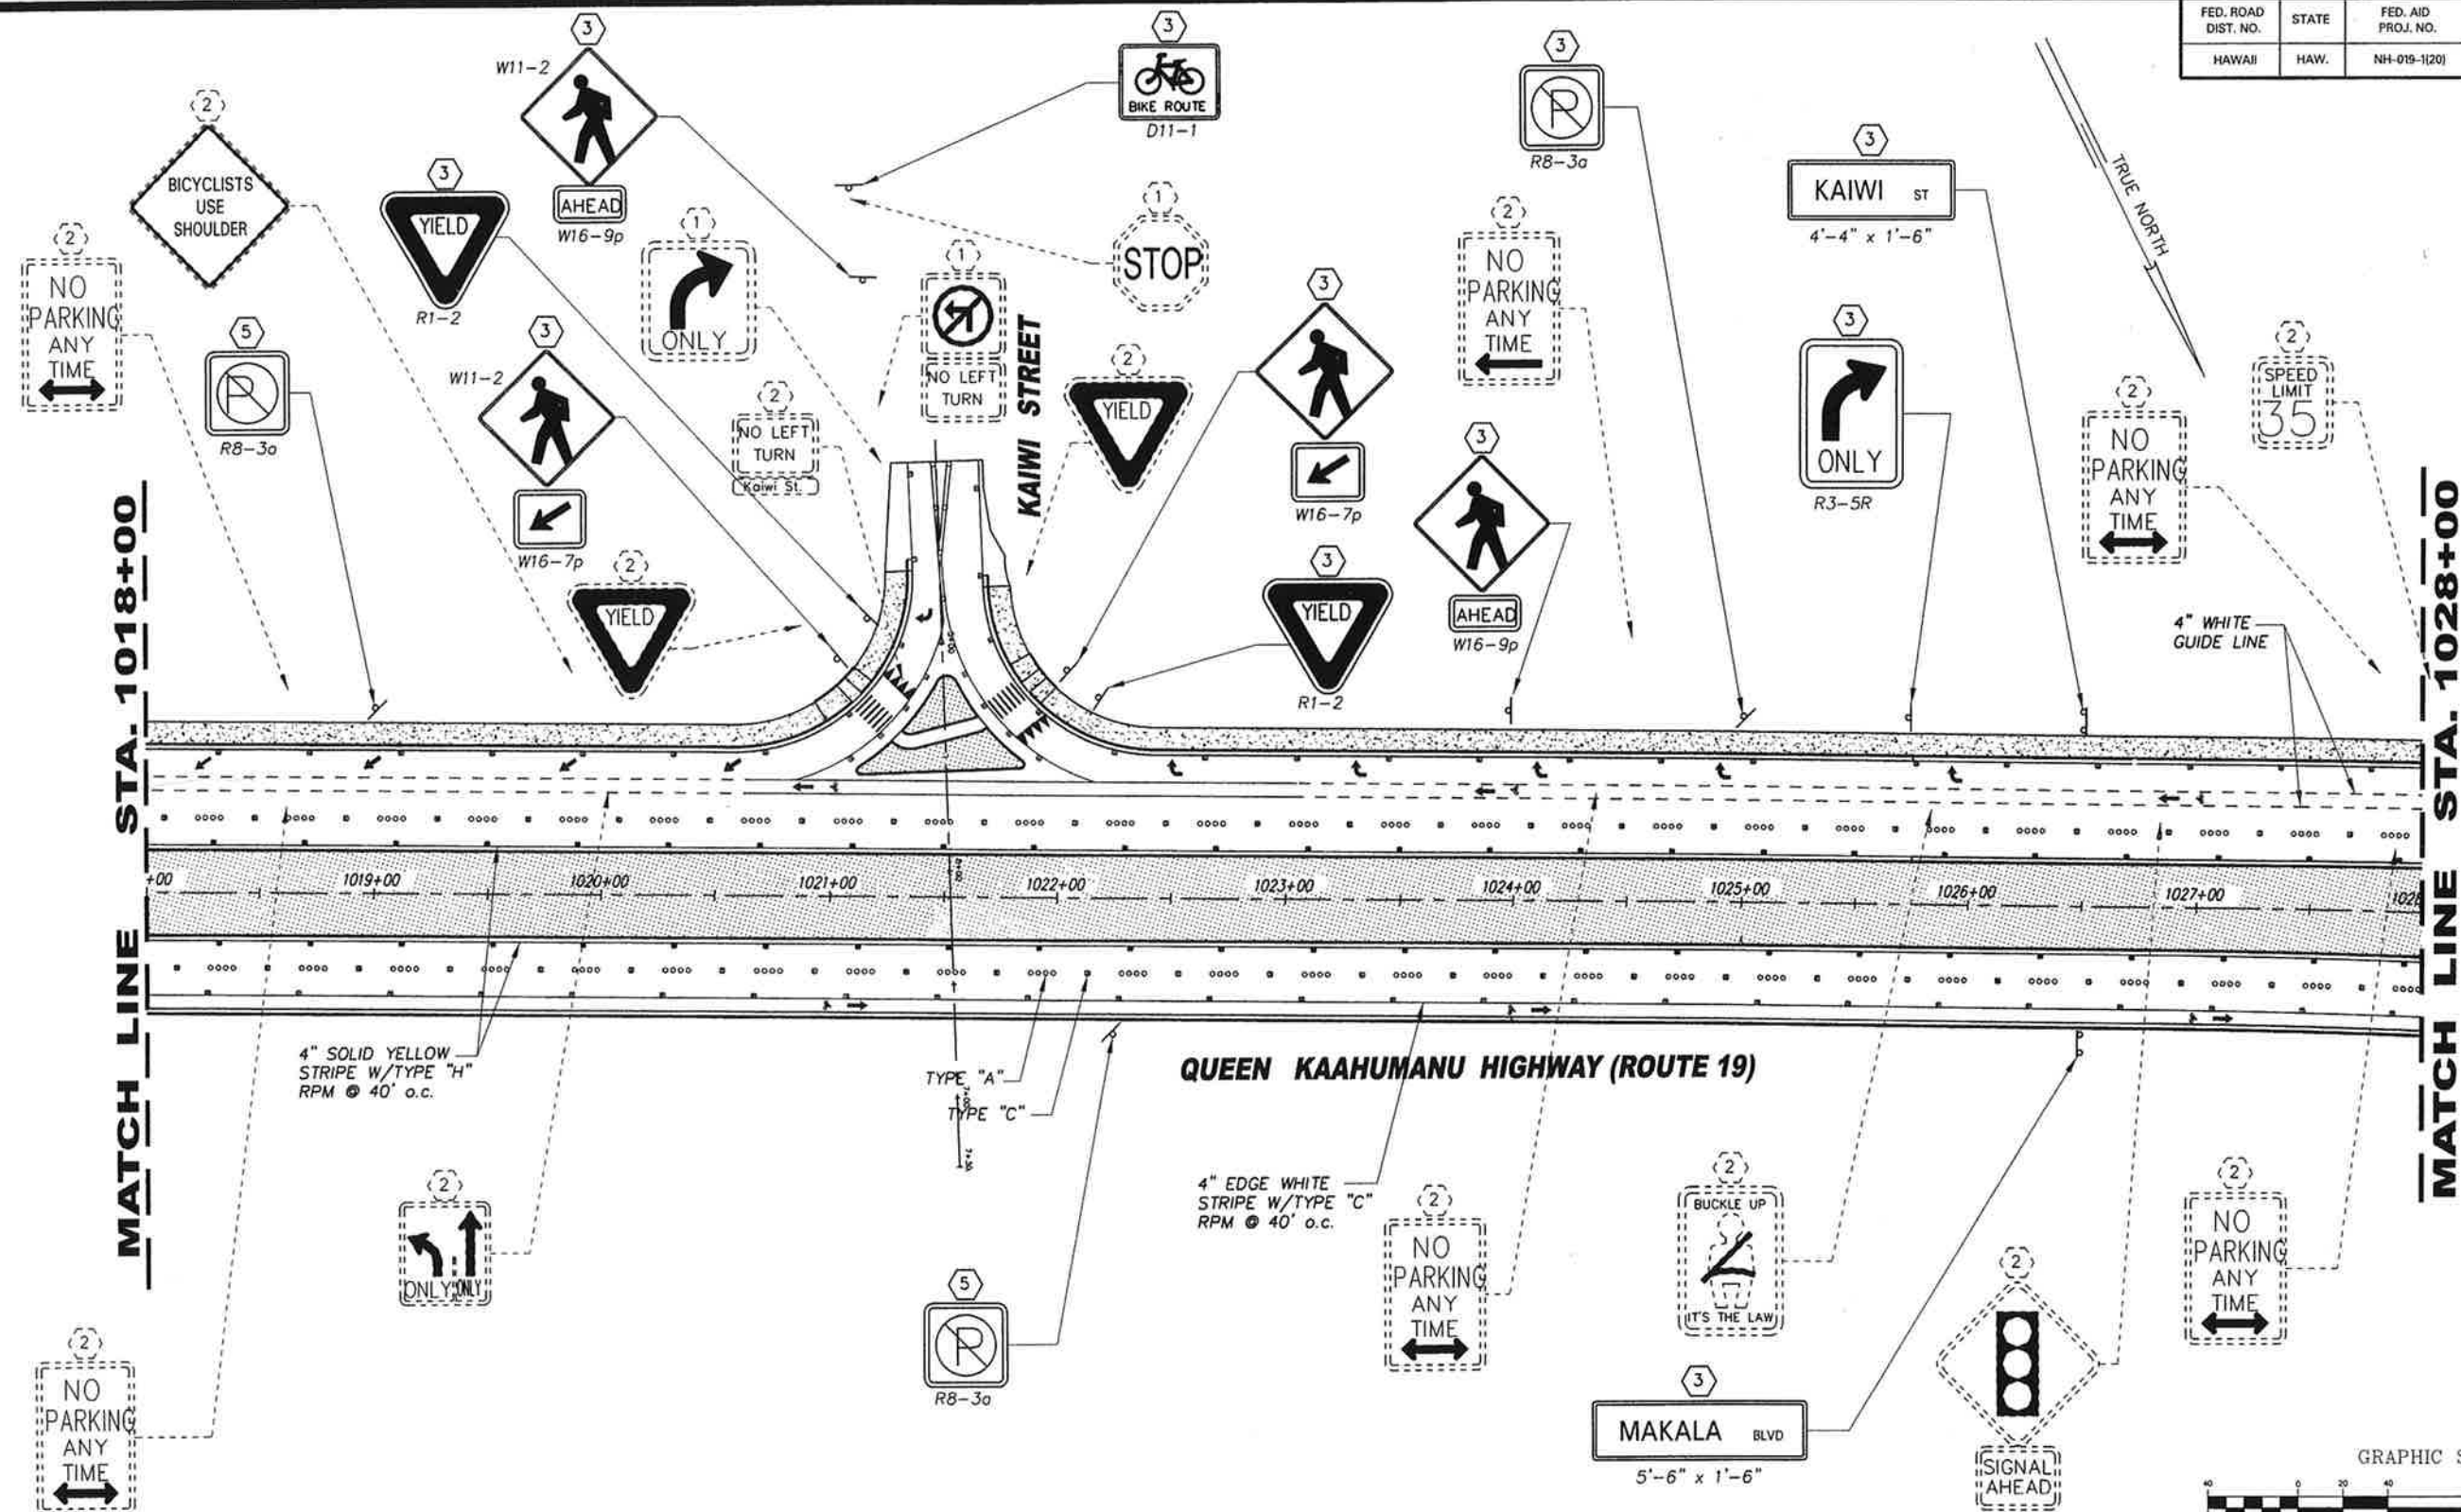

QUEEN KAAHUMANU HIGHWAY (ROUTE 19)

PLAN
Scale: 1"=40'

NOTE: INSTALL SIGN R8-3A AT 45' TO TRAVEL LANE

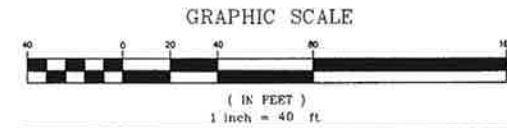

This work was prepared by me or under my supervision.
Exp. 04-30-10
Neal S. Fukunaga
Wesley R. Sogawa & Associates, Inc.


STATE OF HAWAII
DEPARTMENT OF TRANSPORTATION
HIGHWAYS DIVISION
STRIPING PLAN
STA. 1018+00 TO STA. 1028+00
QUEEN KAAHUMANU HIGHWAY WIDENING
HENRY ST. to KEALAKEHE PKWY - PHASE I
Federal Aid Project No. NH-019-1(20)
Scale: 1" = 40' Date: November 2009

SHEET No. 6 OF 15 SHEETS

AS-BUILT


SURVEY PLOTTED BY	DATE
DRAWN BY	
DESIGNED BY	
QUANTITIES BY	
CHECKED BY	
ORIGINAL PLAN	
NOTE BOOK	
No.	

FED. ROAD DIST. NO.	STATE	FED. AID PROJ. NO.	FISCAL YEAR	SHEET NO.	TOTAL SHEETS
HAWAII	HAW.	NH-019-1(20)	2005	121	315

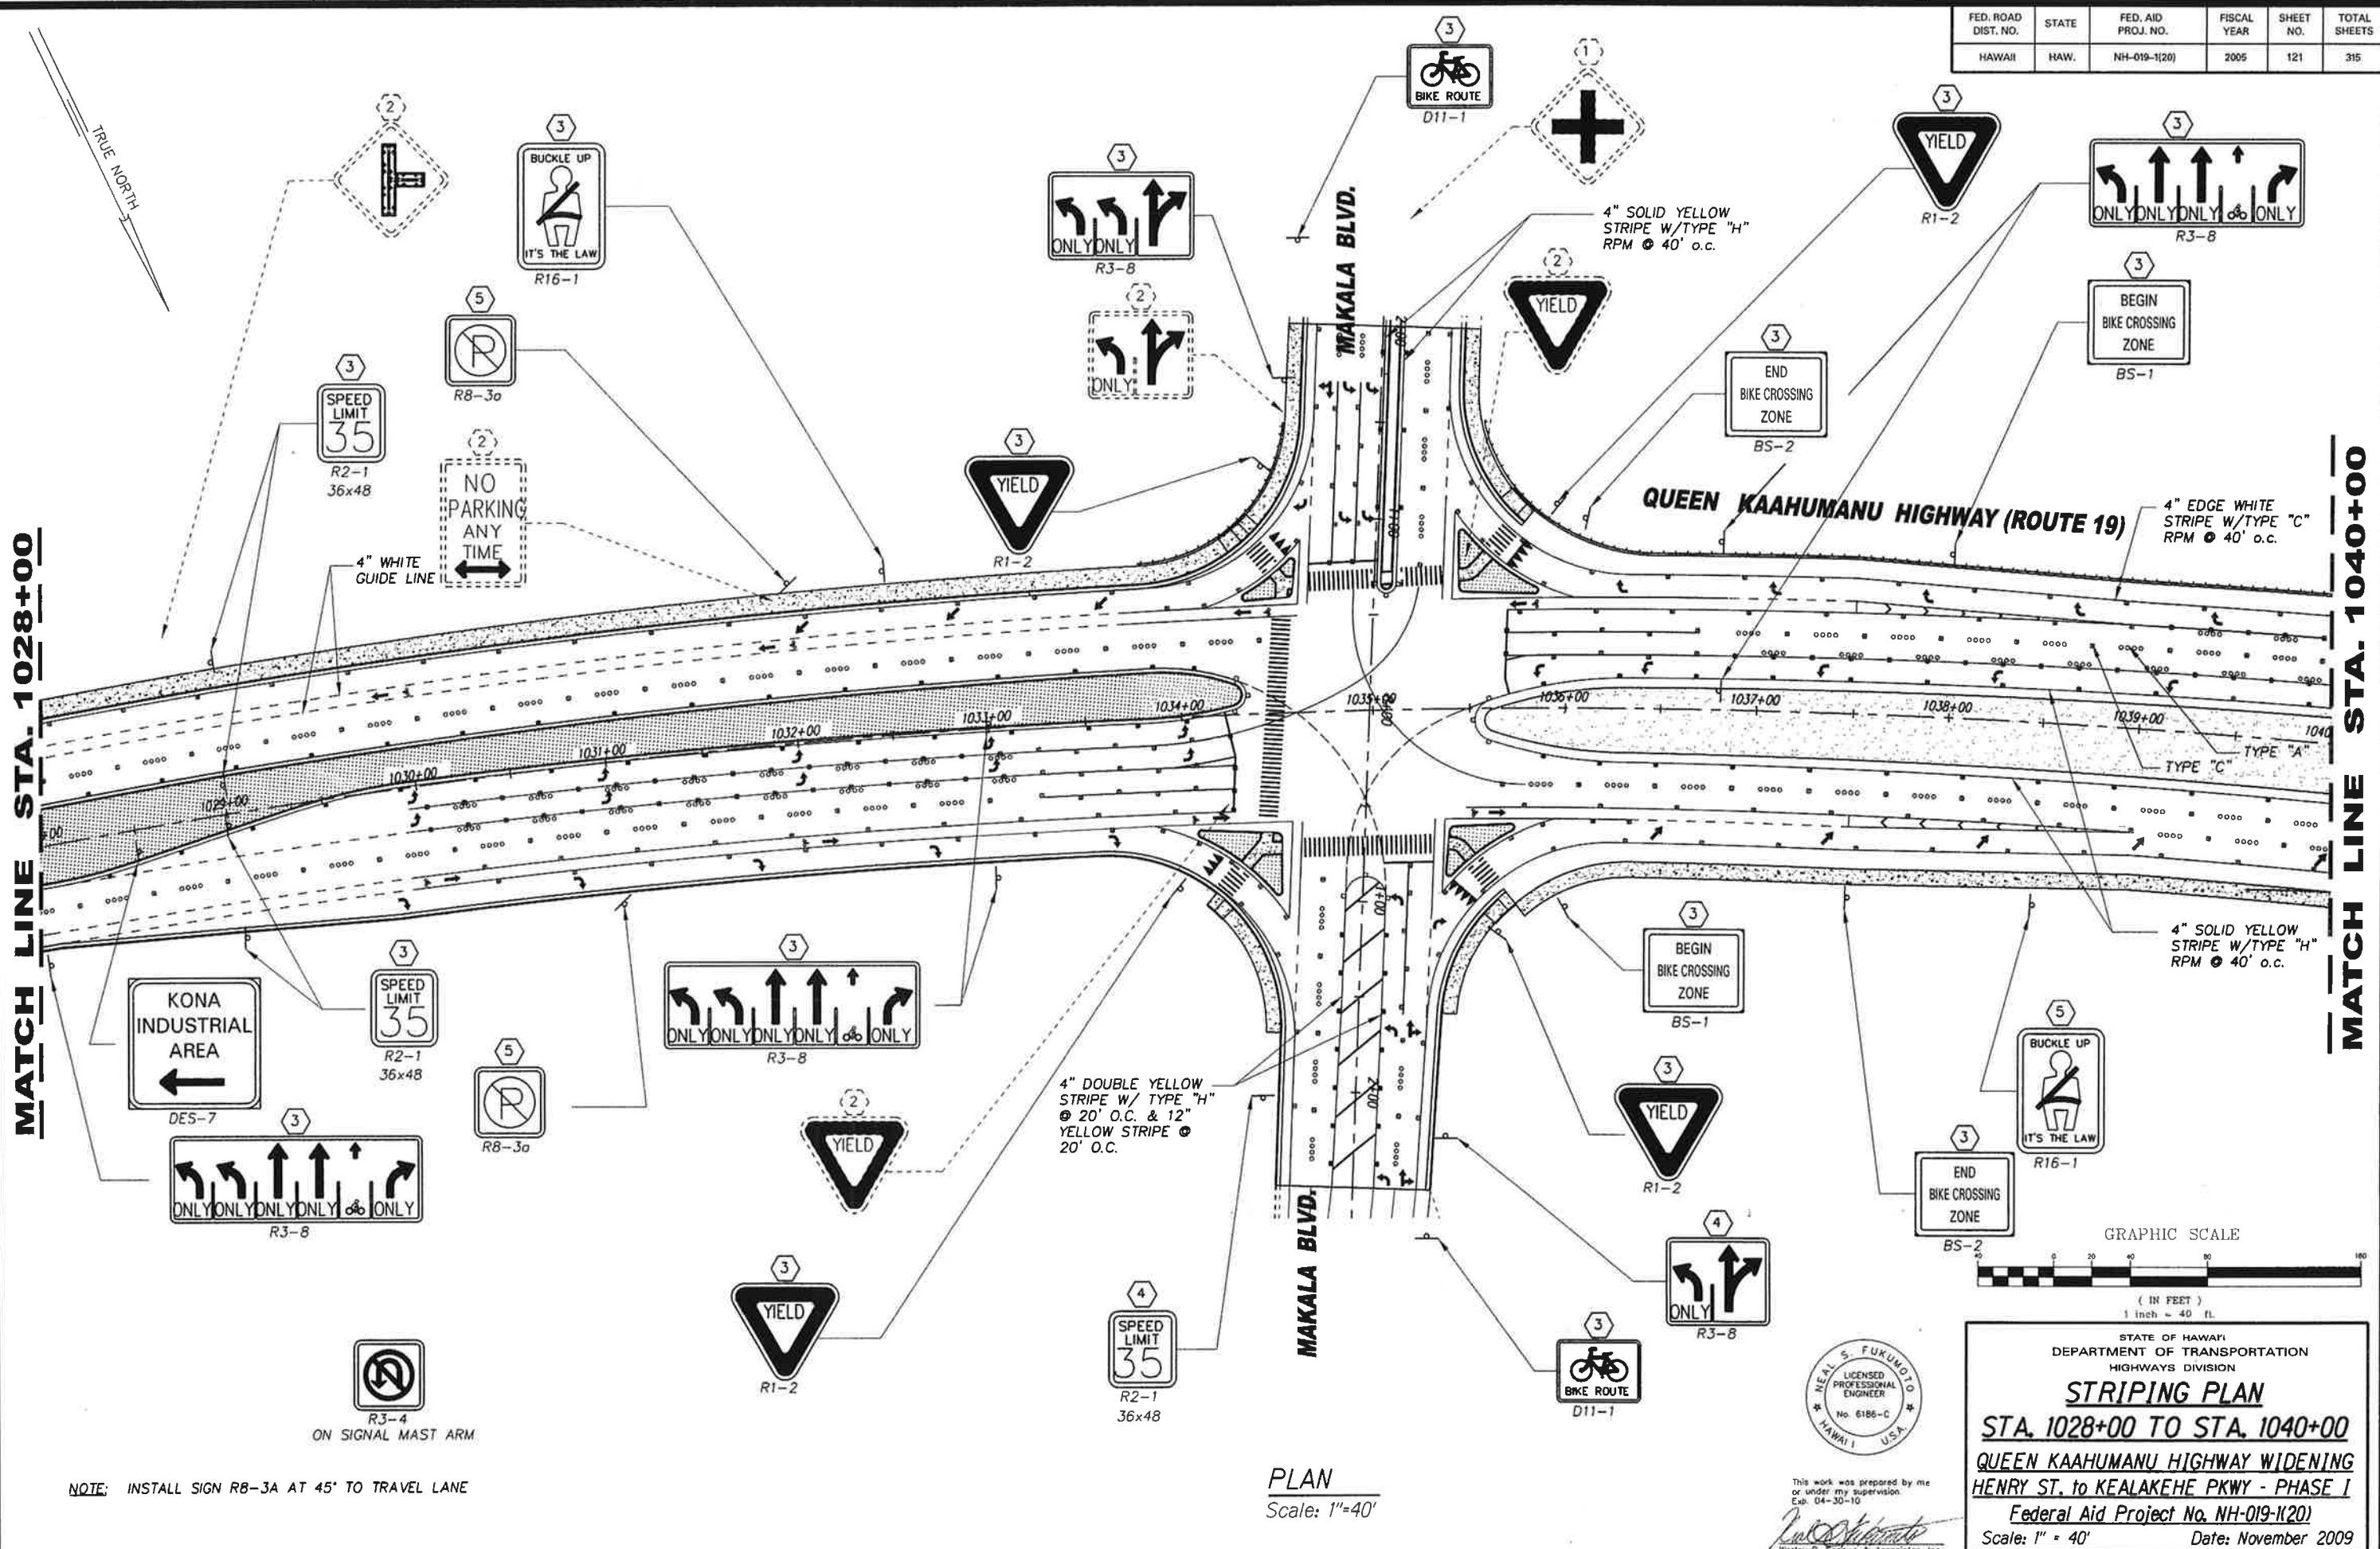

NOTE: INSTALL SIGN RB-3A AT 45' TO TRAVEL LANE

PLAN
Scale: 1"=40'

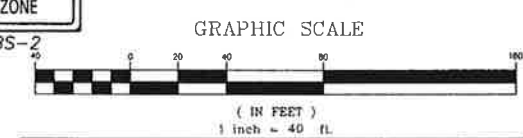


This work was prepared by me or under my supervision.
E.S. 04-30-10
Wesley R. Segawa & Associates, Inc.


STATE OF HAWAII
DEPARTMENT OF TRANSPORTATION
HIGHWAYS DIVISION

STRIPING PLAN
STA. 1028+00 TO STA. 1040+00
QUEEN KAAHUMANU HIGHWAY WIDENING
HENRY ST. to KEALAKEHE PKWY - PHASE I
Federal Aid Project No. NH-019-1(20)
Scale: 1" = 40' Date: November 2009

FED. ROAD DIST. NO.	STATE	FED. AID PROJ. NO.	FISCAL YEAR	SHEET NO.	TOTAL SHEETS
HAWAII	HAW.	NH-019-1(20)	2005	122	315

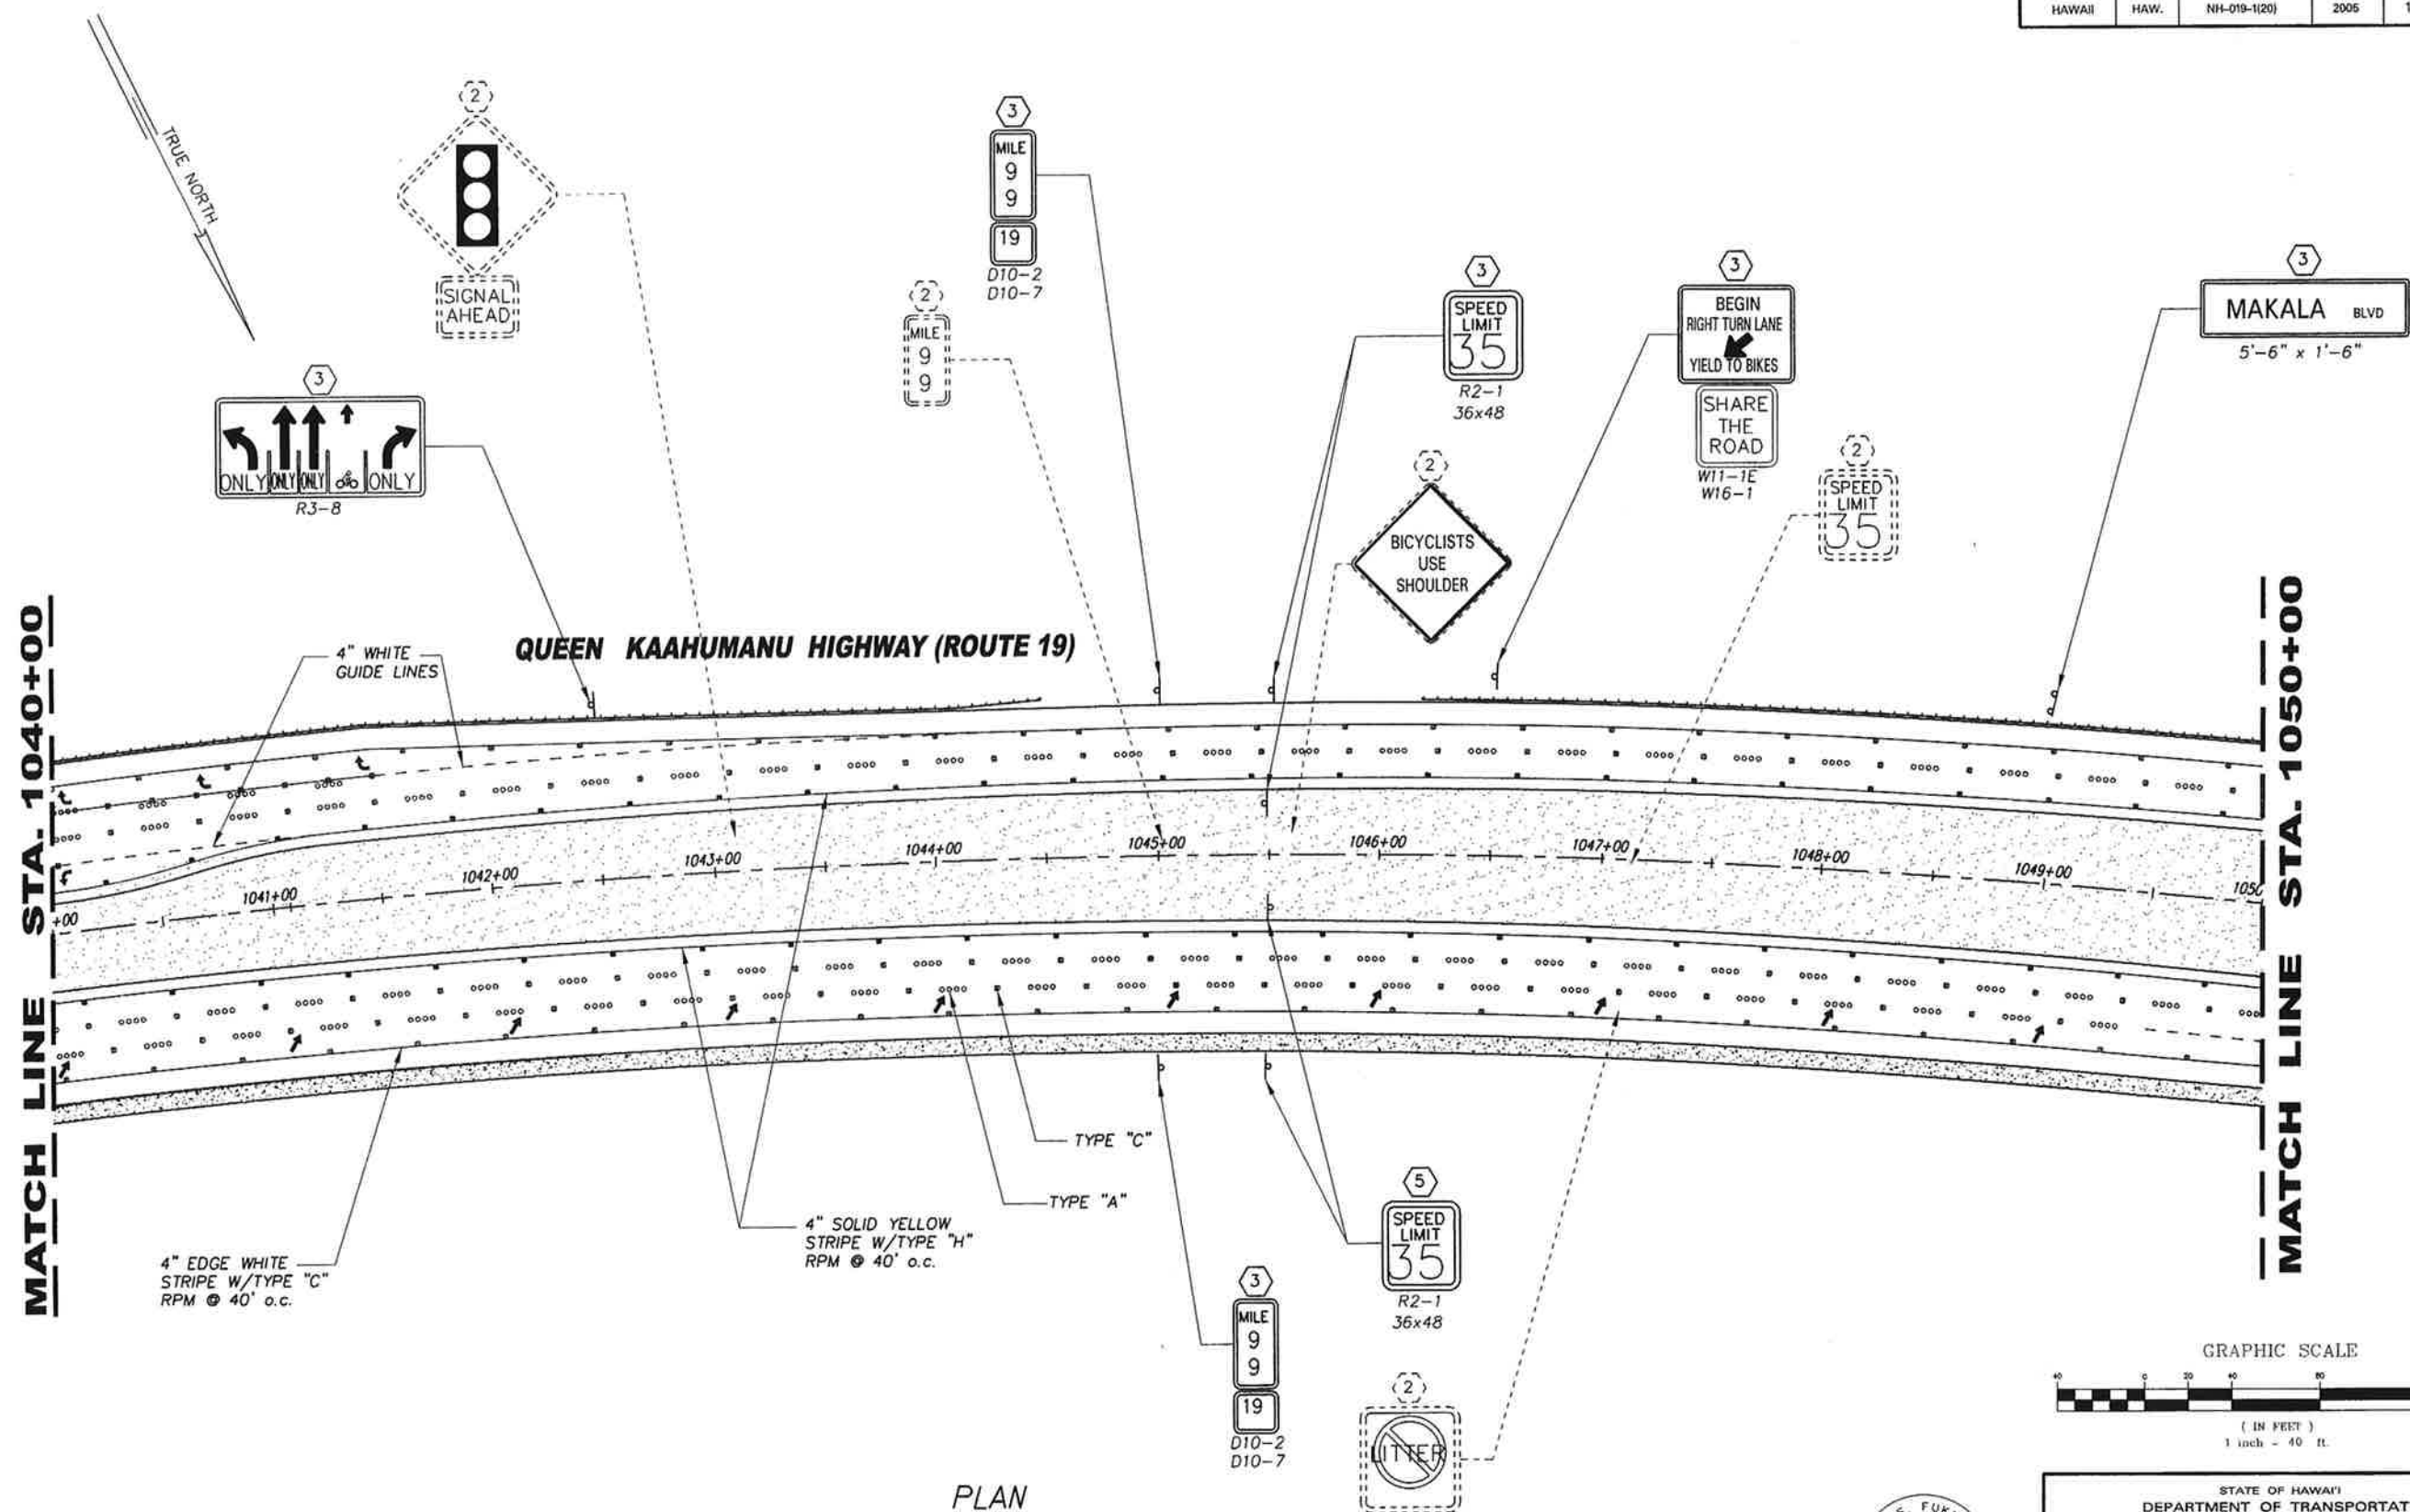

PLAN
Scale: 1"=40'

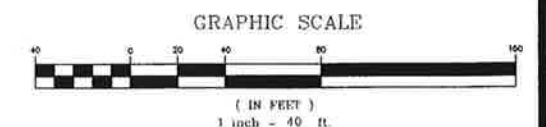

This work was prepared by me or under my supervision.
Exp. 04-30-10
Neal S. Fukumoto
Wesley R. Sato & Associates, Inc.

STATE OF HAWAII
DEPARTMENT OF TRANSPORTATION
HIGHWAYS DIVISION
STRIPING PLAN
STA. 1040+00 TO STA. 1050+00
QUEEN KAAHUMANU HIGHWAY WIDENING
HENRY ST. to KEALAKEHE PKWY - PHASE I
Federal Aid Project No. NH-019-1(20)
Scale: Not to Scale Date: November 2009


SHEET No. 8 OF 15 SHEETS

AS-BUILT


122

SURVEY PLOTTED BY	DATE
DRAWN BY	
CHECKED BY	
NOTE BOOK	
QUANTITIES BY	
CHECKED BY	
N.	

FED. ROAD DIST. NO.	STATE	FED. AID PROJ. NO.	FISCAL YEAR	SHEET NO.	TOTAL SHEETS
HAWAII	HAW.	NH-019-1(20)	2005	123	315

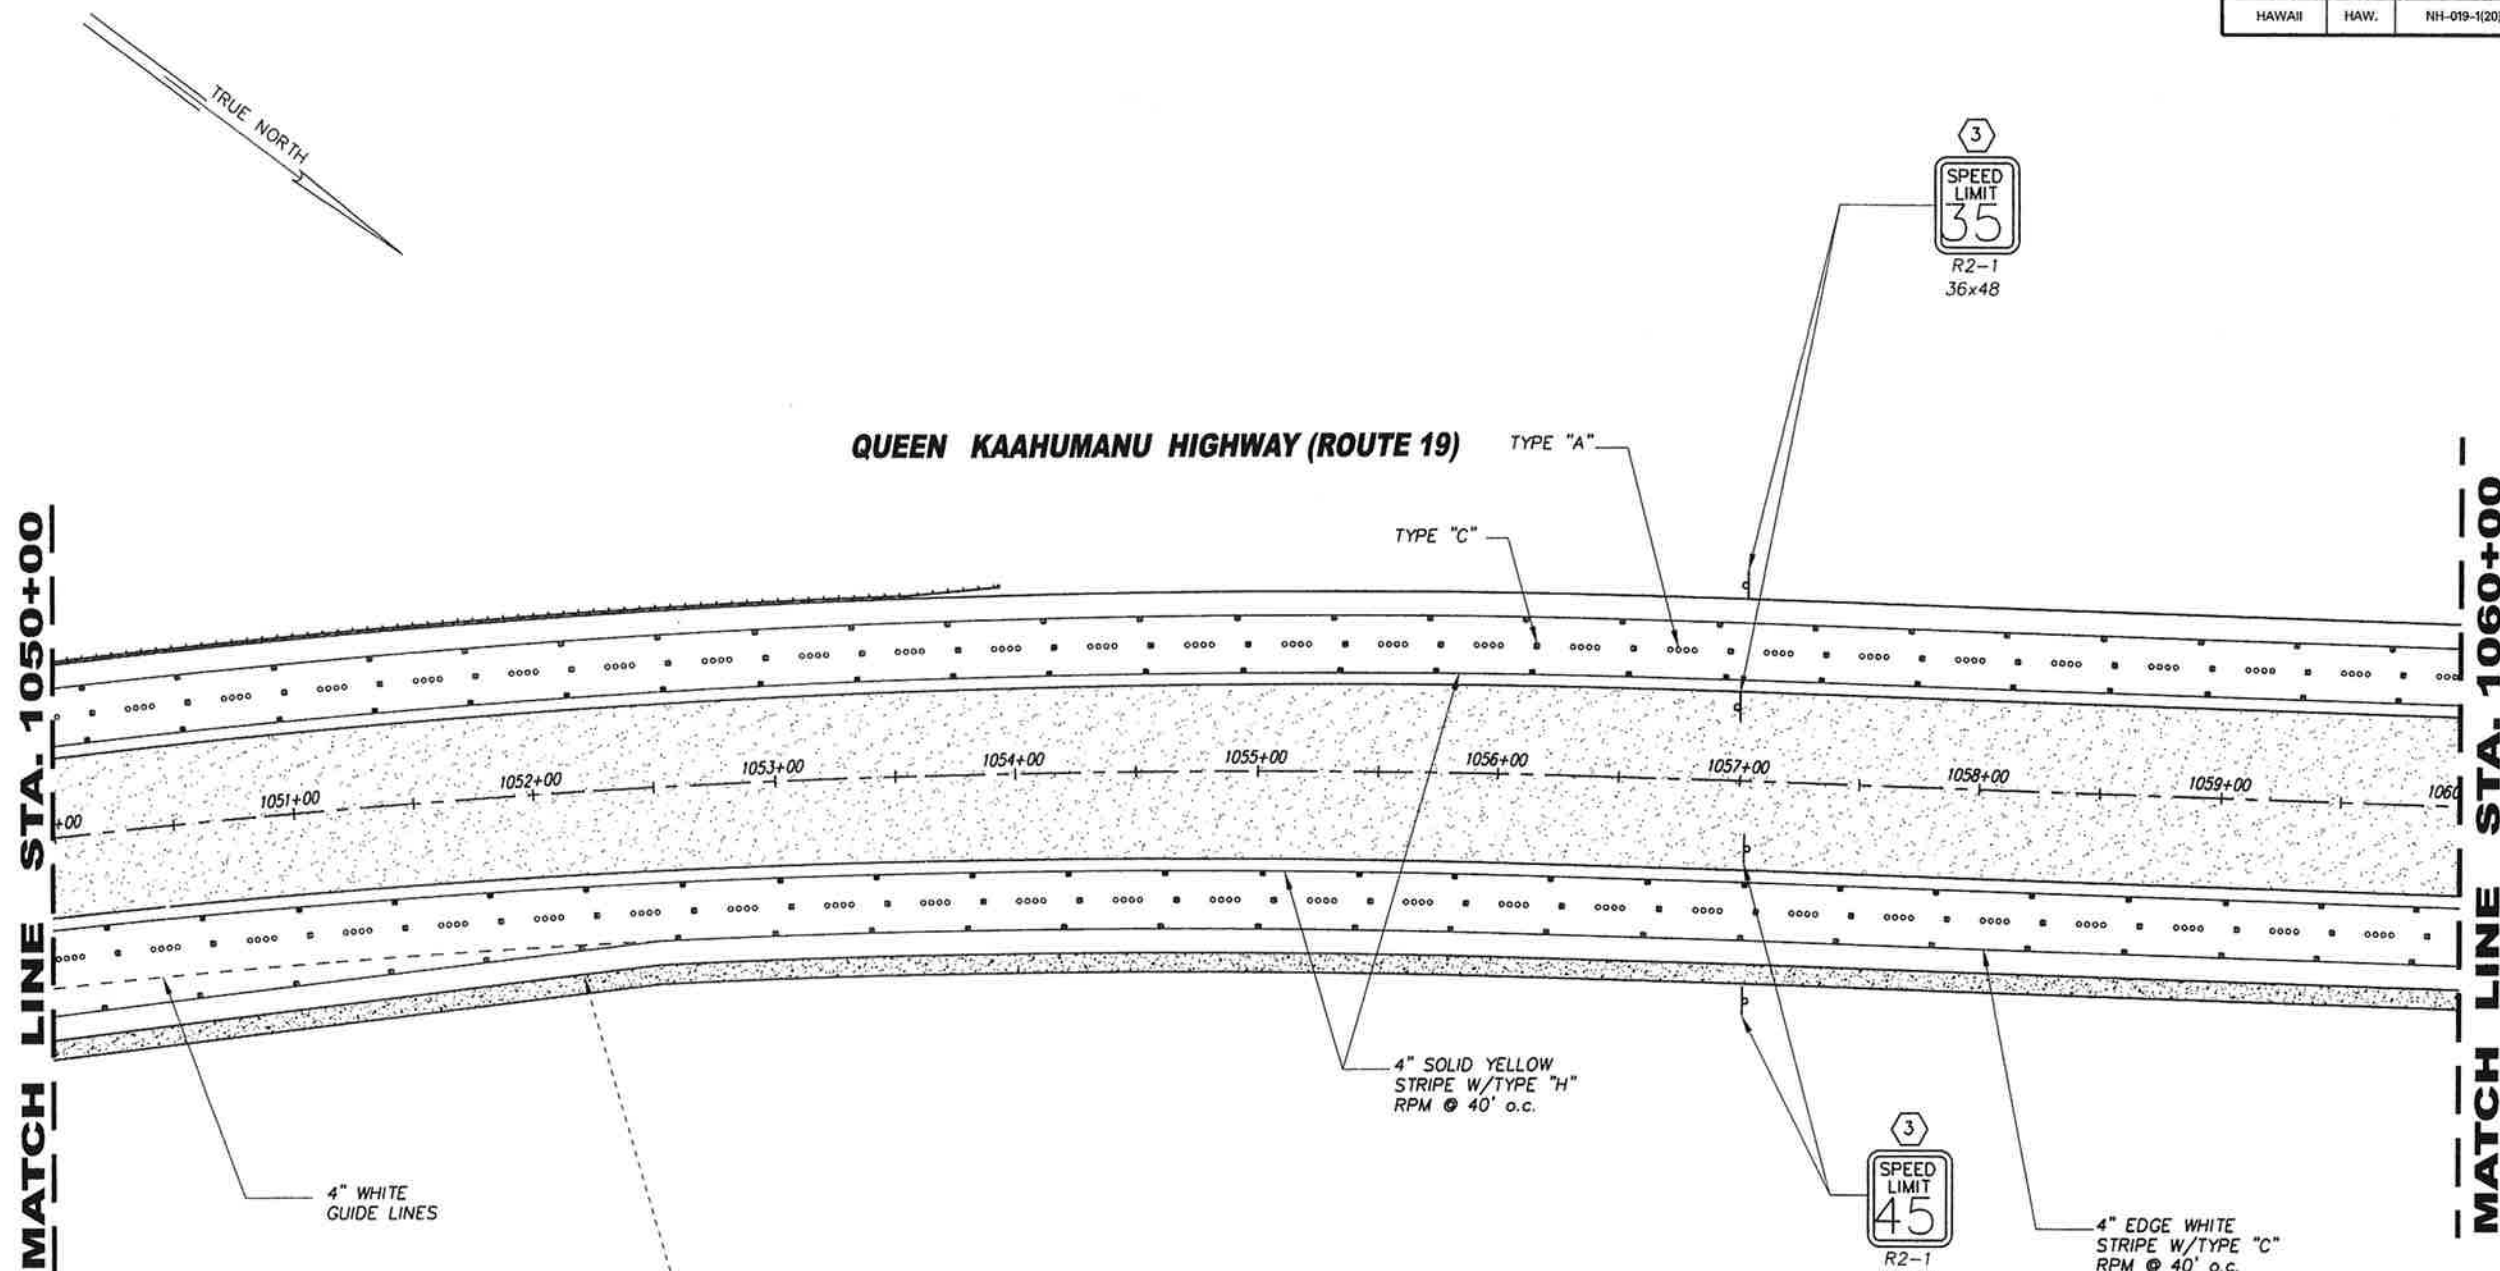

PLAN
Scale: 1"=40'

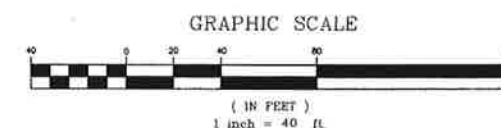

This work was prepared by me or under my supervision.
Exp. 04-30-10
Neal S. Fukunaga
Wesley R. Segawa & Associates, Inc.

STATE OF HAWAII
DEPARTMENT OF TRANSPORTATION
HIGHWAYS DIVISION

STRIPING PLAN
STA. 1050+00 TO STA. 1060+00
QUEEN KAAHUMANU HIGHWAY WIDENING
HENRY ST. to KEALAKEHE PKWY - PHASE I
Federal Aid Project No. NH-019-1(20)
Scale: 1" = 40' Date: November 2009

SHEET No. 9 OF 15 SHEETS

AS-BUILT

123


SURVEY PLOTTED BY	DATE
DESIGNED BY	
NOTED BY	
CHECKED BY	
NO.	

FED. ROAD DIST. NO.	STATE	FED. AID PROJ. NO.	FISCAL YEAR	SHEET NO.	TOTAL SHEETS
HAWAII	HAW.	NH-019-1(20)	2005	124	315


TRUE NORTH

MATCH LINE STA. 1060+00

MATCH LINE STA. 1070+00

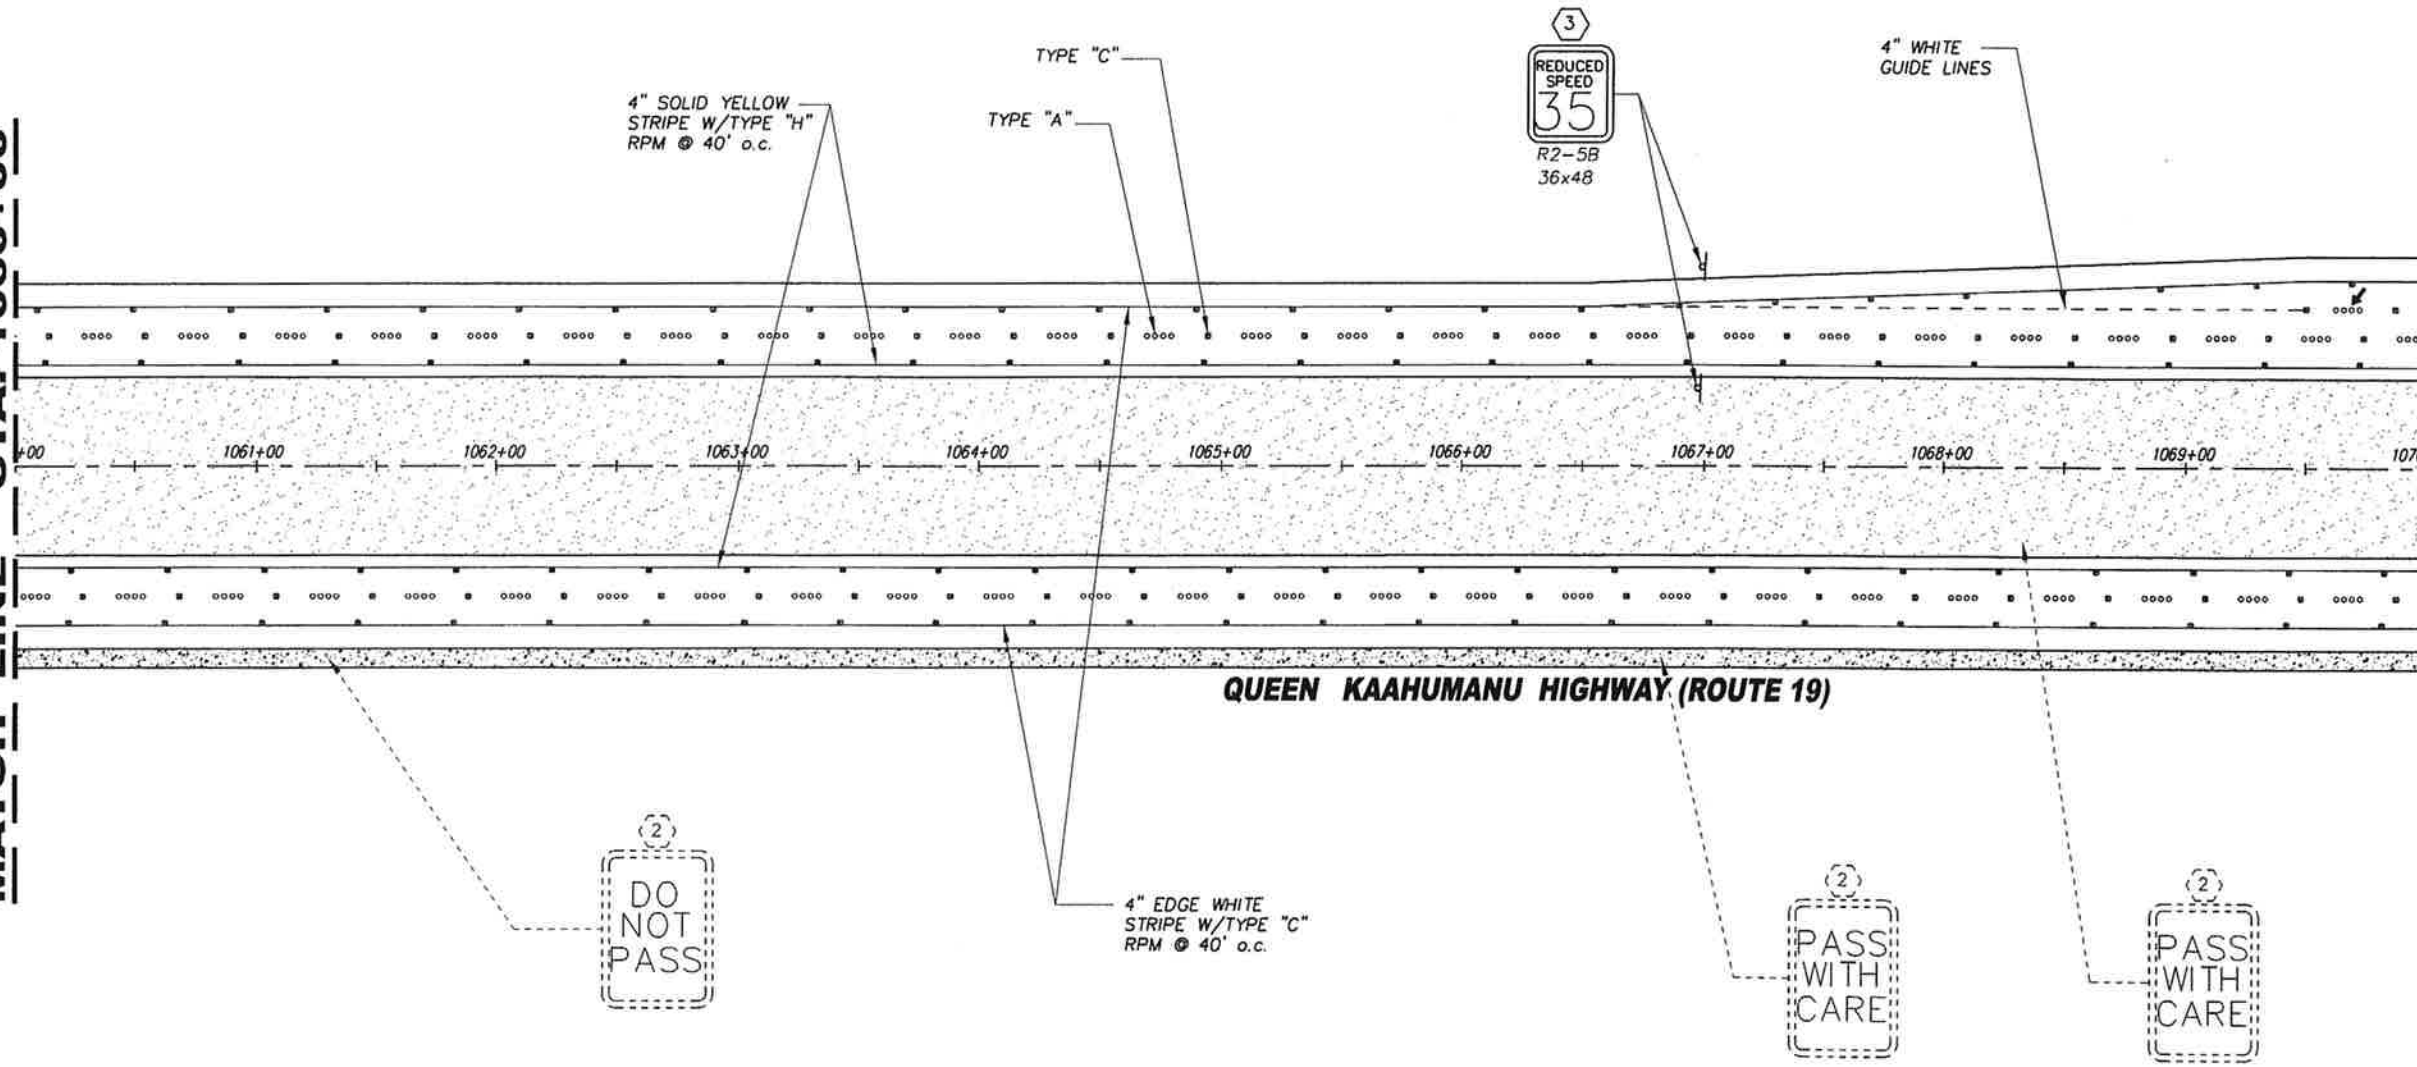

PLAN
Scale: 1"=40'

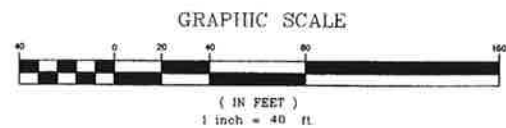

SURVEY PLOTTED BY	DATE
DRAWN BY	
DESIGNED BY	
NOTE BOOK	
CHECKED BY	


NEAL S. FUKUMOTO
LICENSED PROFESSIONAL ENGINEER
No. 6186-C
HAWAII, U.S.A.

This work was prepared by me or under my supervision.
Exp. 04-30-10
Neal S. Fukumoto
Wesley K. Segawa & Associates, Inc.


STATE OF HAWAII
DEPARTMENT OF TRANSPORTATION
HIGHWAYS DIVISION
STRIPING PLAN
STA. 1060+00 TO STA. 1070+00
QUEEN KAAHUMANU HIGHWAY WIDENING
HENRY ST. to KEALAKEHE PKWY - PHASE I
Federal Aid Project No. NH-019-1(20)
Scale: 1" = 40' Date: November 2009

AS-BUILT

FED. ROAD DIST. NO.	STATE	FED. AID PROJ. NO.	FISCAL YEAR	SHEET NO.	TOTAL SHEETS
HAWAII	HAW.	NH-019-1(20)	2005	125	315

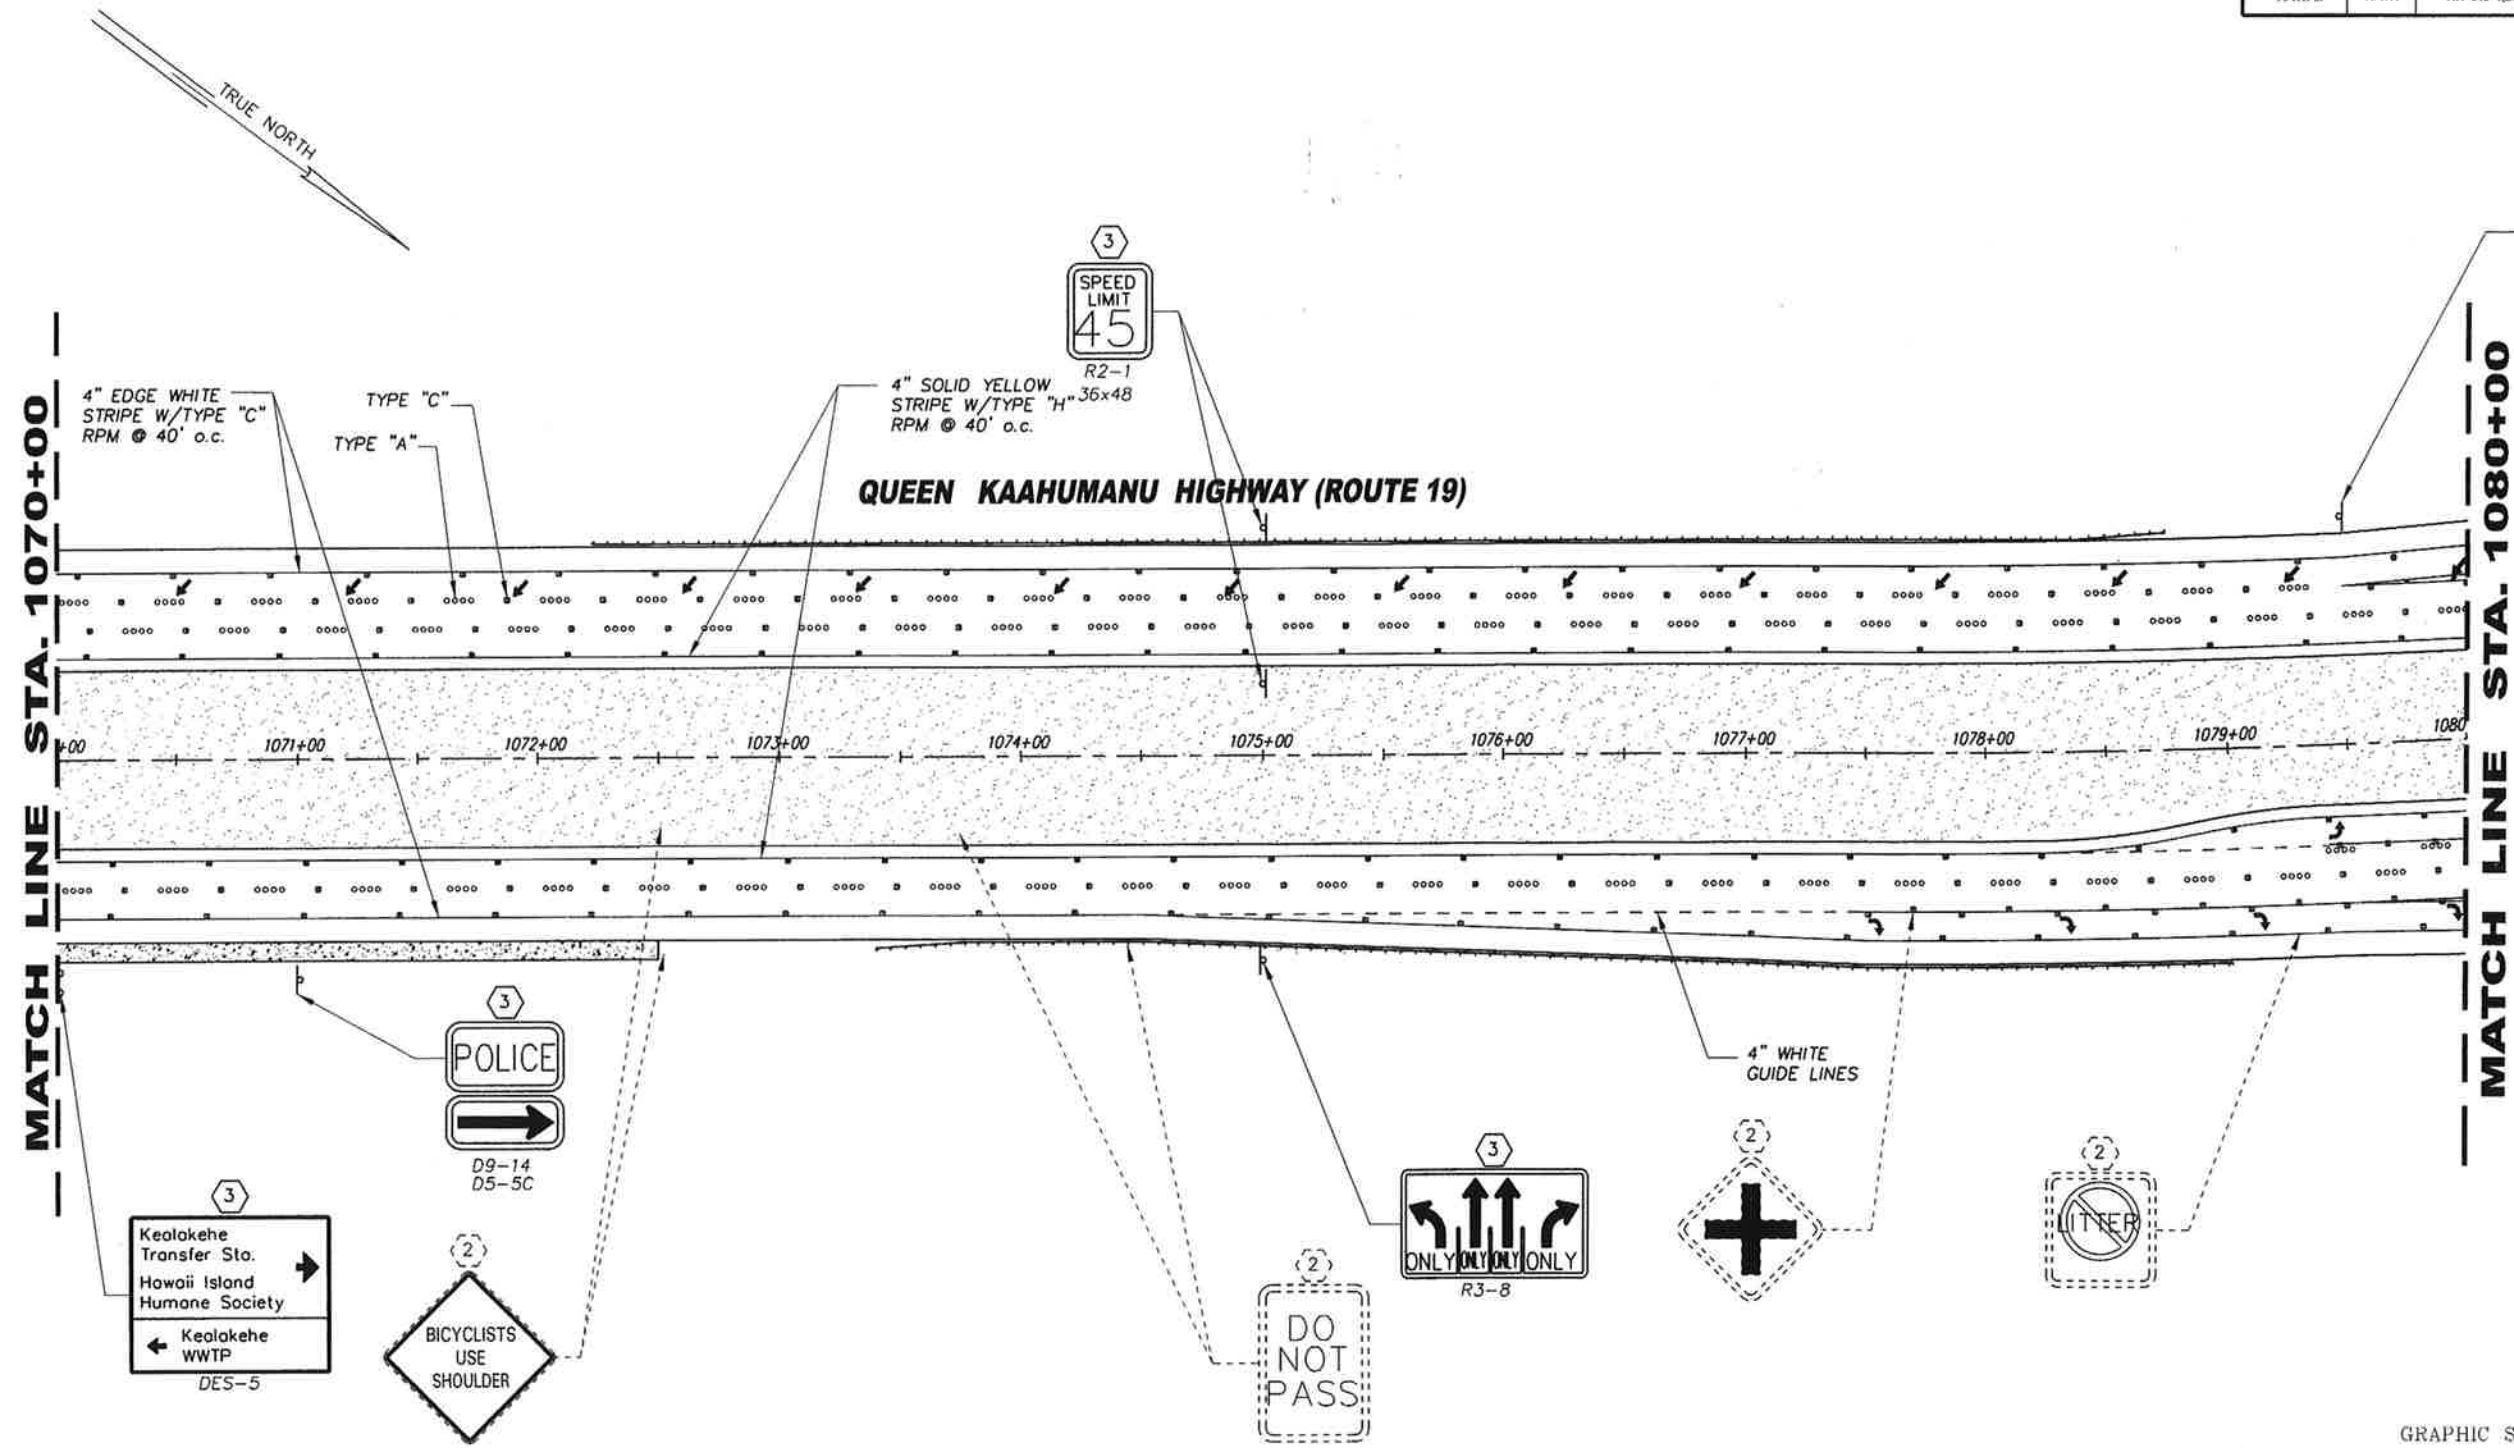

PLAN
Scale: 1"=40'

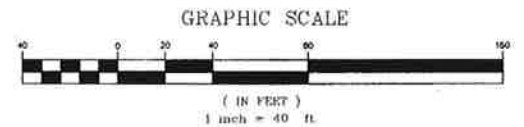

DATE	
SURVEY PLOTTED BY	
DESIGNED BY	
NOTED BY	
CHECKED BY	




This work was prepared by me or under my supervision.
Exp. 04-30-10
Neal S. Fukumoto
Wesley R. Seppel & Associates, Inc.

STATE OF HAWAII
DEPARTMENT OF TRANSPORTATION
HIGHWAYS DIVISION

STRIPING PLAN
STA. 1070+00 TO STA. 1080+00
QUEEN KAAHUMANU HIGHWAY WIDENING
HENRY ST. to KEALAKEHE PKWY - PHASE I
Federal Aid Project No. NH-019-1(20)
Scale: 1" = 40' Date: November 2009


AS-BUILT

FED. ROAD DIST. NO.	STATE	FED. AID PROJ. NO.	FISCAL YEAR	SHEET NO.	TOTAL SHEETS
HAWAII	HAW.	NH-019-1(20)	2005	126	315

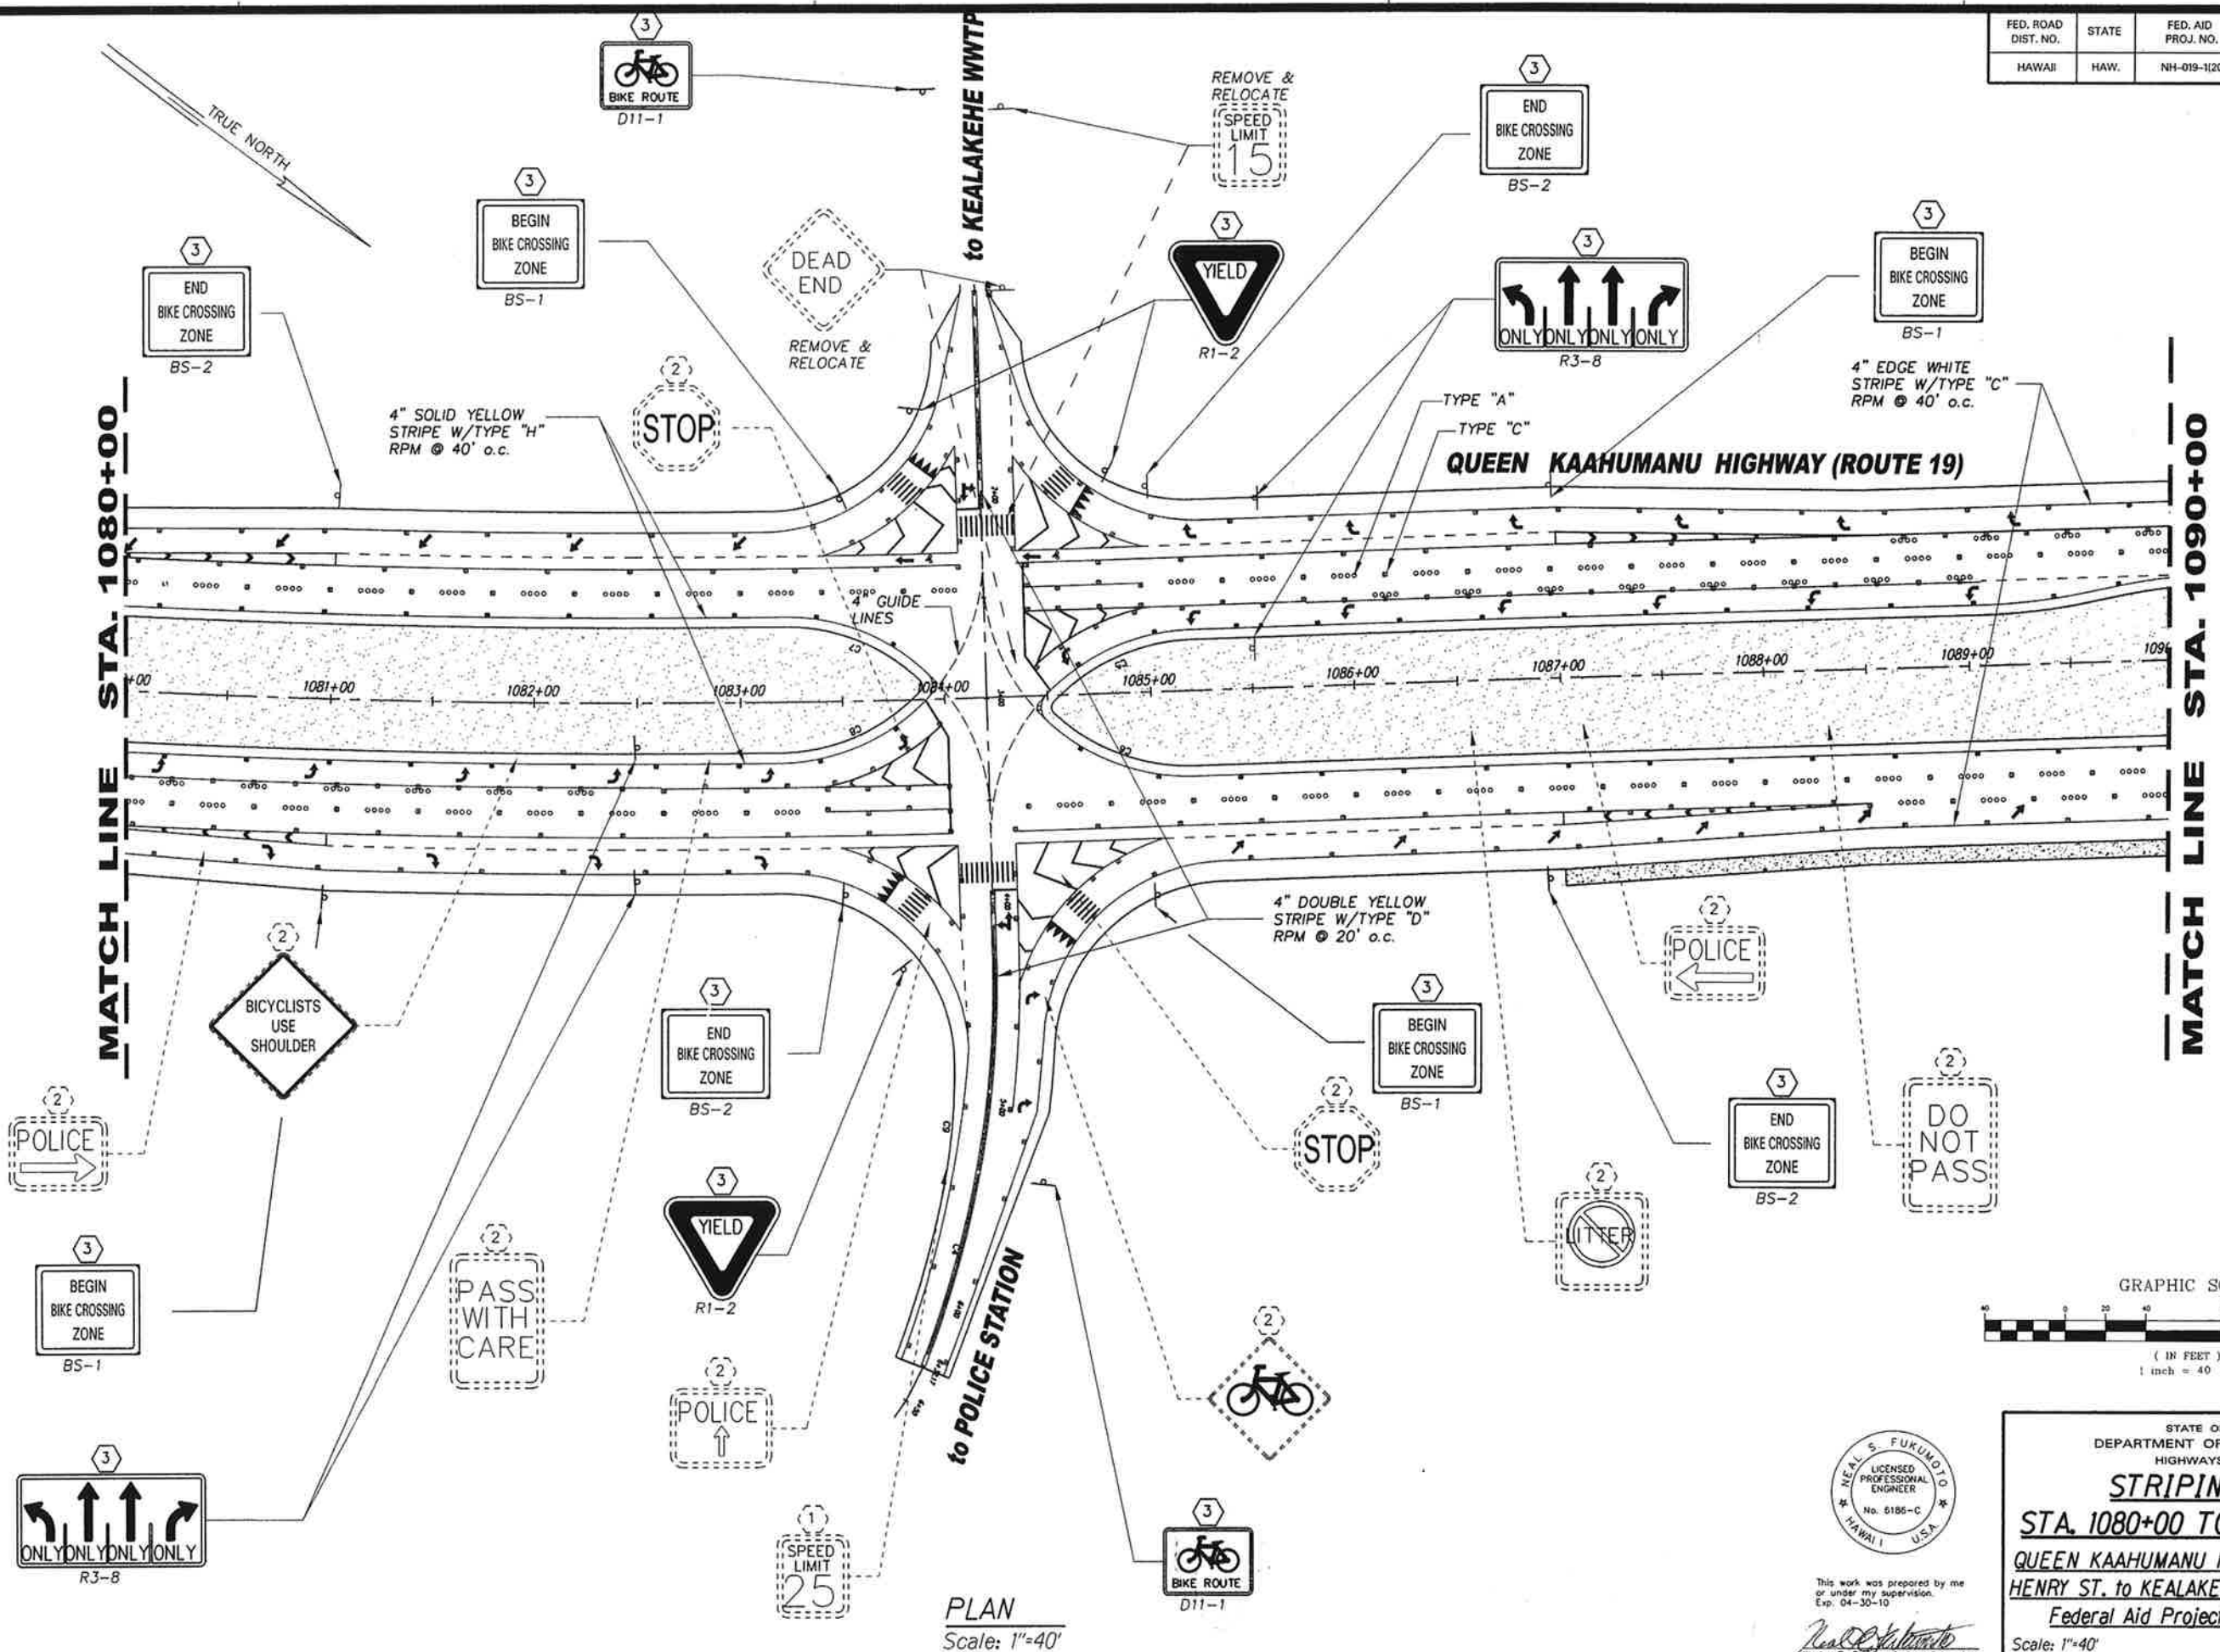

DATE	_____
DESIGNED BY	_____
CHECKED BY	_____
NOTED BY	_____
QUANTITIES BY	_____
ORIGINAL FILED BY	_____

PLAN
Scale: 1"=40'

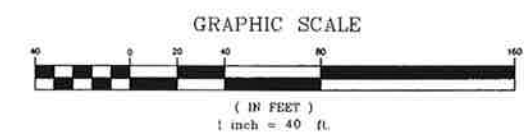

This work was prepared by me or under my supervision.
Exp. 04-30-10
Wesley R. Segawa & Associates, Inc.


STATE OF HAWAII
DEPARTMENT OF TRANSPORTATION
HIGHWAYS DIVISION

STRIPING PLAN
STA. 1080+00 TO STA. 1090+00
QUEEN KAAHUMANU HIGHWAY WIDENING
HENRY ST. to KEALAKEHE PKWY - PHASE I
Federal Aid Project No. NH-019-1(20)

Scale: 1"=40' Date: November 2009


AS-BUILT

FED. ROAD DIST. NO.	STATE	FED. AID PROJ. NO.	FISCAL YEAR	SHEET NO.	TOTAL SHEETS
HAWAII	HAW.	NH-019-1(20)	2005	127	315

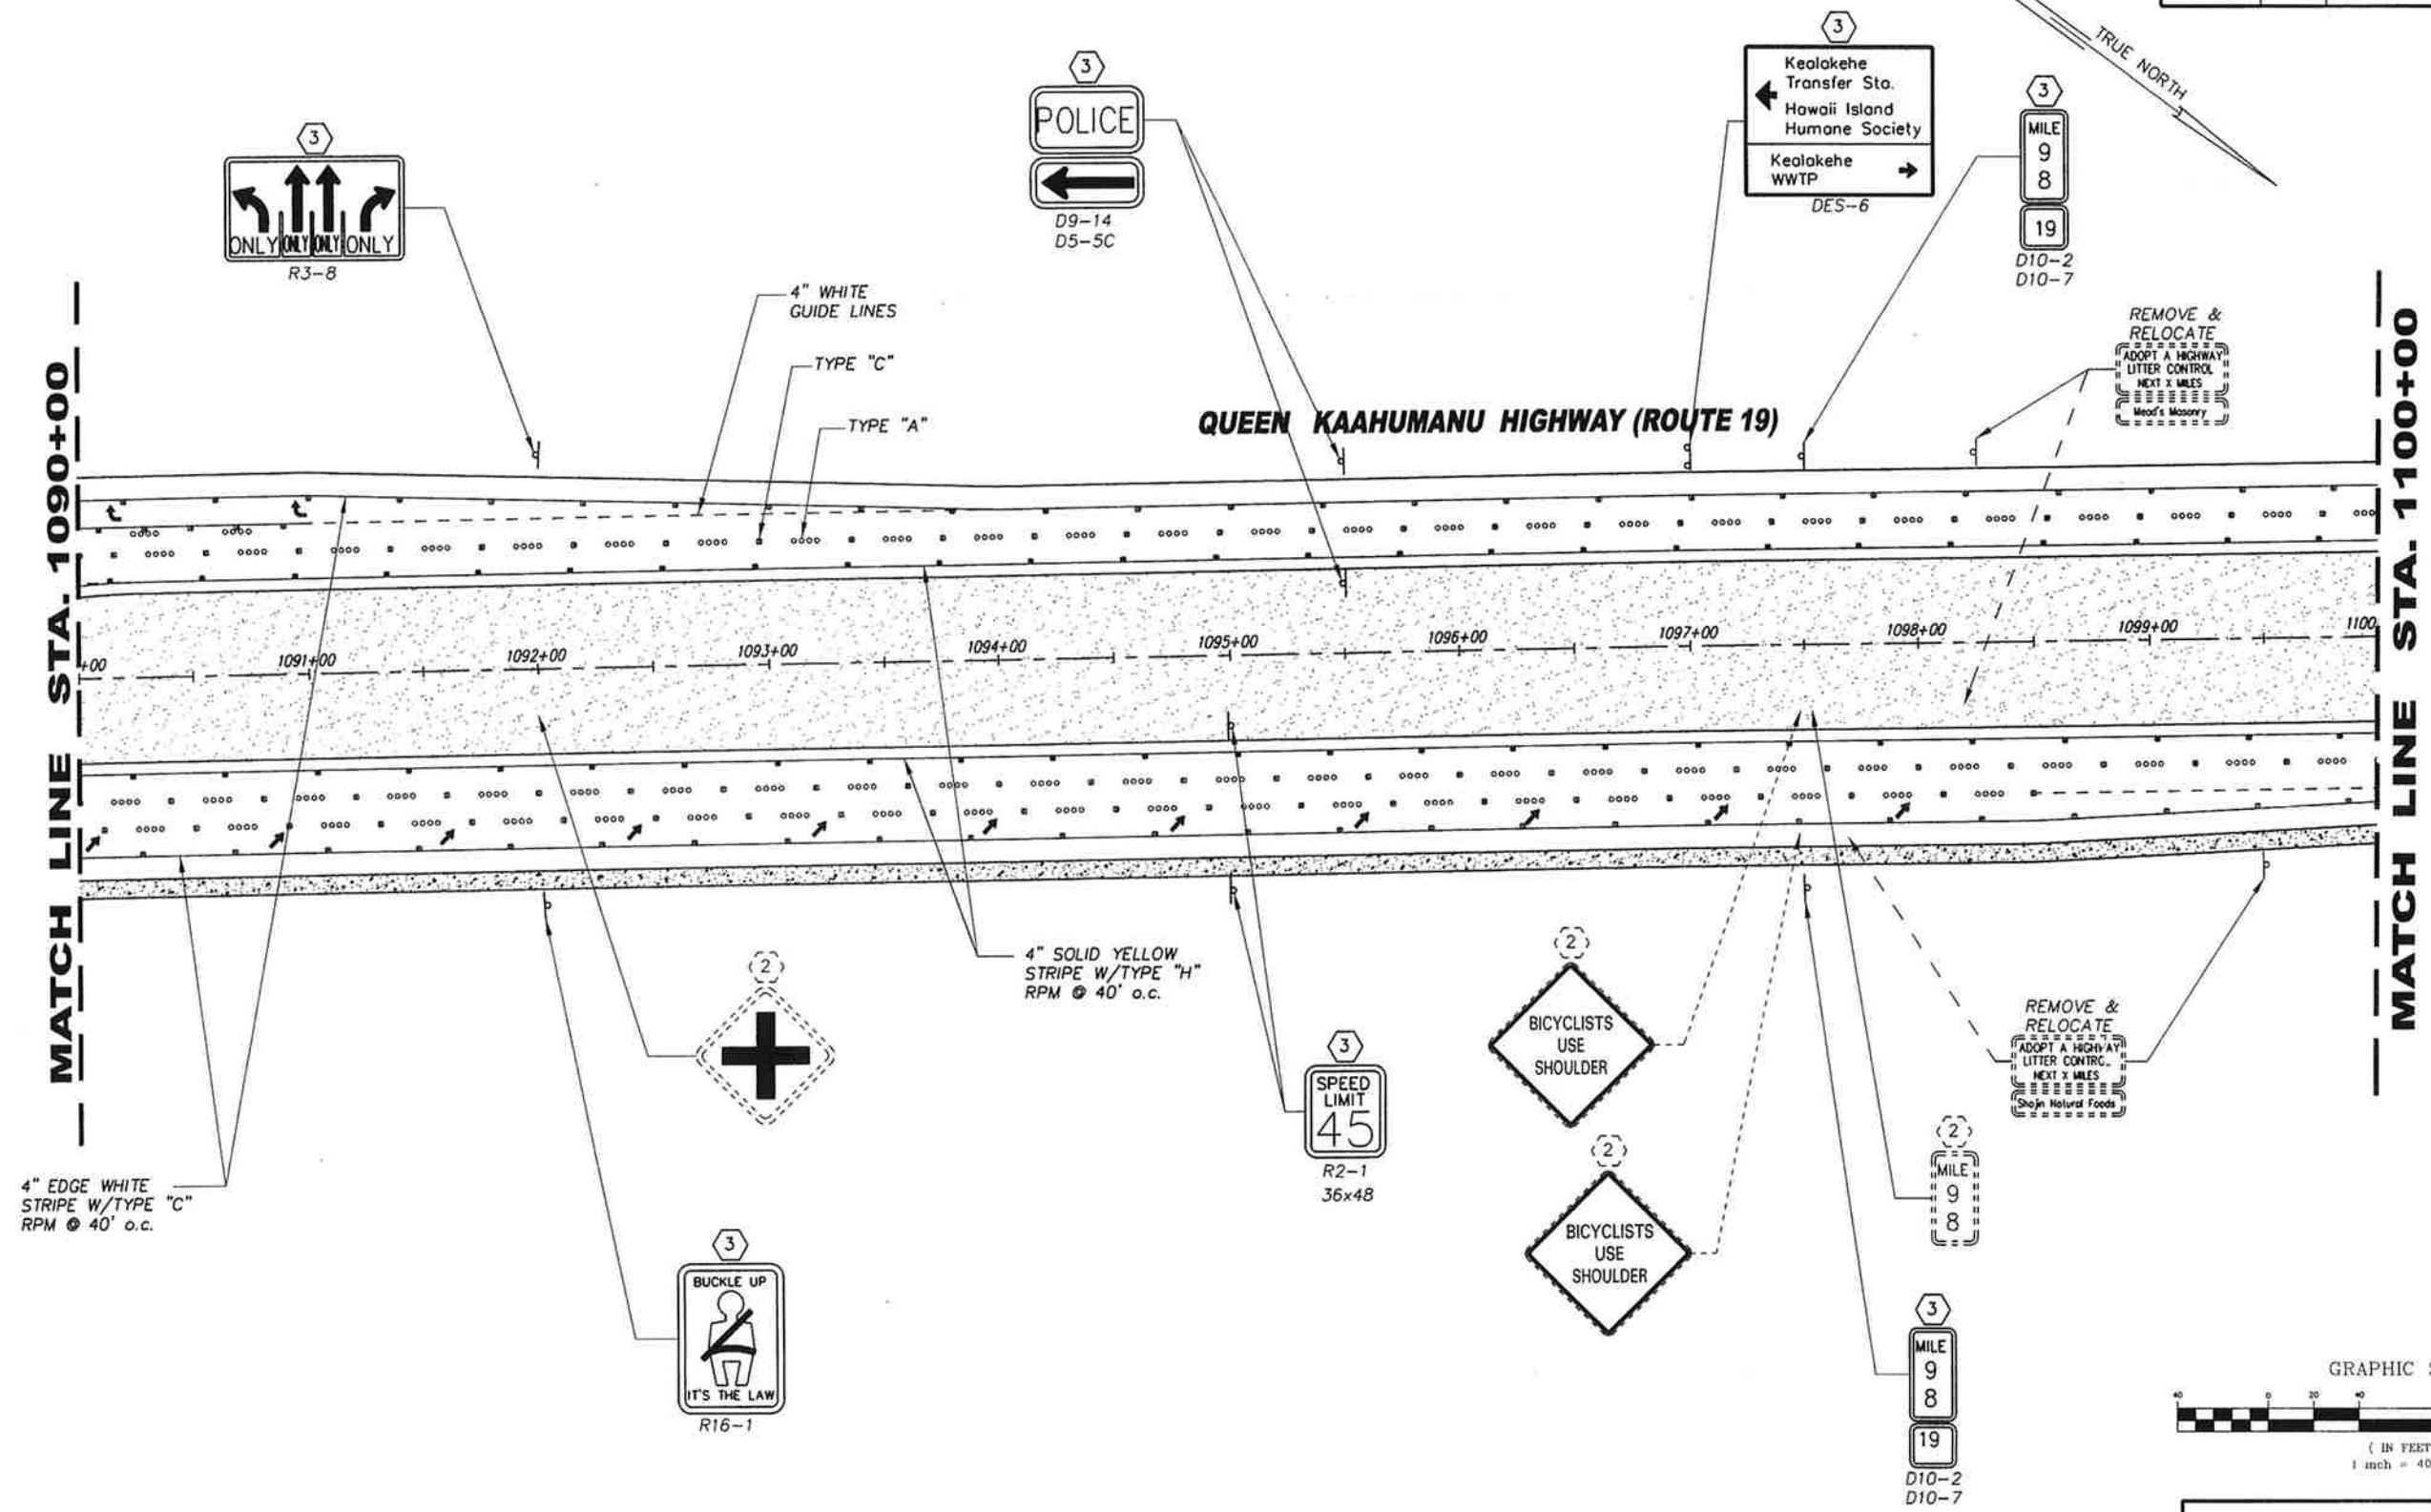

DATE	_____
DESIGNED BY	_____
CHECKED BY	_____
QUANTITIES BY	_____
NOTED BY	_____
ORIGINAL PLAN	_____

PLAN
Scale: 1"=40'

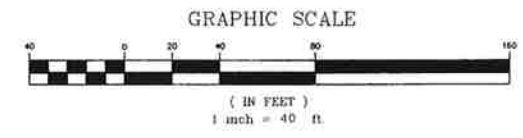


This work was prepared by me or under my supervision.
Exp. 04-30-10
Neal S. Fukumoto
Wesley R. Segawa & Associates, Inc.

STATE OF HAWAII
DEPARTMENT OF TRANSPORTATION
HIGHWAYS DIVISION

STRIPING PLAN
STA. 1090+00 TO STA. 1100+00
QUEEN KAAHUMANU HIGHWAY WIDENING
HENRY ST. to KEALAKEHE PKWY - PHASE I
Federal Aid Project No. NH-019-1(20)
Scale: 1" = 40' Date: November 2009

AS-BUILT

FED. ROAD DIST. NO.	STATE	FED. AID PROJ. NO.	FISCAL YEAR	SHEET NO.	TOTAL SHEETS
HAWAII	HAW.	NH-019-1(20)	2005	128	315

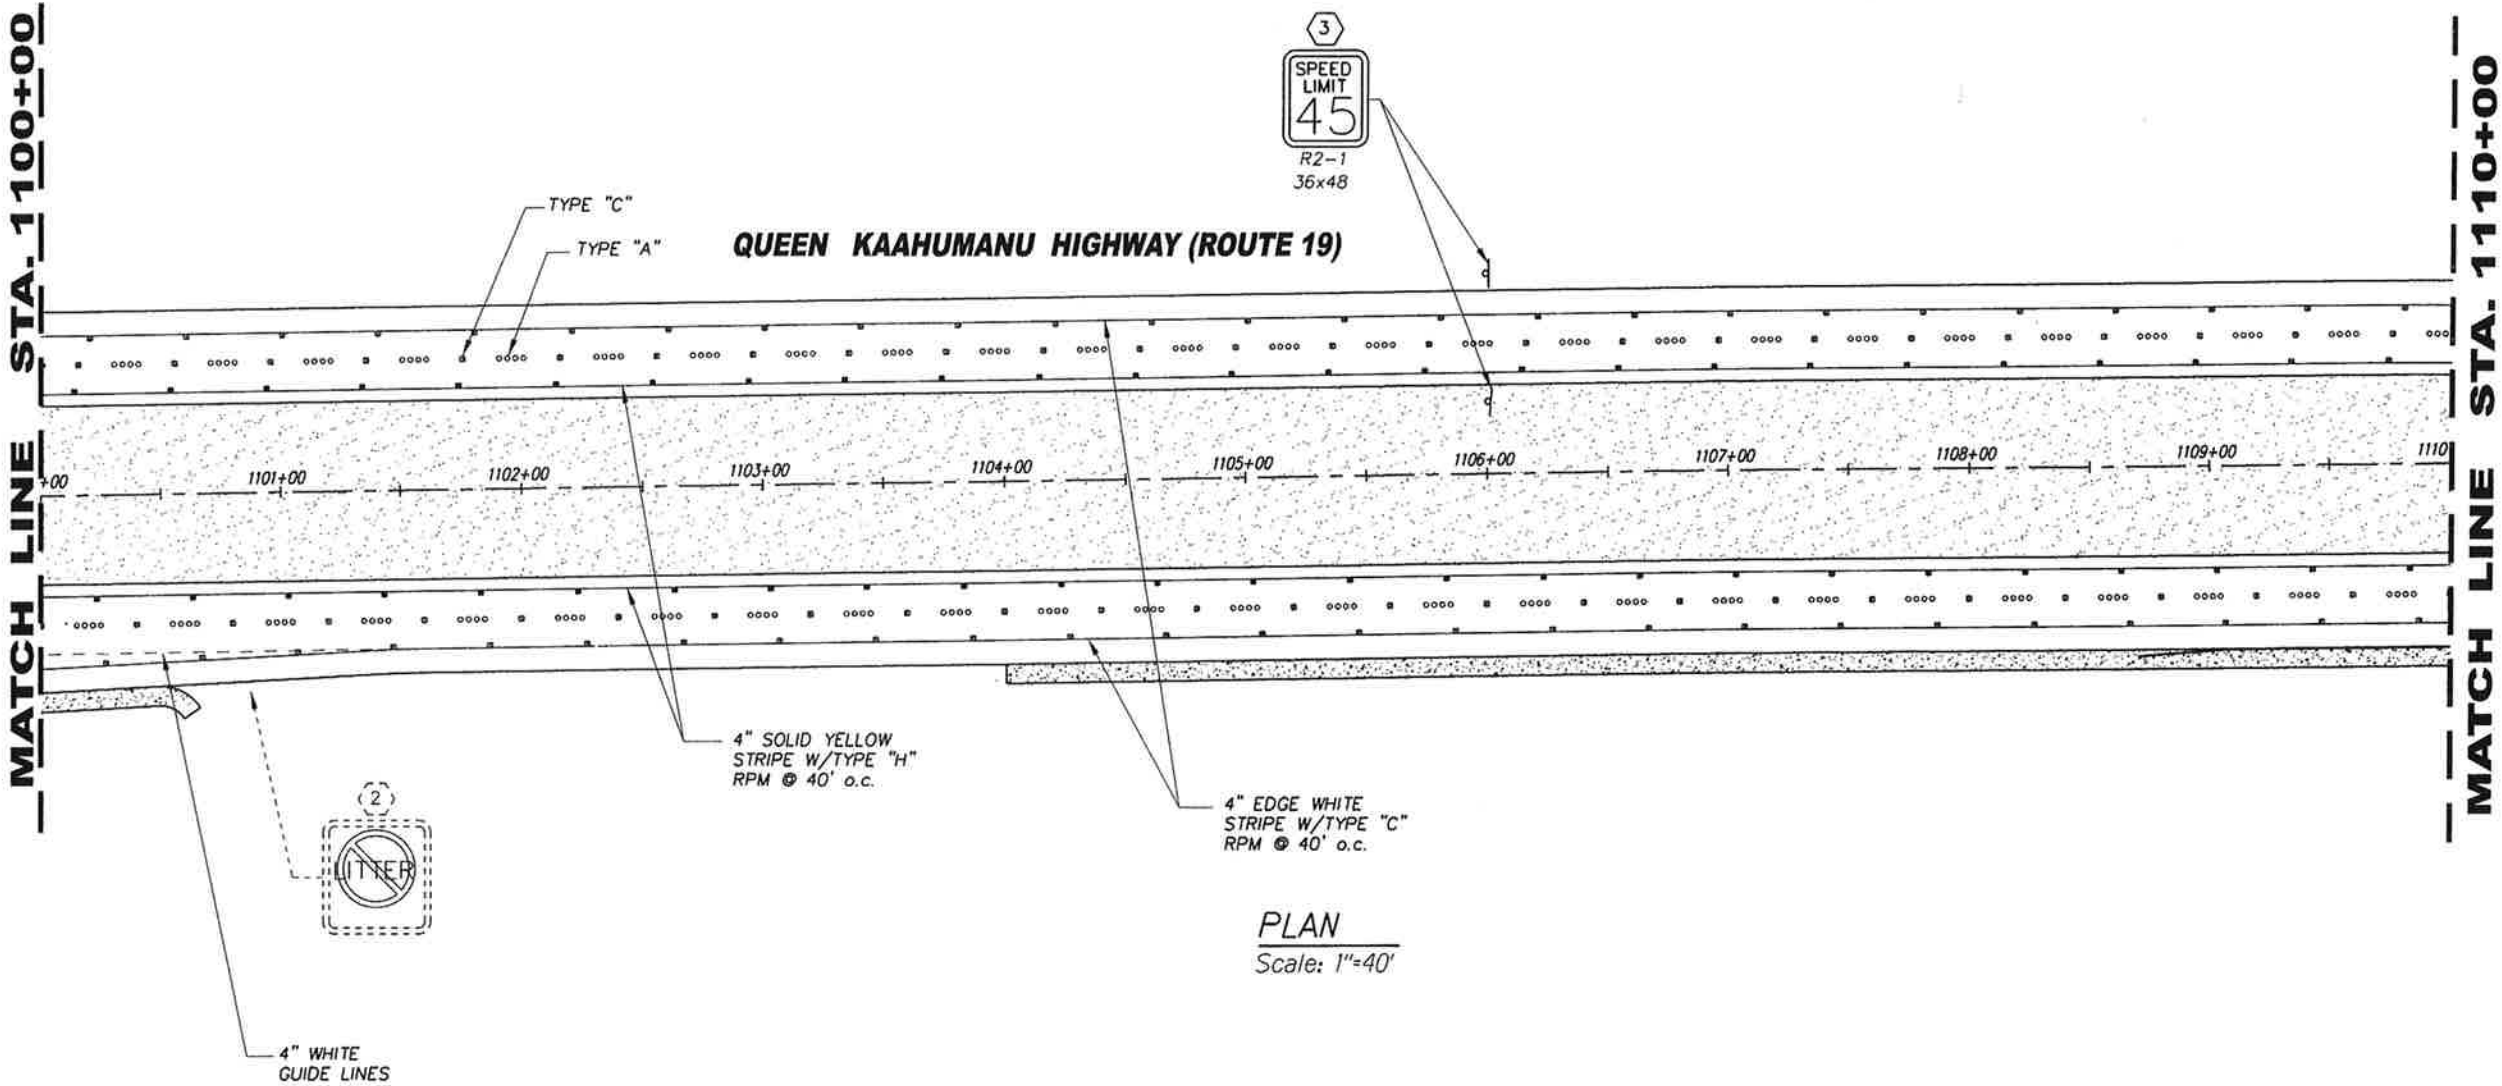

SURVEY PLOTTED BY	DATE
DRAWN BY	
CHECKED BY	
NOTED BY	
CHECKED BY	



This work was prepared by me or under my supervision. Exp. 04-30-10

Neal S. Fukunaga & Associates, Inc.

STATE OF HAWAII
DEPARTMENT OF TRANSPORTATION
HIGHWAYS DIVISION

STRIPING PLAN

STA. 1100+00 TO STA. 1110+00

QUEEN KAAHUMANU HIGHWAY WIDENING


HENRY ST. to KEALAKEHE PKWY - PHASE I

Federal Aid Project No. NH-019-1(20)


Scale: 1" = 40' Date: November 2009

SHEET No. 14 OF 15 SHEETS

FED. ROAD DIST. NO.	STATE	FED. AID PROJ. NO.	FISCAL YEAR	SHEET NO.	TOTAL SHEETS
HAWAII	HAW.	NH-019-1(20)	2005	129	315

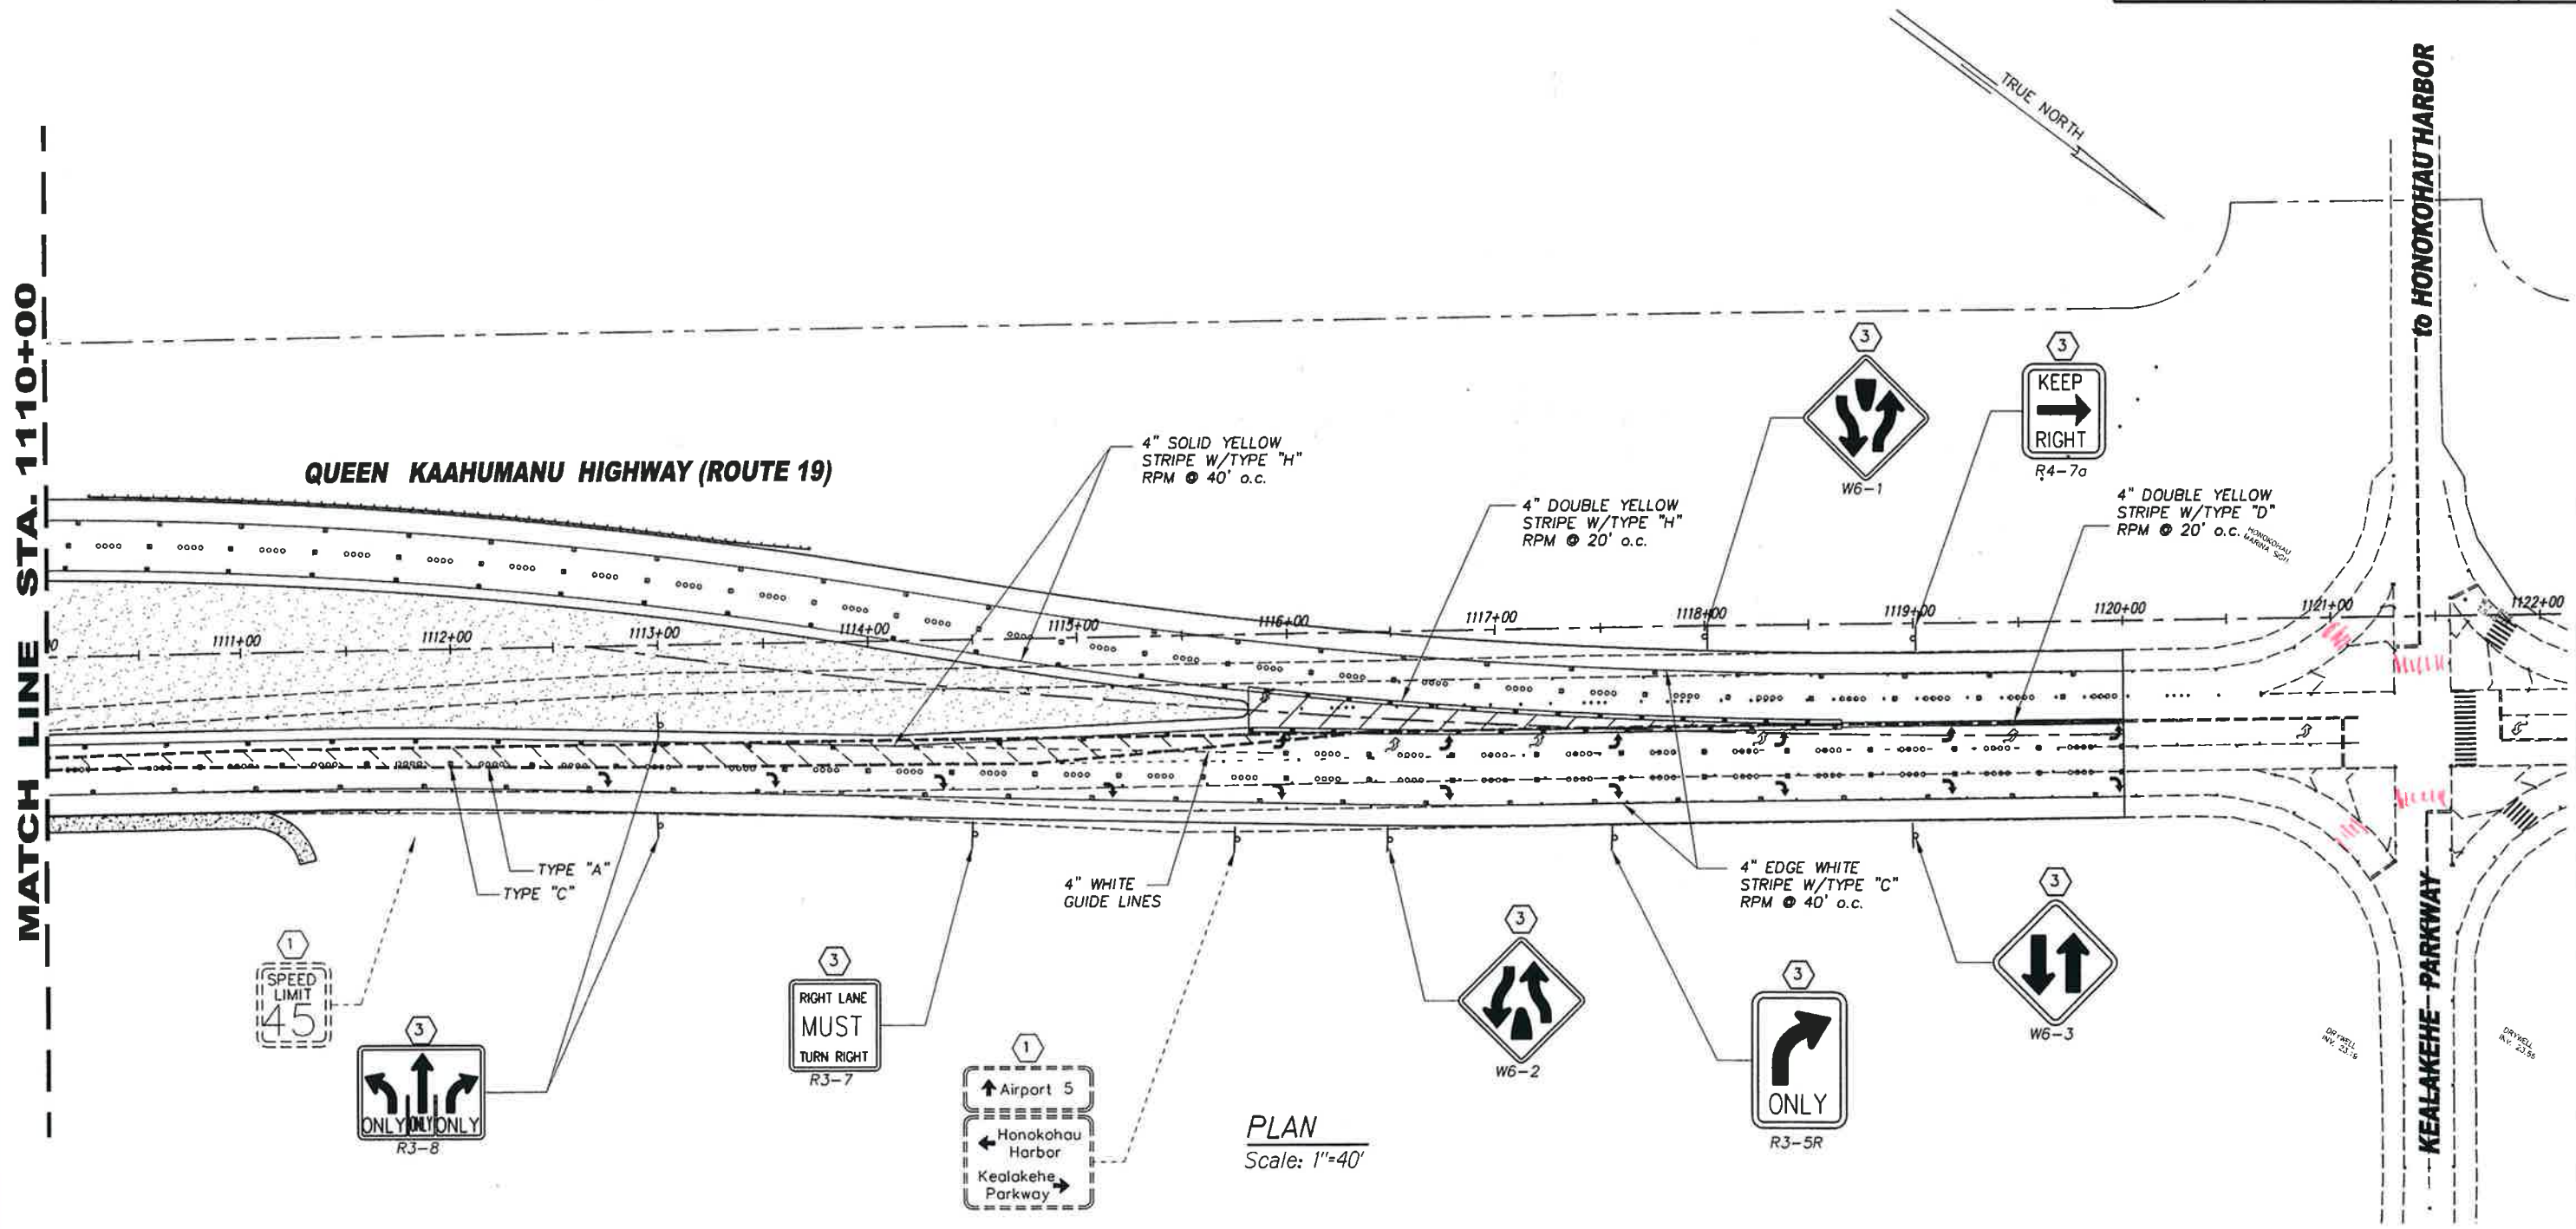

SURVEY PLOTTED BY	DATE
DRAWN BY	
TRACED BY	
CHECKED BY	
NOTED BY	
DATE	

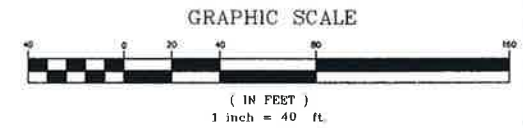

This work was prepared by me or under my supervision.
Exp. 04-30-10
Neal S. Fukumoto
Wesley R. Segawa & Associates, Inc.

STATE OF HAWAII
DEPARTMENT OF TRANSPORTATION
HIGHWAYS DIVISION

STRIPING PLAN
STA. 1110+00 TO STA. 1120+00
QUEEN KAAHUMANU HIGHWAY WIDENING
HENRY ST. to KEALAKEHE PKWY - PHASE I
Federal Aid Project No. NH-019-1(20)
Scale: 1" = 40' Date: November 2009

AS-BUILT