



FED. ROAD DIST. NO.	STATE	FED. AID PROJ. NO.	FISCAL YEAR	SHEET NO.	TOTAL SHEETS
HAWAII	HAW.	NH-019-1(20)	2005	37	315

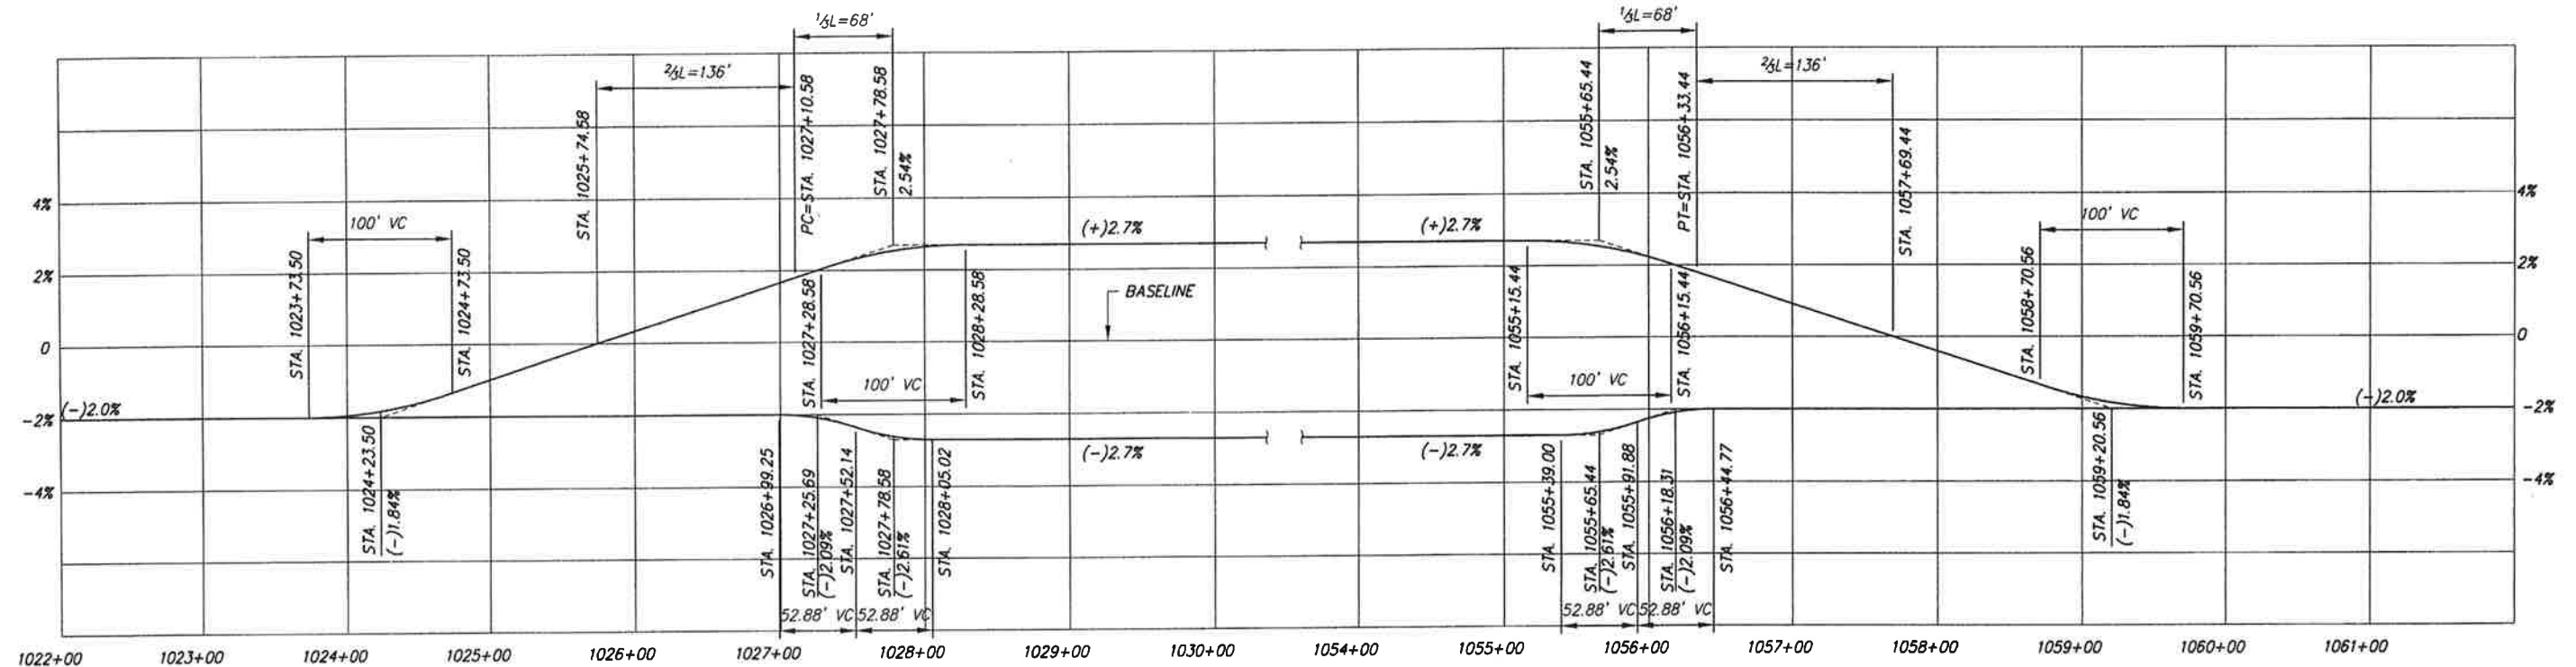

PC STA. 1027+10.58 TO PT STA. 1056+33.44

SCALE: HORIZ 1"=60'
VERT 1"=2%

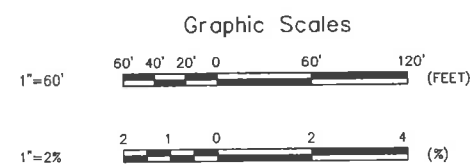

ORIGINAL PLAN	SURVEY PLOTTED BY _____ DATE _____
NOTE BOOK	DRAWN BY _____
	TRACED BY _____
	DESIGNED BY _____
	QUANTITIES BY _____
14.	CHECKED BY _____



This work was prepared by me
or under my supervision.
Exp. 04-30-10


Wesley R. Segawa & Associates, Inc.

STATE OF HAWAII
DEPARTMENT OF TRANSPORTATION
HIGHWAYS DIVISION

SUPERELEVATION DIAGRAM


QUEEN KAAHUMANU HIGHWAY WIDENING
HENRY ST. to KEALAKEHE PKWY - PHASE I
Federal Aid Project No. NH-019-K201

Scale: As Shown Date: November 2009

SHEET No. 1 OF 2 SHEETS

AS-BUILT

FED. ROAD DIST. NO.	STATE	FED. AID PROJ. NO.	FISCAL YEAR	SHEET NO.	TOTAL SHEETS
HAWAII	HAW.	NH-019-1(20)	2005	38	315

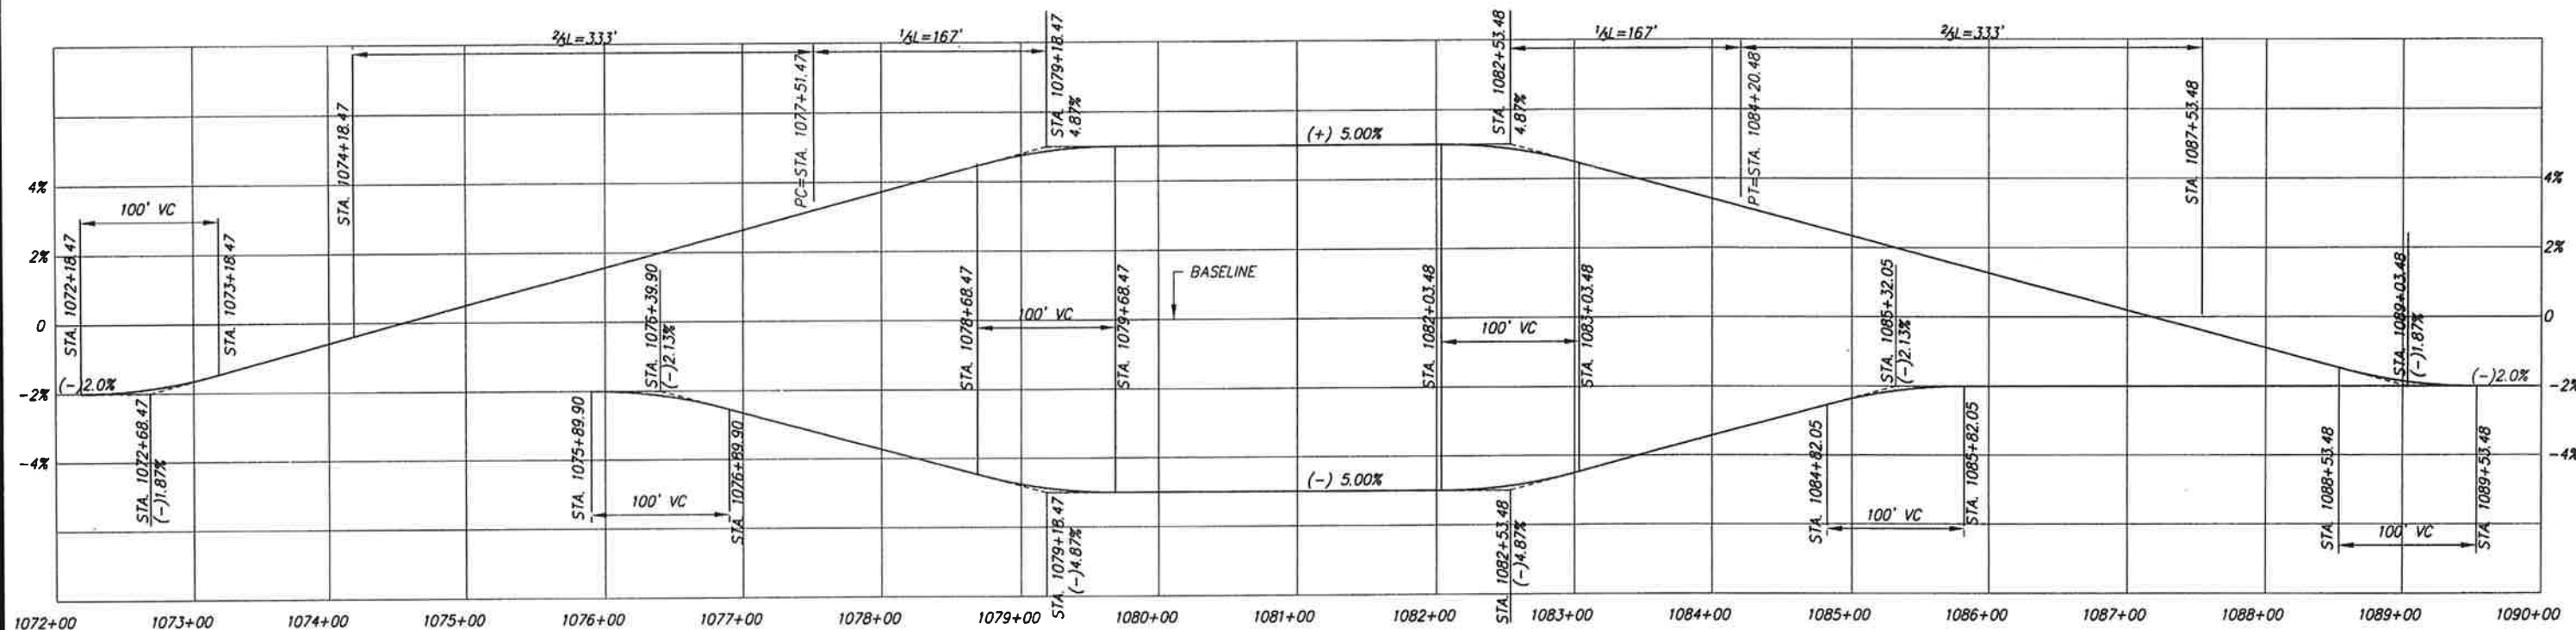

PC STA. 1077+51.47 TO PT STA. 1084+20.48

SCALE: HORIZ 1"=60'
VERT 1"=2%

Graphic Scales

1"=60' 60' 40' 20' 0 60' 120' (FEET)

1"=2% 2 1 0 2 4 (%)



This work was prepared by me or under my supervision. Exp. 04-30-10

Wesley R. Segura & Associates, Inc.

STATE OF HAWAII
DEPARTMENT OF TRANSPORTATION
HIGHWAYS DIVISION

SUPERELEVATION DIAGRAM

QUEEN KAAHUMANU HIGHWAY WIDENING
HENRY ST. to KEALAKEHE PKWY - PHASE I

Federal Aid Project No. NH-019-1(20)

Scale: As Shown Date: November 2009

SHEET No. 2 OF 2 SHEETS

AS-BUILT

38

SURVEY PLOTTED BY	DATE
DESIGNED BY	
TRACED BY	
QUANTITIES BY	
CHECKED BY	
ORIGINAL PLAN	
NOTE BOOK	
No.	