
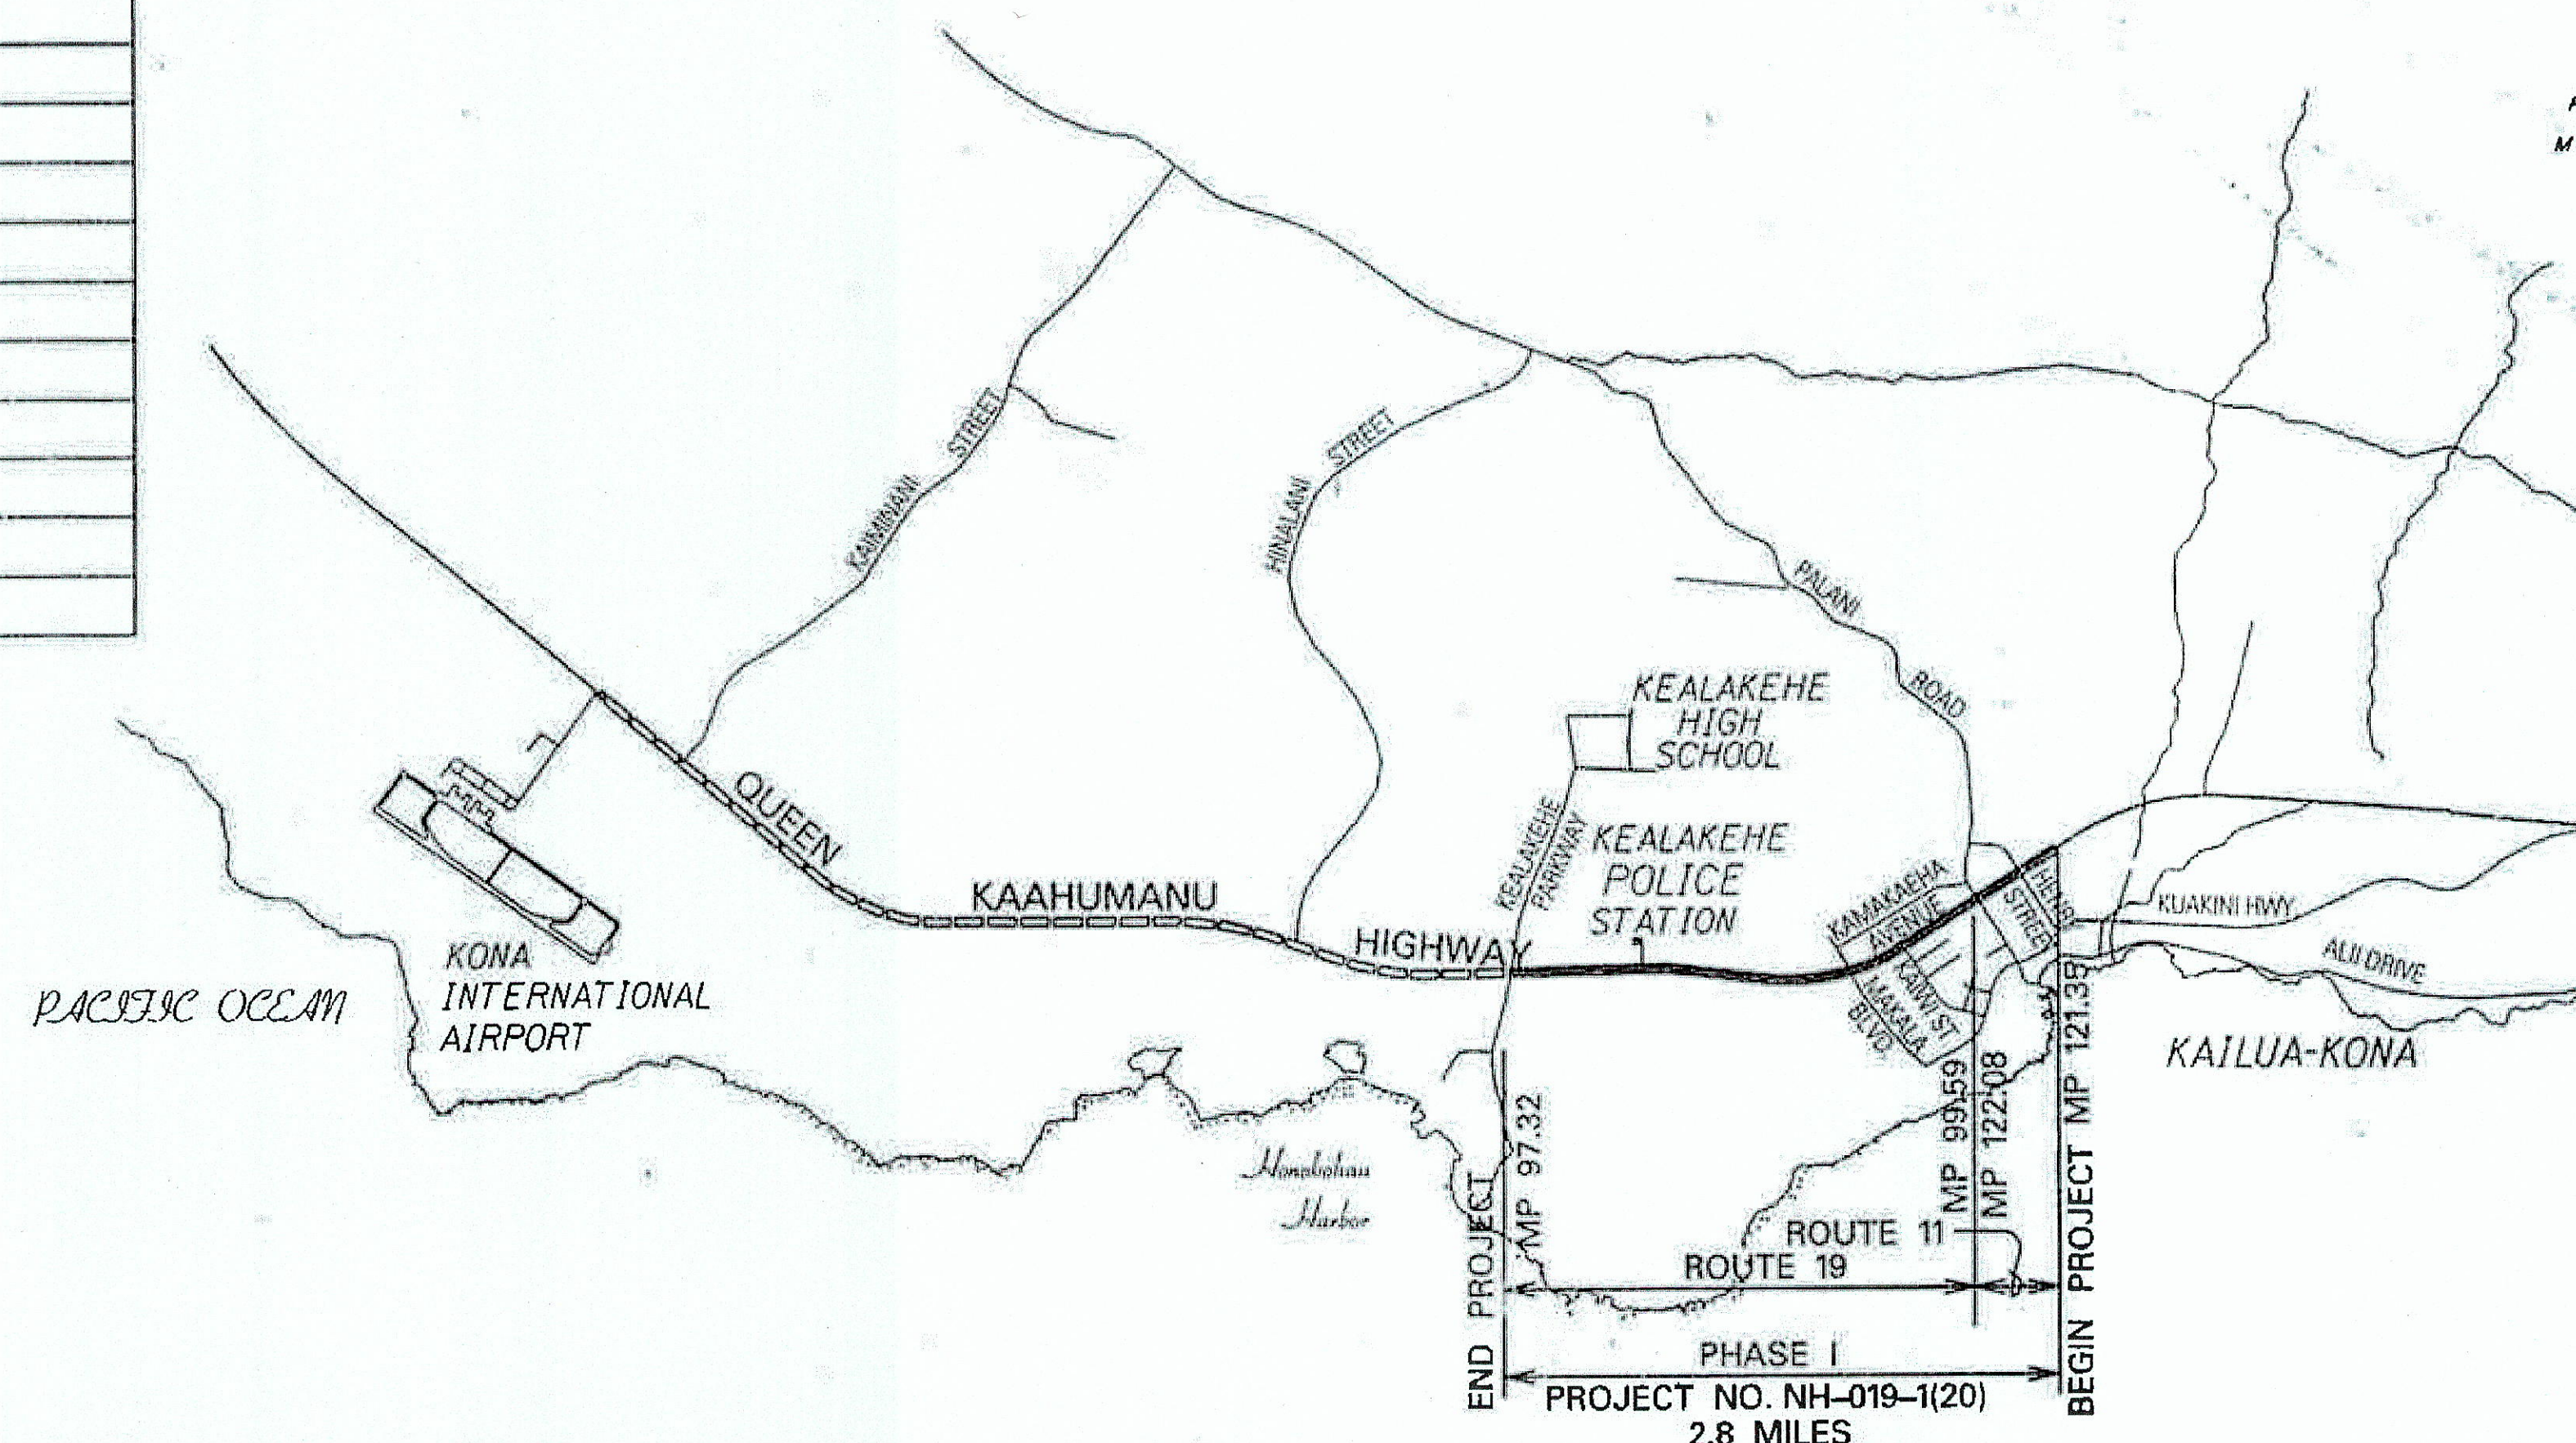
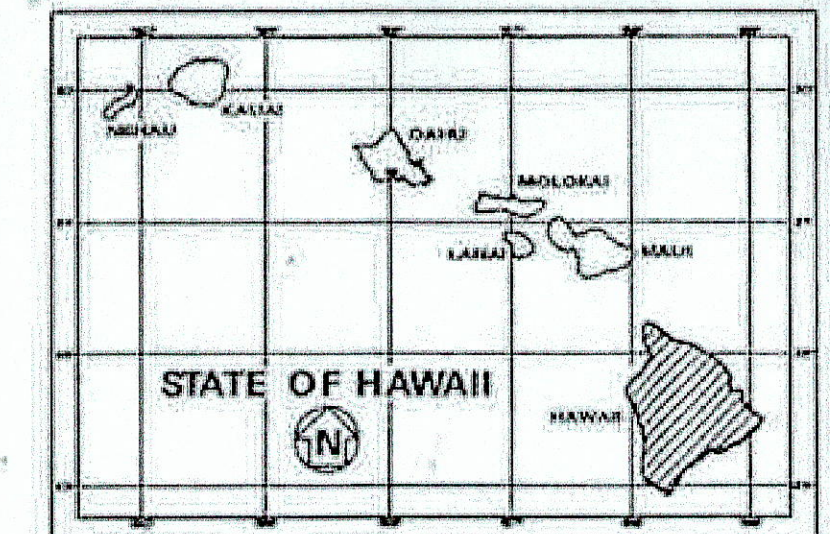


INDEX TO DRAWINGS	
SHEET NO.	DESCRIPTION
1	TITLE SHEET
2	STANDARD PLANS SUMMARY
3-5	GENERAL NOTES
6 - 7	WATER POLLUTION & EROSION CONTROL NOTES
8 - 17	TYPICAL SECTIONS
18 - 21	BASELINE DATA
22 - 36	ROADWAY PLAN & PROFILE
37 - 38	SUPERELEVATION DIAGRAM
39 - 41	INTERSECTION PROFILE
42 - 53	WATERLINE PLAN & PROFILE
54 - 57	WATERLINE DETAILS
58 - 71	DRAINAGE PLAN & PROFILE
72 - 89	CATCH BASINS AND CULVERTS PLAN, SECTION AND PROFILE
90 - 92	DRYWELL DETAILS
93 - 105	INTERSECTION PLANS
106 - 111	CURB RAMP DETAILS
112	PEDESTRIAN PUSH BUTTON DETAILS
113	DETECTABLE WARNING DETAILS
114	PAVEMENT MARKERS LEGEND AND NOTES
115 - 129	STRIPING PLAN
130 - 133	DESTINATION SIGNS NOTES & MISCELLANEOUS DETAILS
134 - 137	SIGN SCHEDULE
138 - 146	TRAFFIC CONTROL PLAN
147 - 148	GUARDRAIL DETAILS & NOTES
149	STRONG POST W-BEAM GUARDAIL
150	FLEAT-350
151 - 223	STRONG POST W-BEAM GUARDAIL
224 - 225	CROSS SECTION QUANTITIES
226 - 234	STRUCTURAL PLANS
235 - 251	LANDSCAPING PLANS
252 - 315	ELECTRICAL PLANS

STATE OF HAWAII
DEPARTMENT OF TRANSPORTATION
HIGHWAYS DIVISION
HONOLULU, HAWAII
"AS-BUILT"
PLANS FOR
QUEEN KAAHUMANU HIGHWAY WIDENING
PHASE I
HENRY STREET TO KEALAKEHE PARKWAY
FEDERAL AID PROJECT NO. NH-019-01 (20)
DISTRICT OF NORTH KONA
ISLAND OF HAWAII

FED. ROAD DIST. NO.	STATE	FED. AID PROJ. NO.	FISCAL YEAR	SHEET NO.	TOTAL SHEETS
HAWAII	HAW.	NH-019-01(20)	2005	1	315

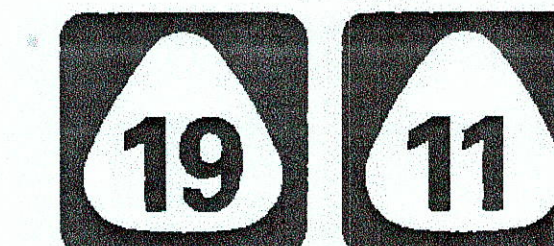

LOCATION PLAN

DESIGN DESIGNATION

ADT (2005).....	28,400
DESIGN ADT (2025)	44,100
DHV	4,000
D	65/35
T ₂₄	5.0%
V	50 MPH (Kailua to Makala Blvd)
	70 MPH (Makala Blvd to Keahole)

APPROVED

DATE

MANAGER, DEPARTMENT OF WATER SUPPLY
COUNTY OF HAWAII

DEPARTMENT OF TRANSPORTATION STATE OF HAWAII	
APPROVED:	
DIR. OF TRANSPORTATION	DATE

WESLEY R. SEGAWA
 & ASSOCIATES, INC.
 DESIGNED BY
 STERLING CHOW
 P. S. & E. BY
 933-8866
 NOV. 2009
 DATE

CHANGES MADE DURING CONSTRUCTION HAVE BEEN
INCORPORATED ON THESE PLANS EXCEPT CHANGES
IN THE ORIGINAL THEORETICAL QUANTITIES. FOR
ACTUAL QUANTITIES, REFER TO PROJECT LEDGER
AND/OR COMPUTATION BOOK.

RESIDENT ENGINEER
 6/29/20
 DATE