

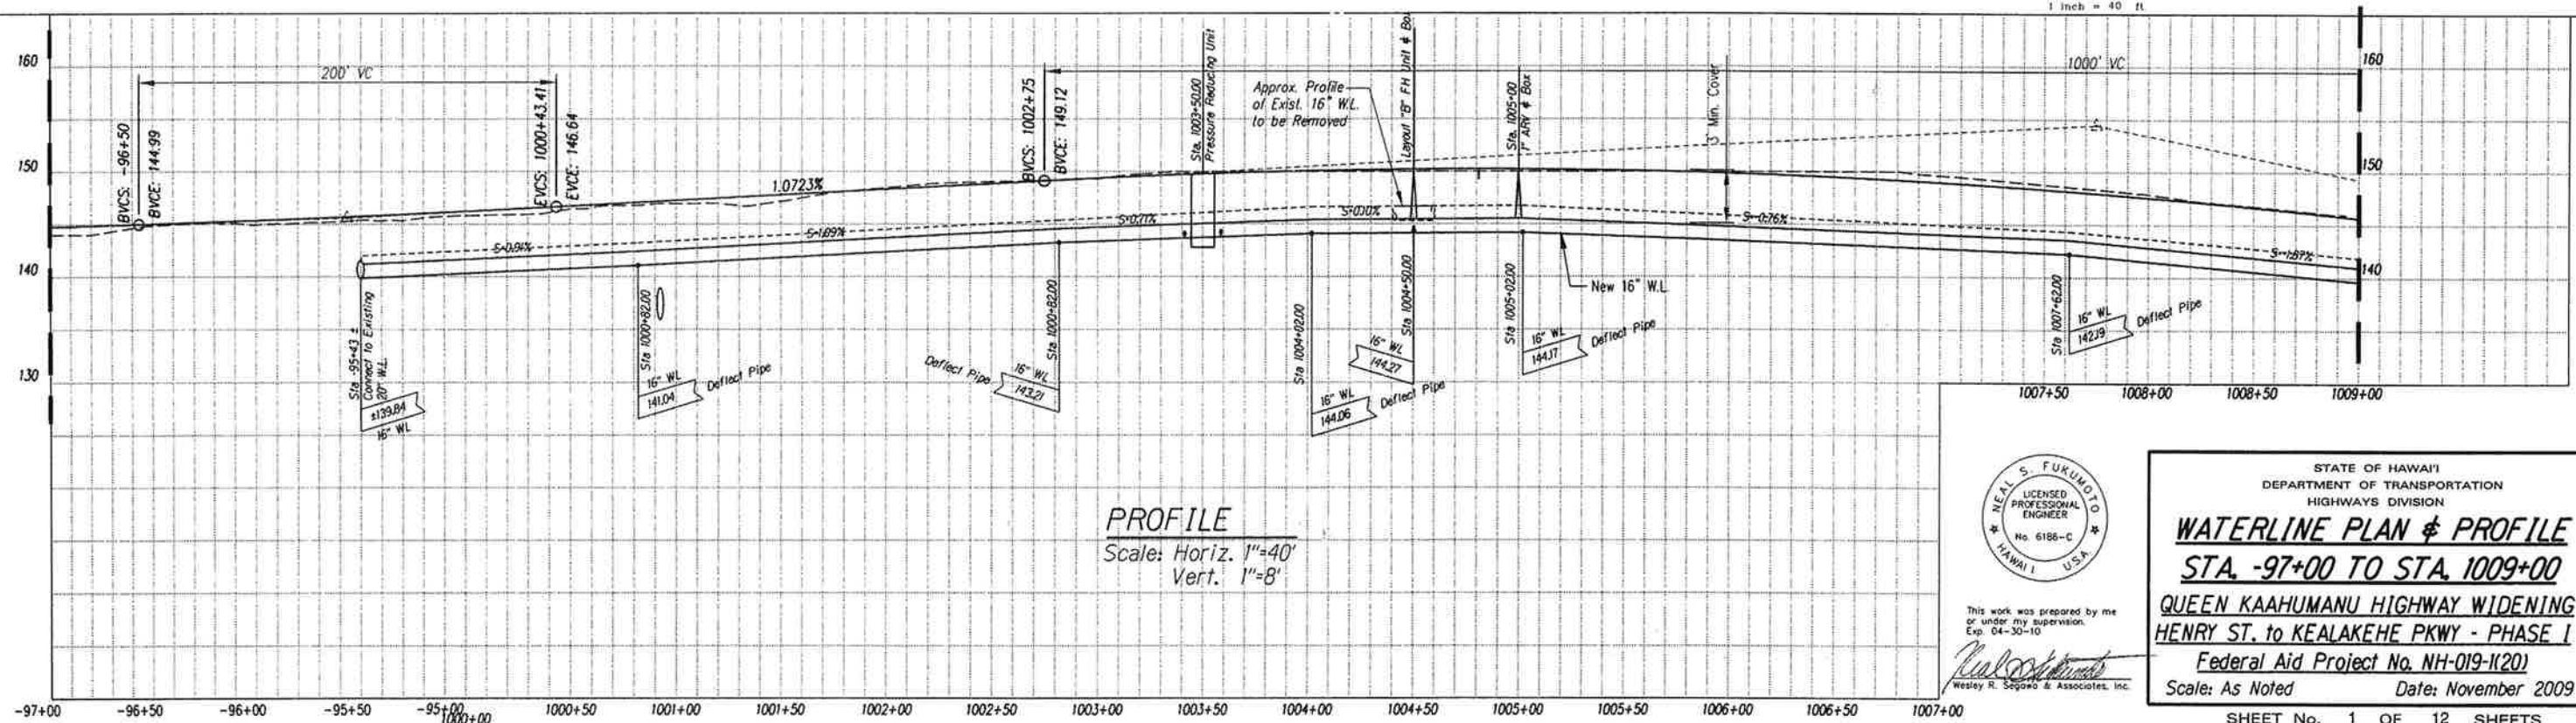
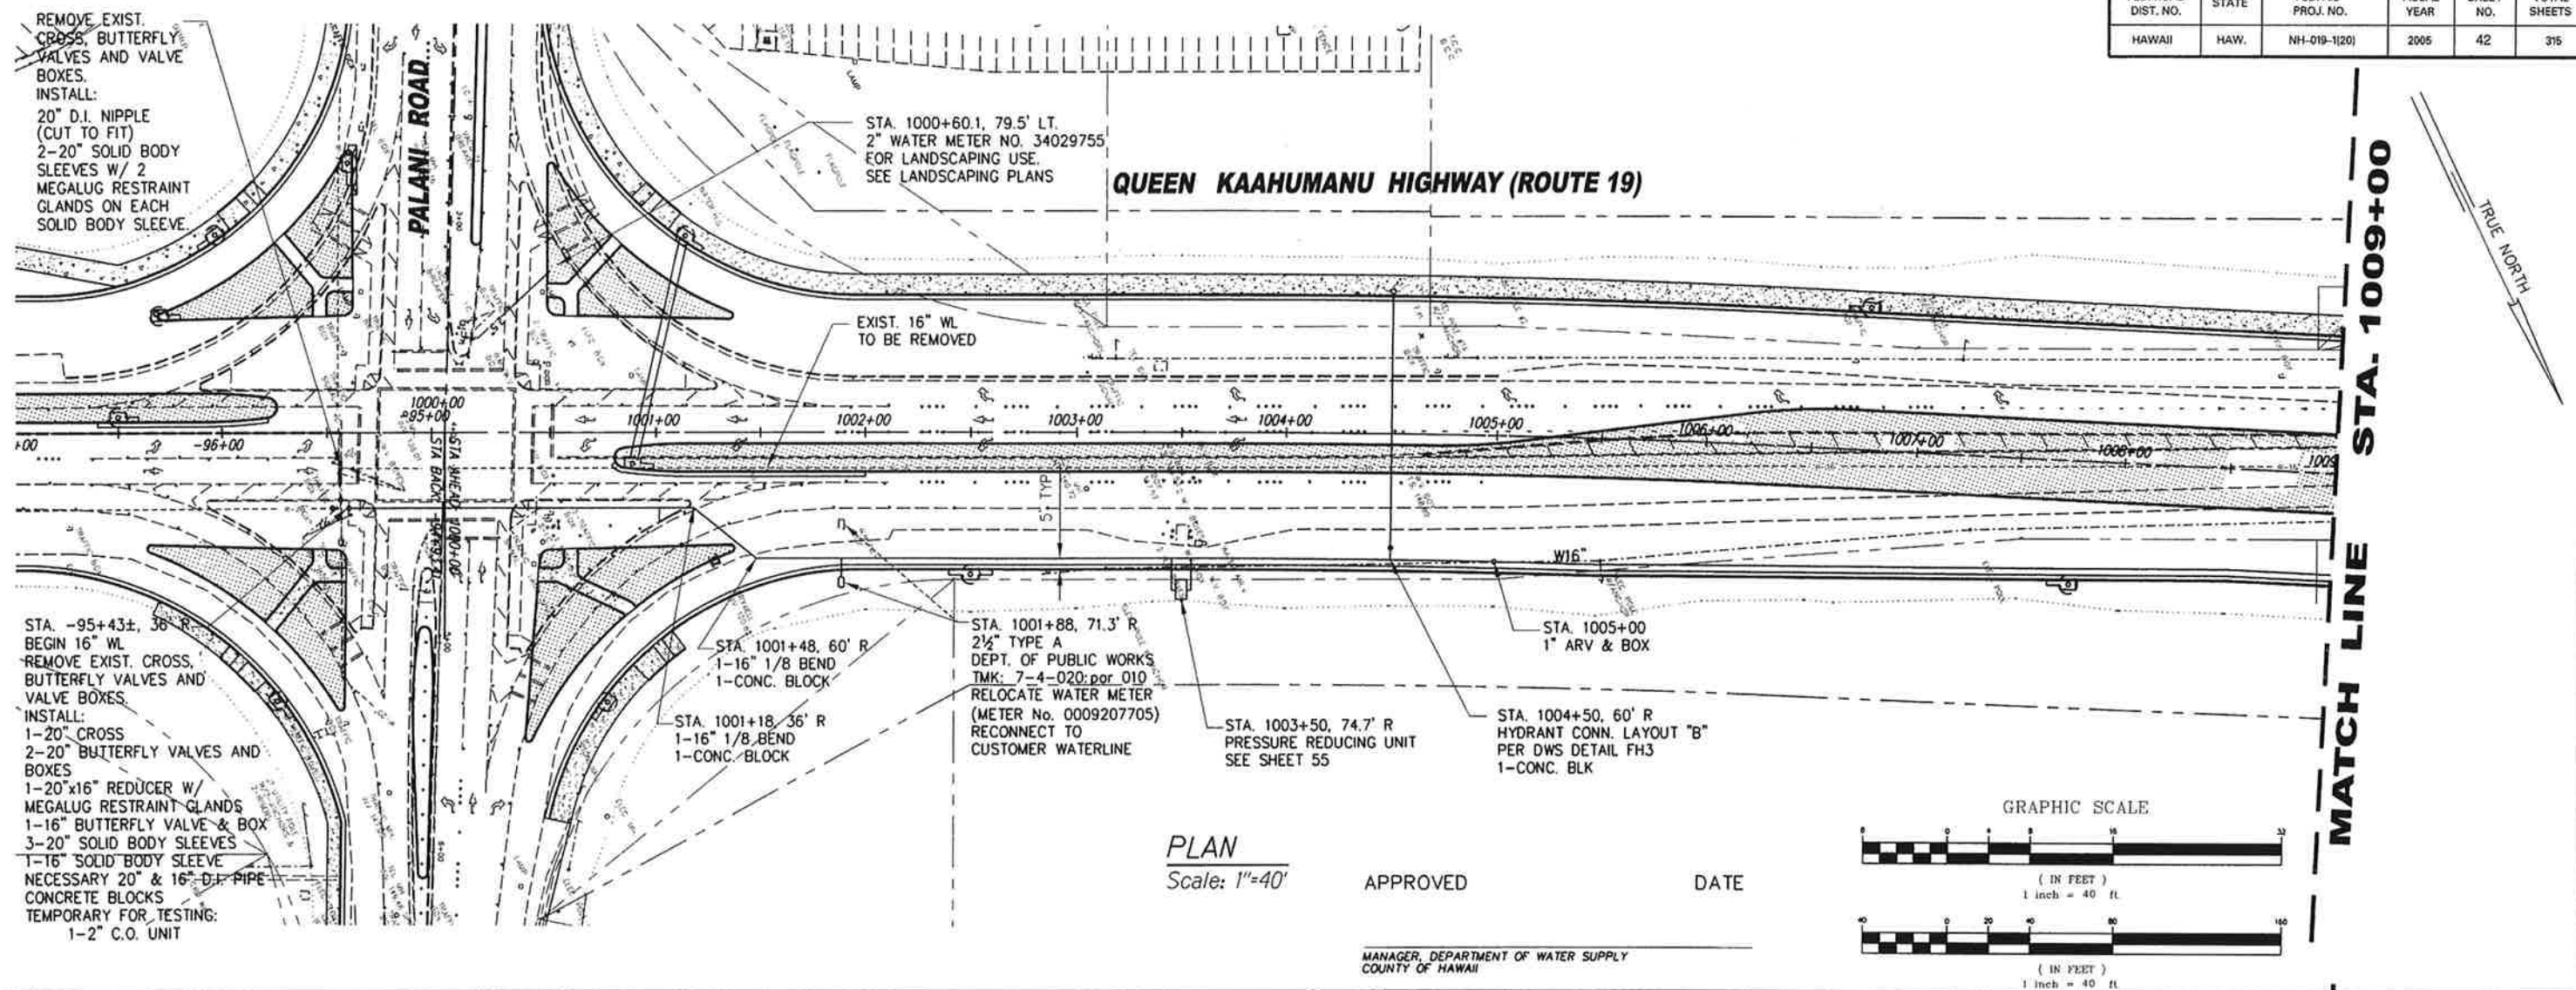
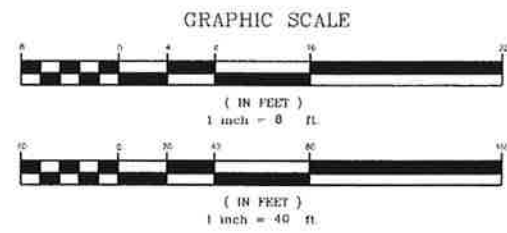


FED. ROAD DIST. NO.	STATE	FED. AID PROJ. NO.	FISCAL YEAR	SHEET NO.	TOTAL SHEETS
HAWAII	HAW.	NH-019-1(20)	2005	42	315

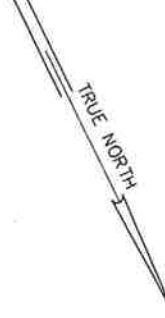


AS-BUILT

FED. ROAD DIST. NO.	STATE	FED. AID PROJ. NO.	FISCAL YEAR	SHEET NO.	TOTAL SHEETS
HAWAII	HAW.	NH-019-1(20)	2005	43	315

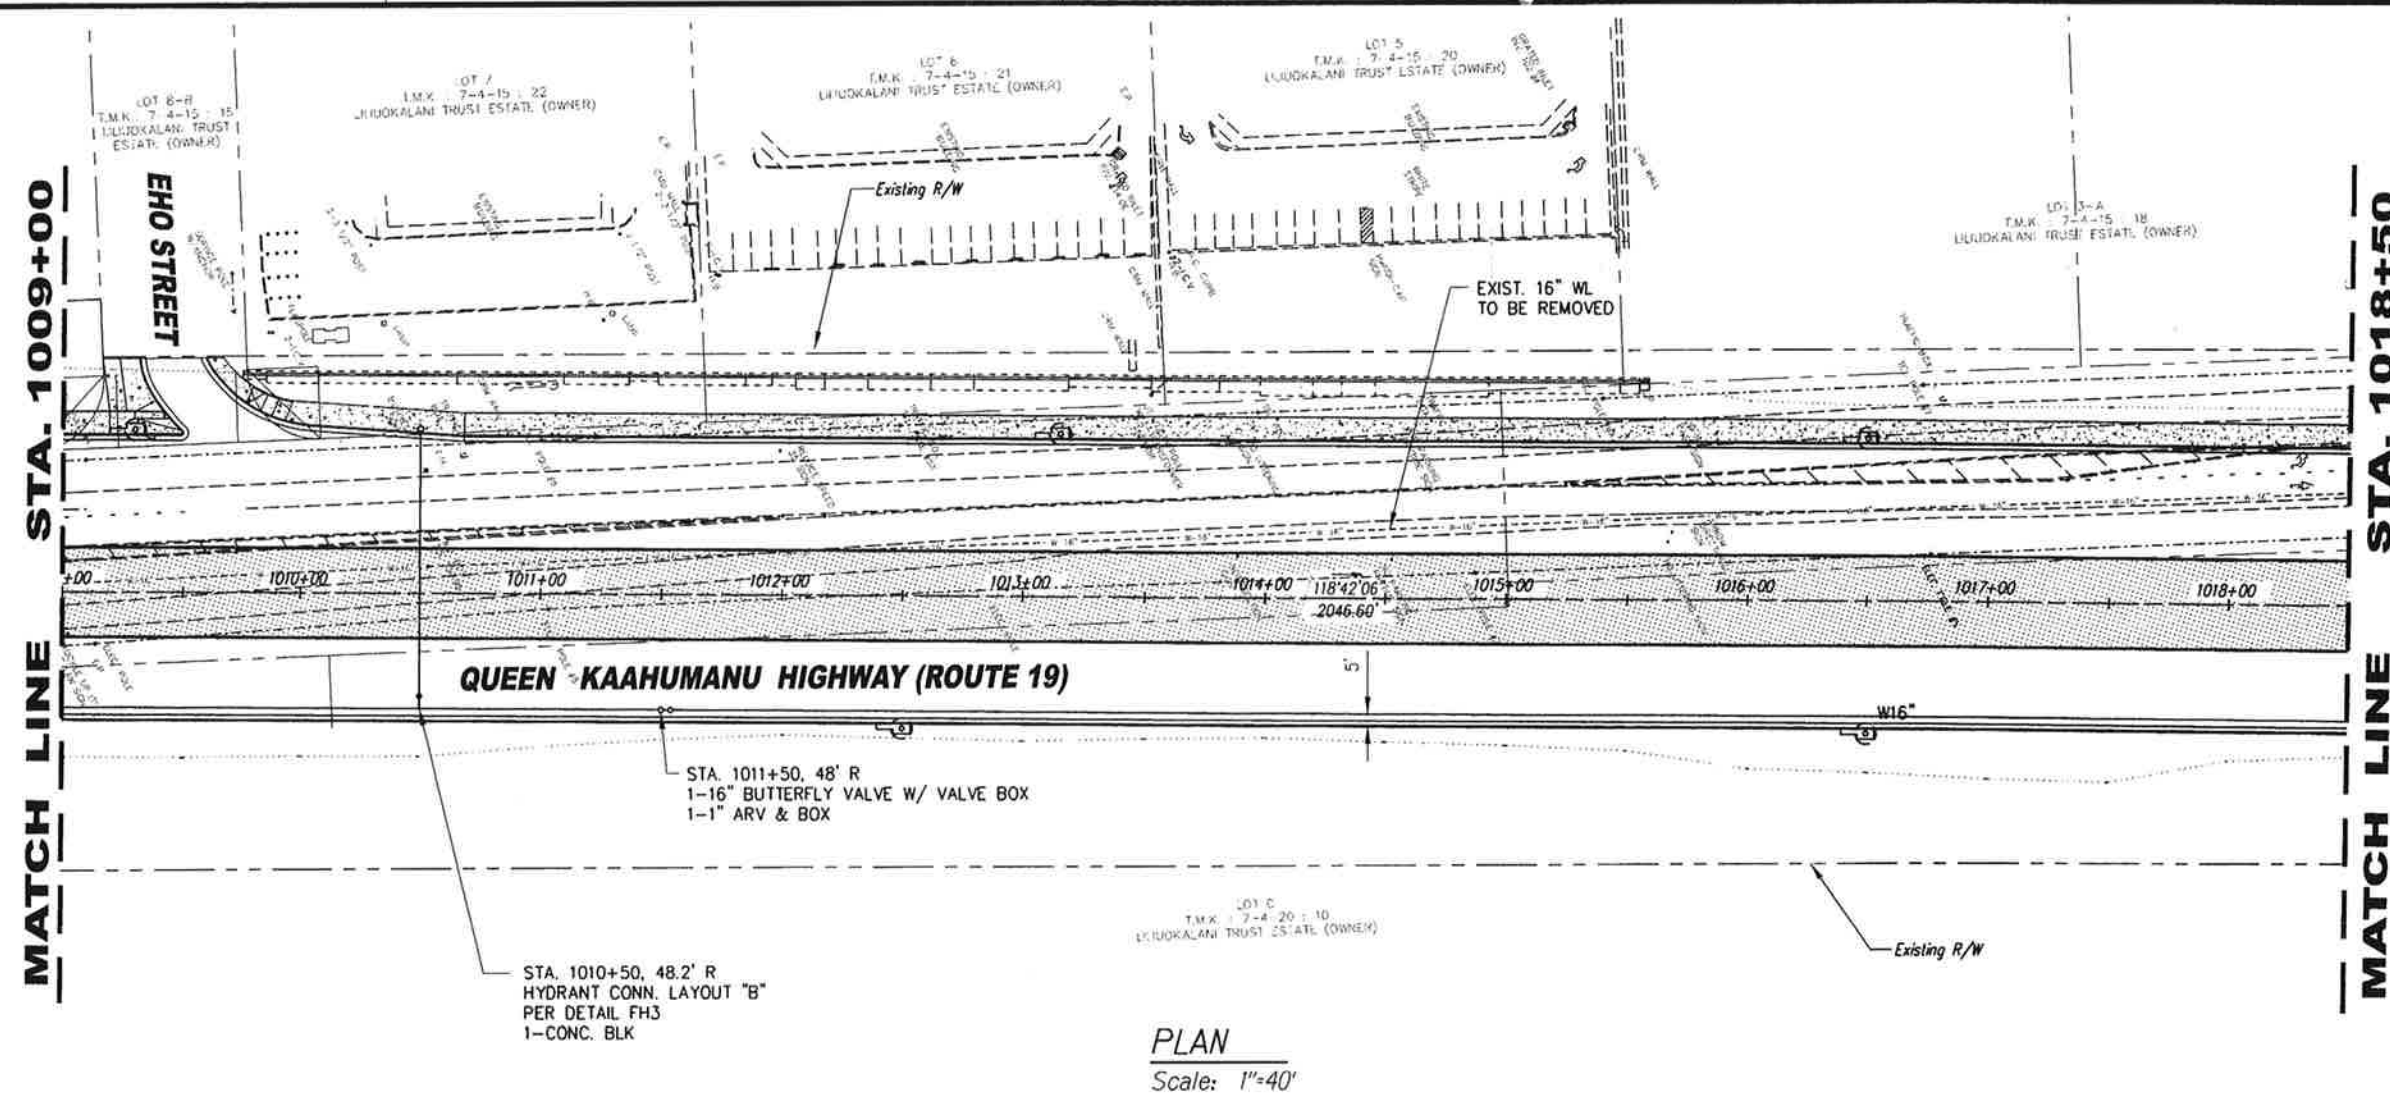

PLAN
Scale: 1"=40'

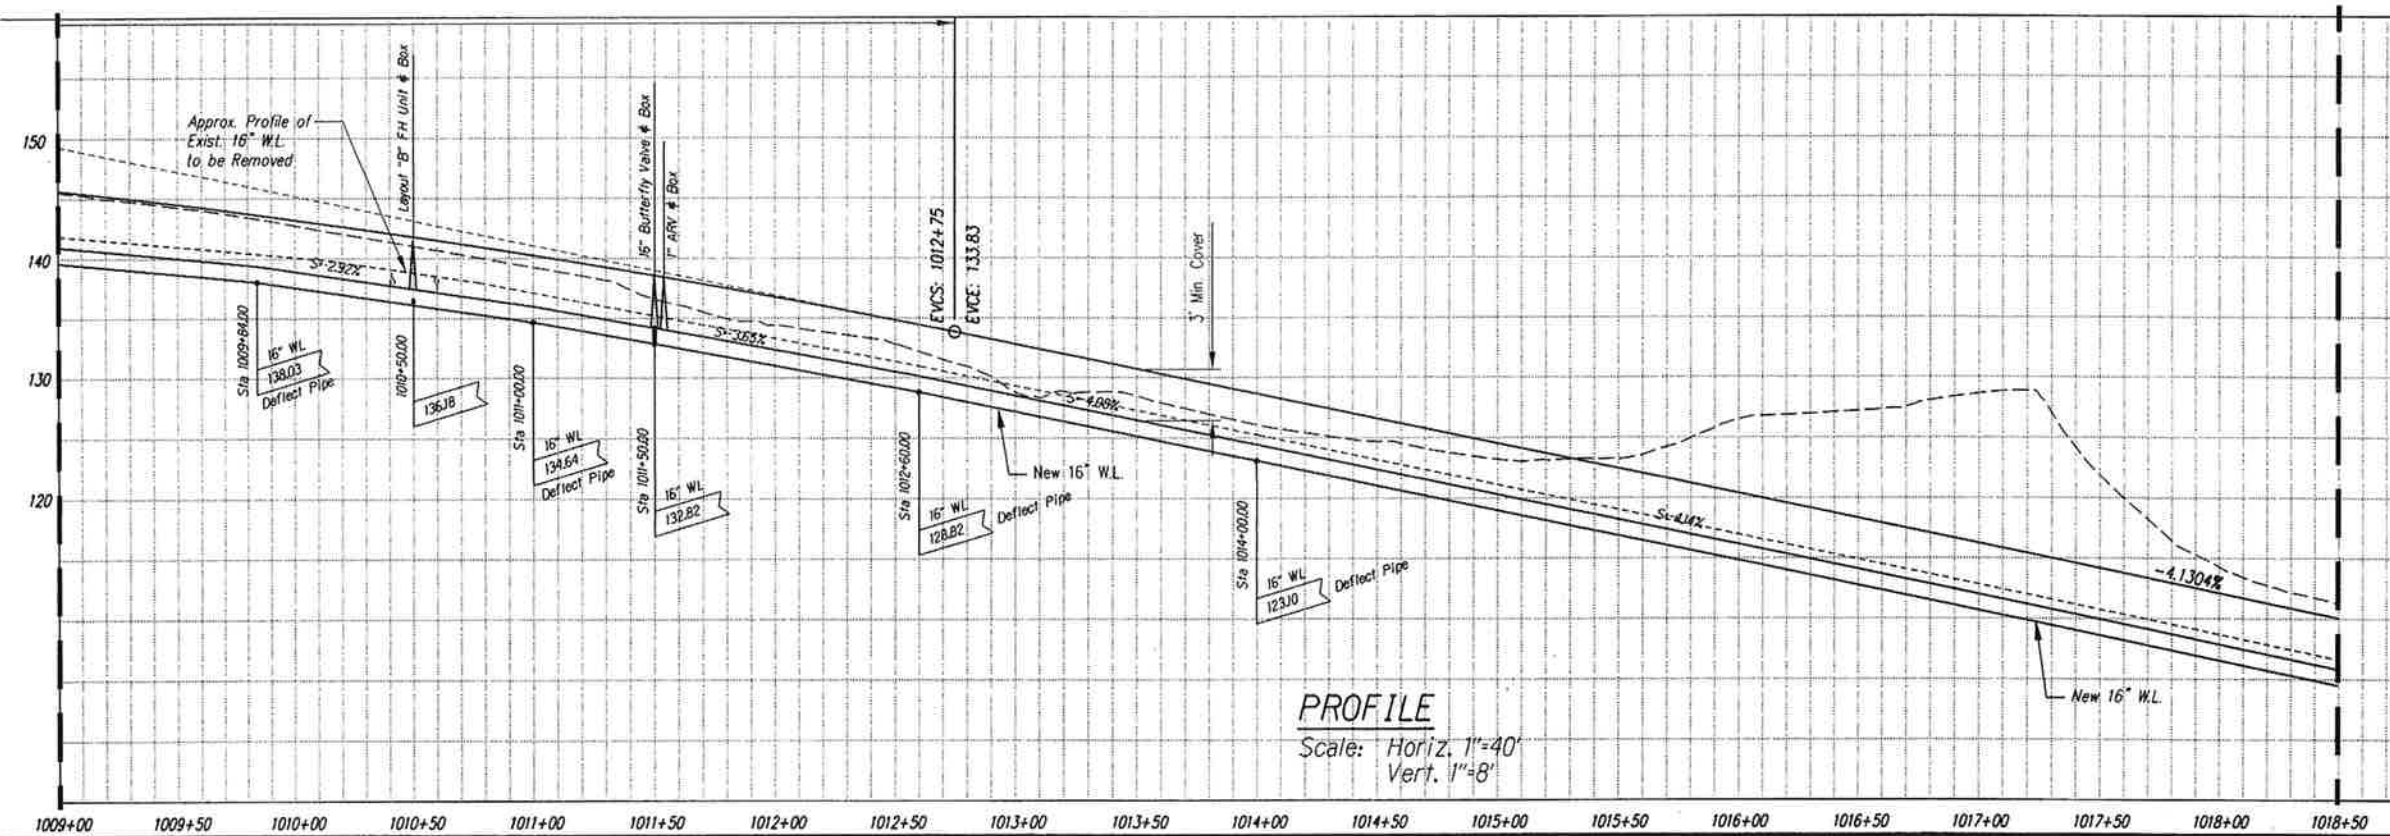

PROFILE
Scale: Horiz. 1"=40'
Vert. 1"=8'







This work was prepared by me or under my supervision.
Exp. 04-30-10
Neal S. Fukunaga
Wesley R. Segawa & Associates, Inc.

STATE OF HAWAII
DEPARTMENT OF TRANSPORTATION
HIGHWAYS DIVISION

WATERLINE PLAN & PROFILE
STA. 1009+00 TO STA. 1018+50
QUEEN KAAHUMANU HIGHWAY WIDENING
HENRY ST. to KEALAKEHE PKWY - PHASE I
Federal Aid Project No. NH-019-1(20)
Scale: As Noted Date: November 2009

DATE	_____
DESIGNED BY	_____
CHECKED BY	_____
NOTED BY	_____
QUANTITIES BY	_____
ORIGINAL PLAN	_____
TRACED BY	_____
DATE	_____

FED. ROAD DIST. NO.	STATE	FED. AID PROJ. NO.	FISCAL YEAR	SHEET NO.	TOTAL SHEETS
HAWAII	HAW.	NH-019-1(20)	2005	44	315

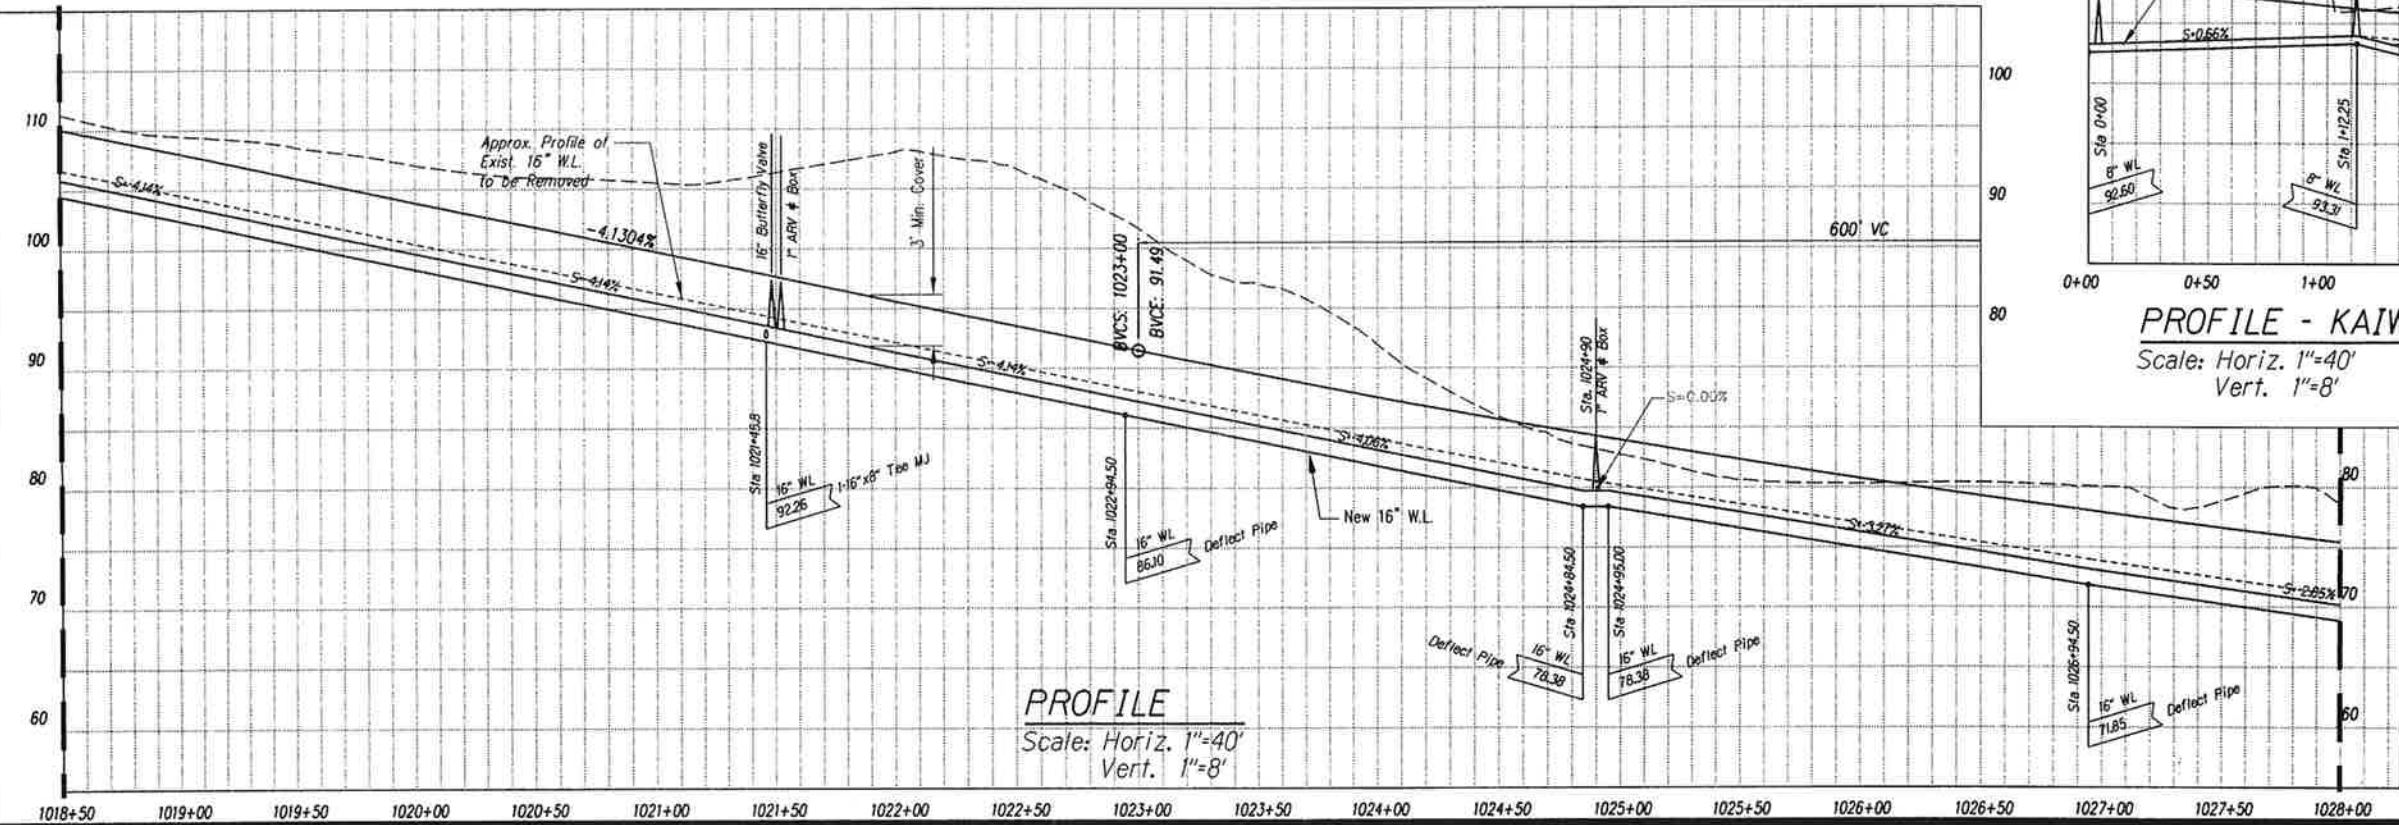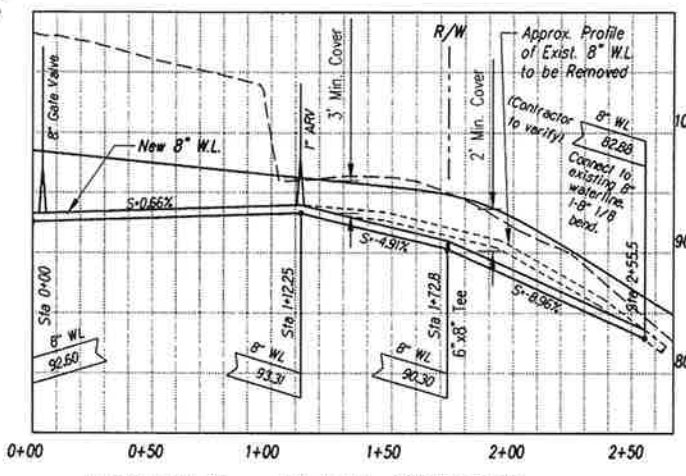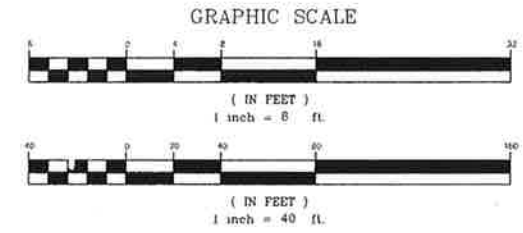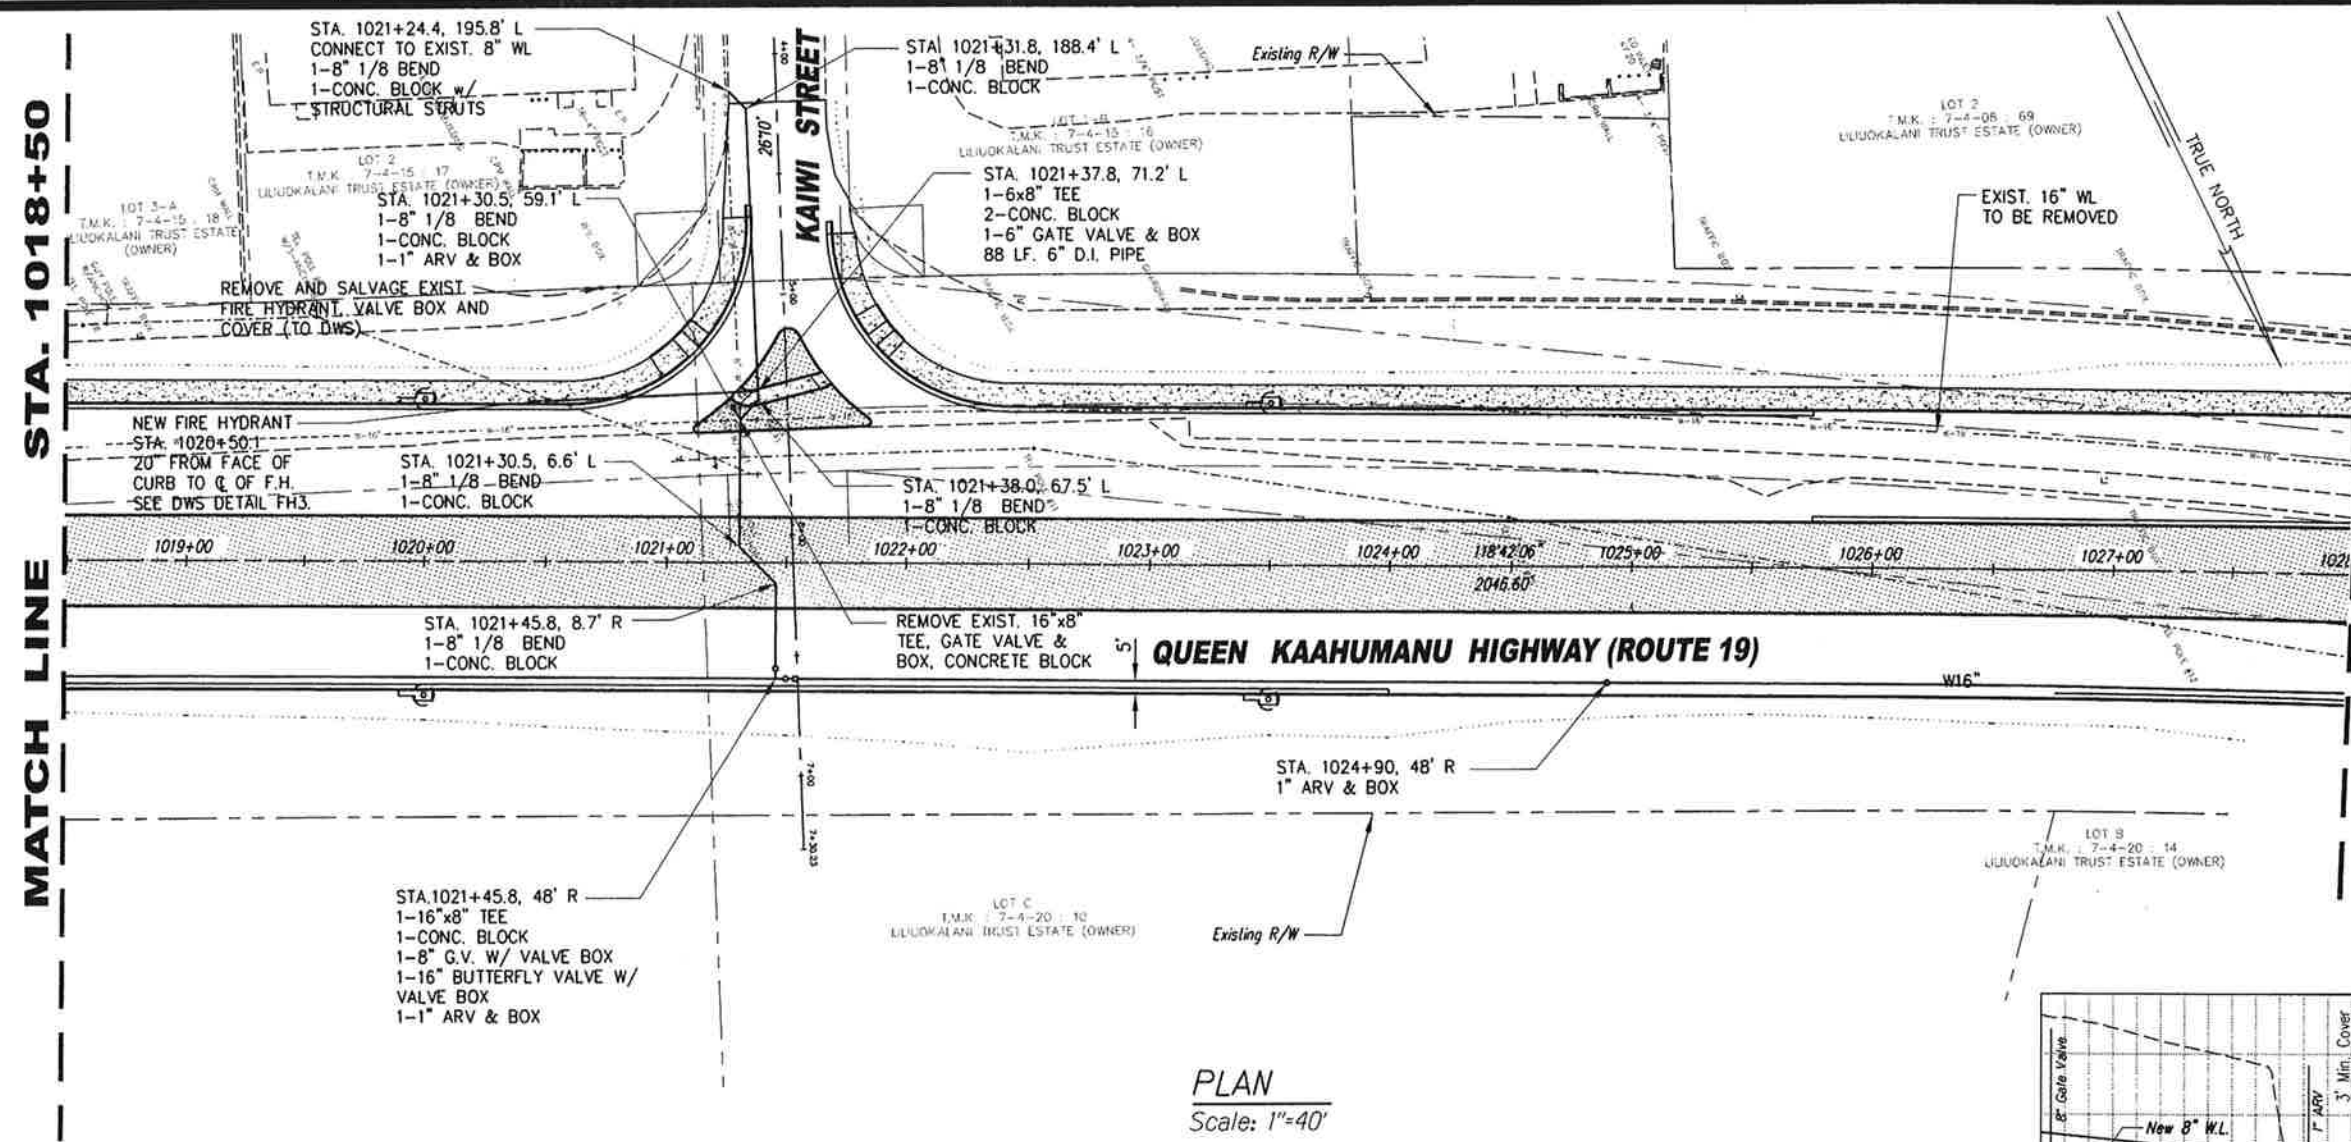

This work was prepared by me or under my supervision.
Exp. 04-30-10
Wesley R. Segawa & Associates, Inc.

STATE OF HAWAII
DEPARTMENT OF TRANSPORTATION
HIGHWAYS DIVISION


WATERLINE PLAN & PROFILE
STA. 1018+50 TO STA. 1028+00
QUEEN KAAHUMANU HIGHWAY WIDENING
HENRY ST. to KEALAKEHE PKWY - PHASE I
Federal Aid Project No. NH-019-1(20)
Scale: As Noted Date: November 2009

SHEET No. 3 OF 12 SHEETS



AS-BUILT

DESIGNED BY	DATE
CHECKED BY	
NOTED BY	
QUANTITIES BY	
TRACED BY	
DRAWN BY	
ORIGINAL PLAN	

FED. ROAD DIST. NO.	STATE	FED. AID PROJ. NO.	FISCAL YEAR	SHEET NO.	TOTAL SHEETS
HAWAII	HAW.	NH-019-1(20)	2005	45	315

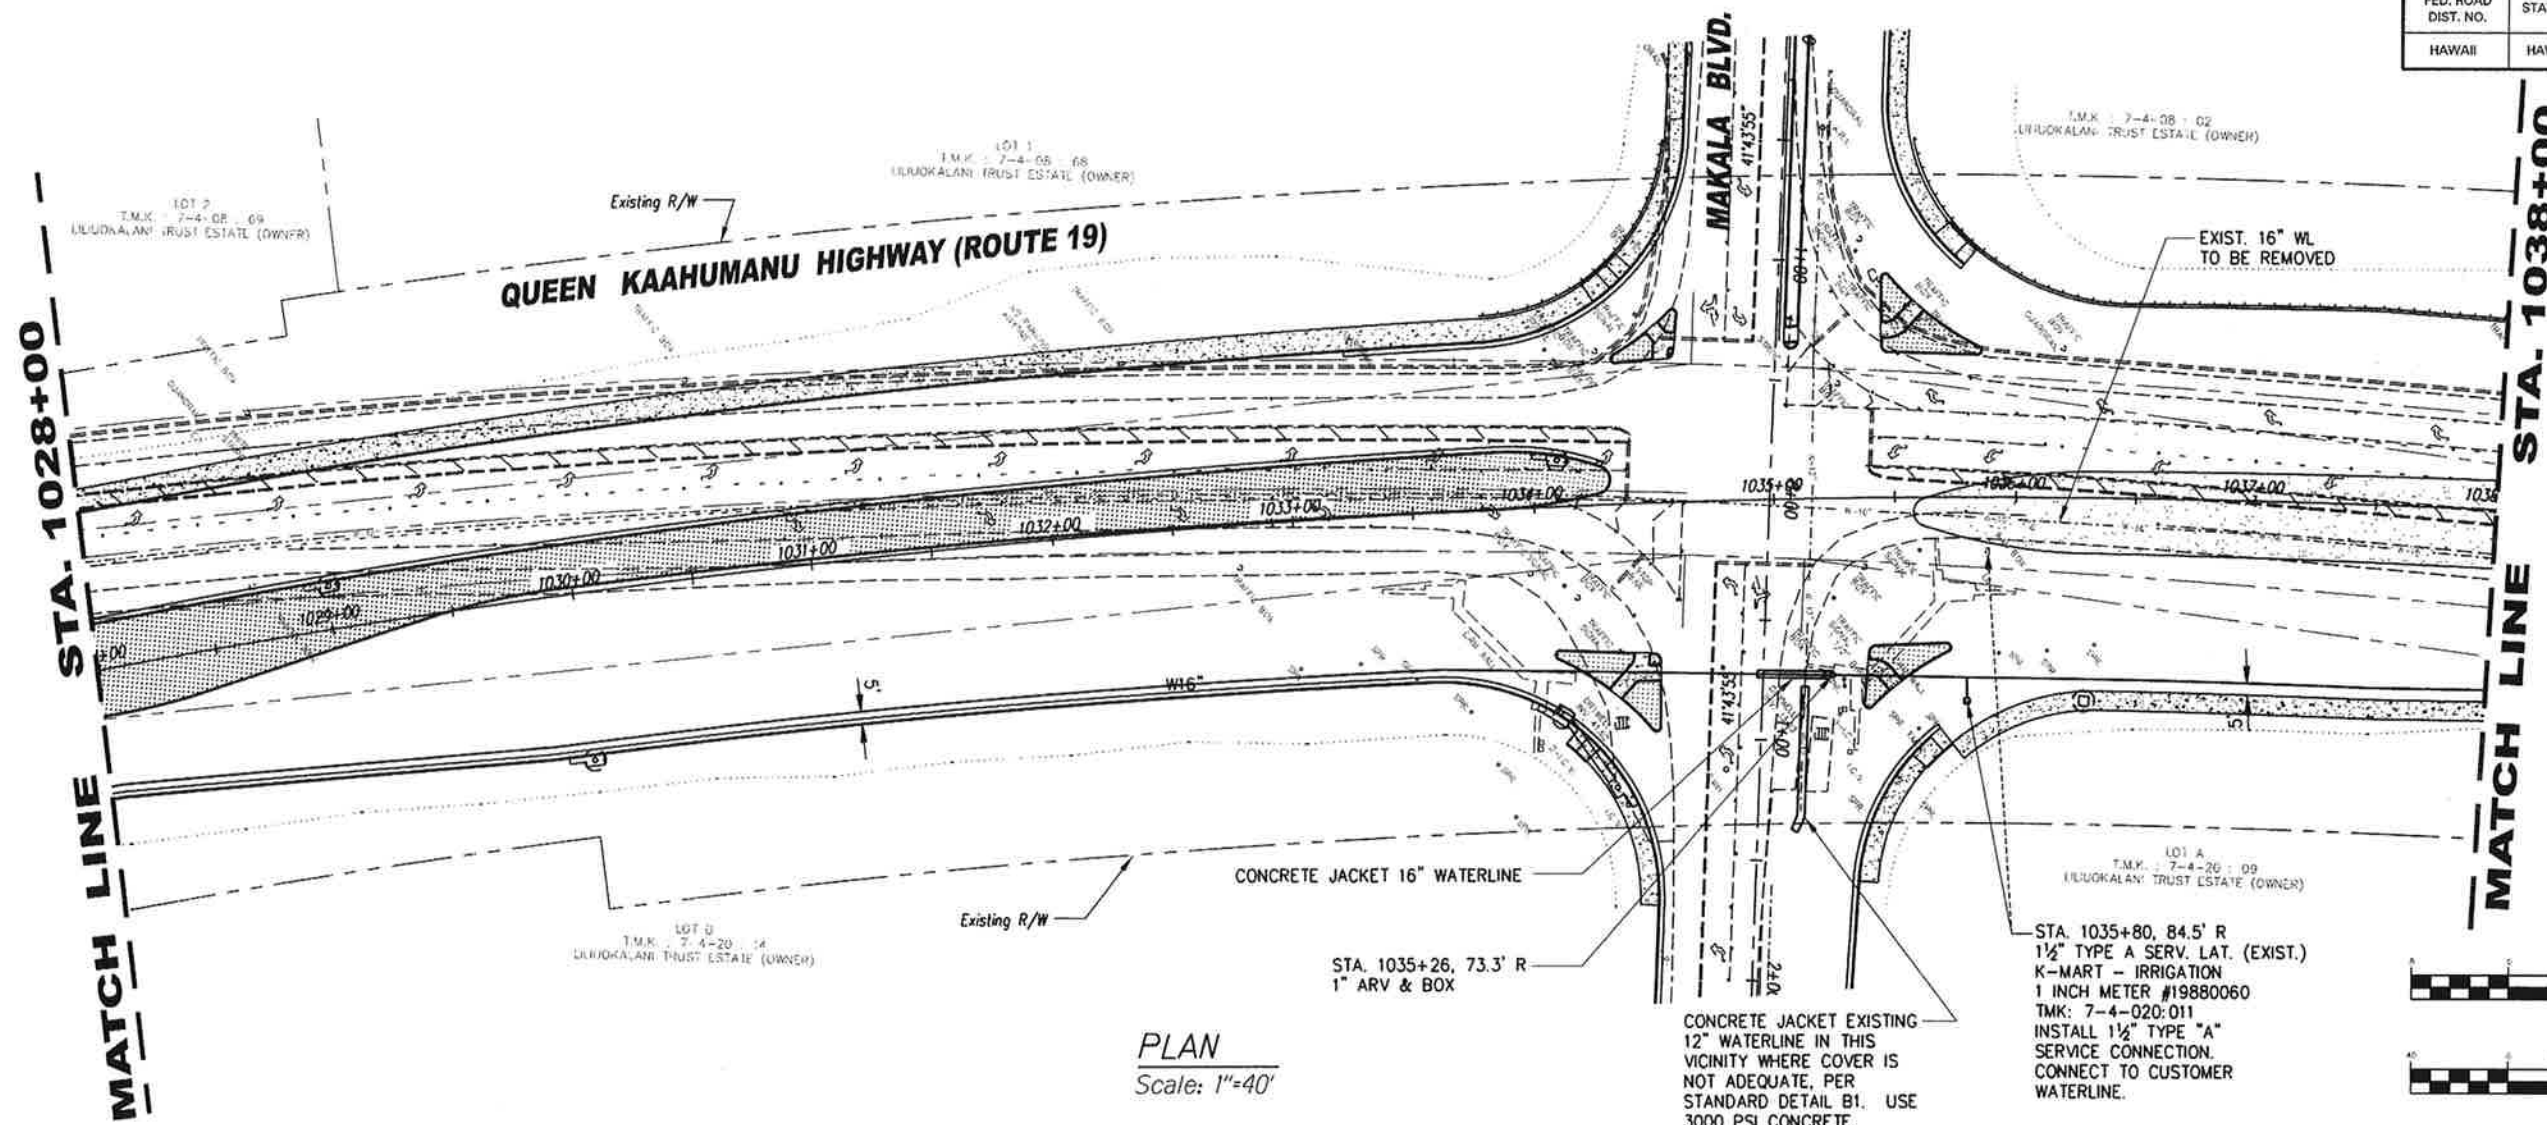

PLAN
Scale: 1"=40'

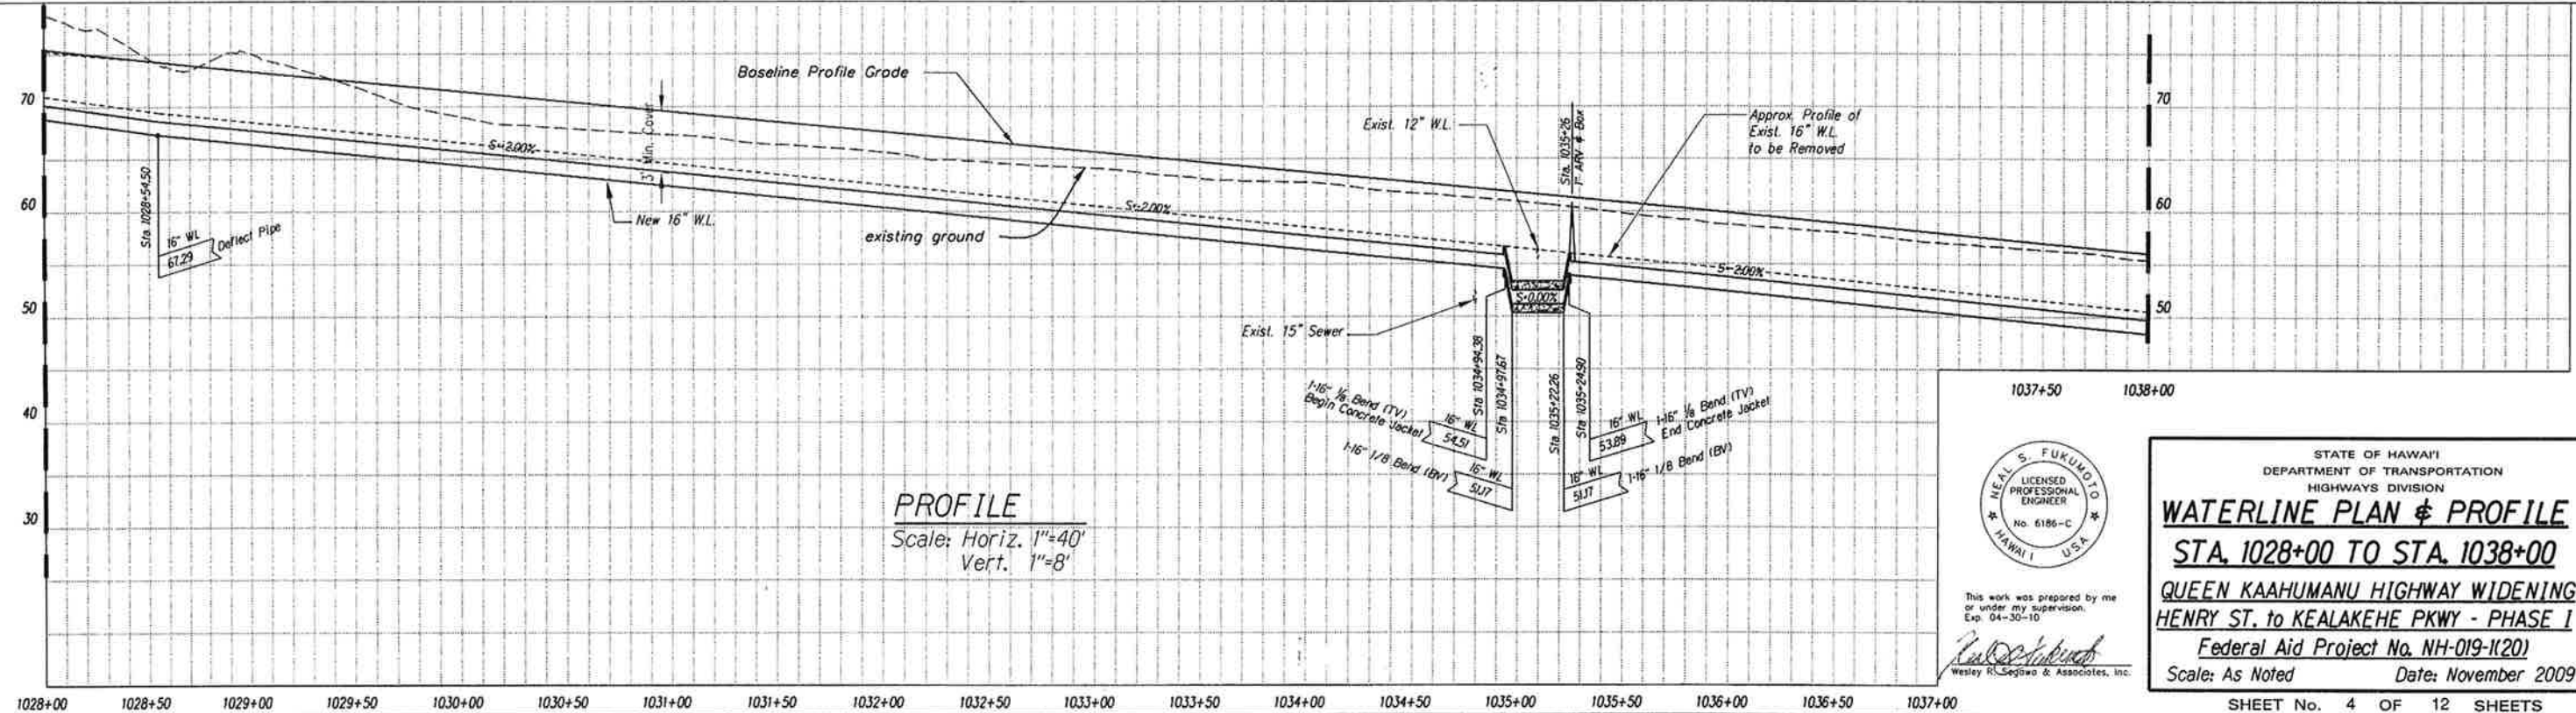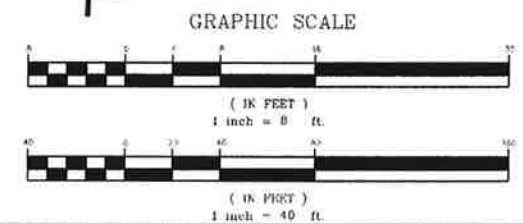

PROFILE
Scale: Horiz. 1"=40'
Vert. 1"=8'



This work was prepared by me or under my supervision.
Exp. 04-30-10
Neal S. Fukumoto
Wesley R. Segovia & Associates, Inc.



STATE OF HAWAII
DEPARTMENT OF TRANSPORTATION
HIGHWAYS DIVISION

WATERLINE PLAN & PROFILE
STA. 1028+00 TO STA. 1038+00
QUEEN KAAHUMANU HIGHWAY WIDENING
HENRY ST. to KEALAKEHE PKWY - PHASE I
Federal Aid Project No. NH-019-1(20)
Scale: As Noted Date: November 2009

SURVEY PLOTTED BY	DATE
DESIGNED BY	
NOTED BY	
CHECKED BY	

AS-BUILT

FED. ROAD DIST. NO.	STATE	FED. AID PROJ. NO.	FISCAL YEAR	SHEET NO.	TOTAL SHEETS
HAWAII	HAW.	NH-019-1(20)	2005	46	315

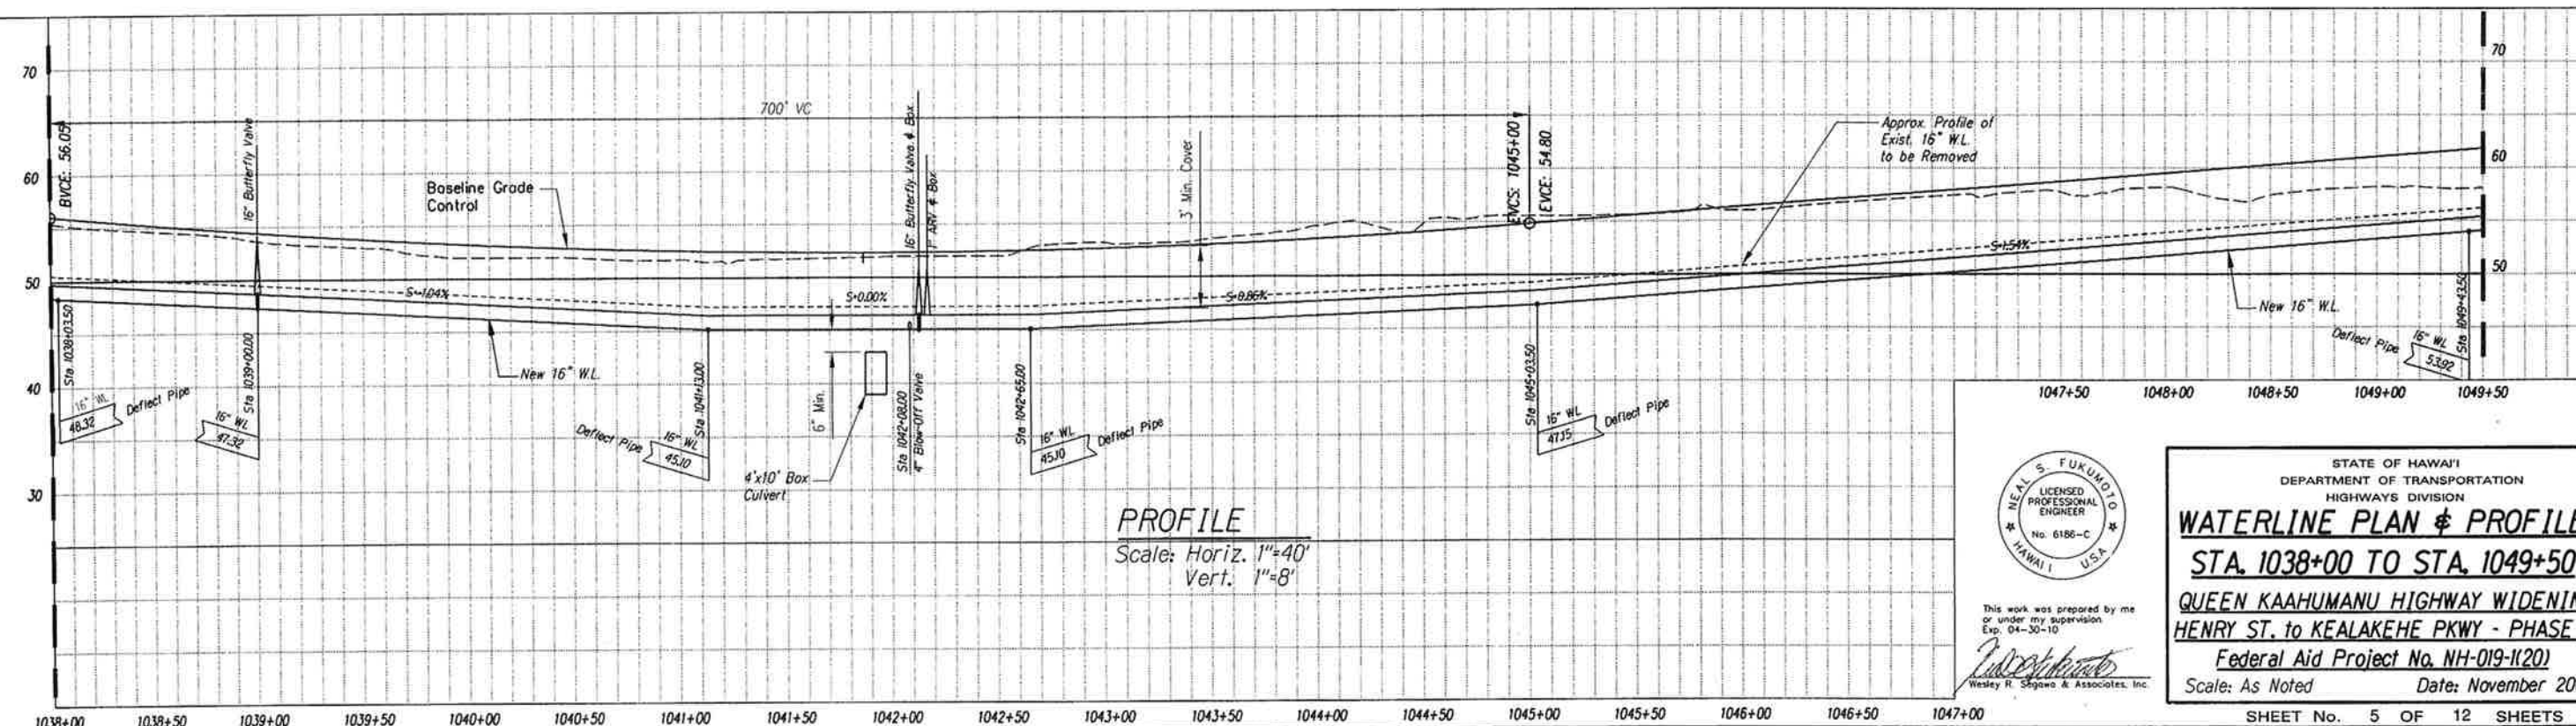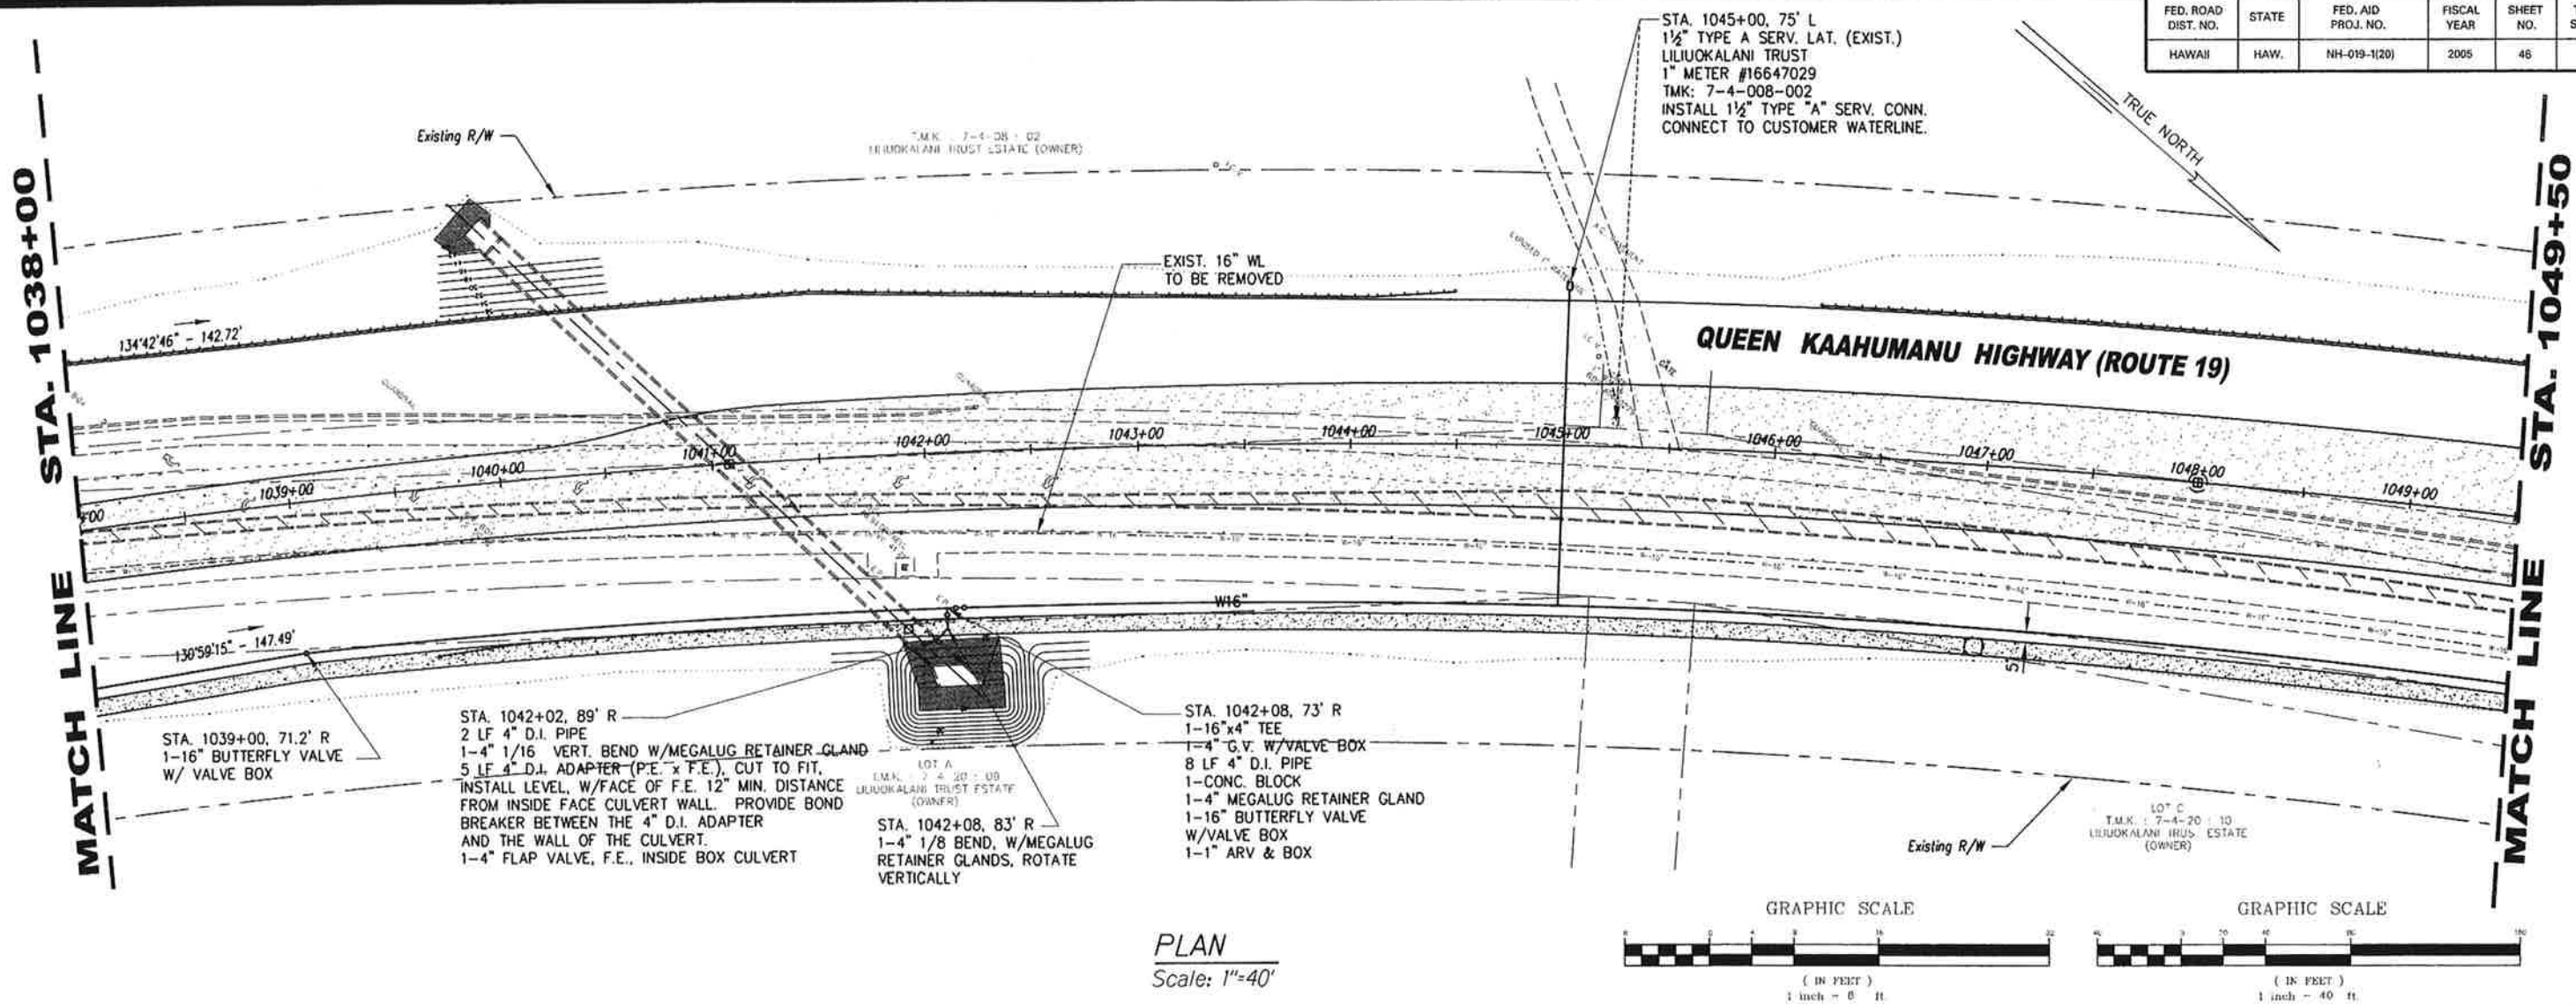

DATE	_____
SURVEY PLOTTED BY	_____
DRAWN BY	_____
DESIGNED BY	_____
NOTE BOOK	_____
CHECKED BY	_____




This work was prepared by me or under my supervision
Exp. 04-30-10
Neil S. Fukumoto
Wesley R. Segawa & Associates, Inc.



STATE OF HAWAII
DEPARTMENT OF TRANSPORTATION
HIGHWAYS DIVISION
WATERLINE PLAN & PROFILE
STA. 1038+00 TO STA. 1049+50
QUEEN KAAHUMANU HIGHWAY WIDENING
HENRY ST. to KEALAKEHE PKWY - PHASE I
Federal Aid Project No. NH-019-1(20)
Scale: As Noted Date: November 2009

AS-BUILT

FED. ROAD DIST. NO.	STATE	FED. AID PROJ. NO.	FISCAL YEAR	SHEET NO.	TOTAL SHEETS
HAWAII	HAW.	NH-019-1120	2005	47	315

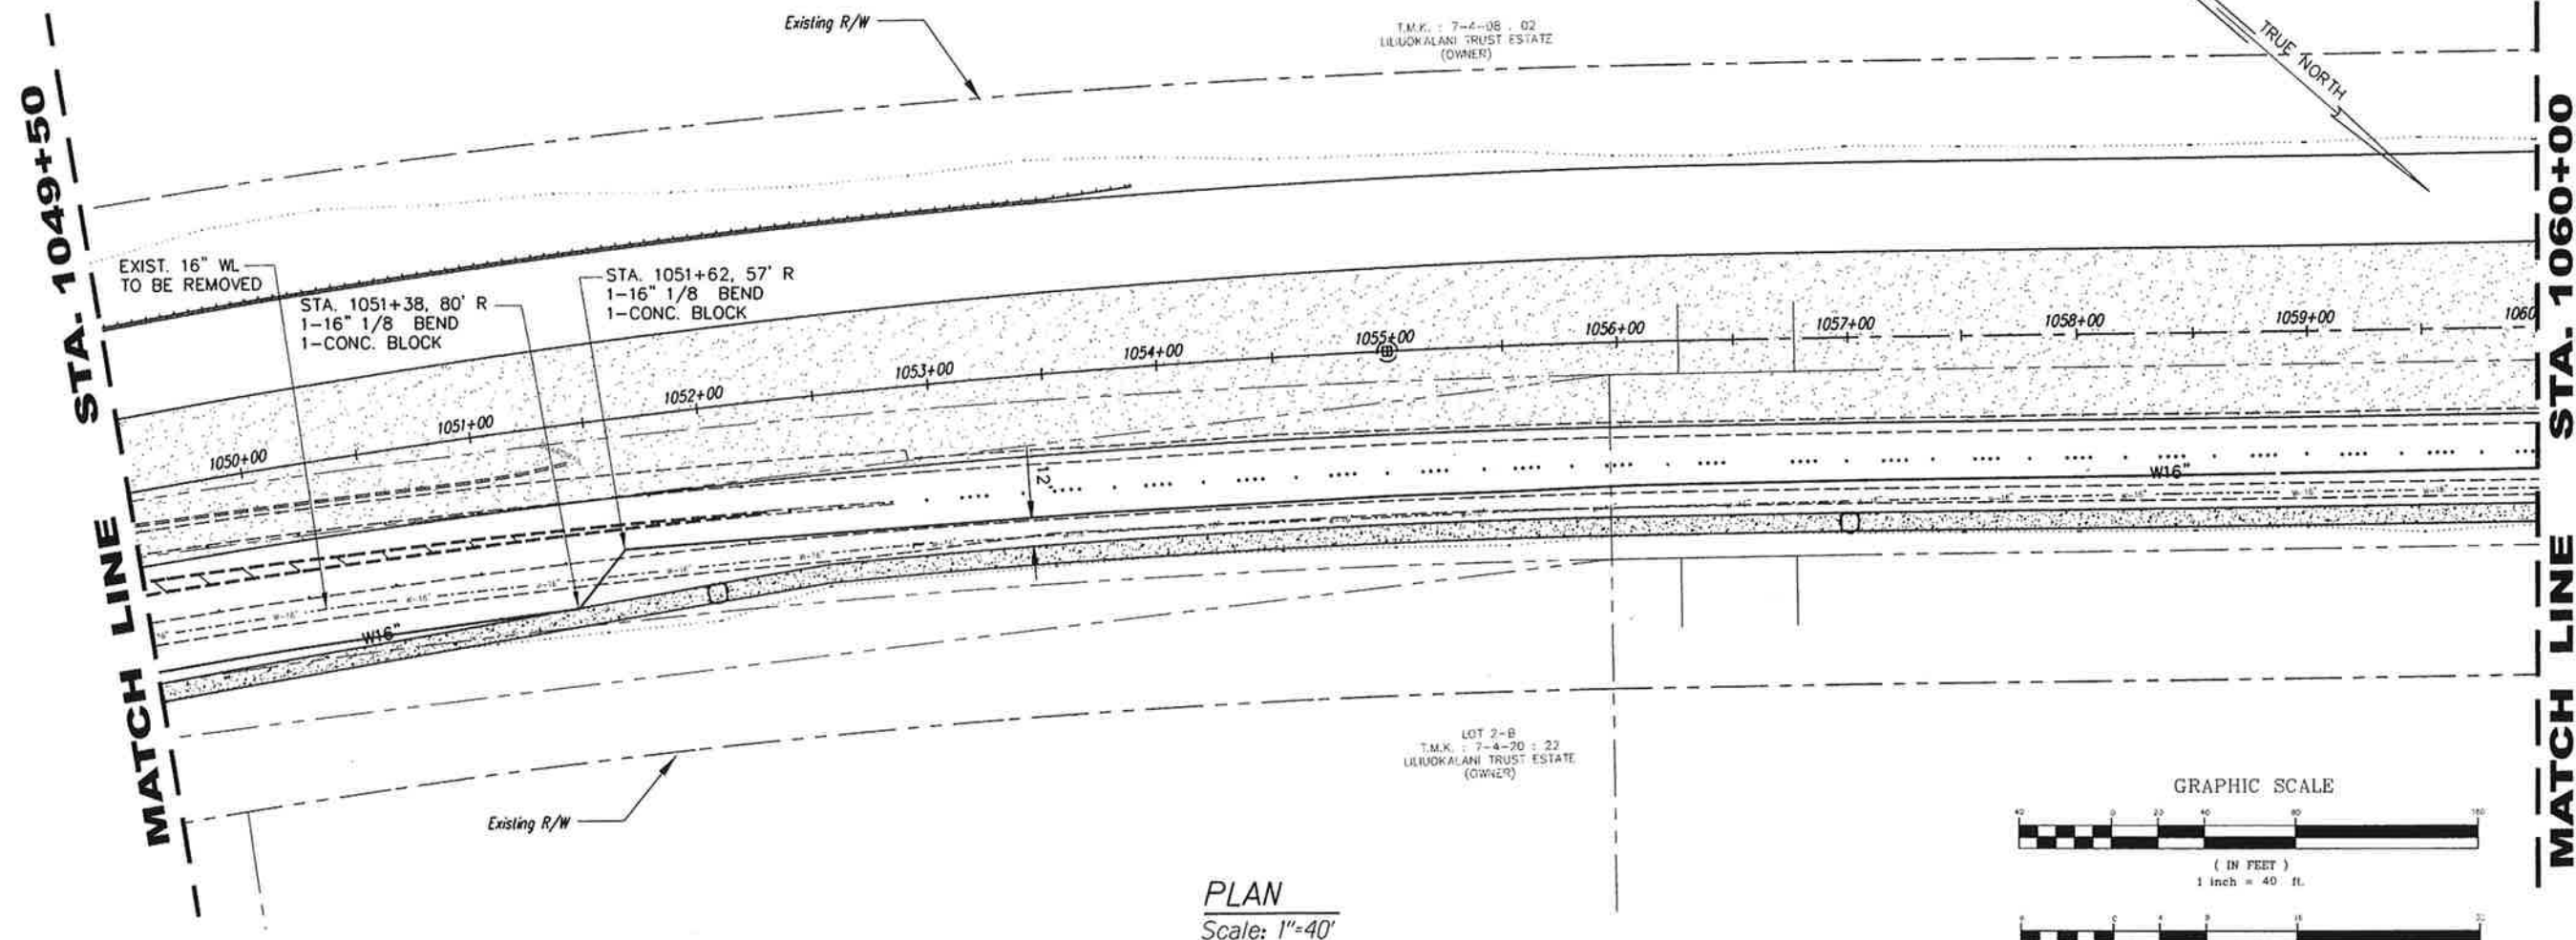

PLAN
Scale: 1"=40'

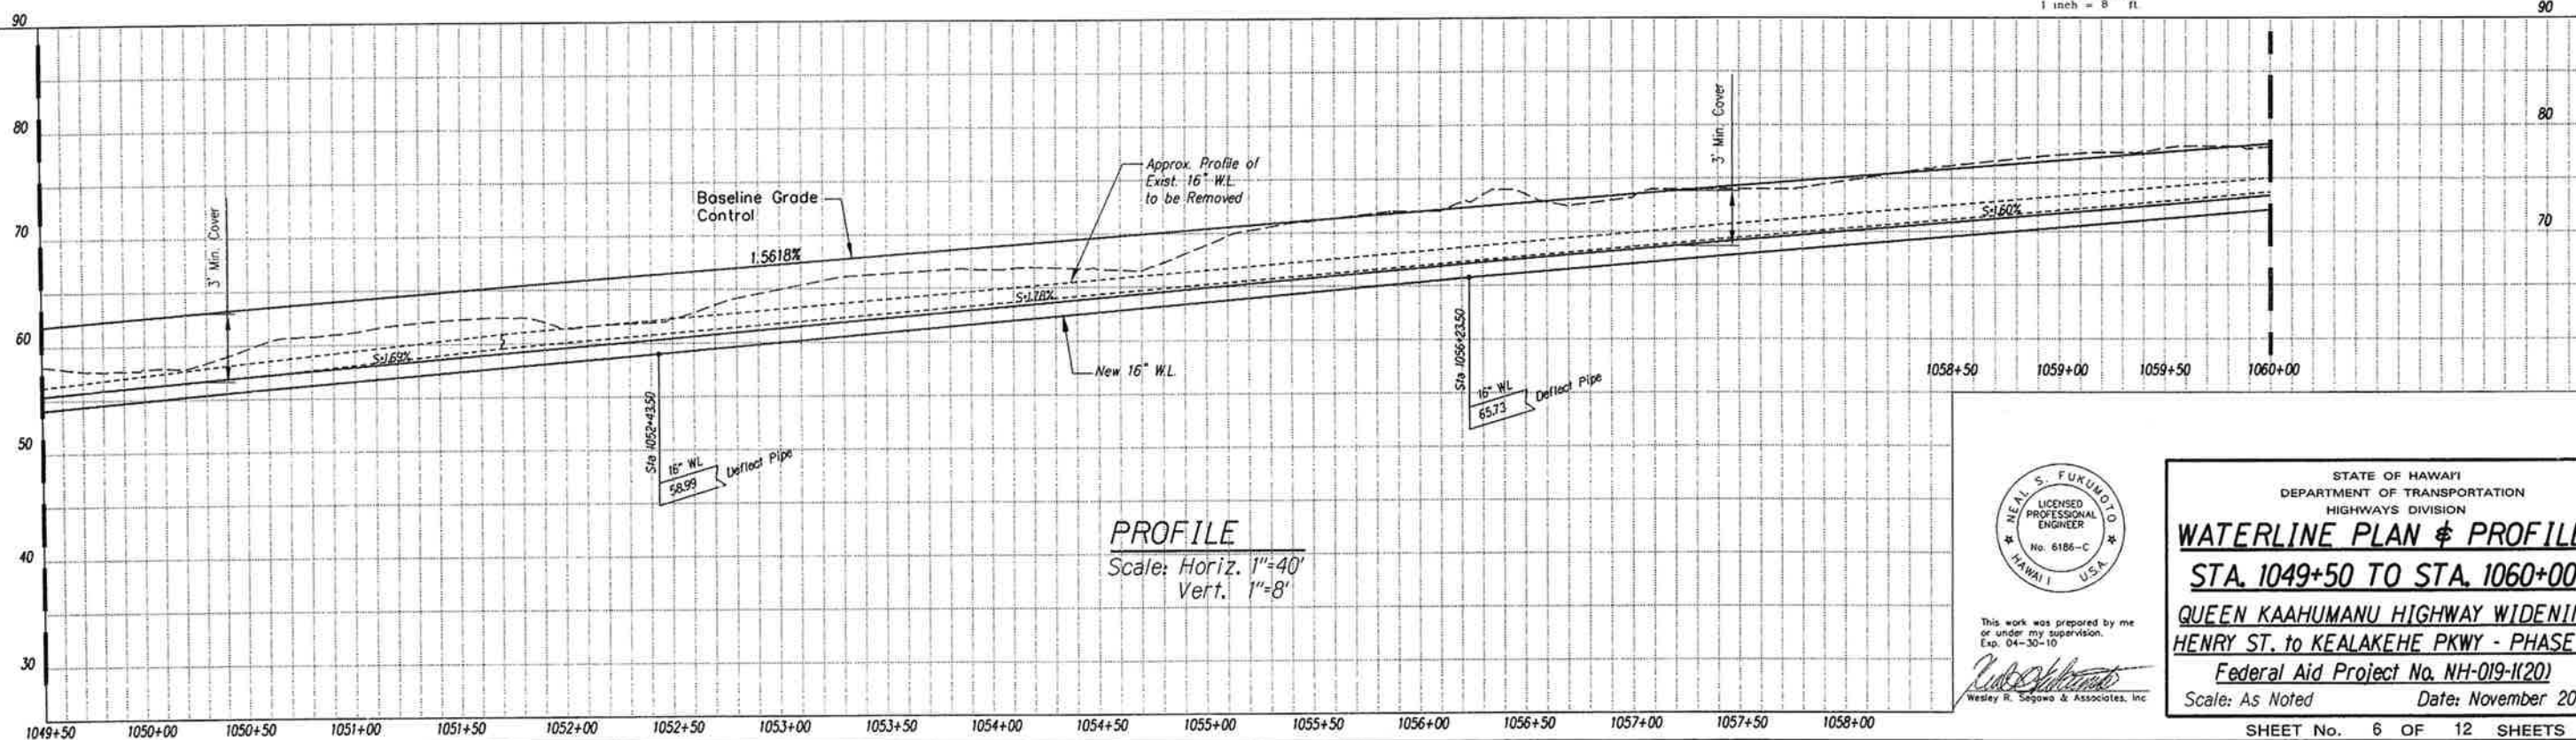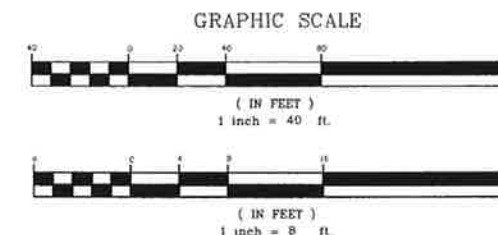

PROFILE
Scale: Horiz. 1"=40'
Vert. 1"=8'



This work was prepared by me or under my supervision.
Exp. 04-30-10
Wesley R. Segawa & Associates, Inc.


STATE OF HAWAII
DEPARTMENT OF TRANSPORTATION
HIGHWAYS DIVISION
WATERLINE PLAN & PROFILE
STA. 1049+50 TO STA. 1060+00
QUEEN KAAHUMANU HIGHWAY WIDENING
HENRY ST. to KEALAKEHE PKWY - PHASE I
Federal Aid Project No. NH-019-1120
Scale: As Noted Date: November 2009

SHEET No. 6 OF 12 SHEETS



AS-BUILT

DESIGNED BY	DATE
CHECKED BY	
NOTED BY	
QUANTITIES BY	
TRACED BY	
DRAWN BY	
PLOTTED BY	
ORIGINAL PLAN	

FED. ROAD DIST. NO.	STATE	FED. AID PROJ. NO.	FISCAL YEAR	SHEET NO.	TOTAL SHEETS
HAWAII	HAW.	NH-019-1(20)	2005	48	315

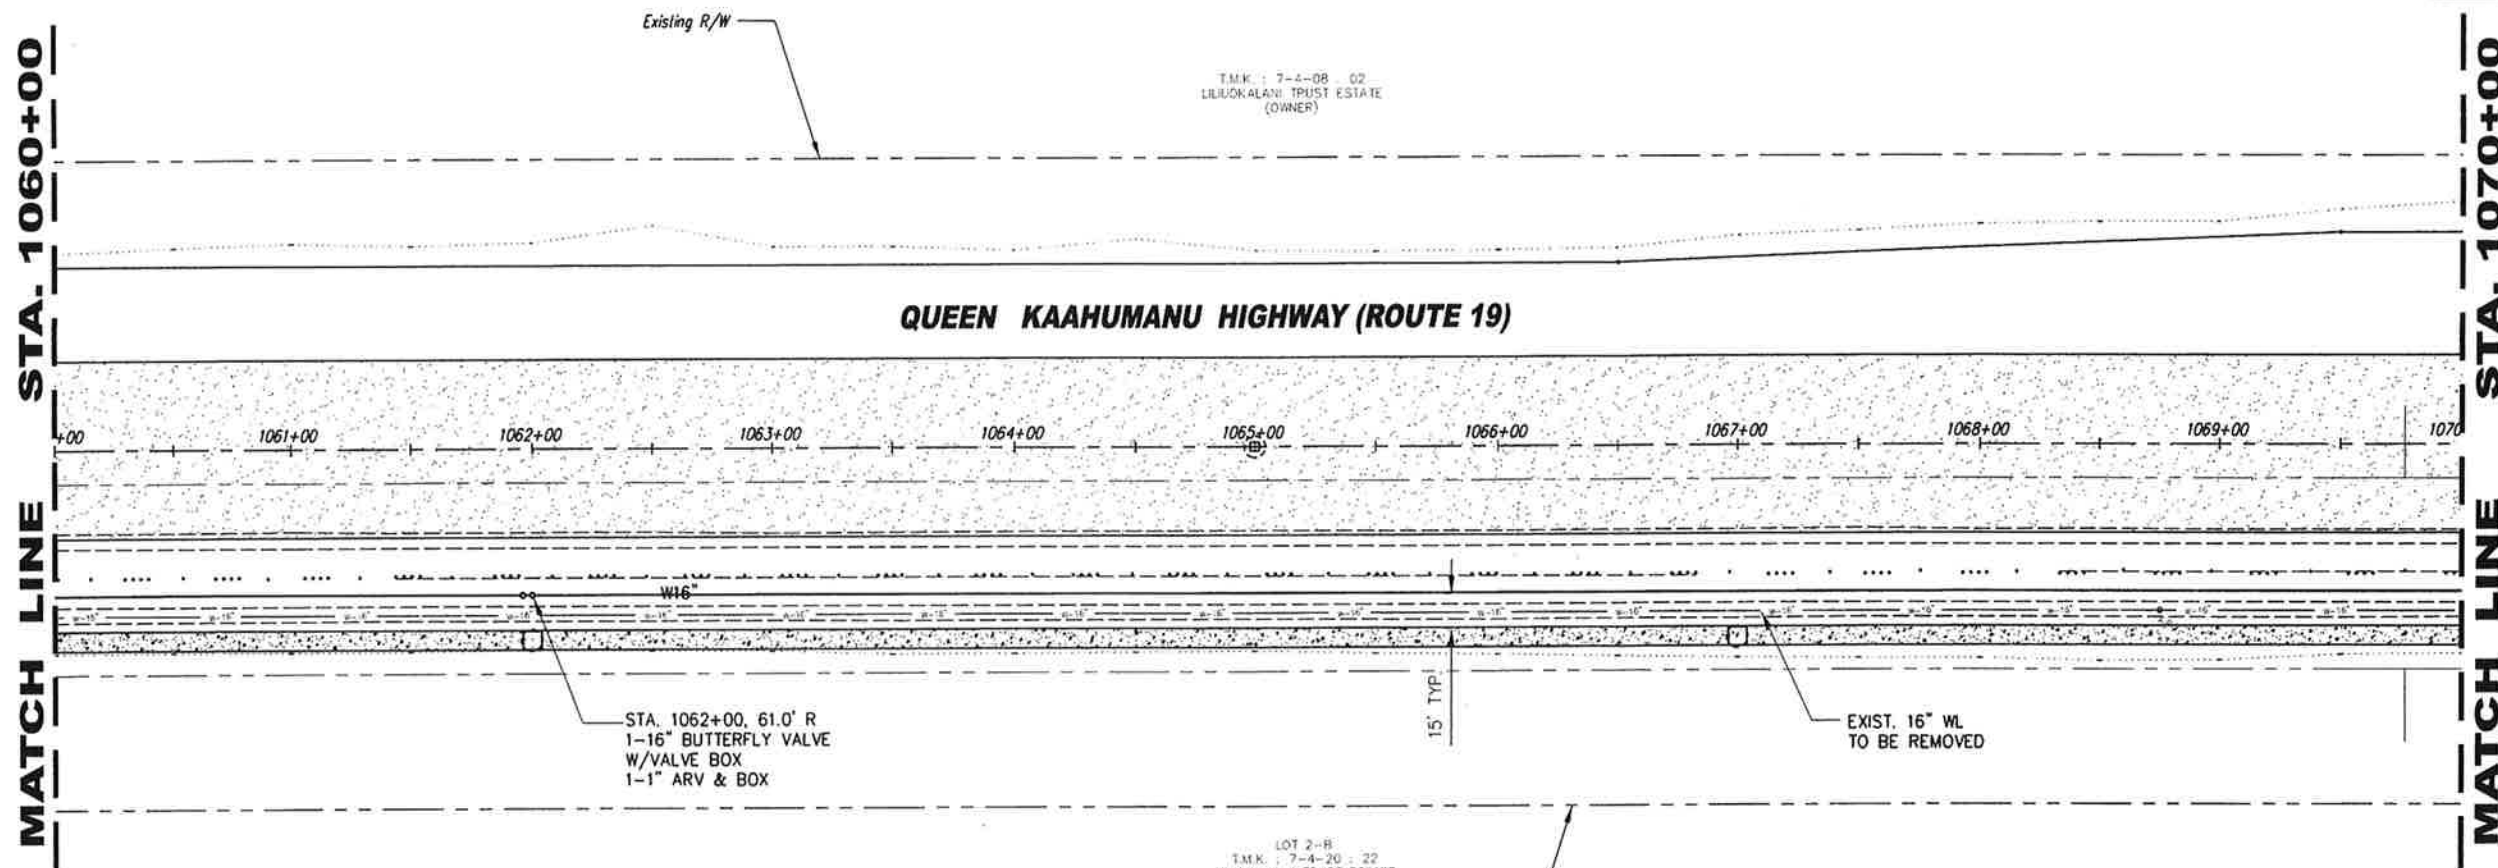

PLAN
Scale: 1"=40'

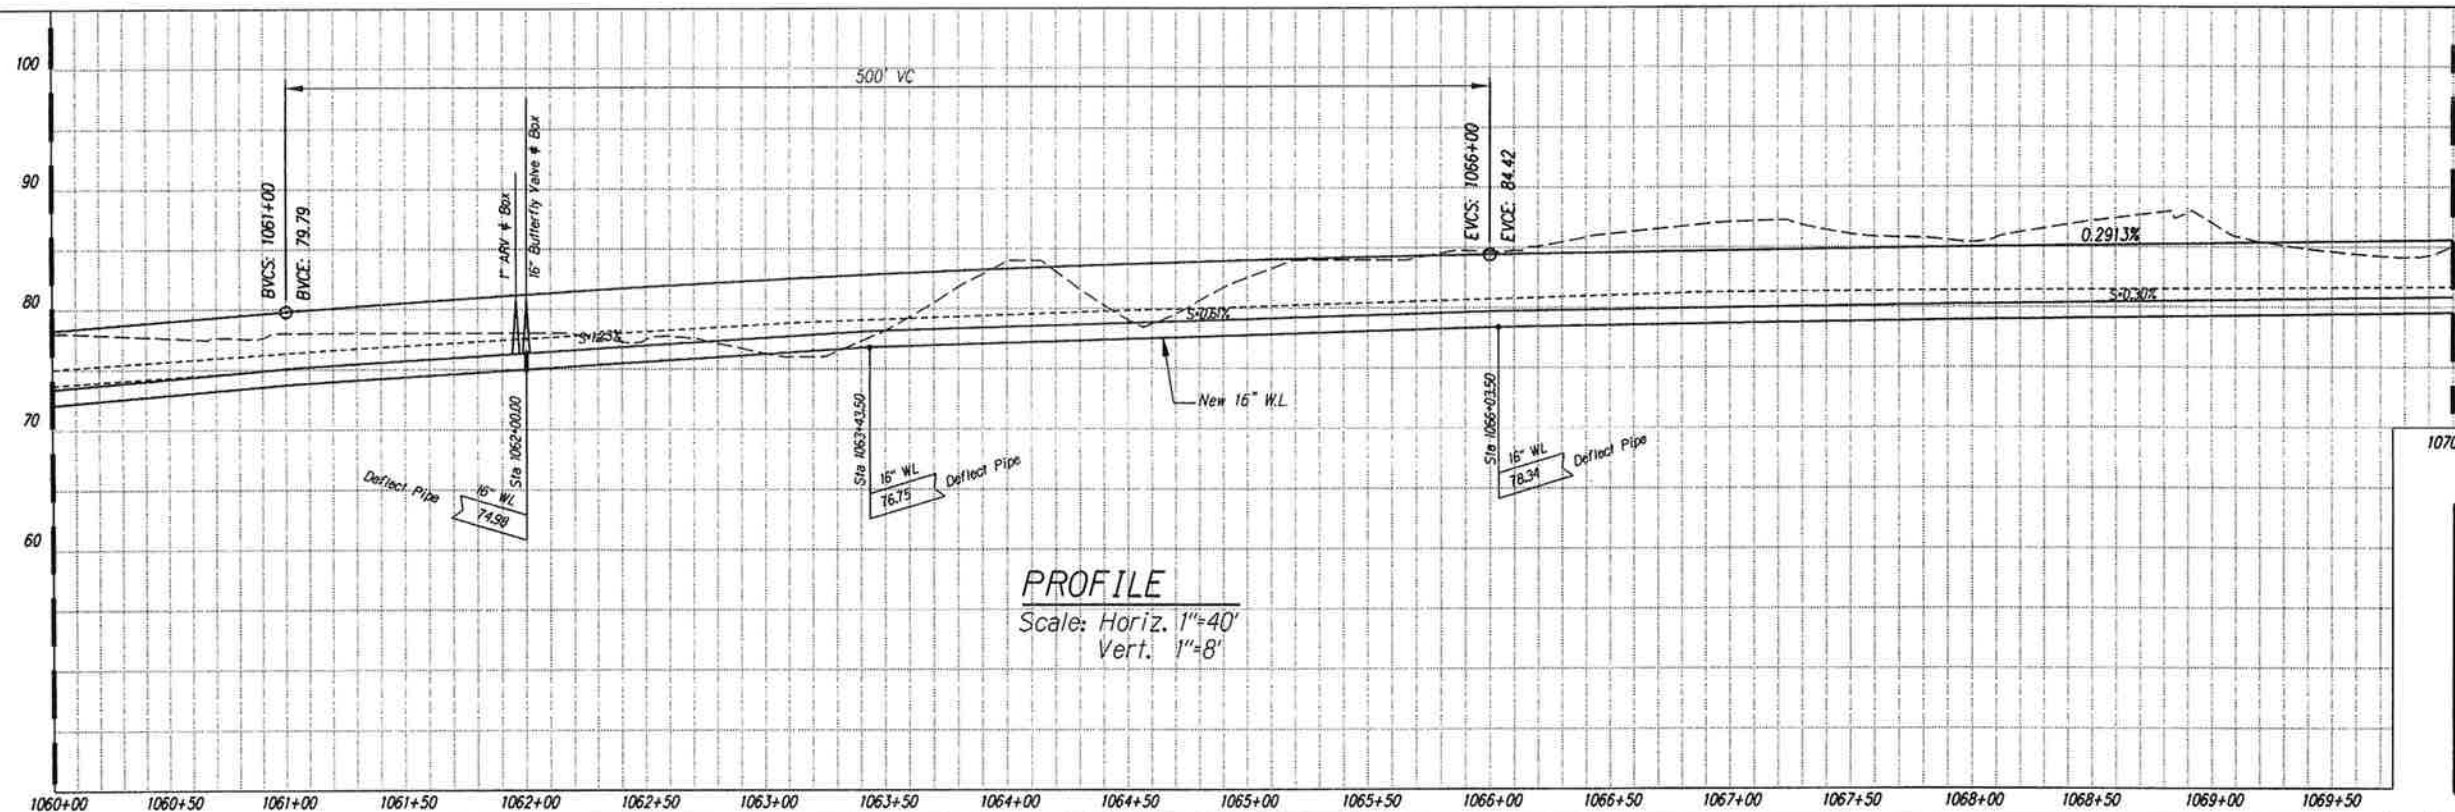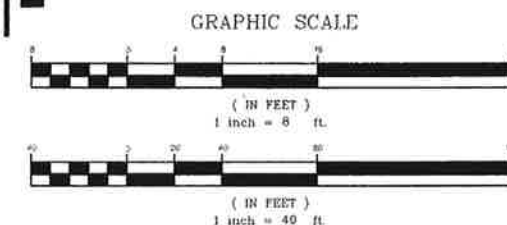

PROFILE
Scale: Horiz. 1"=40'
Vert. 1"=8'




This work was prepared by me or under my supervision.
Exp. 04-30-10

Neil S. Fukumoto
Wesley R. Segawa & Associates, Inc.



STATE OF HAWAII
DEPARTMENT OF TRANSPORTATION
HIGHWAYS DIVISION
WATERLINE PLAN & PROFILE
STA. 1060+00 TO STA. 1070+00
QUEEN KAAHUMANU HIGHWAY WIDENING
HENRY ST. to KEALAKEHE PKWY - PHASE I
Federal Aid Project No. NH-019-1(20)
Scale: As Noted Date: November 2009
SHEET No. 7 OF 12 SHEETS

AS-BUILT


FED. ROAD DIST. NO.	STATE	FED. AID PROJ. NO.	FISCAL YEAR	SHEET NO.	TOTAL SHEETS
HAWAII	HAW.	NH-019-1(20)	2005	49	315

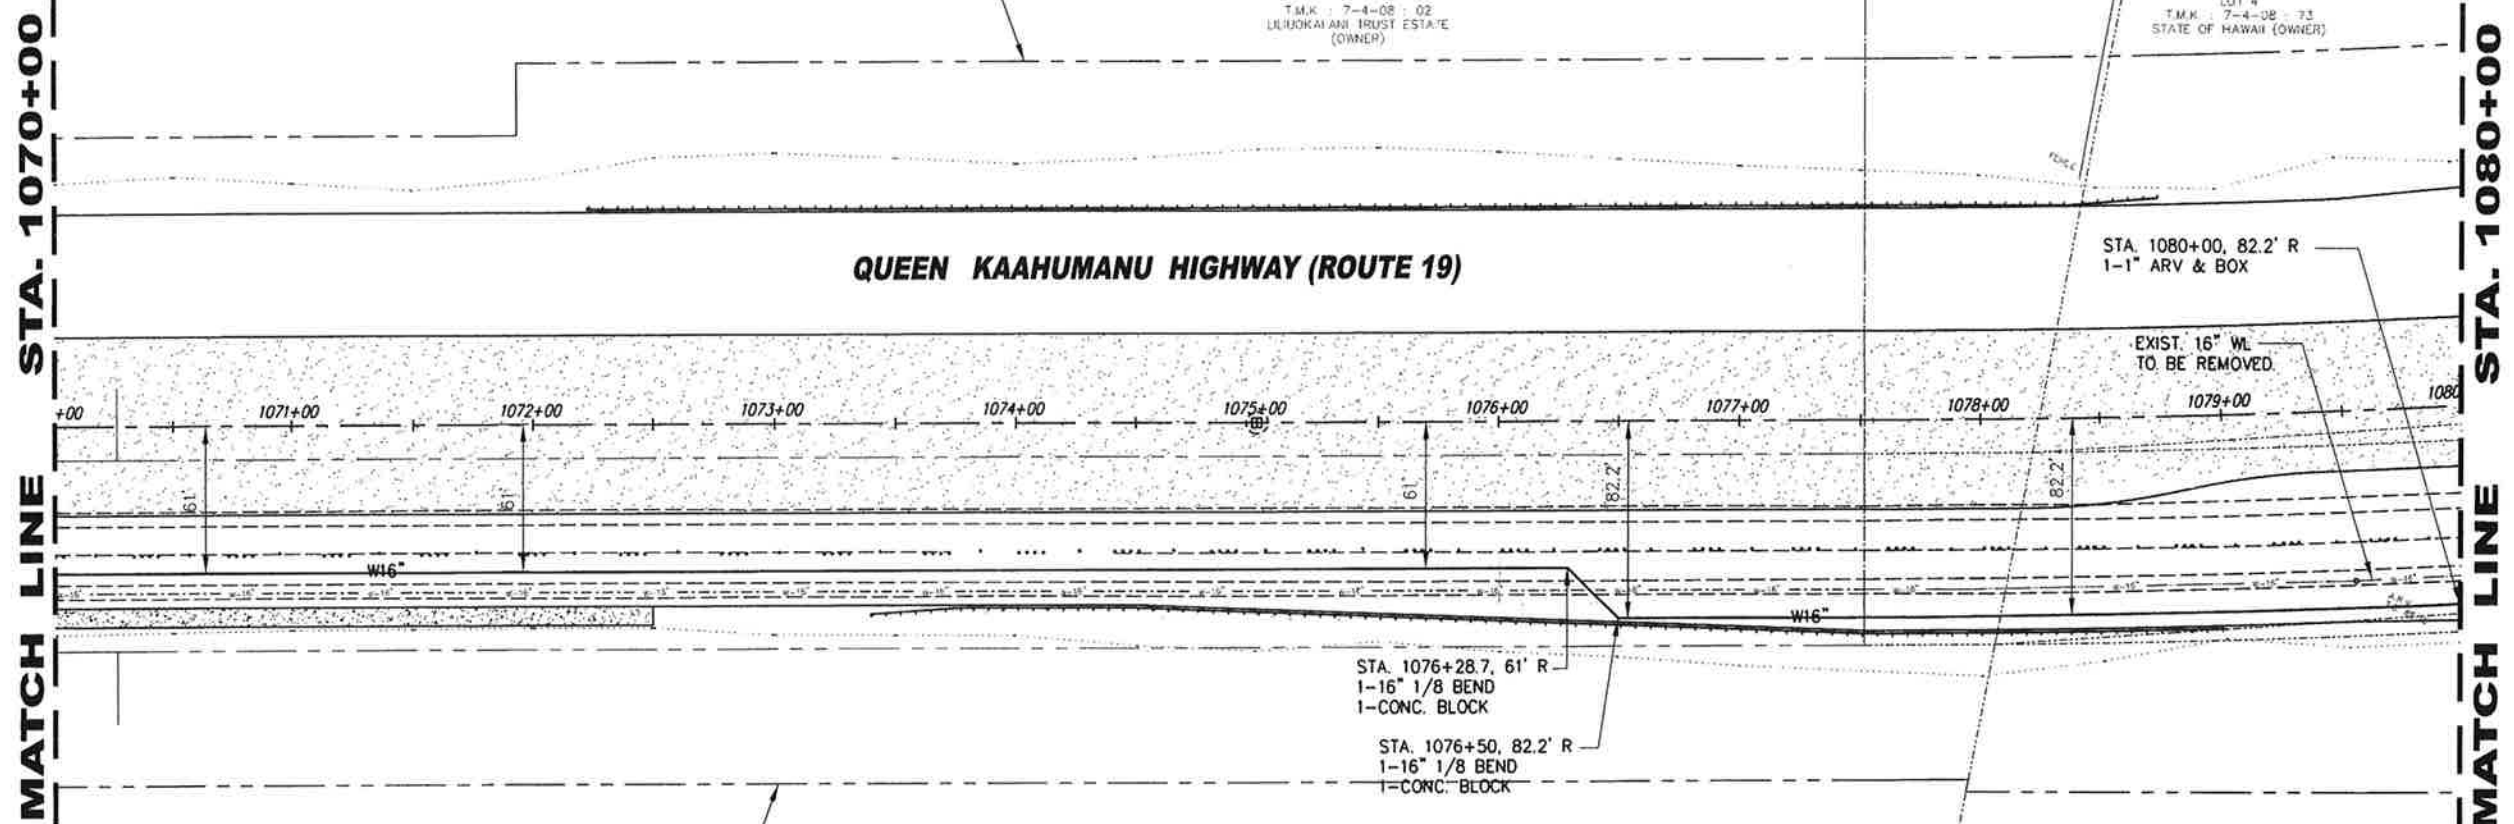

PLAN
Scale: 1"=40'

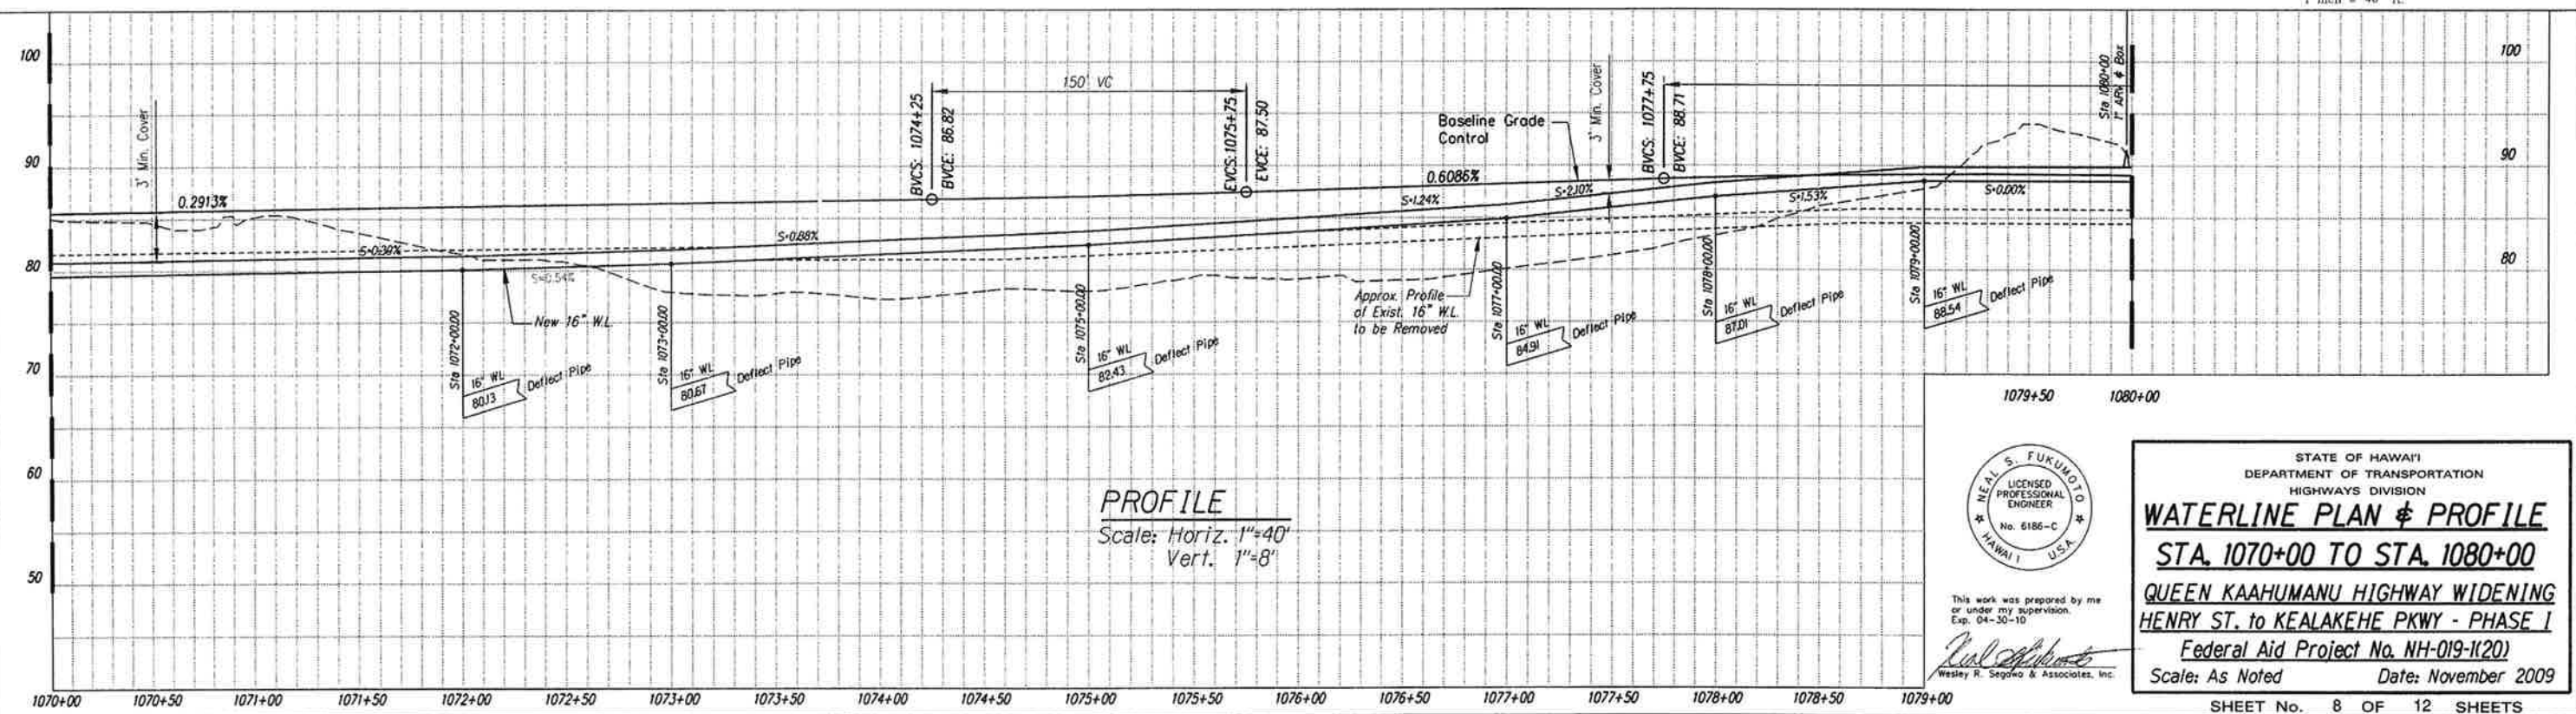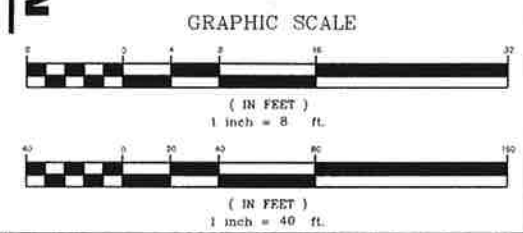

PROFILE
Scale: Horiz. 1"=40'
Vert. 1"=8'

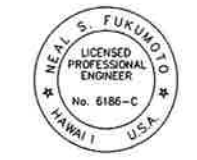

This work was prepared by me or under my supervision.
Exp. 04-30-10
Neil S. Fukumoto
Wesley R. Segawa & Associates, Inc.


STATE OF HAWAII
DEPARTMENT OF TRANSPORTATION
HIGHWAYS DIVISION

WATERLINE PLAN & PROFILE
STA. 1070+00 TO STA. 1080+00
QUEEN KAAHUMANU HIGHWAY WIDENING
HENRY ST. to KEALAKEHE PKWY - PHASE I
Federal Aid Project No. NH-019-1(20)
Scale: As Noted Date: November 2009

SURVEY PLOTTED BY	DATE
DRAWN BY	
DESIGNED BY	
CHECKED BY	


AS-BUILT

FED. ROAD DIST. NO.	STATE	FED. AID PROJ. NO.	FISCAL YEAR	SHEET NO.	TOTAL SHEETS
HAWAII	HAW.	NH-019-1(20)	2006	50	315

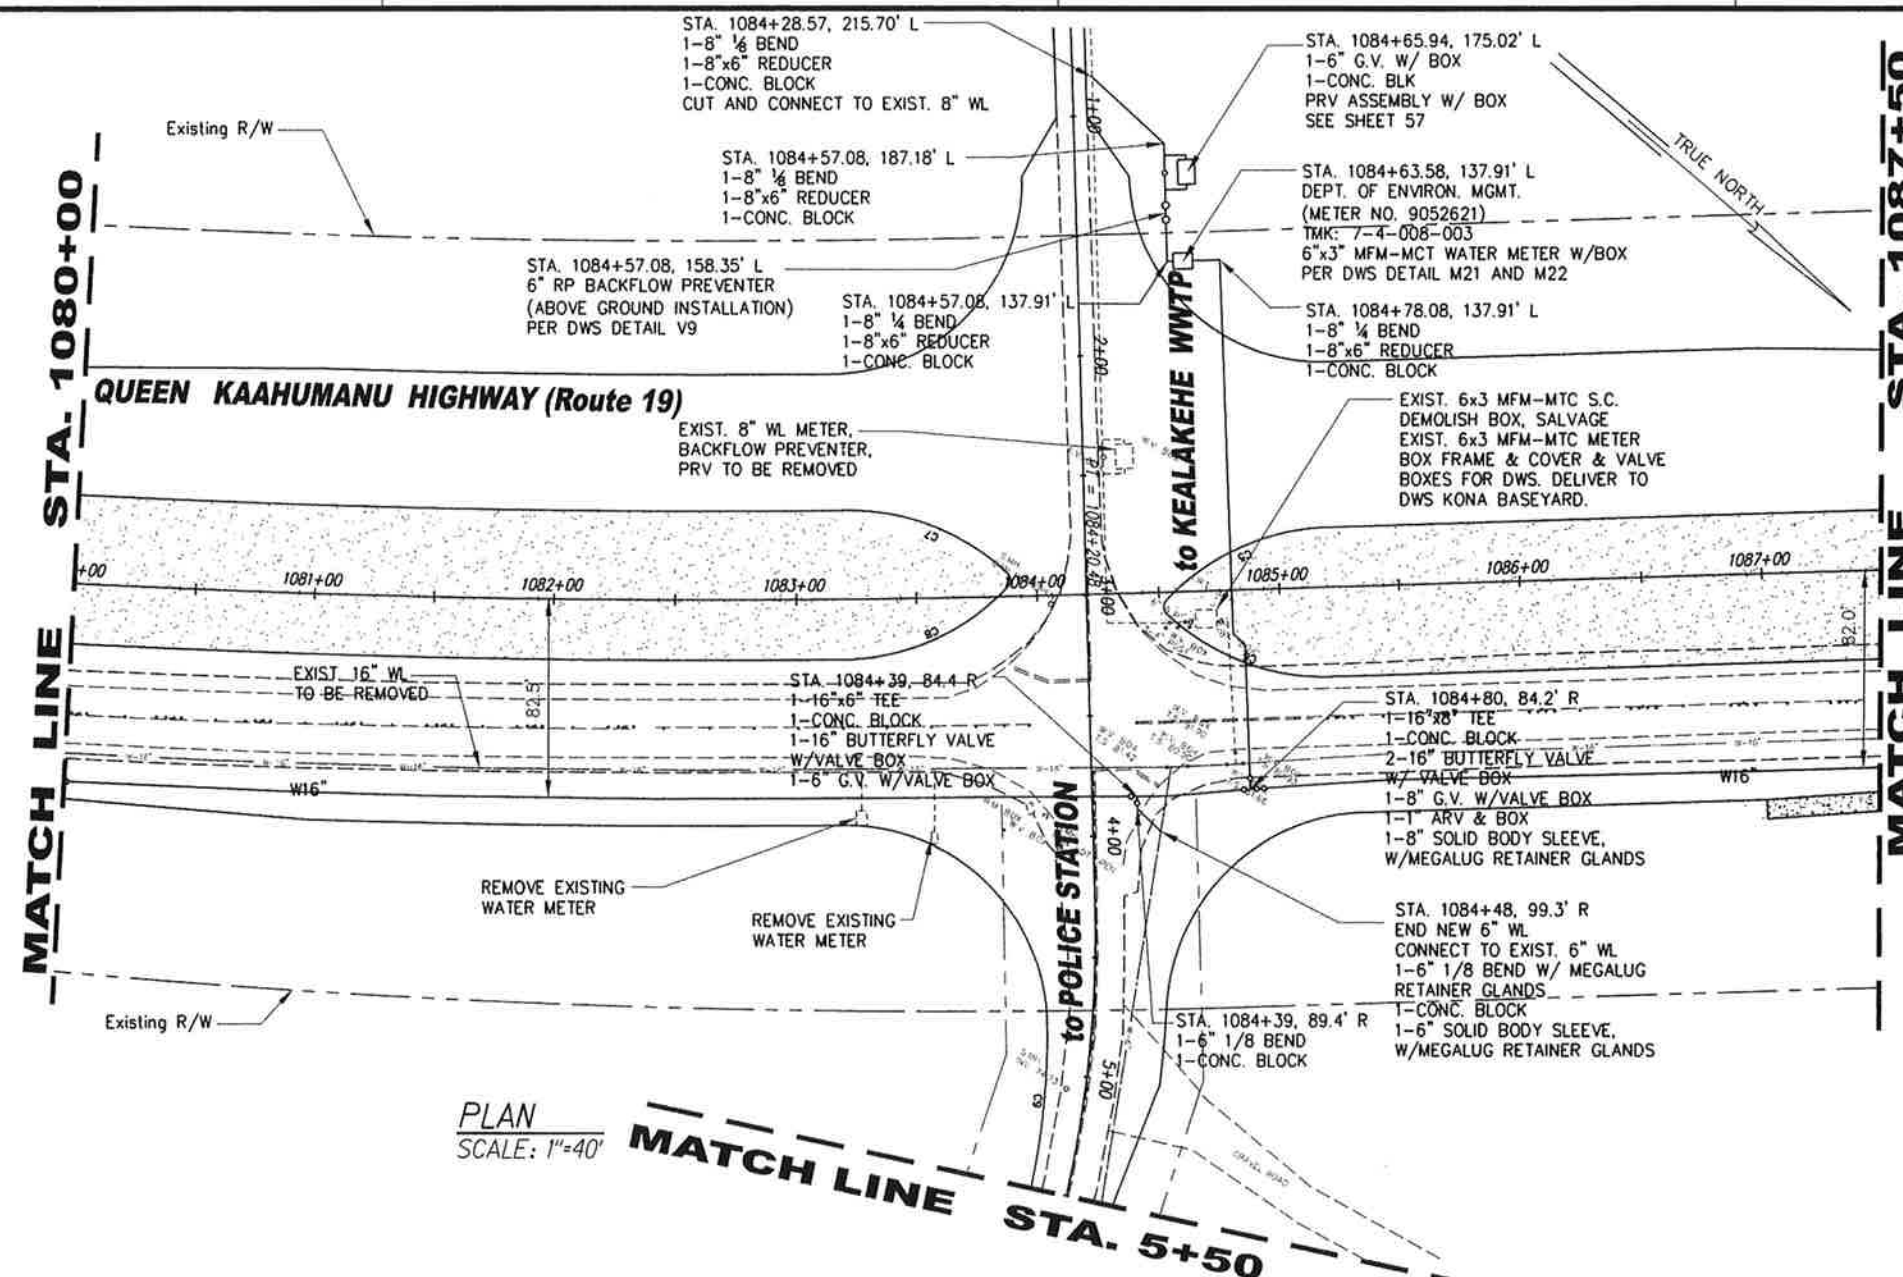


2 1/2" TYPE "A" SERV. LAT. (EXIST.)
 GEORGE TAMASHIRO
 2 INCH METER #34049464
 TMK: 7-4-020:018
 RELOCATE WATER METER
 INSTALL 2 1/2" TYPE "A" SERV. CONN.
 CONNECT TO EXIST.
 CUSTOMER WATER LINE.

1 1/4" TYPE "A" SERV. LAT.
 WEST HAWAII HUMANE SOCIETY
 1 INCH METER #32754660
 TMK: 7-4-020:016
 RELOCATE WATER METER.
 INSTALL 1 1/4" TYPE "A" SERV. CONN.
 CONNECT TO EXIST. CUSTOMER
 WATER LINE.

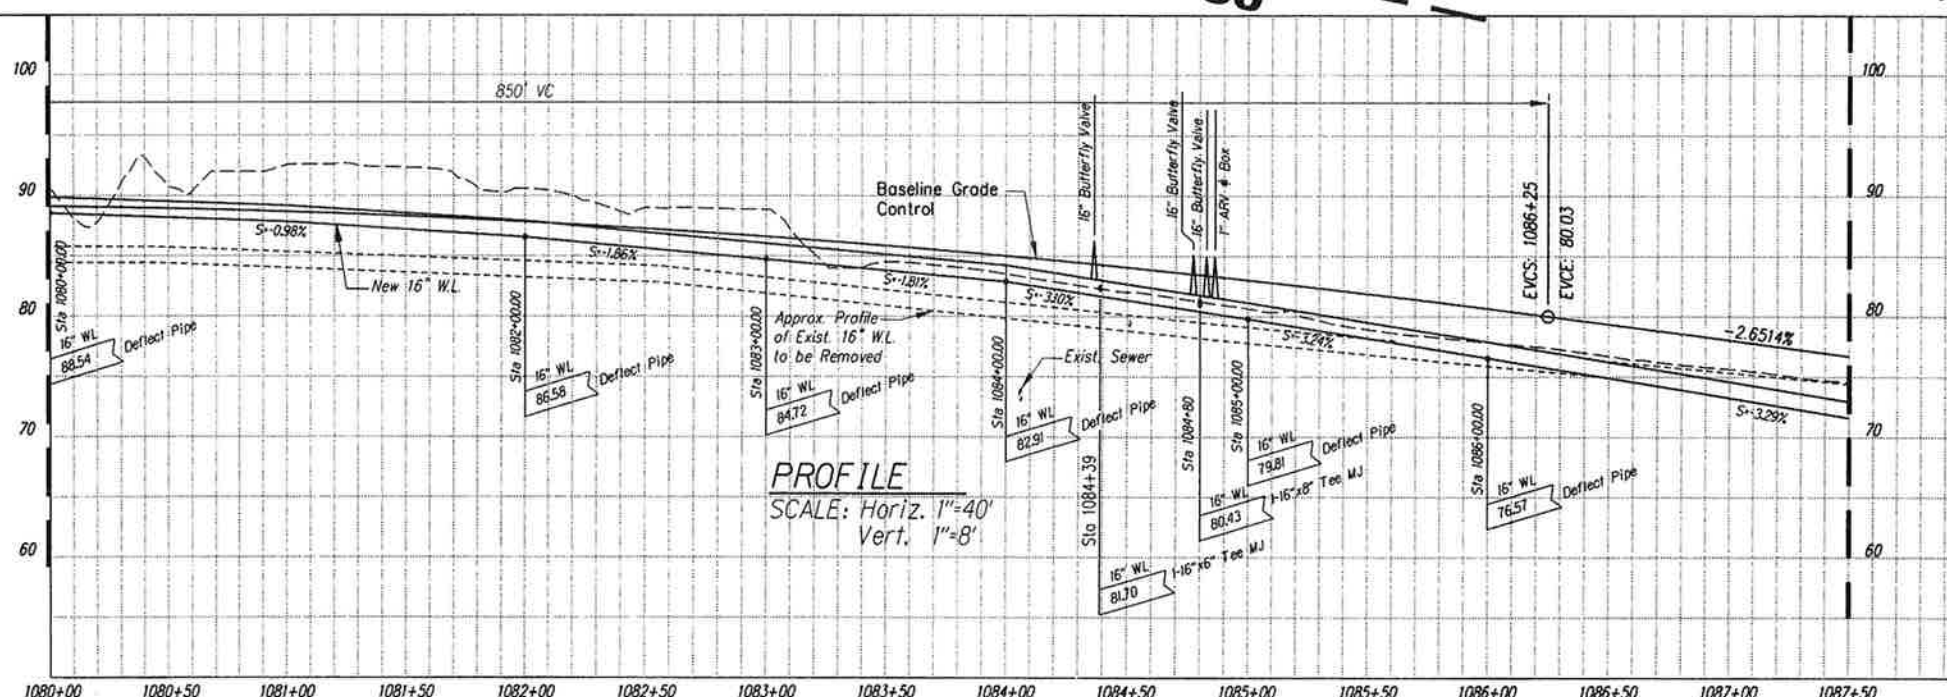

AS-BUILT

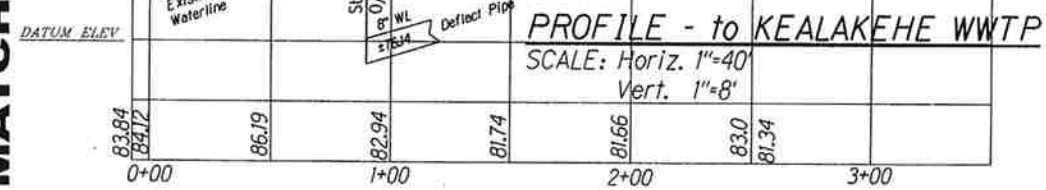

PLAN
 SCALE: 1"=40'

STATE OF HAWAII
 DEPARTMENT OF TRANSPORTATION
 HIGHWAYS DIVISION


WATERLINE PLAN & PROFILE
STA. 1080+00 TO STA. 1087+50
QUEEN KAAHUMANU HIGHWAY WIDENING
HENRY ST. to KEALAKEHE PKWY - PHASE I
 Federal Aid Project No. NH-019-1(20)
 Scale: As Noted Date: November 2009

SHEET No. 9 OF 12 SHEETS





This work was prepared by me
 or under my supervision.
 Exp. 04-30-10
 Wesley R. Segawa & Associates, Inc.

FED. ROAD DIST. NO.	STATE	FED. AID PROJ. NO.	FISCAL YEAR	SHEET NO.	TOTAL SHEETS
HAWAII	HAW.	NH-019-1(20)	2005	51	315

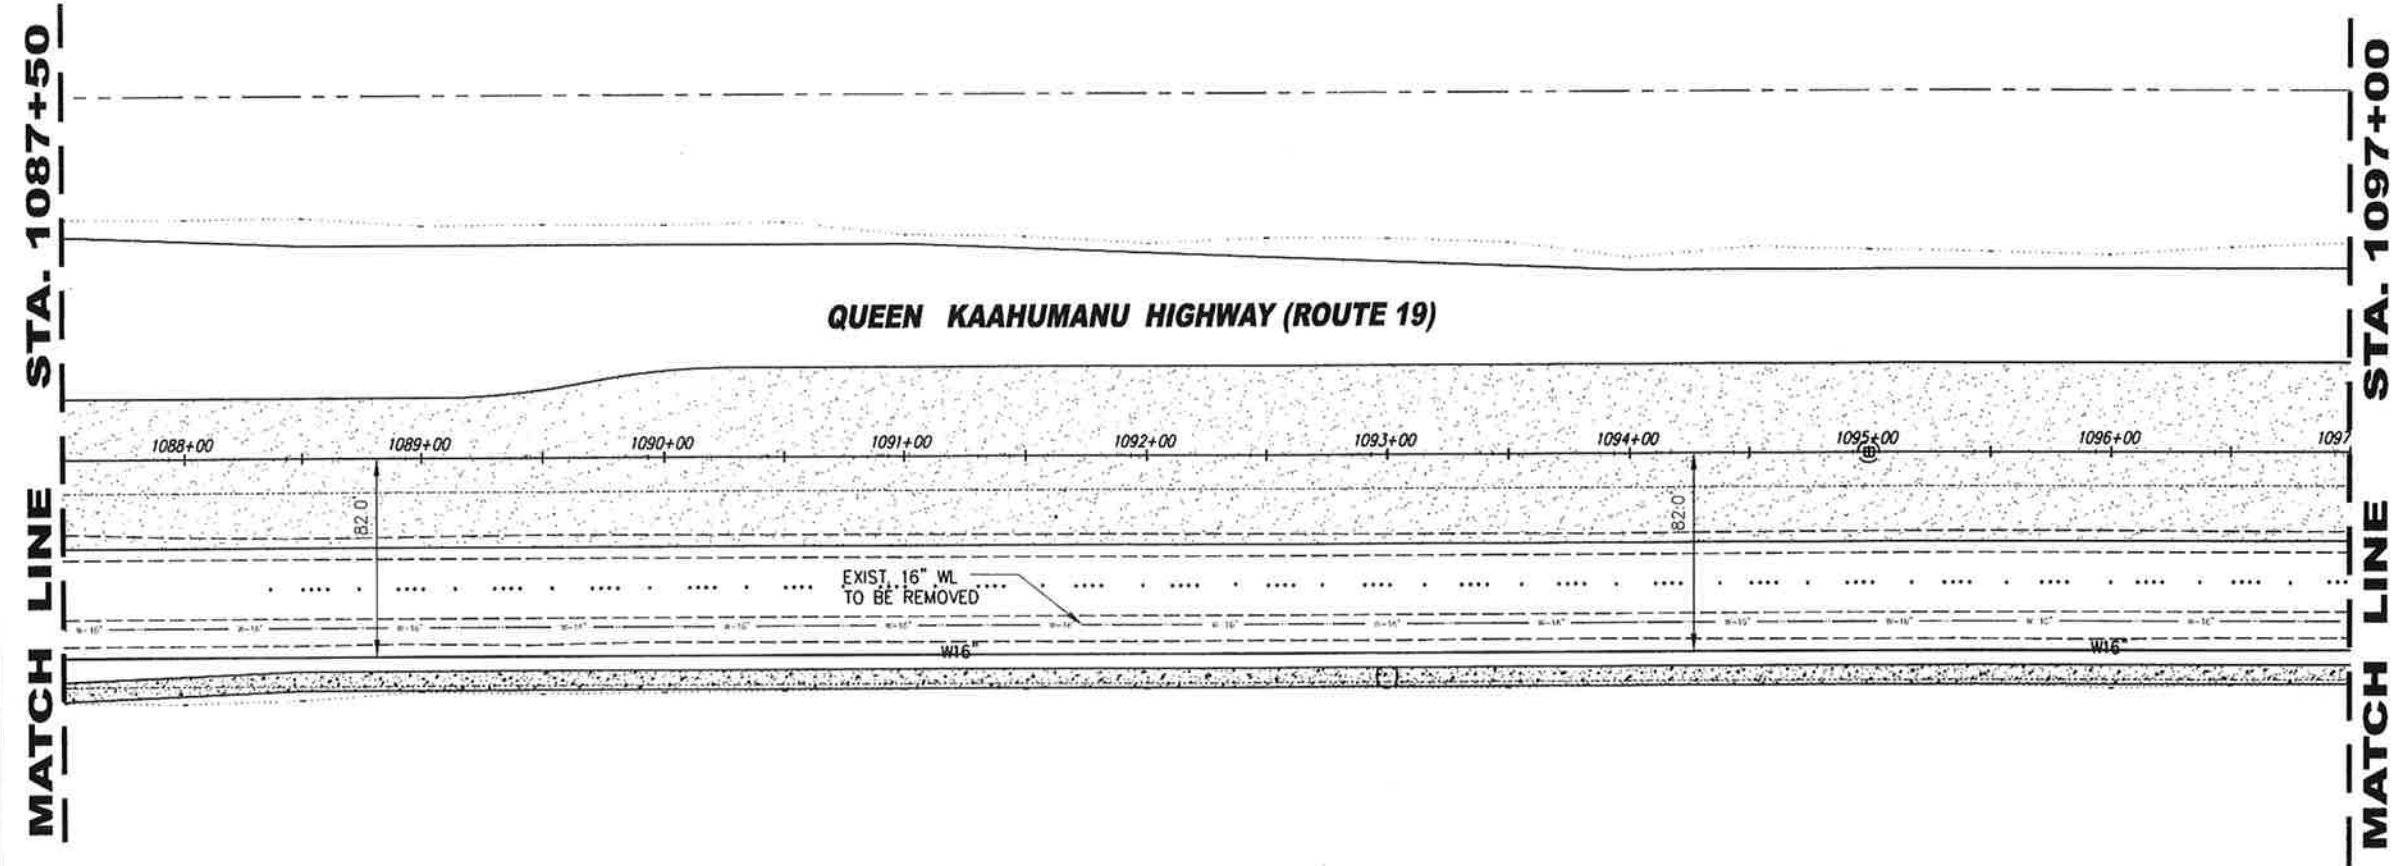

PLAN
Scale: 1"=40'

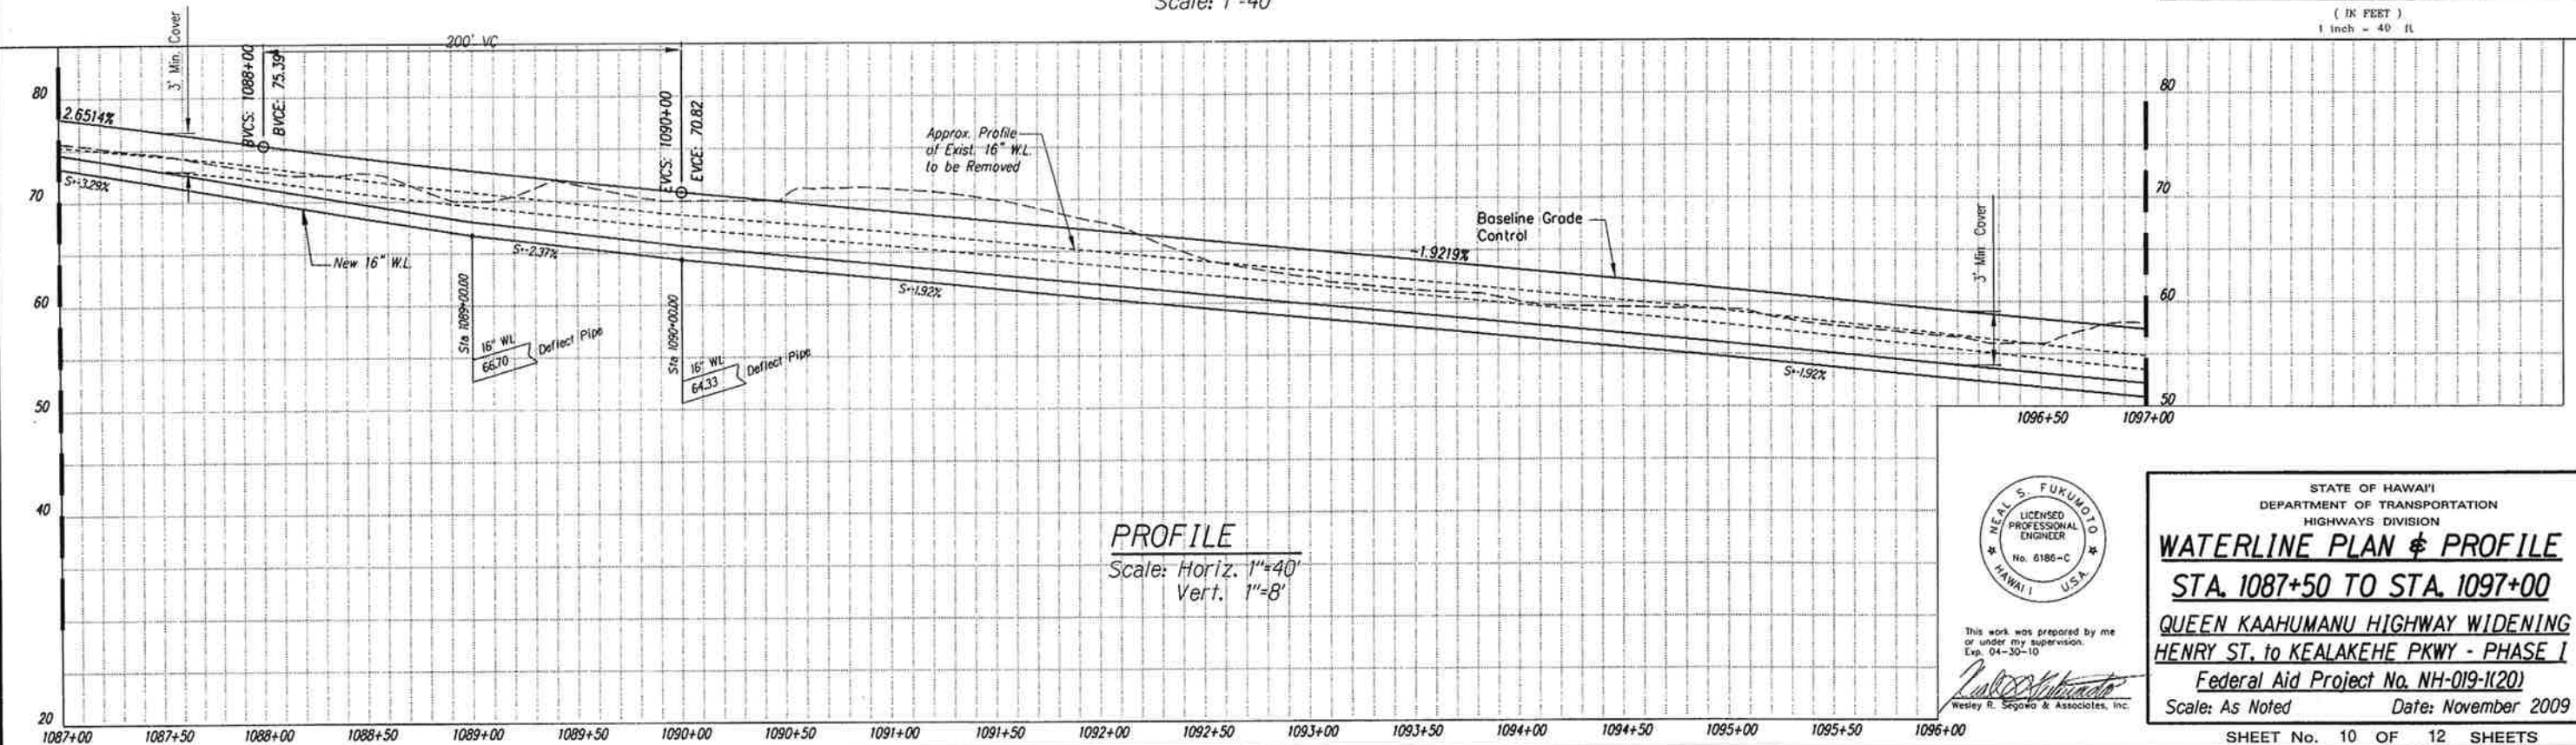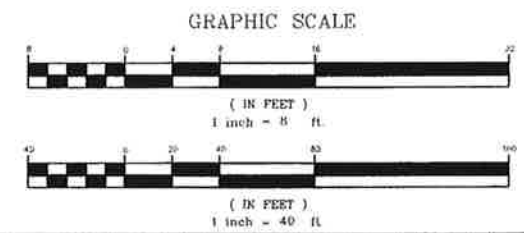

PROFILE
Scale: Horiz. 1"=40'
Vert. 1"=8'

SURVEY PLOTTED BY	DATE
DRAWN BY	
NOTE BOOK	
CHECKED BY	



This work was prepared by me or under my supervision.
Exp. 04-30-10
Neal S. Fukumoto
Wesley R. Segawa & Associates, Inc.

STATE OF HAWAII
DEPARTMENT OF TRANSPORTATION
HIGHWAYS DIVISION
WATERLINE PLAN & PROFILE
STA. 1087+50 TO STA. 1097+00
QUEEN KAAHUMANU HIGHWAY WIDENING
HENRY ST. to KEALAKEHE PKWY - PHASE I
Federal Aid Project No. NH-019-1(20)
Scale: As Noted Date: November 2009

AS-BUILT

FED. ROAD DIST. NO.	STATE	FED. AID PROJ. NO.	FISCAL YEAR	SHEET NO.	TOTAL SHEETS
HAWAII	HAW.	NH-019-1(20)	2005	52	315


MATCH LINE STA. 1097+00

MATCH LINE STA. 1109+00



QUEEN KAAHUMANU HIGHWAY (ROUTE 19)

Exist. R/W

TRUE NORTH

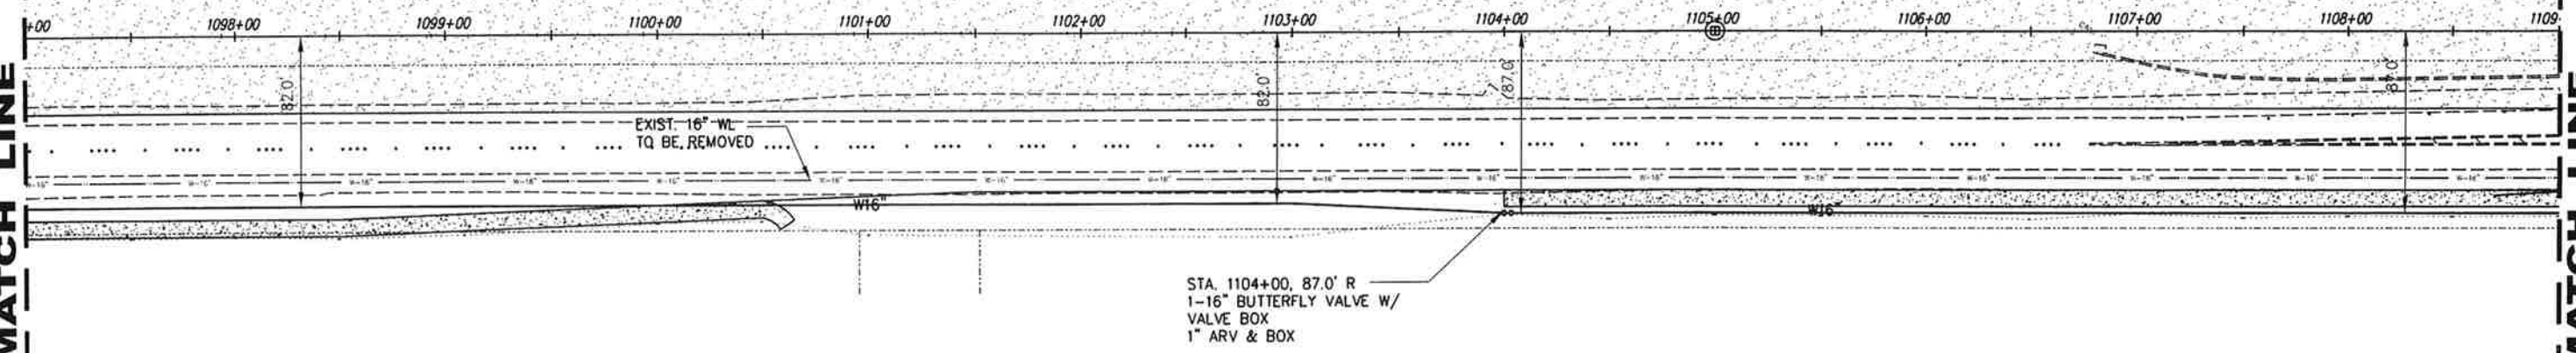

PLAN
Scale: 1"=40'

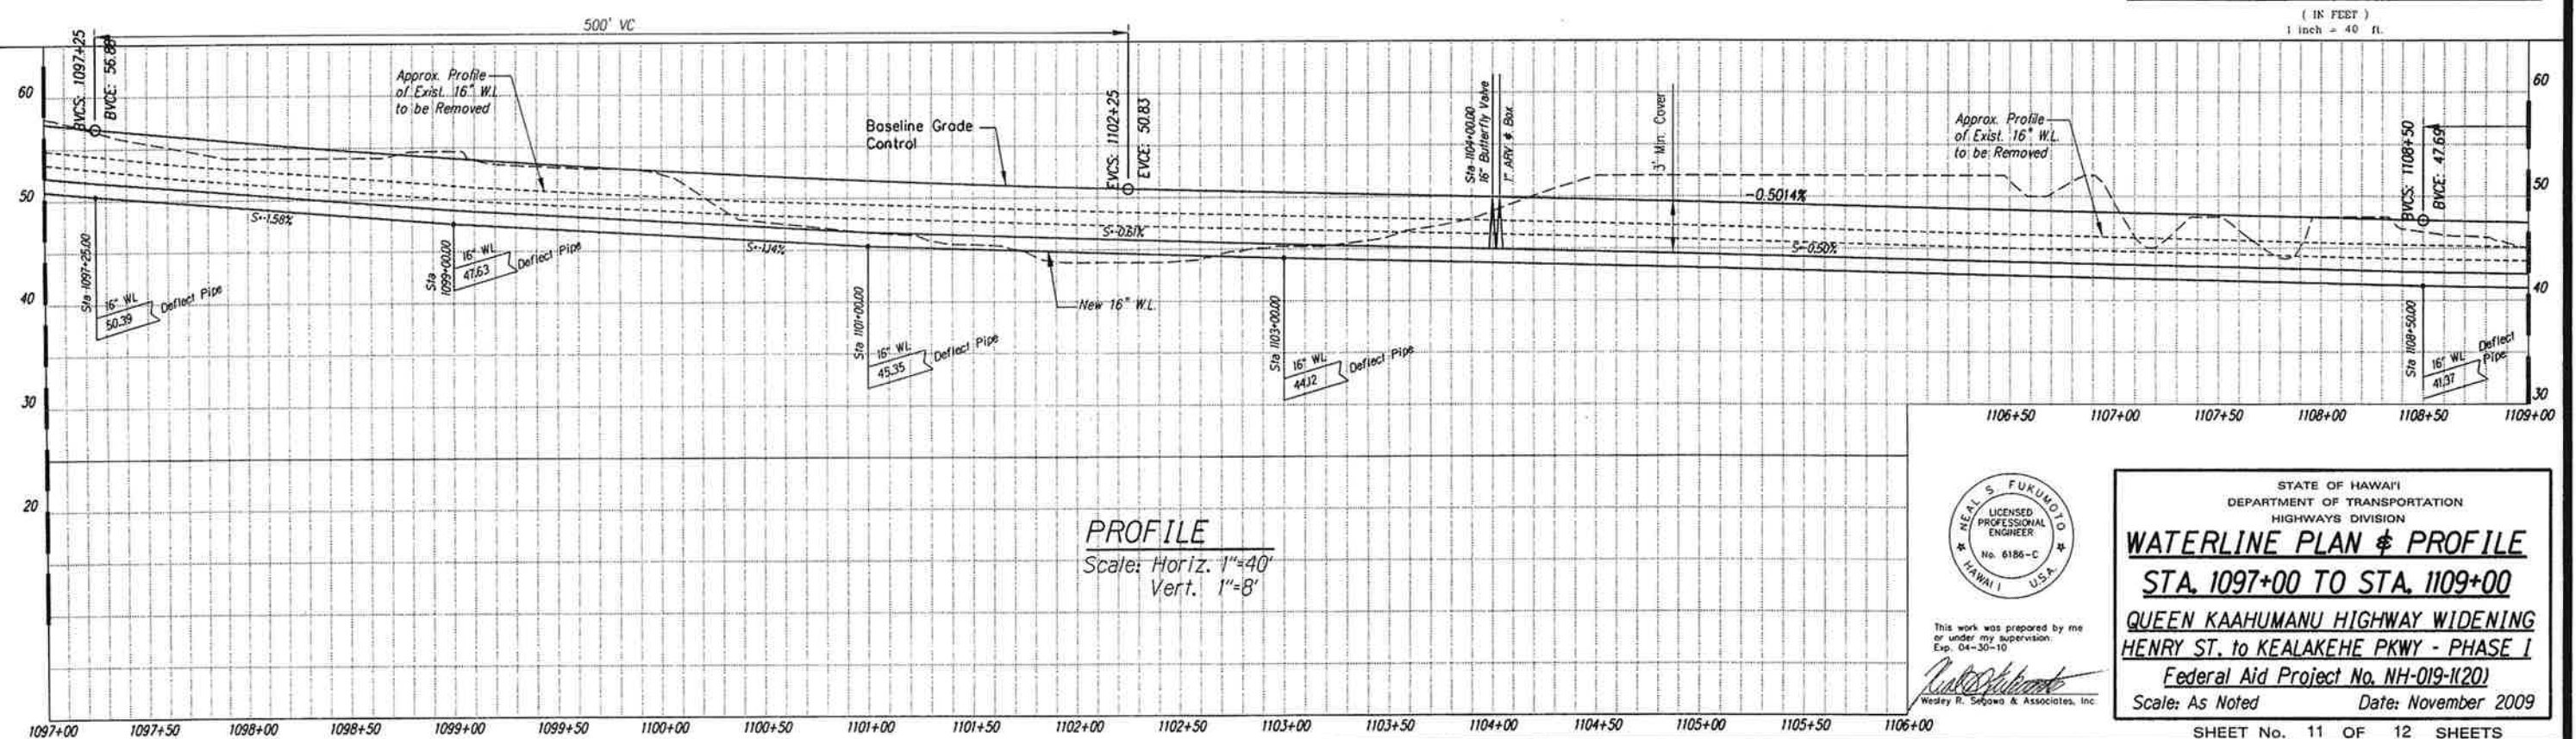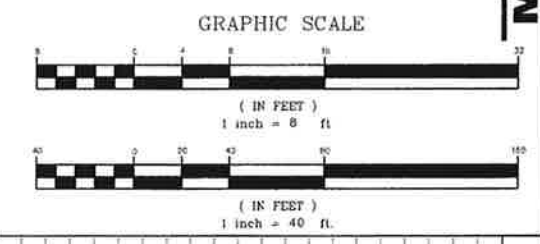

PROFILE
Scale: Horiz. 1"=40'
Vert. 1"=8'

SURVEY PLOTTED BY	DATE
DRAWN BY	
TRACED BY	
NOTED BY	
CHECKED BY	



This work was prepared by me or under my supervision.
Exp. 04-30-10
Neal S. Fukumoto
Wesley R. Segawa & Associates, Inc.

STATE OF HAWAII
DEPARTMENT OF TRANSPORTATION
HIGHWAYS DIVISION

WATERLINE PLAN & PROFILE
STA. 1097+00 TO STA. 1109+00
QUEEN KAAHUMANU HIGHWAY WIDENING
HENRY ST. to KEALAKEHE PKWY - PHASE I
Federal Aid Project No. NH-019-1(20)
Scale: As Noted Date: November 2009

AS-BUILT

