



FED. ROAD DIST. NO.	STATE	FED. AID PROJ. NO.	FISCAL YEAR	SHEET NO.	TOTAL SHEETS
HAWAII	HAW.	NH-019-1(38)R	2016	37	528 522

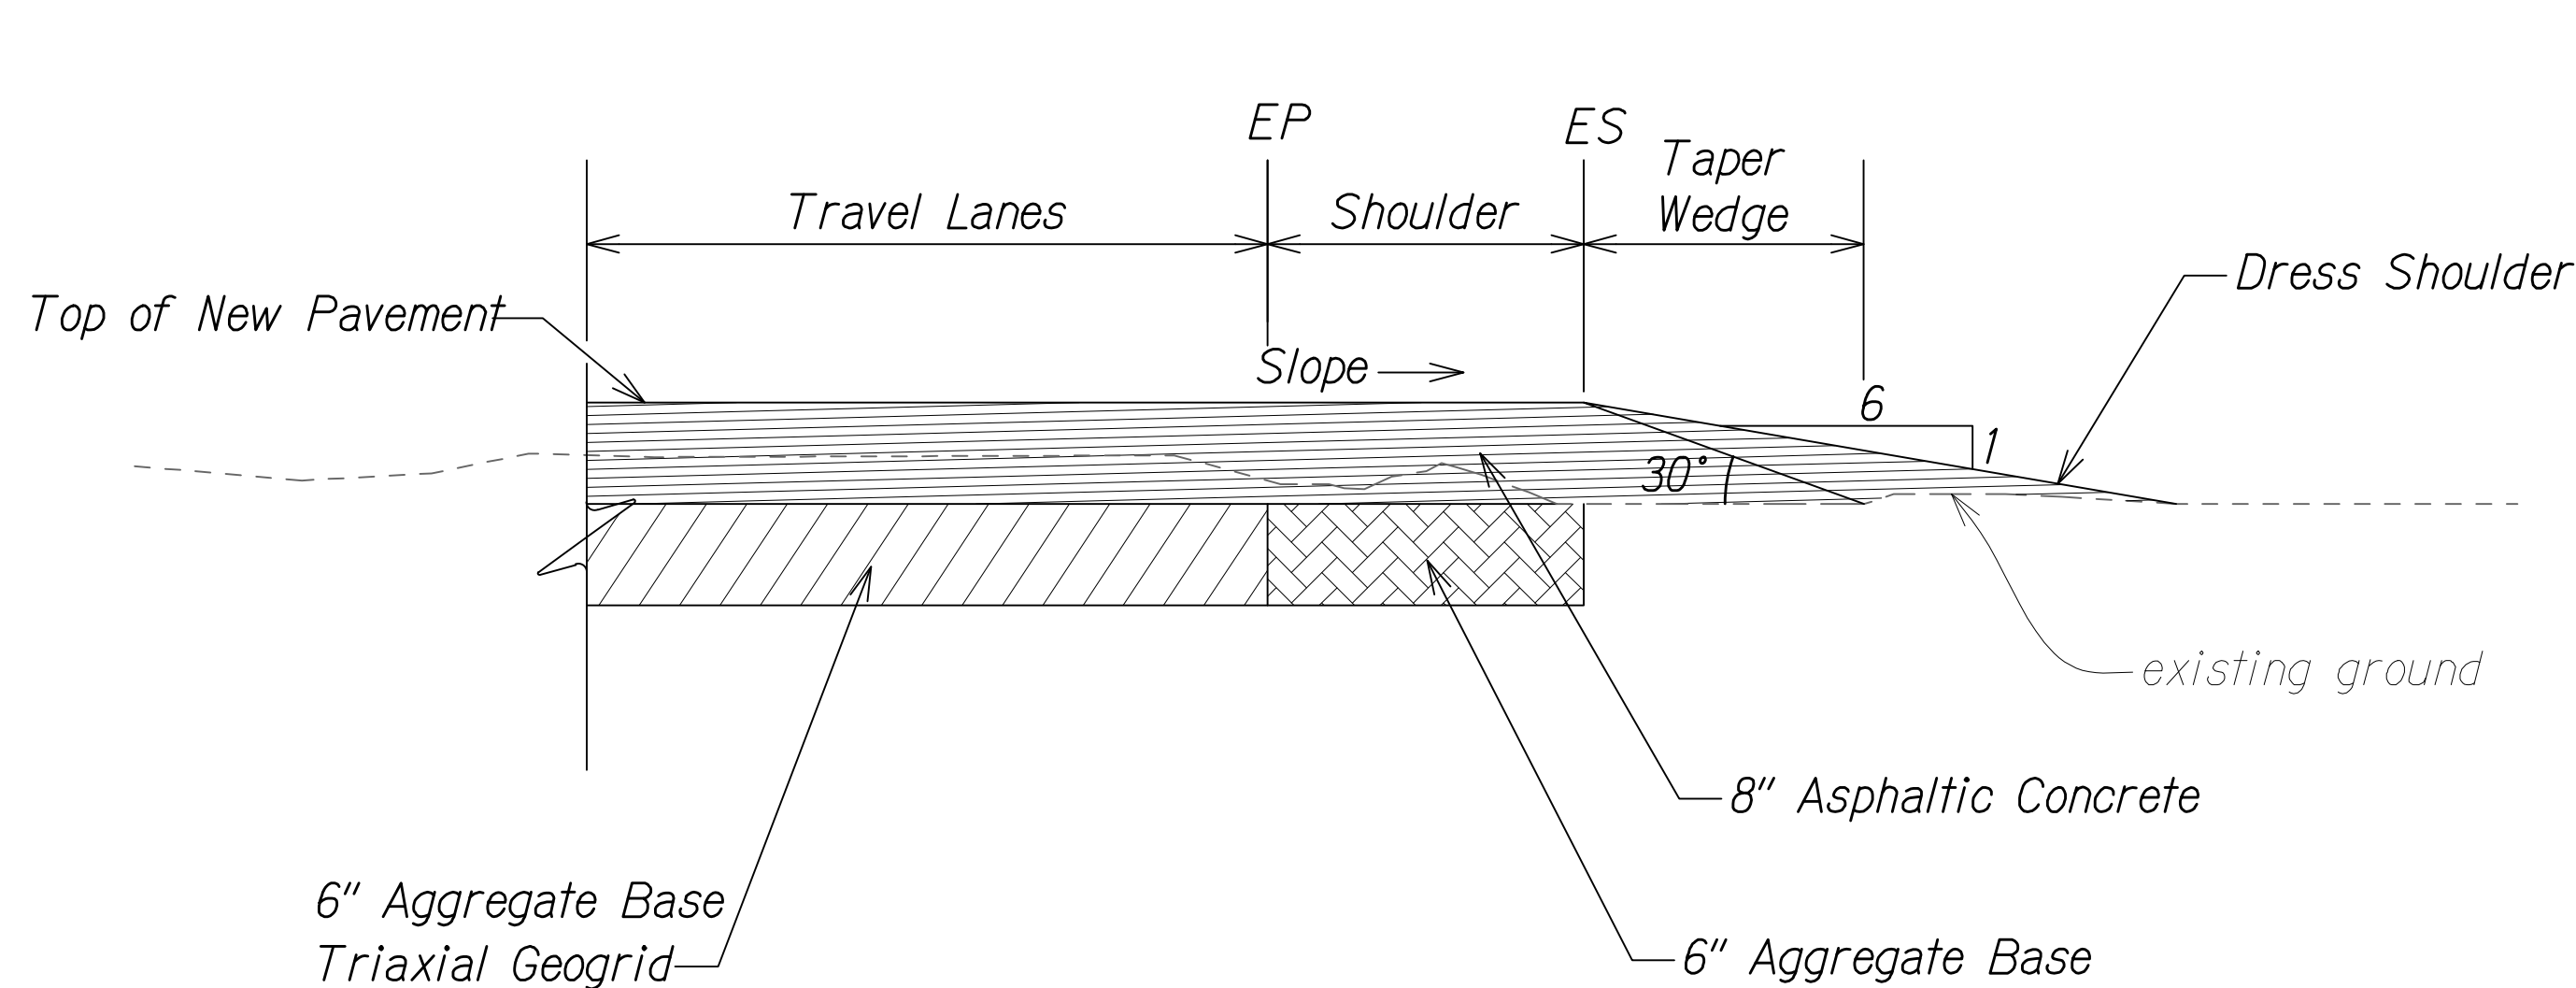

Typical Pavement Edge Detail (For New Pavement)

Scale: N.T.S.

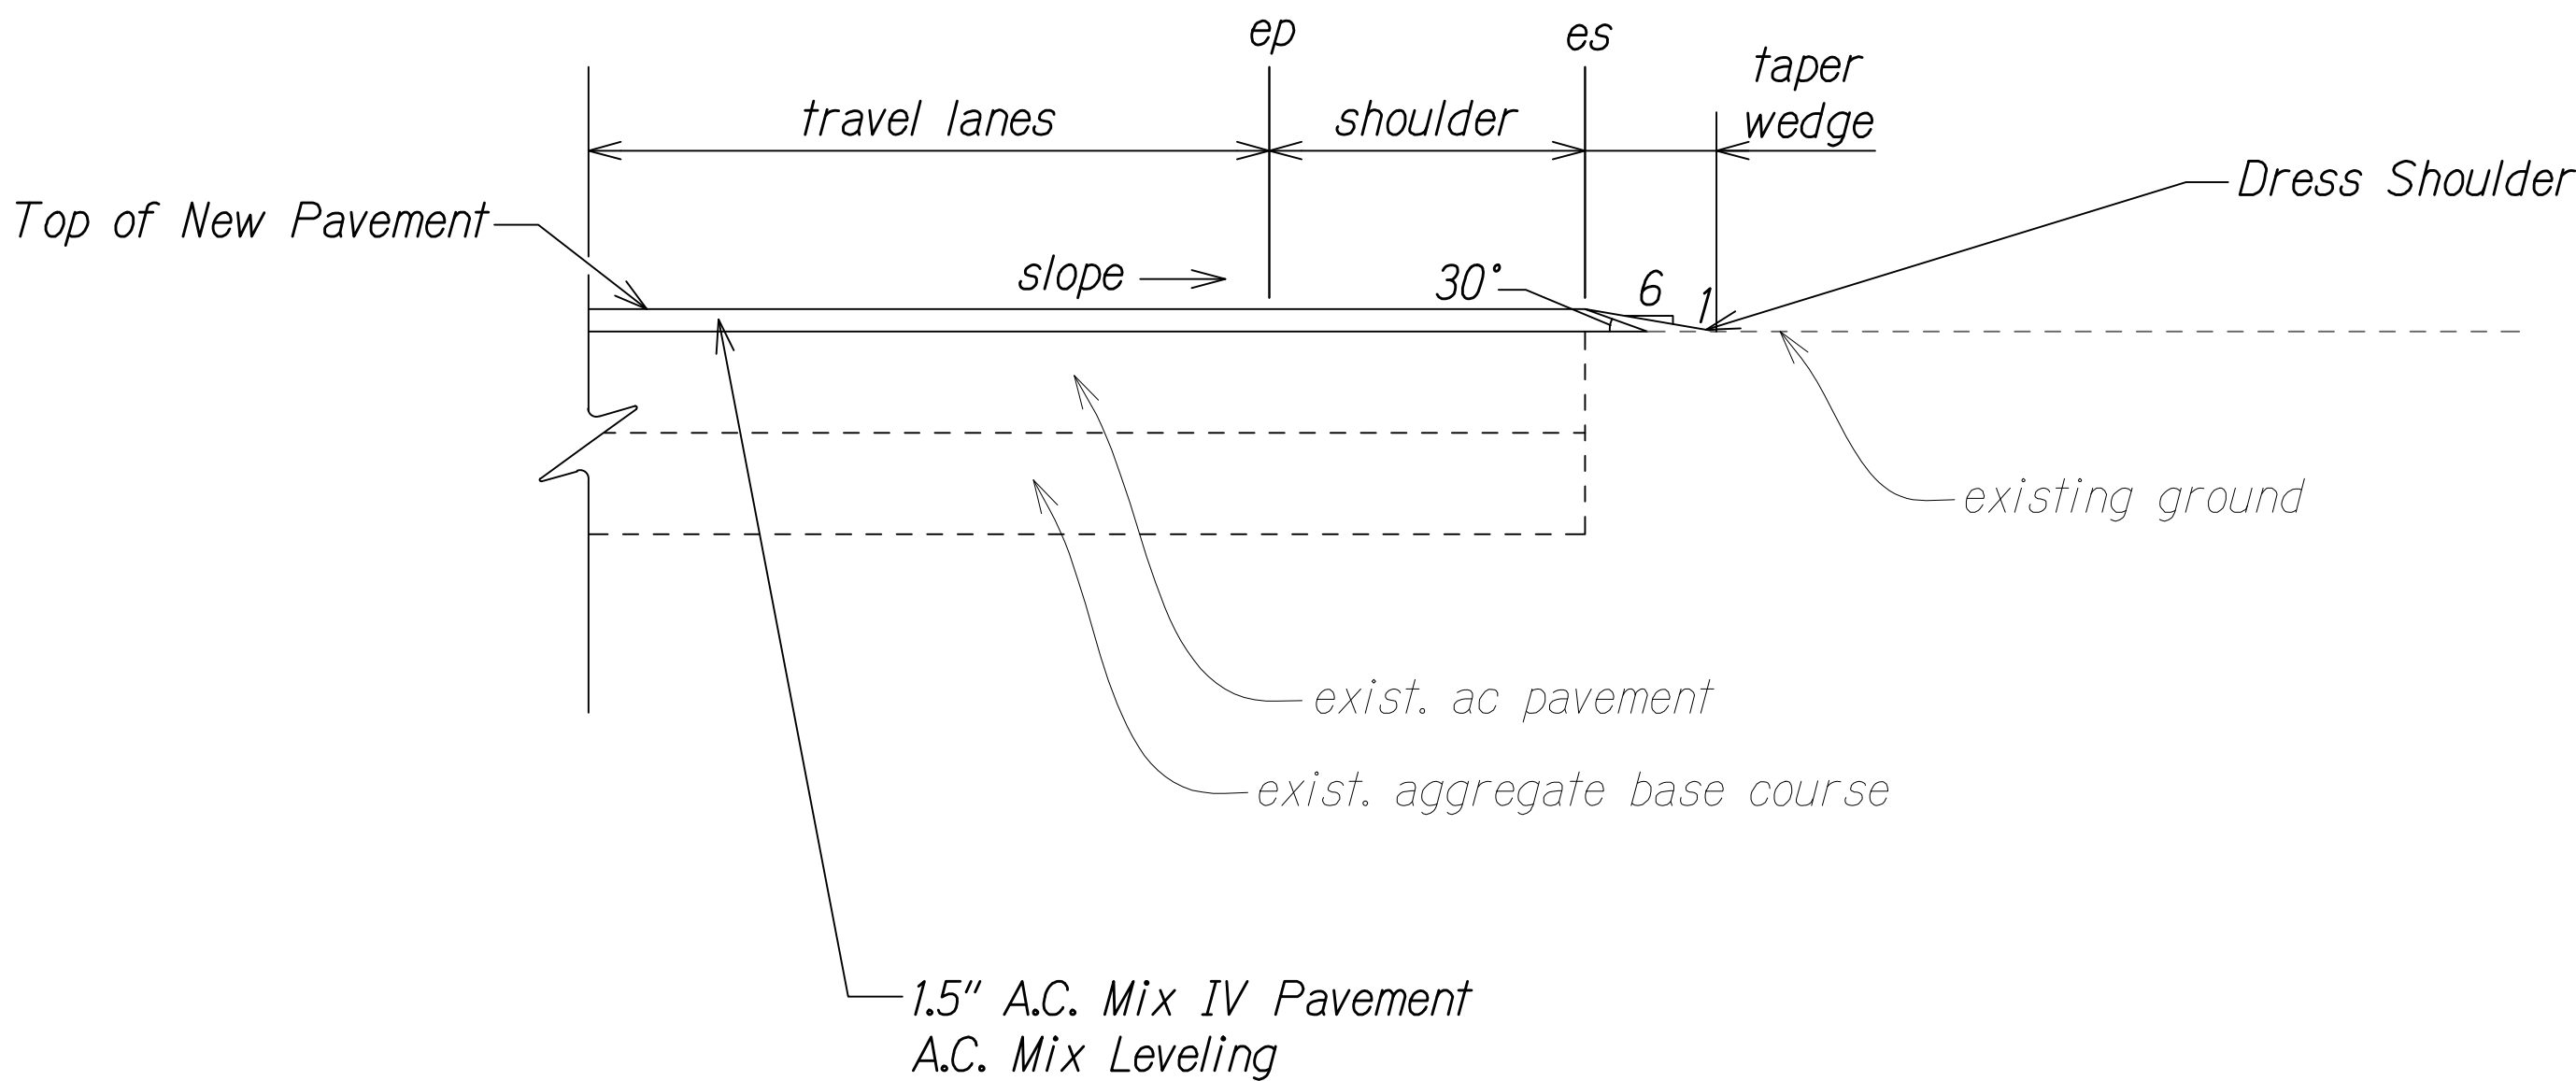

Typical Pavement Edge Detail (For Overlaying Project)

Scale: N.T.S.

NOTES:

Contractor shall mount a device directly on the paver screed extension to provide a 30° beveled shoulder edge.

ORIGINAL PLAN	SURVEY PLOTTED BY	DATE
NOTE BOOK	DESIGNED BY	"
No.	QUANTITIES BY	"
	CHECKED BY	"

W:_CIVIL_3D_PROJECTS\2008_003_001_GBI_QUEEN_K_HWY_WIDENING\01_CIVIL_DRAWINGS\037_PAVEMENT SAFETY_EDGE_DETAIL.DWG 7/26/2016 4:24 PM

LEGEND FOR
AS-BUILT POSTINGS

~~~~~

~~100.00~~

Roadway

Squiggly line for as-built deletion

Double line for as-built deletion

Text for as-built posting

AUSTEN W. DRAKE  
LICENSED PROFESSIONAL ENGINEER  
NO. 13059-C  
HAWAII, USA

THIS WORK WAS PREPARED BY ME OR UNDER MY SUPERVISION AND CONSTRUCTION OF THIS PROJECT WILL BE UNDER MY OBSERVATION.  
Signature: *Austen W. Drake*  
EXPIRATION DATE OF THE LICENSE: APRIL 30, 2018

STATE OF HAWAII  
DEPARTMENT OF TRANSPORTATION  
HIGHWAYS DIVISION

PAVEMENT SAFETY  
EDGE DETAIL

QUEEN KAAHUMANU HIGHWAY WIDENING  
Kealahou Pkwy. To Keahole Airport Rd.(Ph. 2)  
Federal Aid Project No. NH-019-1(38)R

Scale: AS NOTED Date: AUGUST 2016

SHEET No. 1 OF 1 SHEETS

"AS-BUILT"

7/27/2016 9:29 AM