

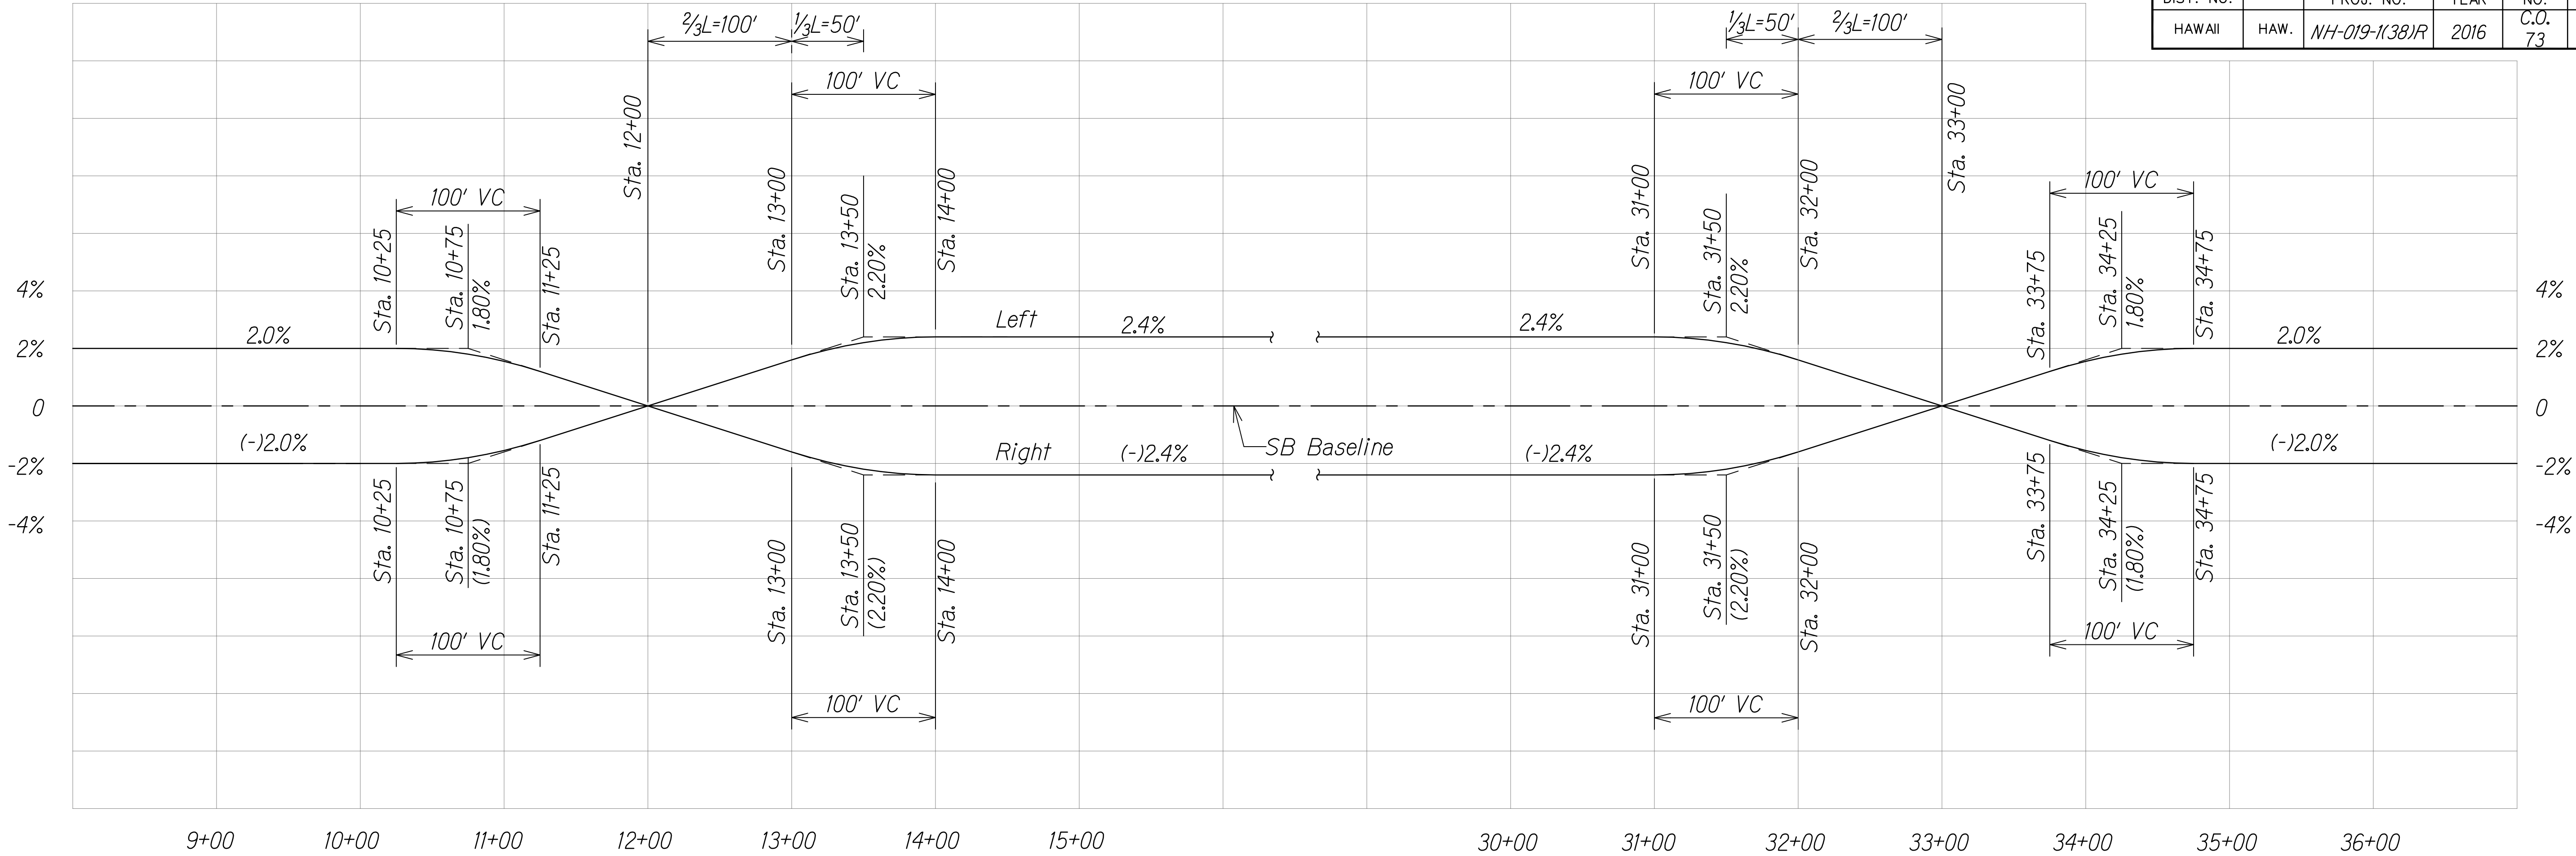


FED. ROAD DIST. NO.	STATE	FED. AID PROJ. NO.	FISCAL YEAR	SHEET NO.	TOTAL SHEETS
HAWAII	HAW.	NH-019-1(38)R	2016	C.O. 73	528 522

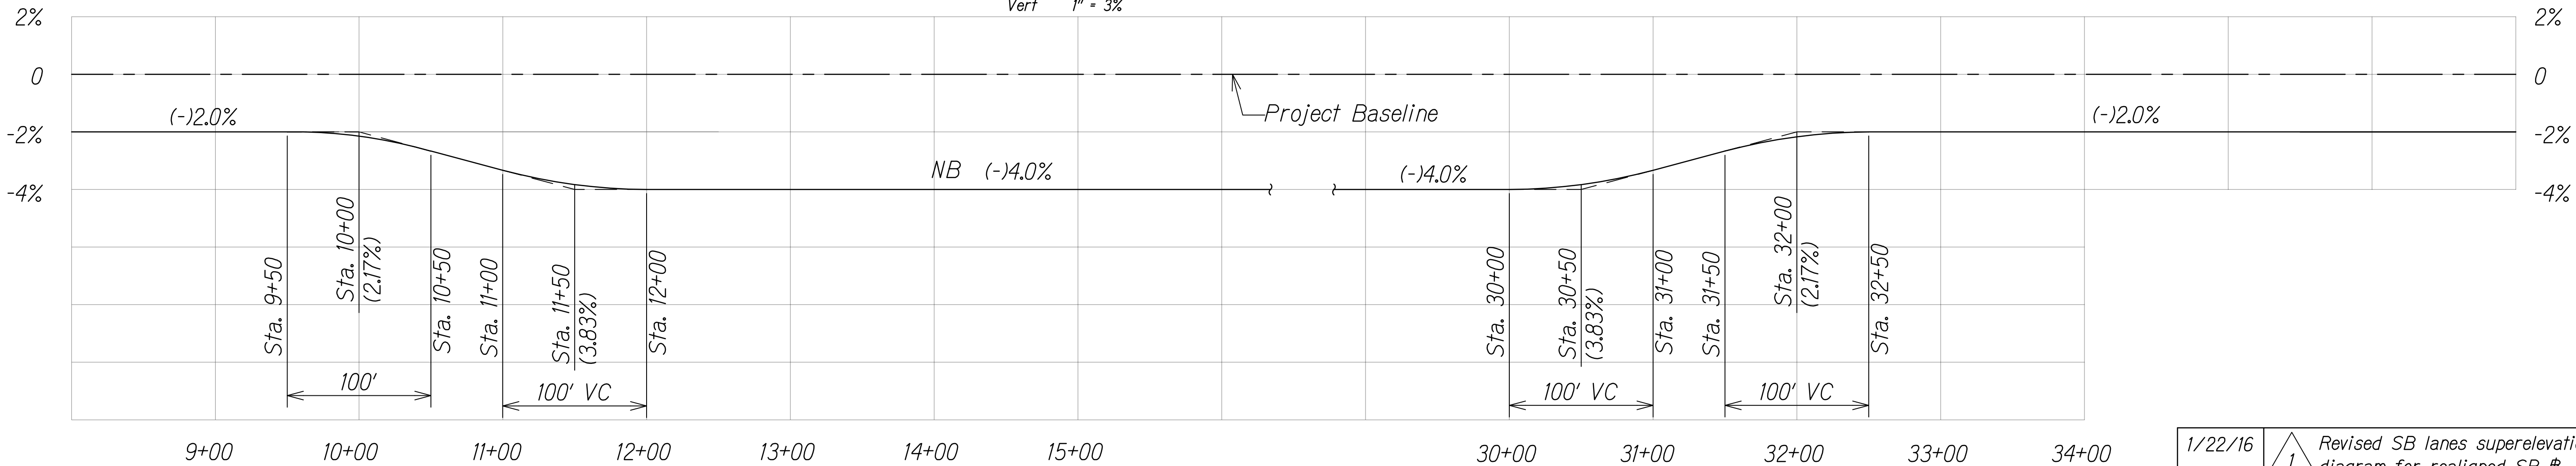

SB @ PC Sta. 13+21.83 to SB @ PT Sta. 31+74.20


Scale: Horiz 1" = 60'
Vert 1" = 3%

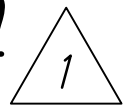

Project @ PC Sta. 10+76.95 to Project @ PT Sta. 31+71.71


Scale: Horiz 1" = 60'
Vert 1" = 3%

GRAPHICAL SCALE:

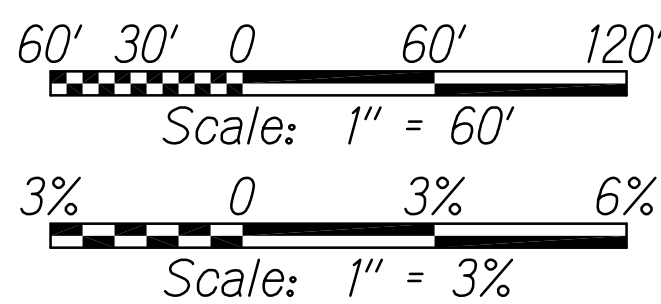

**LEGEND FOR
AS-BUILT POSTINGS**

- Squiggly line for as-built deletion
- Double line for as-built deletion
- Roadway Text for as-built posting

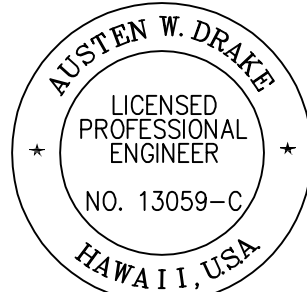

THIS WORK WAS PREPARED BY
ME OR UNDER MY SUPERVISION AND
CONSTRUCTION OF THIS PROJECT
WILL BE UNDER MY OBSERVATION.
Austin W. Drake APRIL 30, 2018
SIGNATURE EXPIRATION DATE
OF THE LICENSE

1/22/16	Revised SB lanes superelevation diagram for realigned SB @
DATE	REVISION

STATE OF HAWAII
DEPARTMENT OF TRANSPORTATION
HIGHWAYS DIVISION

SUPERELEVATION DIAGRAMS

QUEEN KAAHUMANU HIGHWAY WIDENING
Kealakehe Pkwy. To Keahole Airport Rd.(Ph. 2)
Federal Aid Project No. NH-019-1(38)R


Scale: AS NOTED Date: AUGUST 2016

SHEET No. 1 OF 3 SHEETS

"AS-BUILT"

C.O. 73

FED. ROAD DIST. NO.	STATE	FED. AID PROJ. NO.	FISCAL YEAR	SHEET NO.	TOTAL SHEETS
HAWAII	HAW.	NH-019-1(38)R	2016	74	528 522

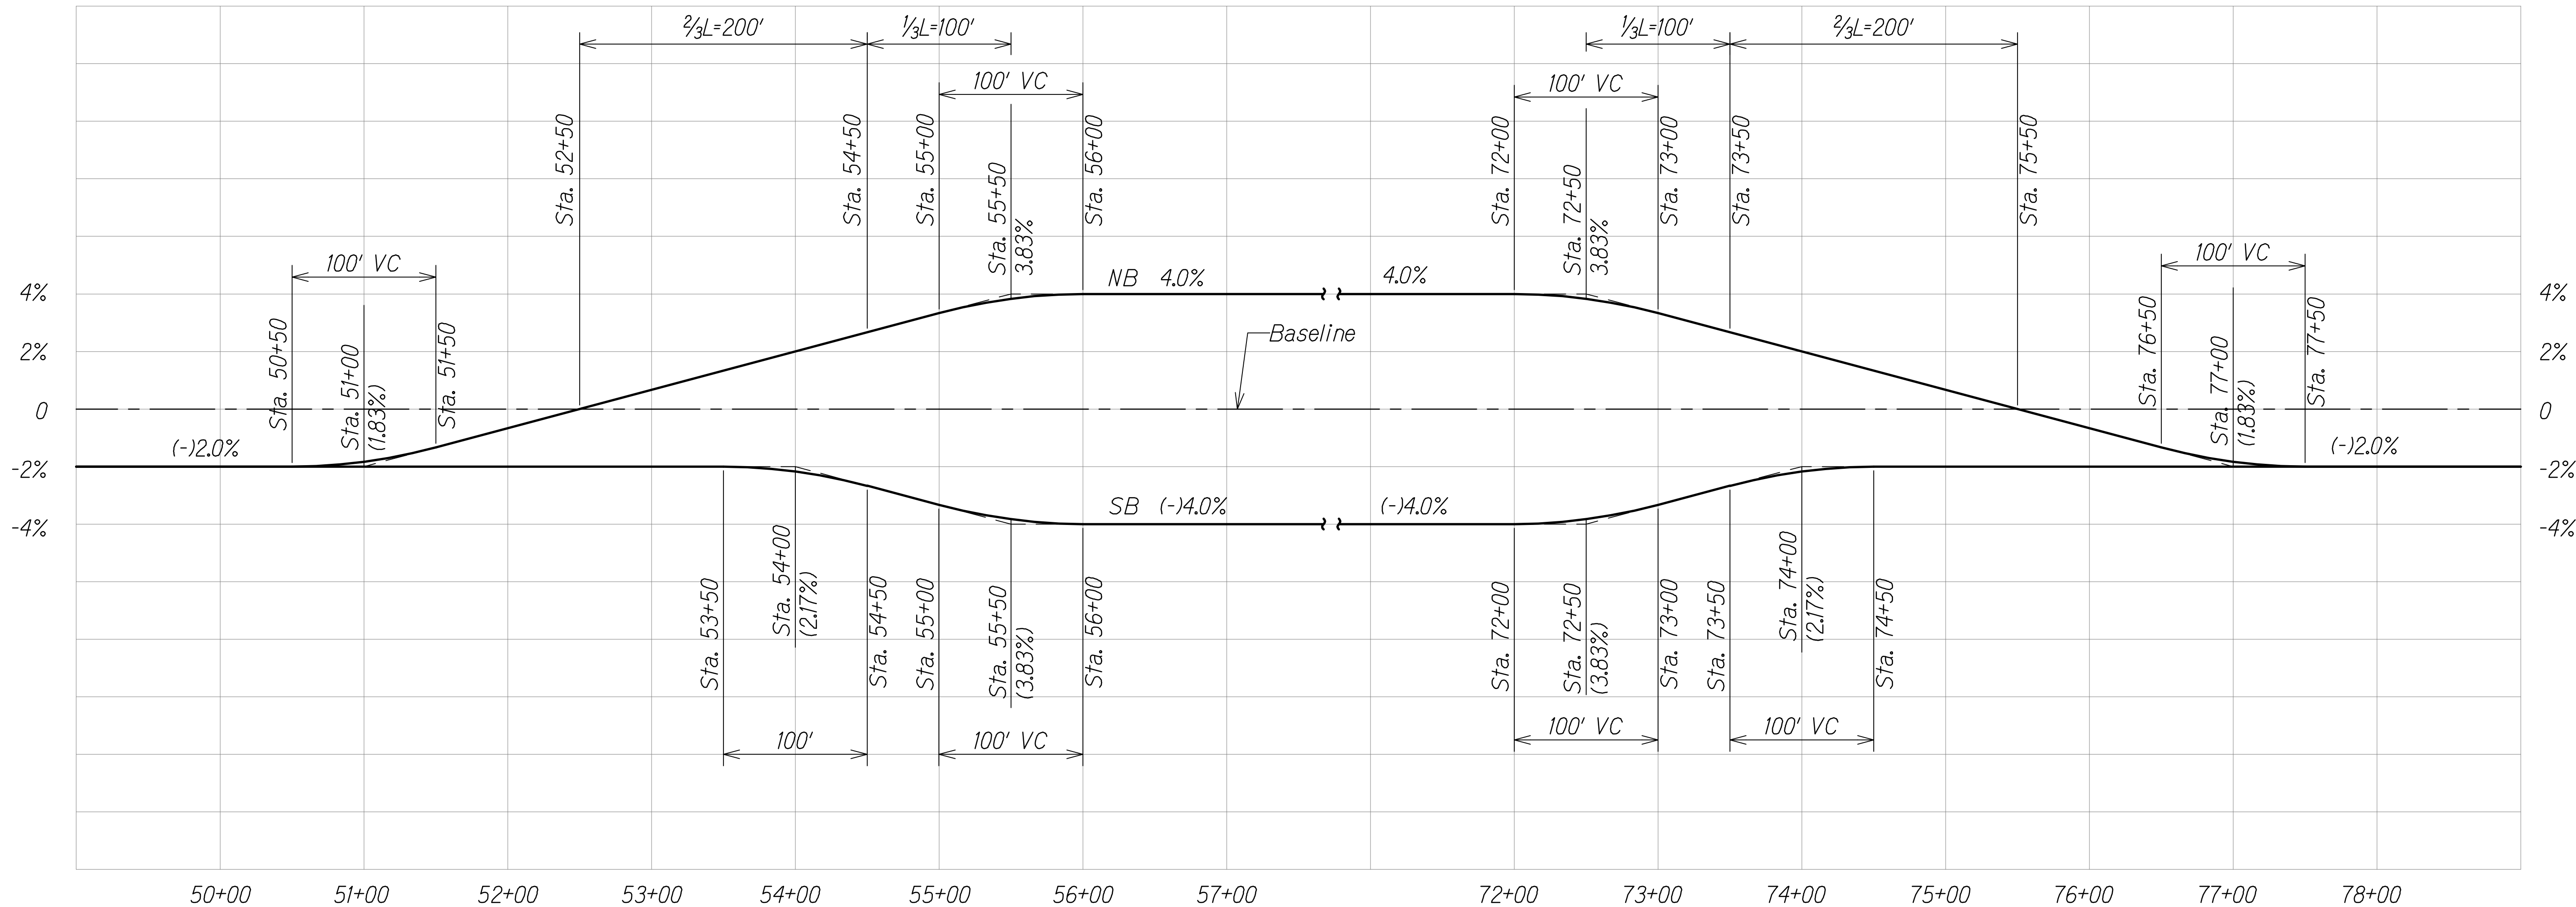

Project @ PC Sta. 54+64.97 to Project @ PT Sta. 73+72.74

Scale: Horiz 1" = 60'
Vert 1" = 3%

ORIGINAL PLAN	DESIGNED BY	DATE
NOTE BOOK	DESIGNED BY	
No.	CHECKED BY	

W:_CIVIL_3D_PROJECTS\2008_003_001_GBI_QUEEN_K_Hwy_WIDENING\SUPERELEVATION DIAGRAM.DWG 3/22/2012 11:20 AM

LEGEND FOR
AS-BUILT POSTINGS

Squiggly line for as-built deletion

Double line for as-built deletion

Roadway

Text for as-built posting

AUSTEN W. DRAKE
LICENSED PROFESSIONAL ENGINEER
NO. 13059-C
HAWAII, USA

THIS WORK WAS PREPARED BY ME OR UNDER MY SUPERVISION AND CONSTRUCTION OF THIS PROJECT WILL BE UNDER MY OBSERVATION.
Austen W. Drake
SIGNATURE
APRIL 30, 2018
EXPIRATION DATE OF THE LICENSE

STATE OF HAWAII
DEPARTMENT OF TRANSPORTATION
HIGHWAYS DIVISION

SUPERELEVATION DIAGRAMS

QUEEN KAAHUMANU HIGHWAY WIDENING
Kealahou Pkwy. To Keahole Airport Rd.(Ph. 2)
Federal Aid Project No. NH-019-1(38)R


Scale: AS NOTED Date: MAY 2012

SHEET No. 2 OF 3 SHEETS

"AS-BUILT"

5/23/2012 9:15 AM

FED. ROAD DIST. NO.	STATE	FED. AID PROJ. NO.	FISCAL YEAR	SHEET NO.	TOTAL SHEETS
HAWAII	HAW.	NH-019-1(38)R	2016	75	528 522

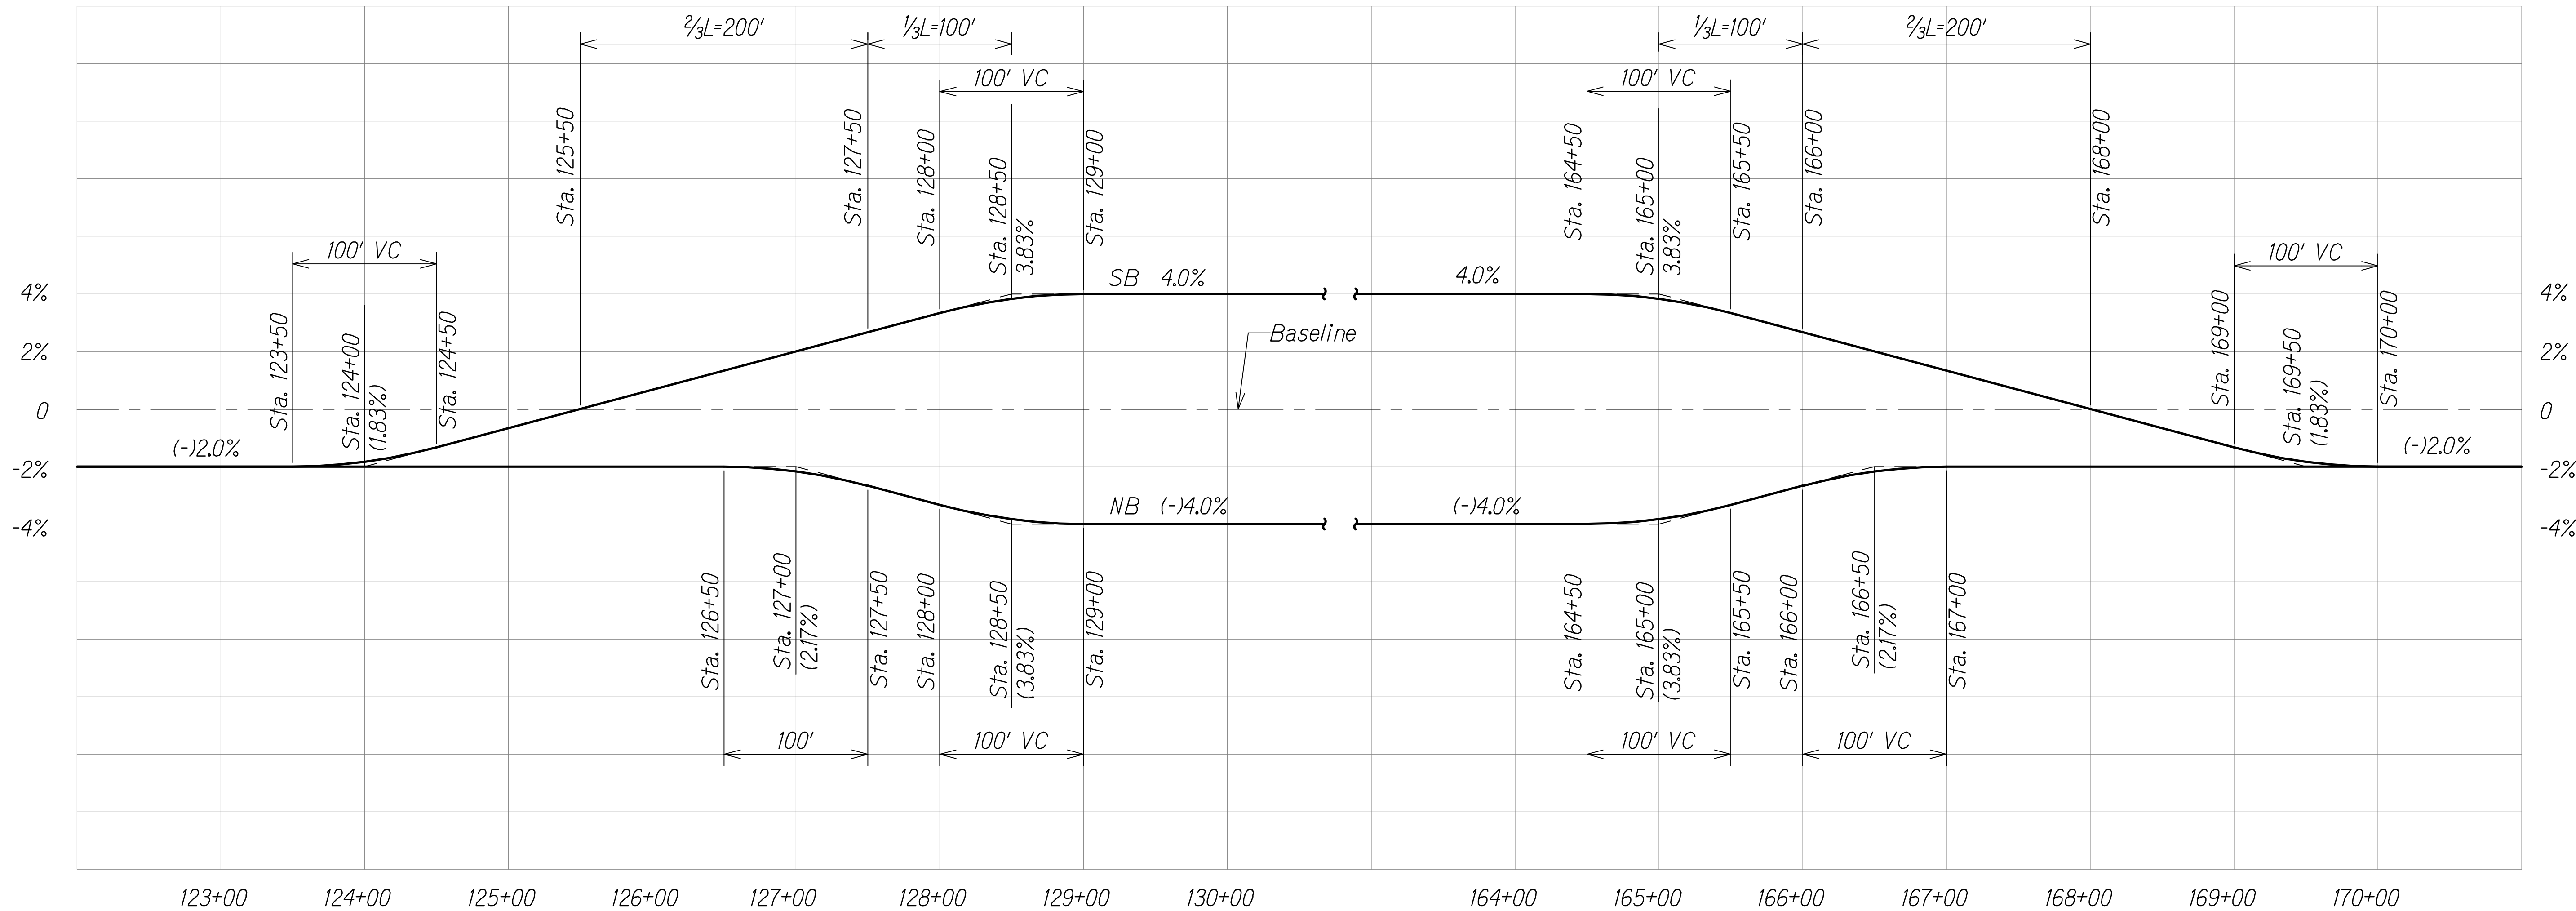

Project # PC Sta. 130+87.27 to Project # PT Sta. 166+05.34

Scale: Horiz 1" = 60'
Vert 1" = 3%

ORIGINAL PLAN	DESIGNED BY	DATE
NOTE BOOK	DESIGNED BY	
No.	CHECKED BY	

W:_CIVIL_3D_PROJECTS\2008_003_001_GBI_QUEEN_K_Hwy_WIDENING\SUPERELEVATION DIAGRAM.DWG 3/22/2012 11:20 AM

LEGEND FOR
AS-BUILT POSTINGS

Squiggly line for as-built deletion

Double line for as-built deletion

Roadway Text for as-built posting

THIS WORK WAS PREPARED BY
ME OR UNDER MY SUPERVISION AND
CONSTRUCTION OF THIS PROJECT
WILL BE UNDER MY OBSERVATION.

APRIL 30, 2018
SIGNATURE EXPIRATION DATE OF THE LICENSE

STATE OF HAWAII
DEPARTMENT OF TRANSPORTATION
HIGHWAYS DIVISION

SUPERELEVATION DIAGRAMS

QUEEN KAAHUMANU HIGHWAY WIDENING
Kealahou Pkwy. To Keahole Airport Rd.(Ph. 2)
Federal Aid Project No. NH-019-1(38)R

Scale: AS NOTED Date: MAY 2012

SHEET No. 3 OF 3 SHEETS

"AS-BUILT"

5/23/2012 9:16 AM