


WESLEY R. SEGAWA & ASSOC. HWY-HE 933-8866 JAN 2006
DESIGNED BY MANAGED BY PHONE DATE



INDEX TO DRAWINGS	
SHEET NO.	DESCRIPTION
1	TITLE SHEET
2	STANDARD PLANS SUMMARY
3	GENERAL NOTES AND LEGEND
4-7	CONSTRUCTION NOTES
8	TYPICAL SECTIONS
9	GENERAL PLAN
10	HALAULANI PLACE MODIFICATION
11	CURB RETURN AND PAVEMENT ELEVATIONS
12	END SIDEWALK
13	CONCRETE LANDING DETAIL AND CHAINLINK FENCE ELEVATION
14	TYPICAL SECTIONS
15	CURB DETAILS
16	CONSTRUCTION DETAILS
17	HALAULANI PLACE MODIFICATION ESTIMATED QUANTITIES AND PAY LIMITS
18	HALAULANI PLACE SIGNING PLAN
19	STANDARD TRAFFIC NOTES AND TRAFFIC SIGN SUMMARY
20-21	PARTIAL DEMOLITION PLAN
22	DEMOLITION ESTIMATED QUANTITIES AND PAY LIMITS, AND NOTES
23	EROSION CONTROL PLAN
24	EROSION CONTROL NOTES
25	EROSION CONTROL ESTIMATED QUANTITIES AND PAY LIMITS, DETAILS AND NOTES
26	GUARDRAIL PLAN, DETAIL AND NOTES
27	FLEAT - 350 (FLARED ENERGY ABSORBING TERMINAL)
28	STRONG POST W-BEAM GUARDRAIL
29	GUARDRAIL DETAILS AND NOTES
30	GROUTED RUBBLE PAVING PLAN
31	GROUTED RUBBLE PAVING DETAIL & SECTIONS
32	MODIFIED TYPE "A-1" FLARE PLAN
33	MODIFIED TYPE "A-1" FLARE DETAILS
34	MODIFIED TYPE "A-1" FLARE DETAILS
35-40	STRUCTURAL SHEETS
41	TCP AND GENERAL NOTES
42	TCP - HALAULANI PLACE
43	TRAFFIC CONTROL PLANS

STATE OF HAWAII
DEPARTMENT OF TRANSPORTATION
HIGHWAYS DIVISION
HONOLULU, HAWAII
"AS-BUILT"
PLANS FOR
HAWAII BELT ROAD
REMOVAL OF HALAULANI BRIDGE
FEDERAL AID PROJECT NO. BR-019-2(50)
DISTRICT OF SOUTH HILO
ISLAND OF HAWAII

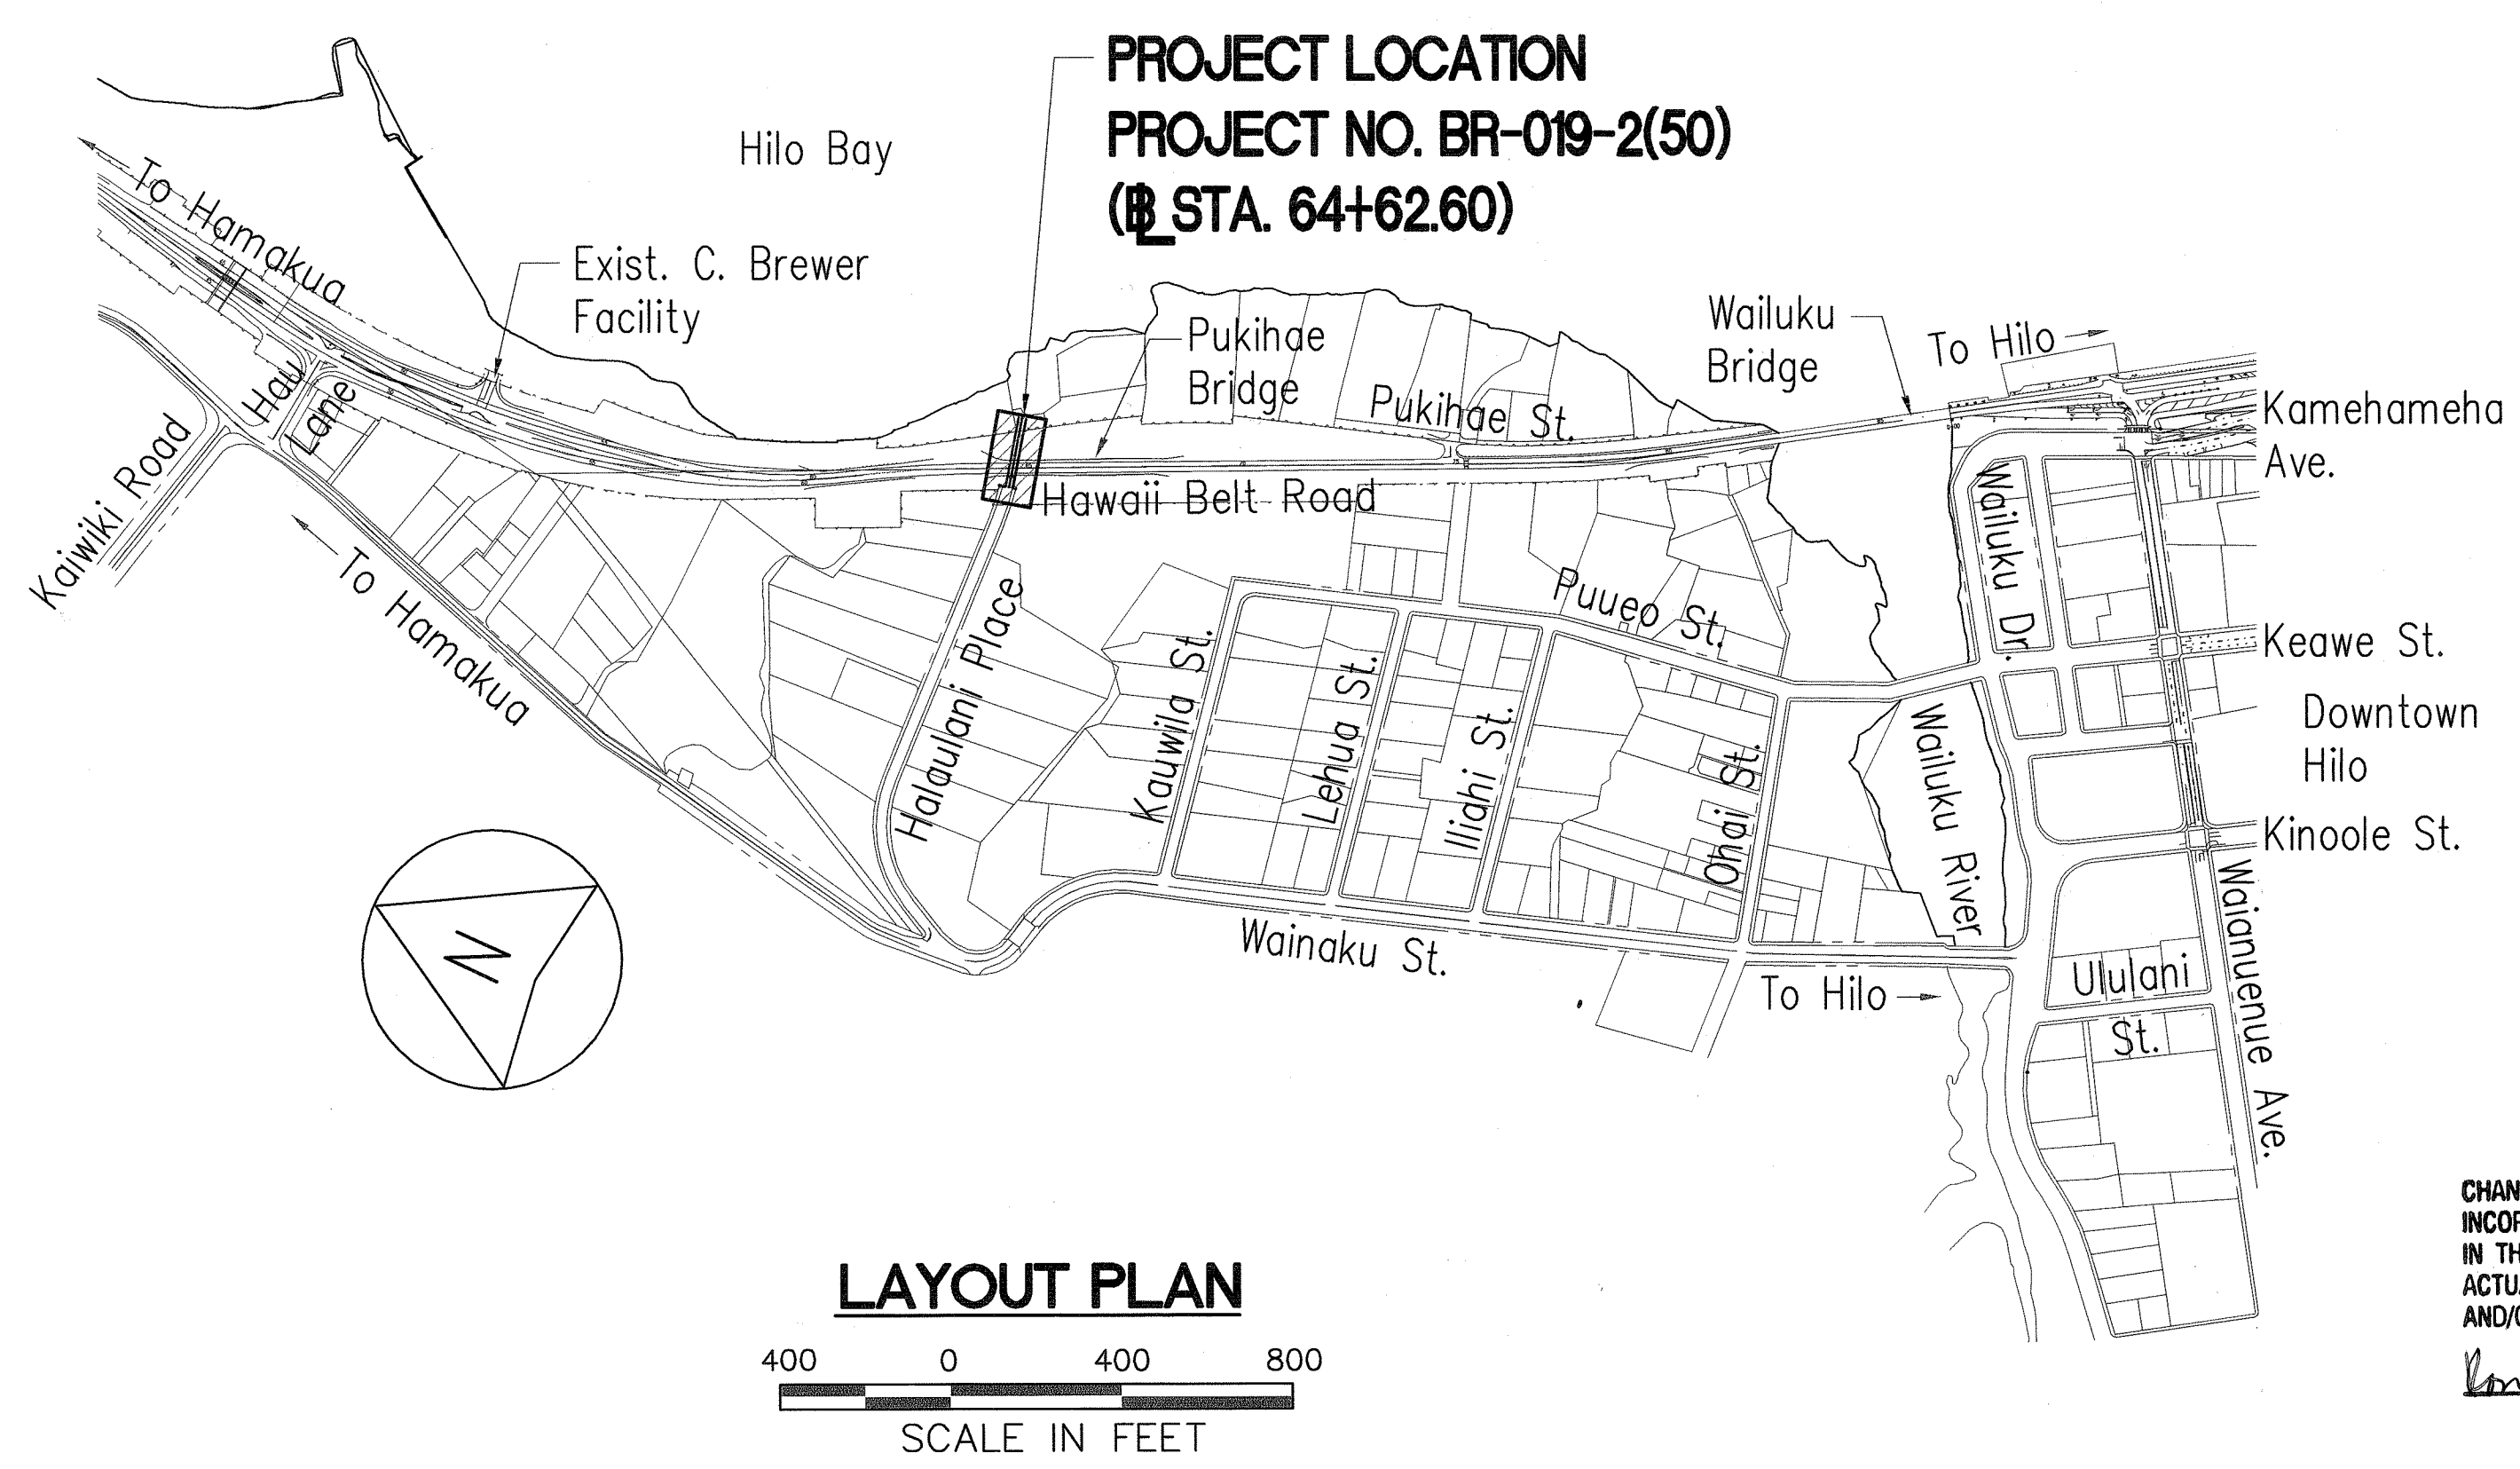

LAYOUT PLAN
400 0 400 800
SCALE IN FEET

FED. ROAD DIST. NO.	STATE	FED. AID PROJ. NO.	FISCAL YEAR	SHEET NO.	TOTAL SHEETS
HAWAII	HAW.	BR-019-2(50)	2006	1	43

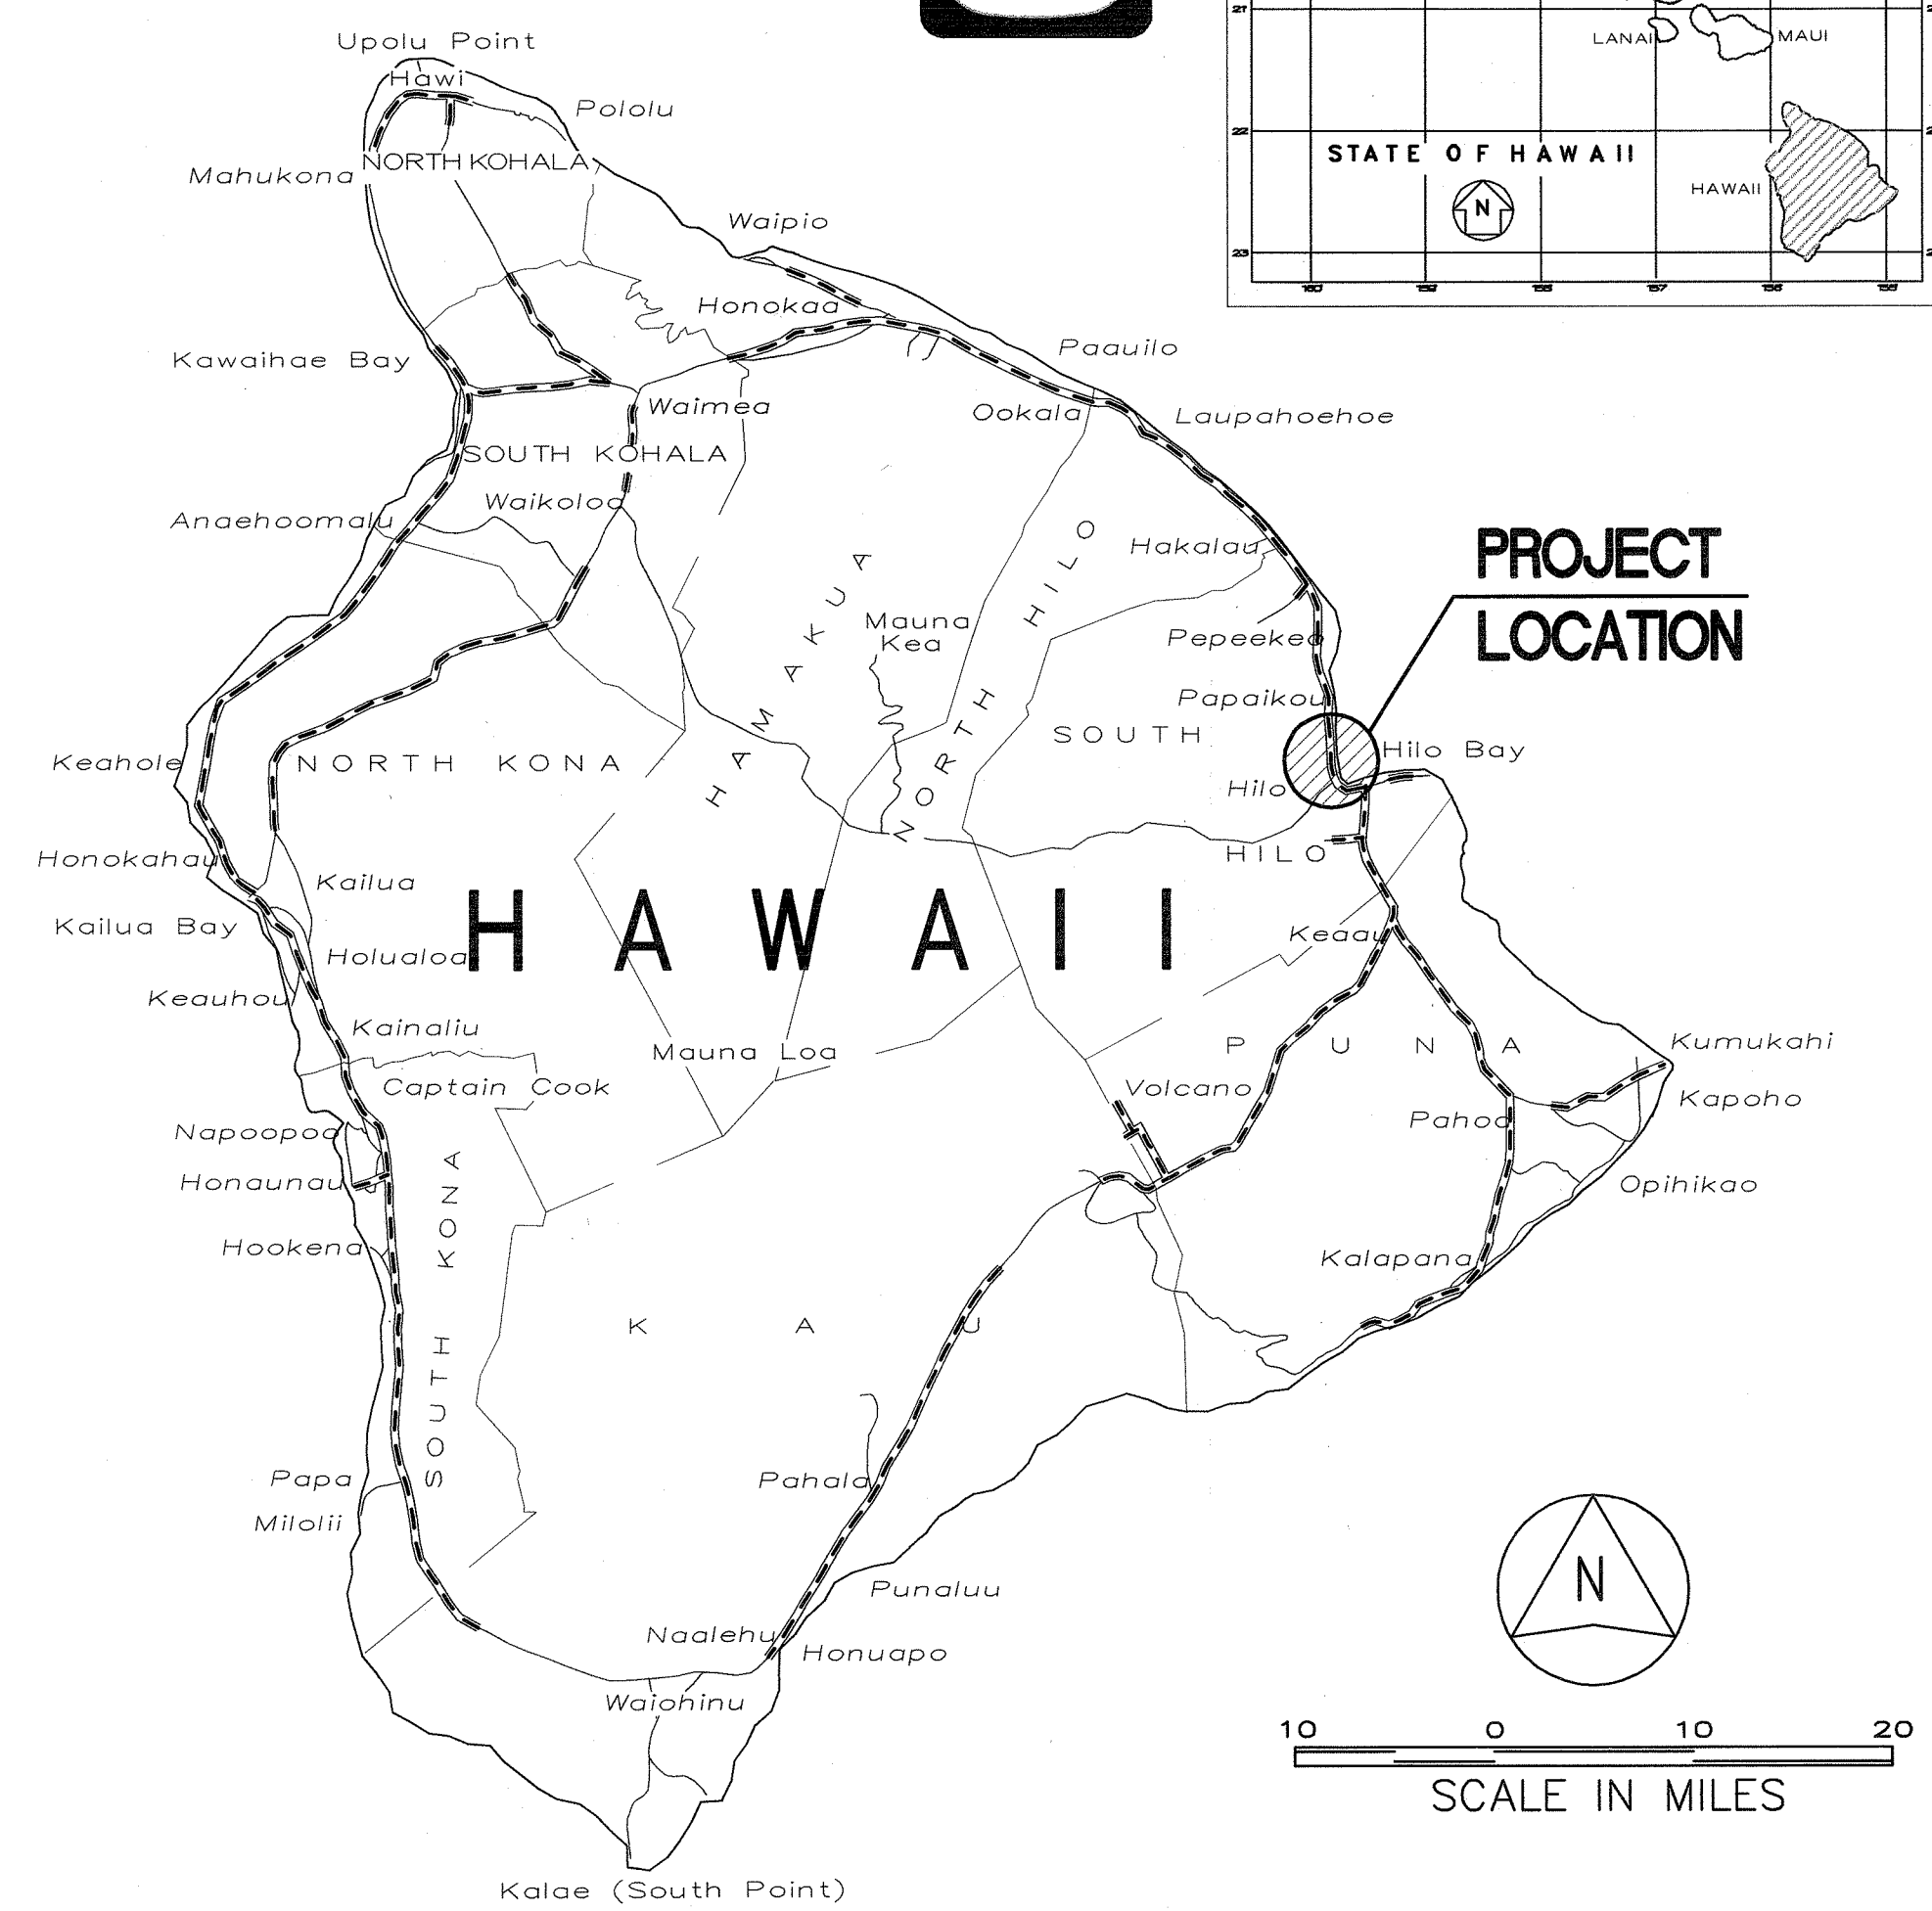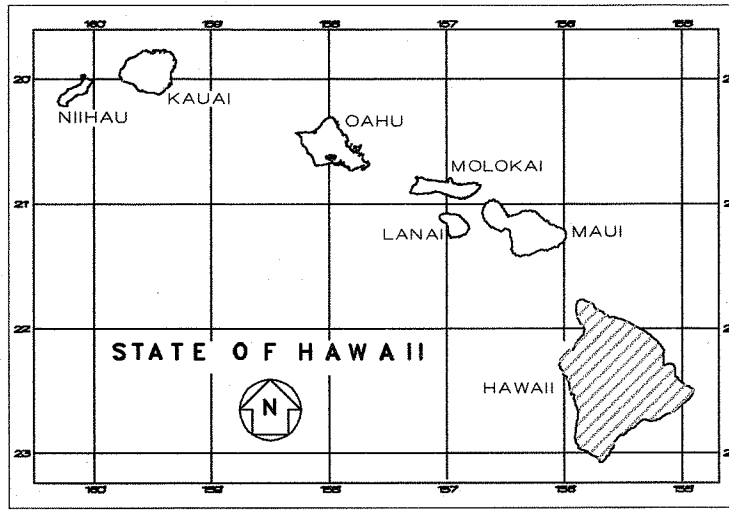

— FEDERAL AID PROJECTS PREVIOUSLY CONSTRUCTED OR UNDER CONSTRUCTION

MILE POST 2.89

DESIGN DESIGNATION

ADT (1998).....	15,725
ADT (2008).....	N/A
DHV.....	1,354
D.....	60/40
T ₂₄	5.5
V.....	45

CHANGES MADE DURING CONSTRUCTION HAVE BEEN INCORPORATED ON THESE PLANS EXCEPT CHANGES IN THE ORIGINAL THEORETICAL QUANTITIES. FOR ACTUAL QUANTITIES, REFER TO PROJECT LEDGER AND/OR COMPUTATION BOOK.
Resident Engineer 9/27/10 DATE

DEPARTMENT OF TRANSPORTATION
STATE OF HAWAII
APPROVED: 1-13-06
DIR. OF TRANSPORTATION DATE