

INDEX TO DRAWINGS	
SHEET NO.	DESCRIPTION
1	TITLE SHEET
2	STANDARD PLANS SUMMARY
3	GENERAL NOTES, DRAINAGE NOTES, UTILITY NOTES & LEGEND
4-5	WATER POLLUTION AND EROSION CONTROL NOTES
6	DRAINAGE SUMMARY
7	TYPICAL SECTIONS
8-9	DRAINAGE PLANS
10	CROSS SECTIONS
11	DRAINAGE PROFILES
12-15	DRAINAGE DETAILS
16	TRAFFIC CONTROL NOTES
17	CONSTRUCTION SIGN PLAN

STATE OF HAWAII

DEPARTMENT OF TRANSPORTATION

HIGHWAYS DIVISION

HONOLULU, HAWAII

"AS-BUILT"

PLANS FOR

HAWAII BELT ROAD


DRAINAGE IMPROVEMENTS

VICINITY OF HONOLII BRIDGE

PROJECT NO. 19J-01-03

DISTRICT OF SOUTH HILO




ISLAND OF HAWAII

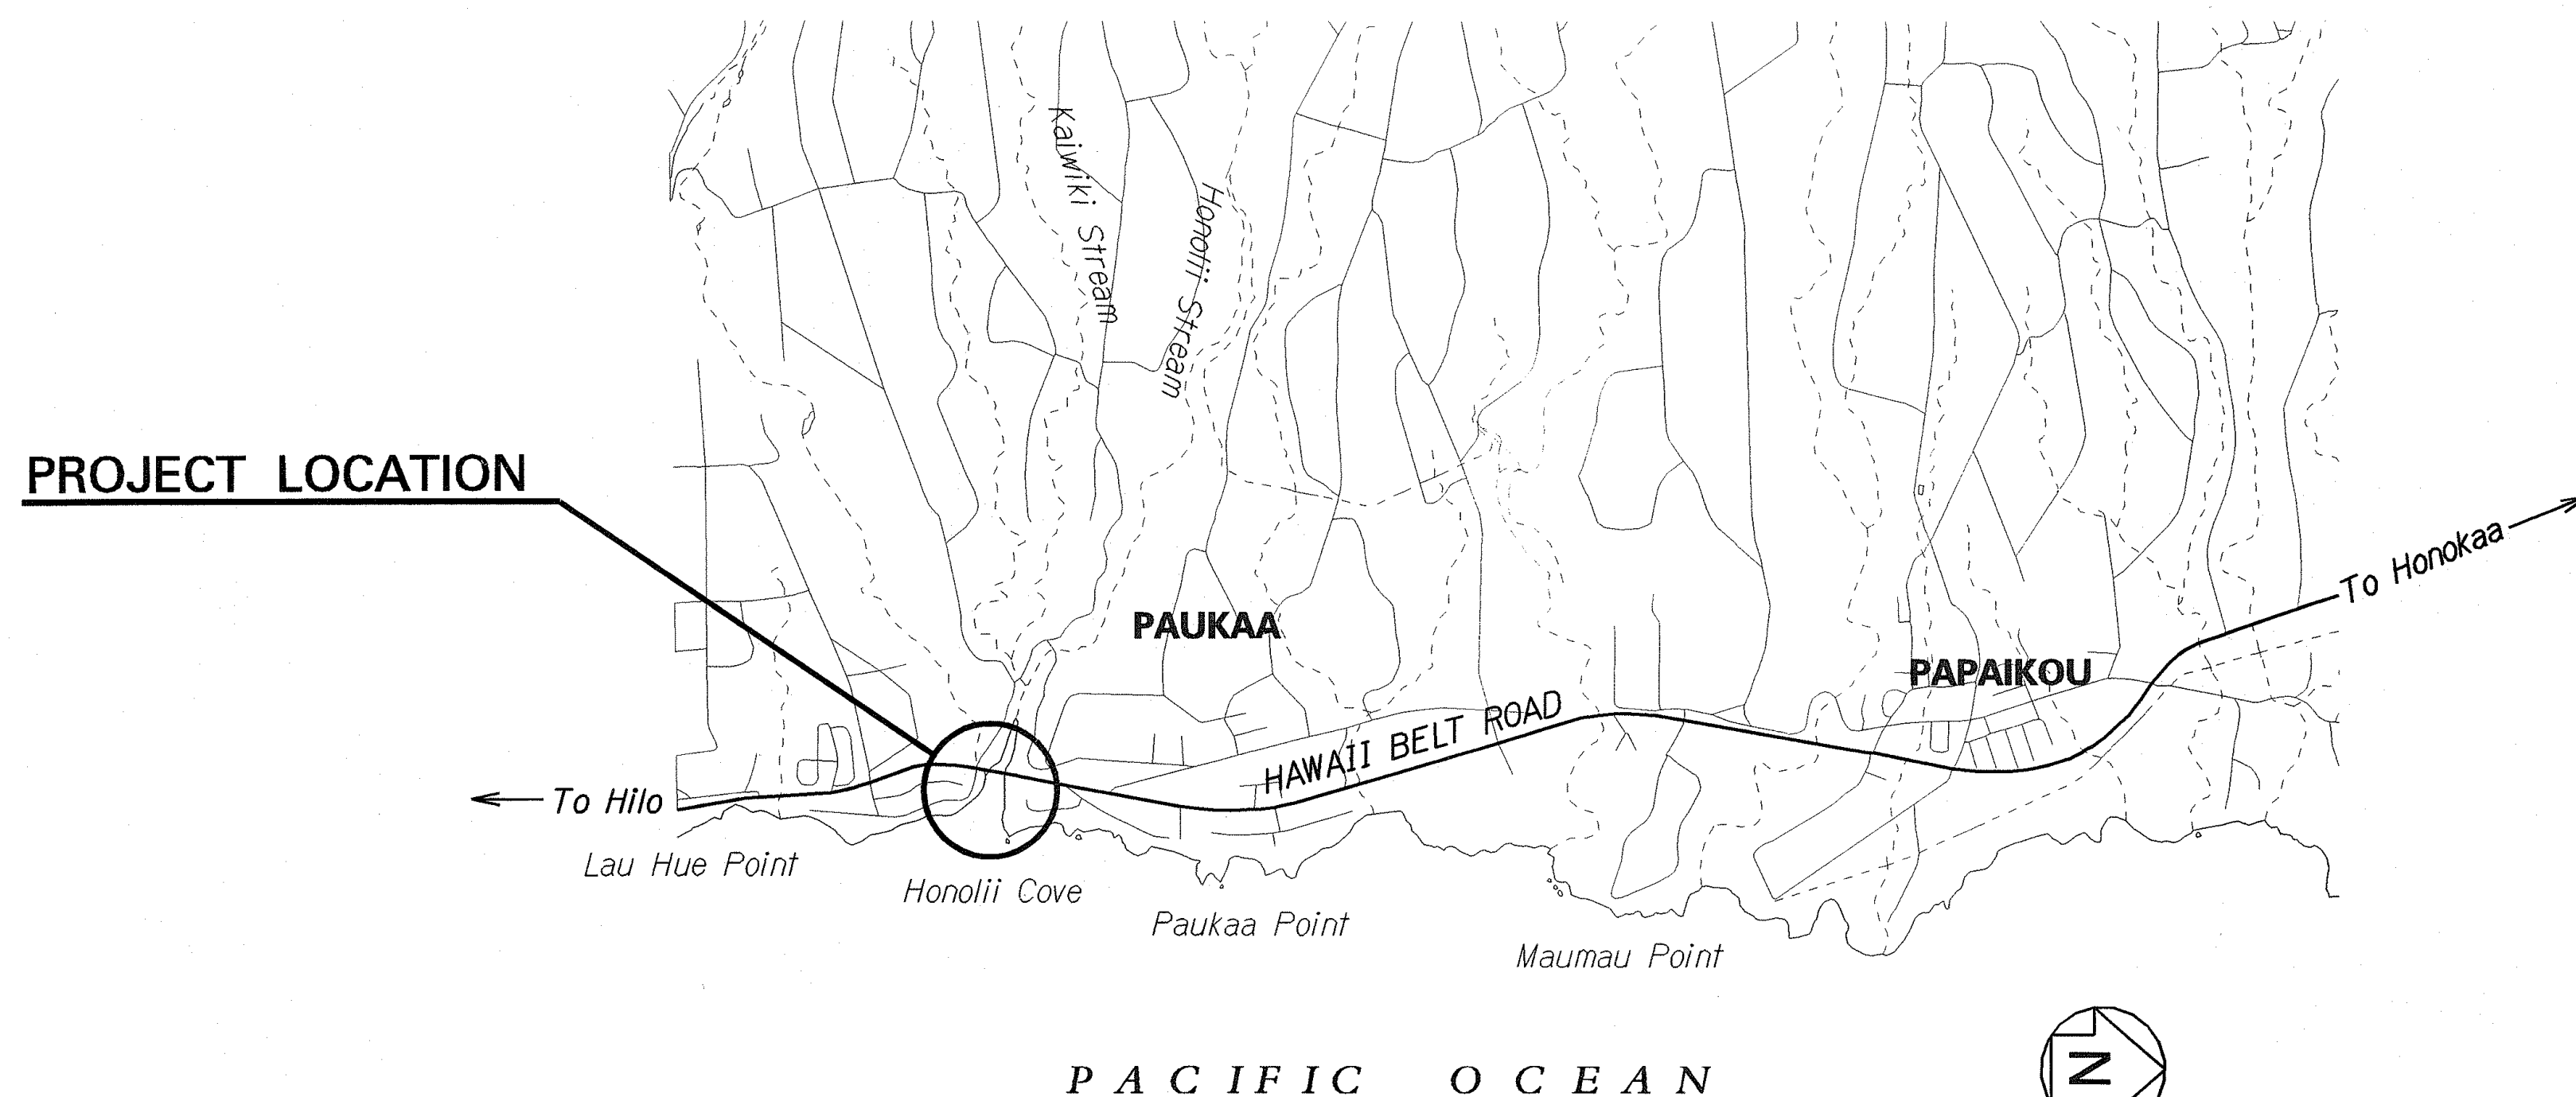

LAYOUT PLAN

GROSS LENGTH OF PROJECT.....0.3 MILES

FED. ROAD DIST. NO.	STATE	PROJ. NO.	FISCAL YEAR	SHEET NO.	TOTAL SHEETS
HAWAII	HAW.	19J-01-03	2005	1	17

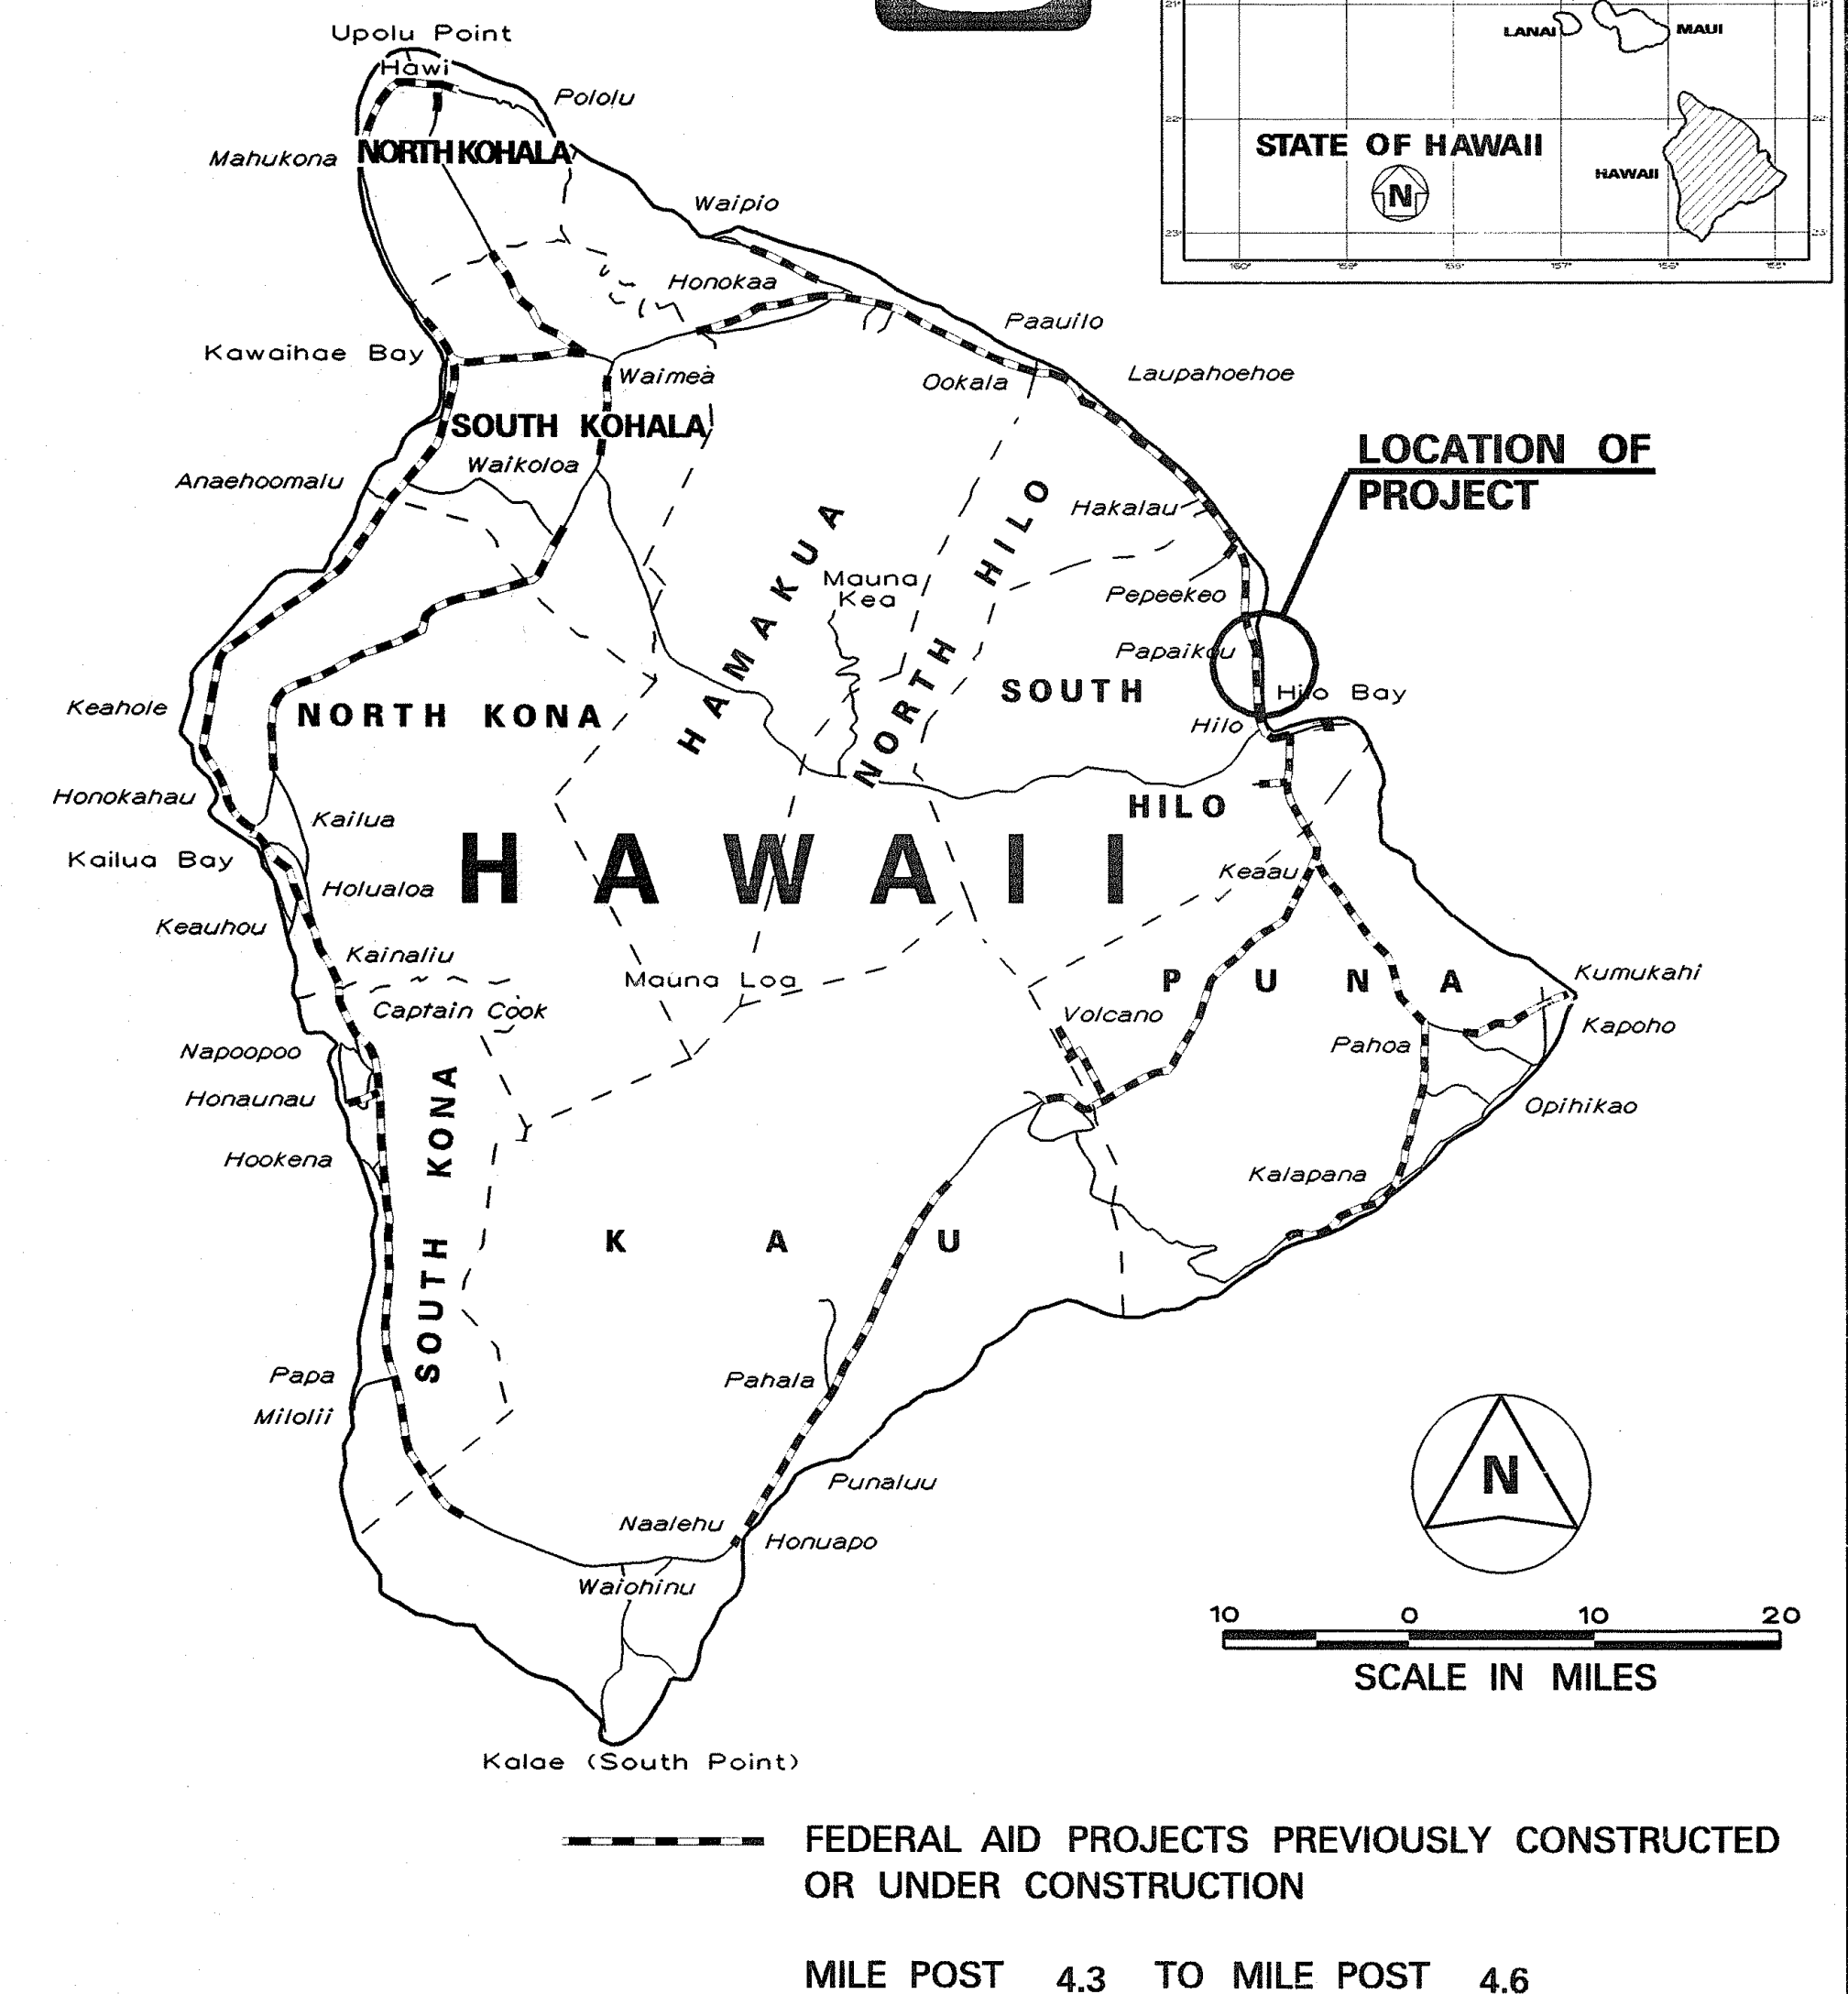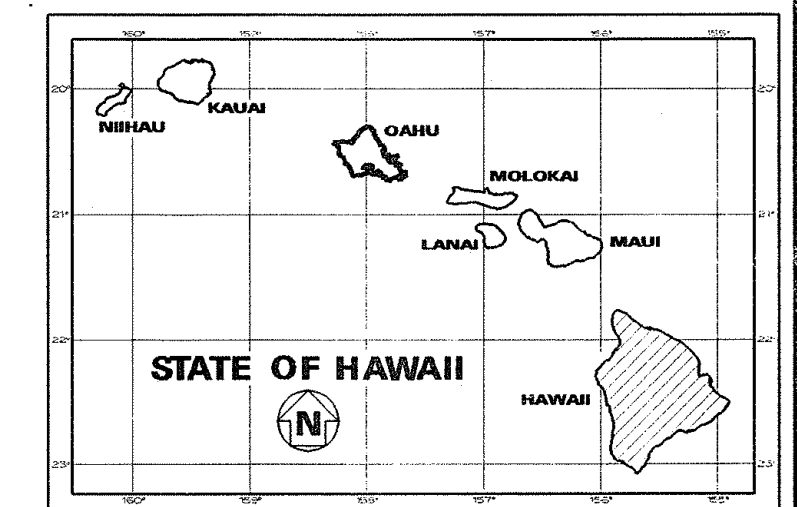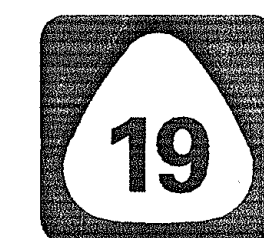

CHANGES MADE DURING CONSTRUCTION HAVE BEEN INCORPORATED ON THESE PLANS EXCEPT CHANGES IN THE ORIGINAL THEORETICAL QUANTITIES. FOR ACTUAL QUANTITIES, REFER TO PROJECT LOGS AND/OR COMPUTATION BOOK.

[Signature] 7/16/04
RESIDENT ENGINEER

DEPARTMENT OF TRANSPORTATION STATE OF HAWAII	
APPROVED:	
<i>[Signature]</i> DIR. OF TRANSPORTATION	7-16-04 DATE

HWY-DH
DESIGNED BY

BRYAN TODA
P.S. & E.BY

692-7565
PHONE

JUL. 2004
DATE