

INDEX TO DRAWINGS	
SHEET NO.	DESCRIPTION
1	TITLE SHEET
2	STANDARD PLANS SUMMARY
3	TYPICAL SECTION
4	TREE AND SHRUB TRIMMING AND REMOVAL DETAILS
5 - 9	ROADWAY PLAN
10 - 11	WATER POLLUTION & EROSION CONTROL NOTES

STATE OF HAWAI'I

DEPARTMENT OF TRANSPORTATION

HIGHWAYS DIVISION

HONOLULU, HAWAI'I

"AS-BUILT"

PLANS FOR

HAWAI'I BELT ROAD, ROUTE 19

TREE AND SHRUB TRIMMING




HONOMU TO NINOLE

PROJECT NO. 19HJ-01-06M

DISTRICT OF NORTH HILO & SOUTH HILO

ISLAND OF HAWAI'I

FED. ROAD DIST. NO.	STATE	PROJ. NO.	FISCAL YEAR	SHEET NO.	TOTAL SHEETS
HAWAI'I	HAW.	19HJ-01-06M	2006	1	11

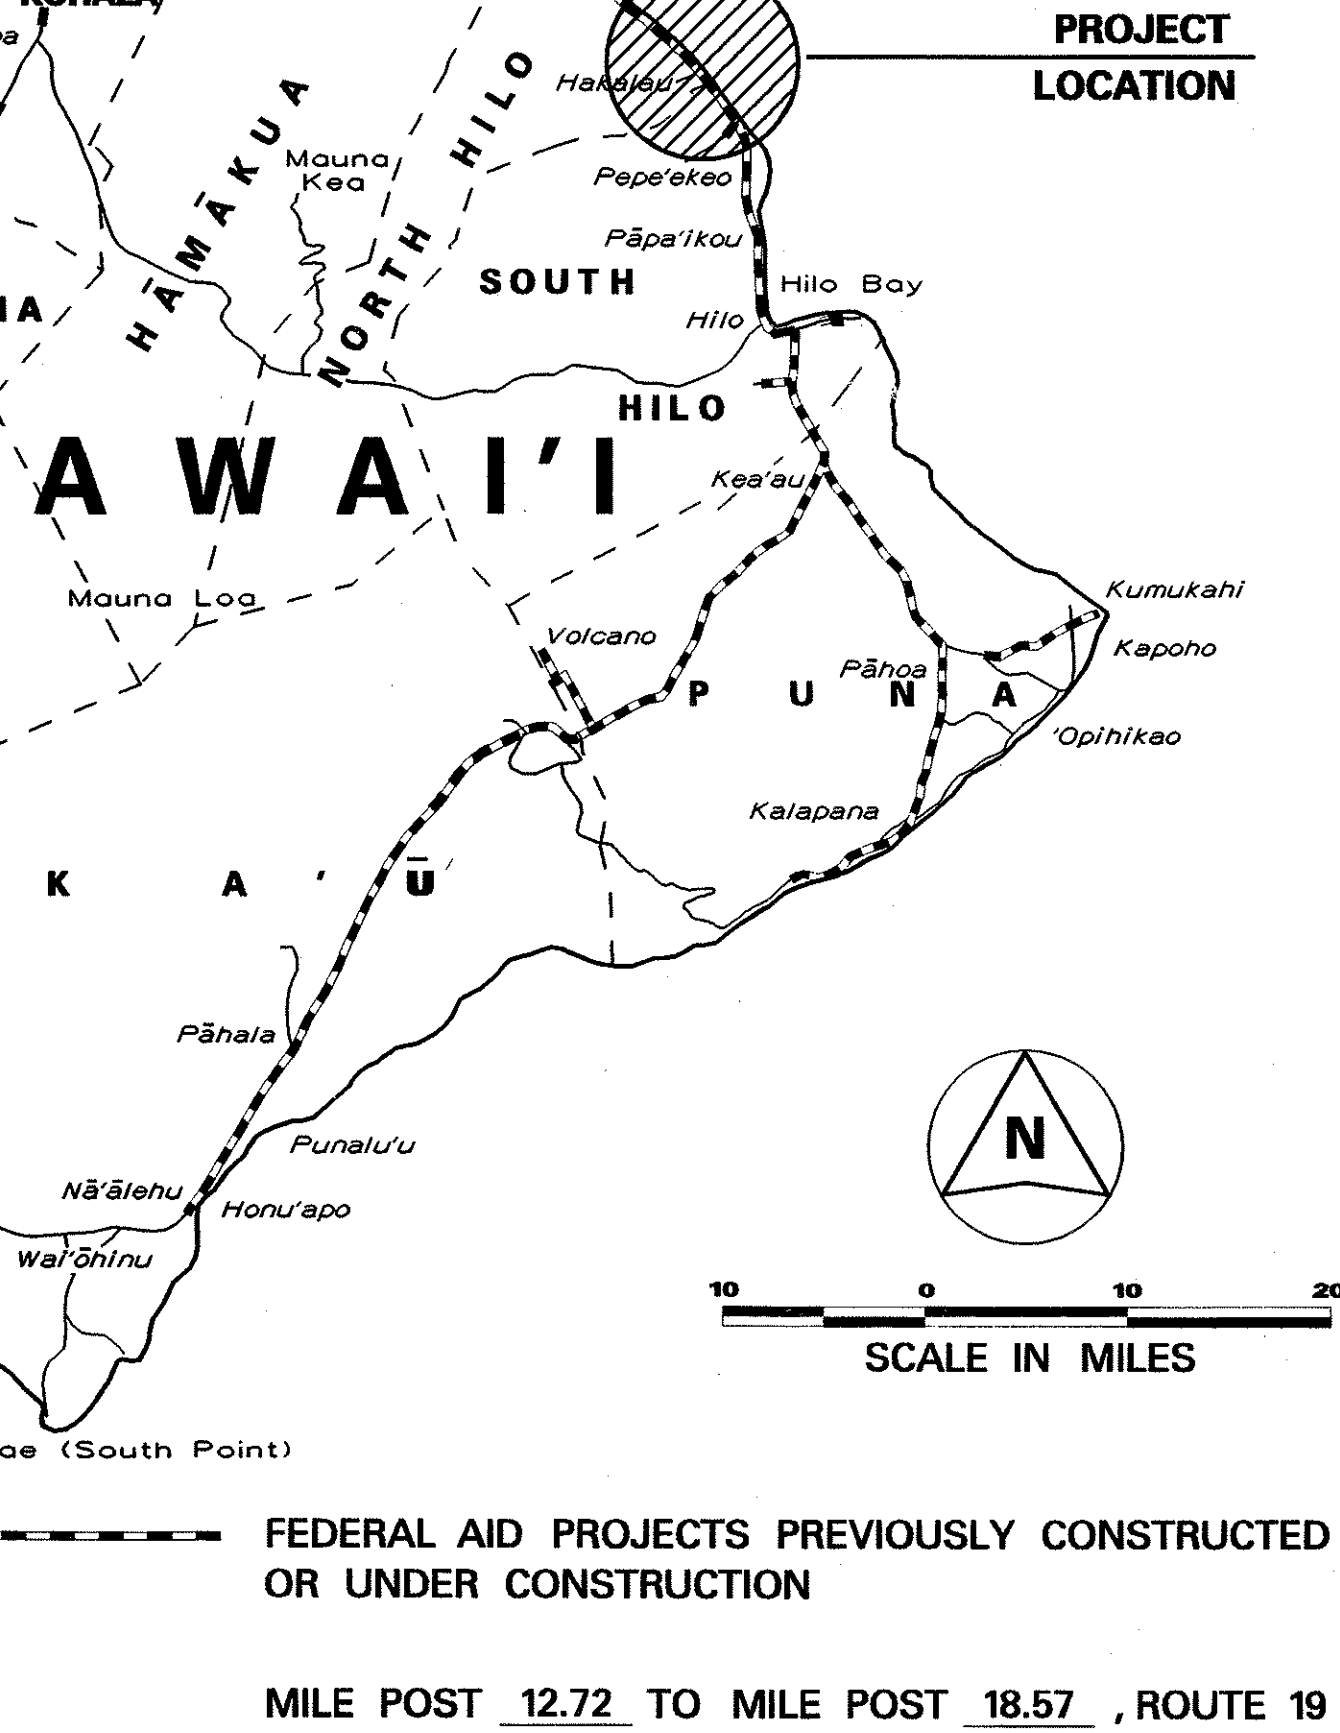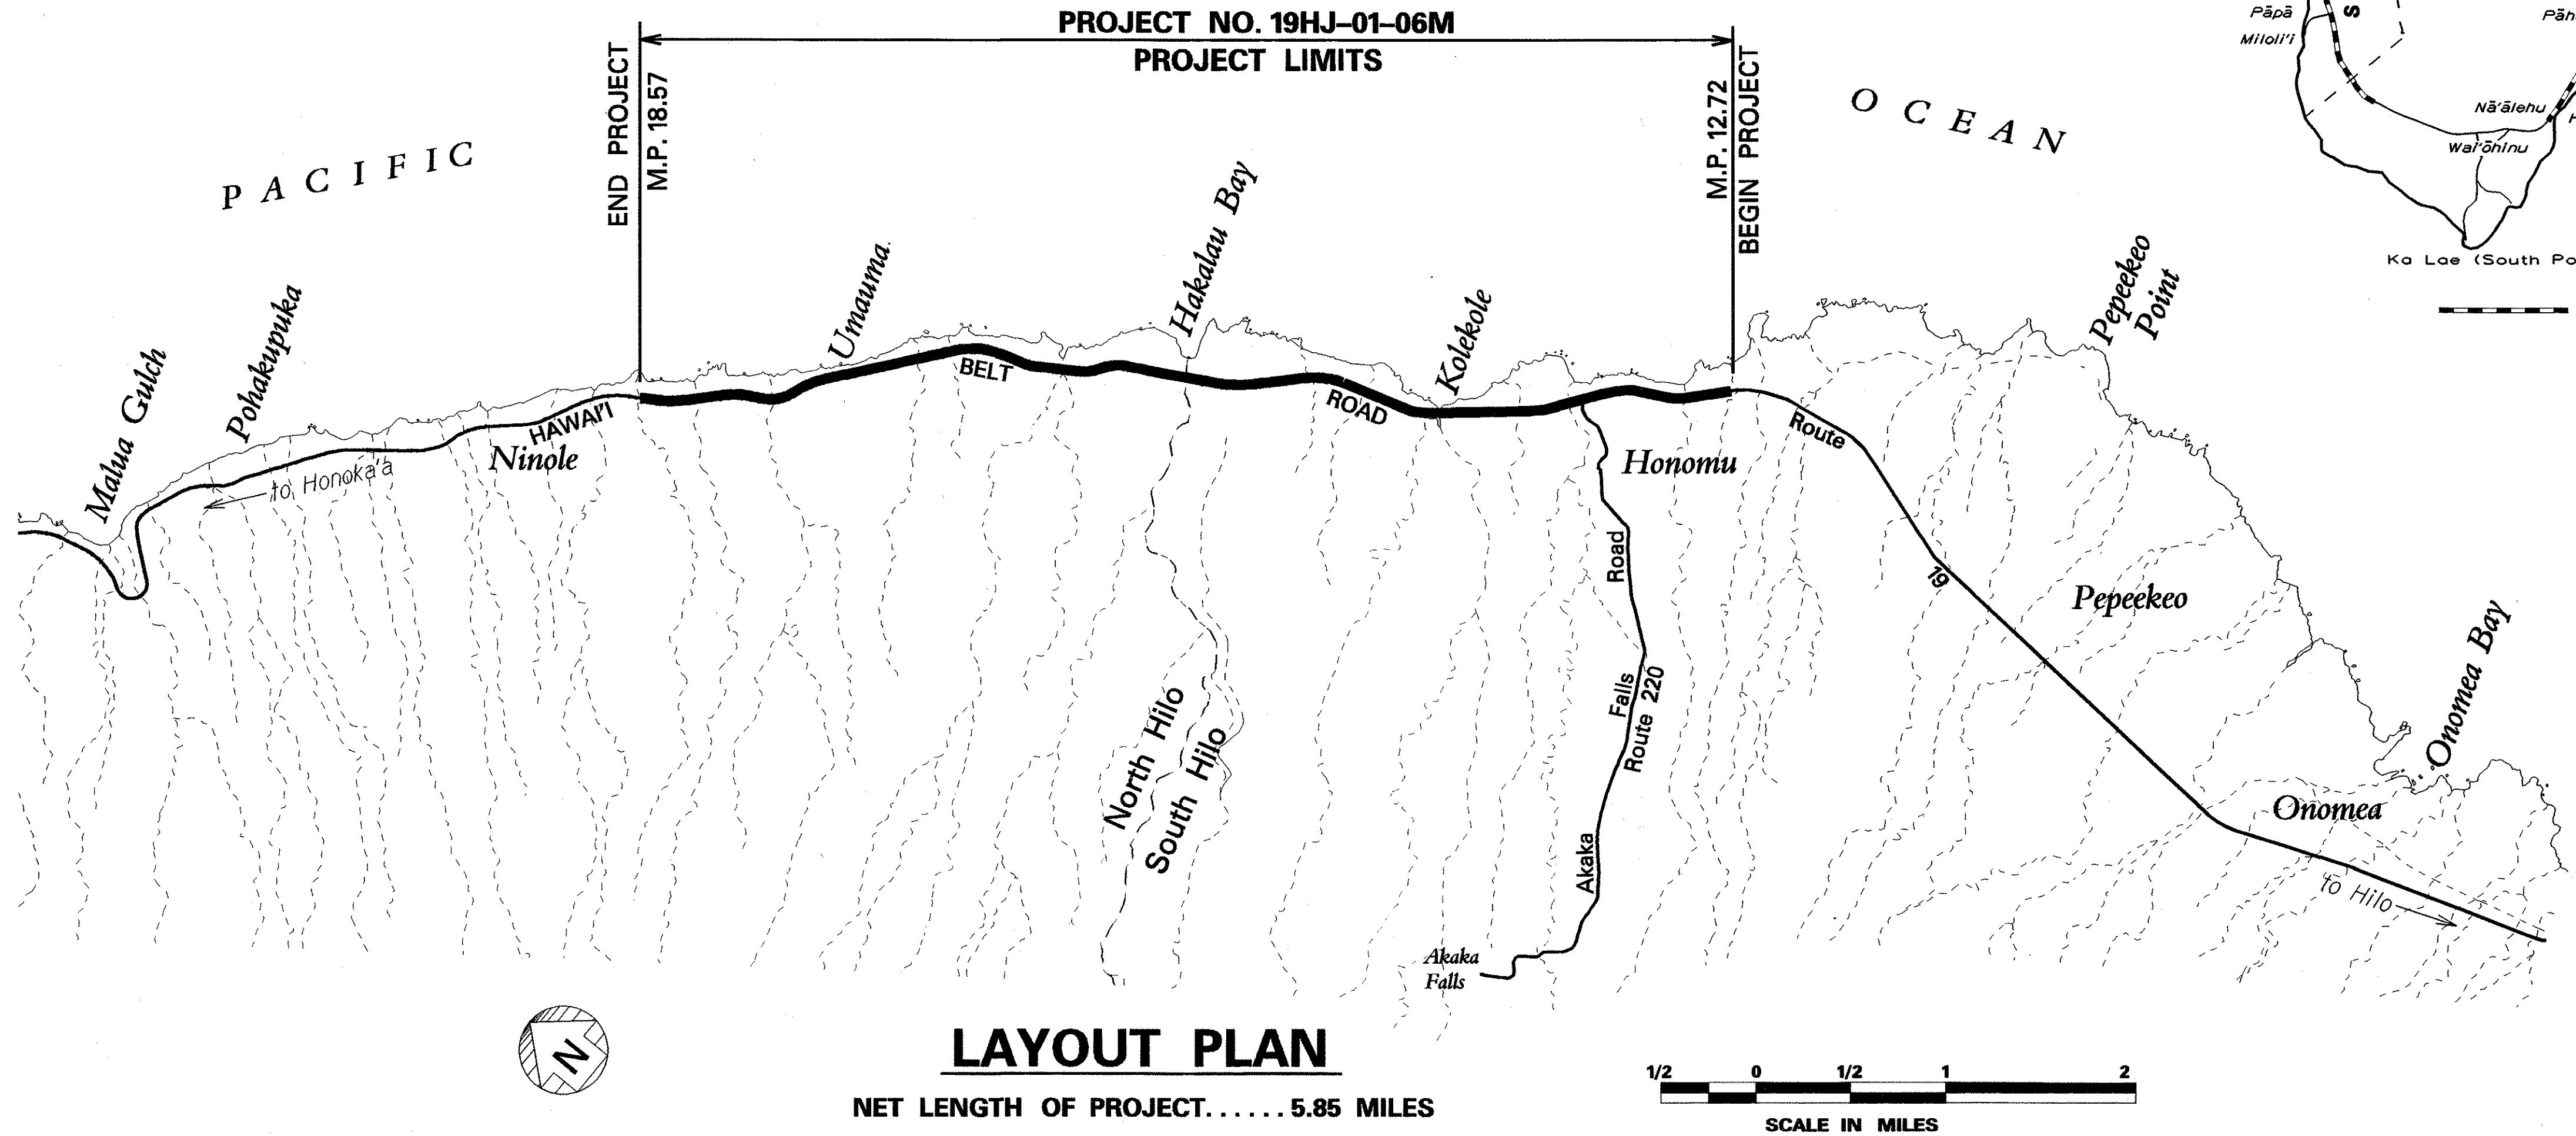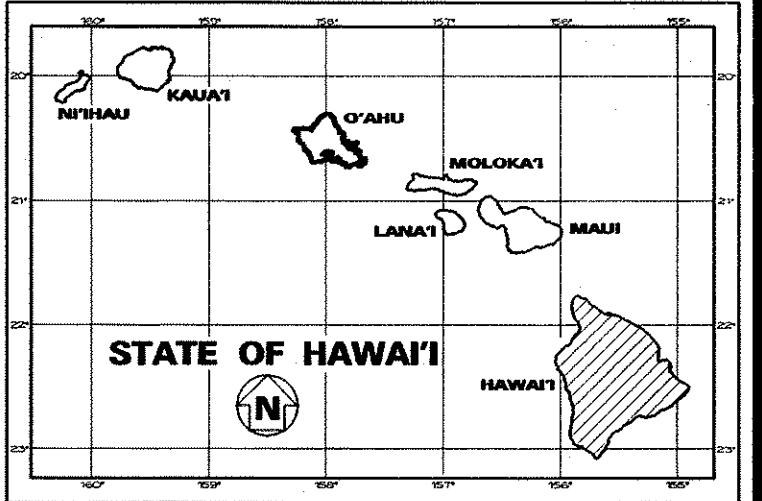

NO SIGNIFICANT CHANGES WERE MADE DURING CONSTRUCTION ON THESE PLANS EXCEPT CHANGES IN THE ORIGINAL THEORETICAL QUANTITIES. FOR ACTUAL QUANTITIES, REFER TO PROJECT LEDGER AND/OR COMPUTATION BOOK.

[Signature] 4/9/08
PRESIDENT ENGINEER DATE

HAWAII DISTRICT

DESIGNED BY

MANAGED BY

HWY-HE

933-8866

PHONE

April, 2006

DATE