

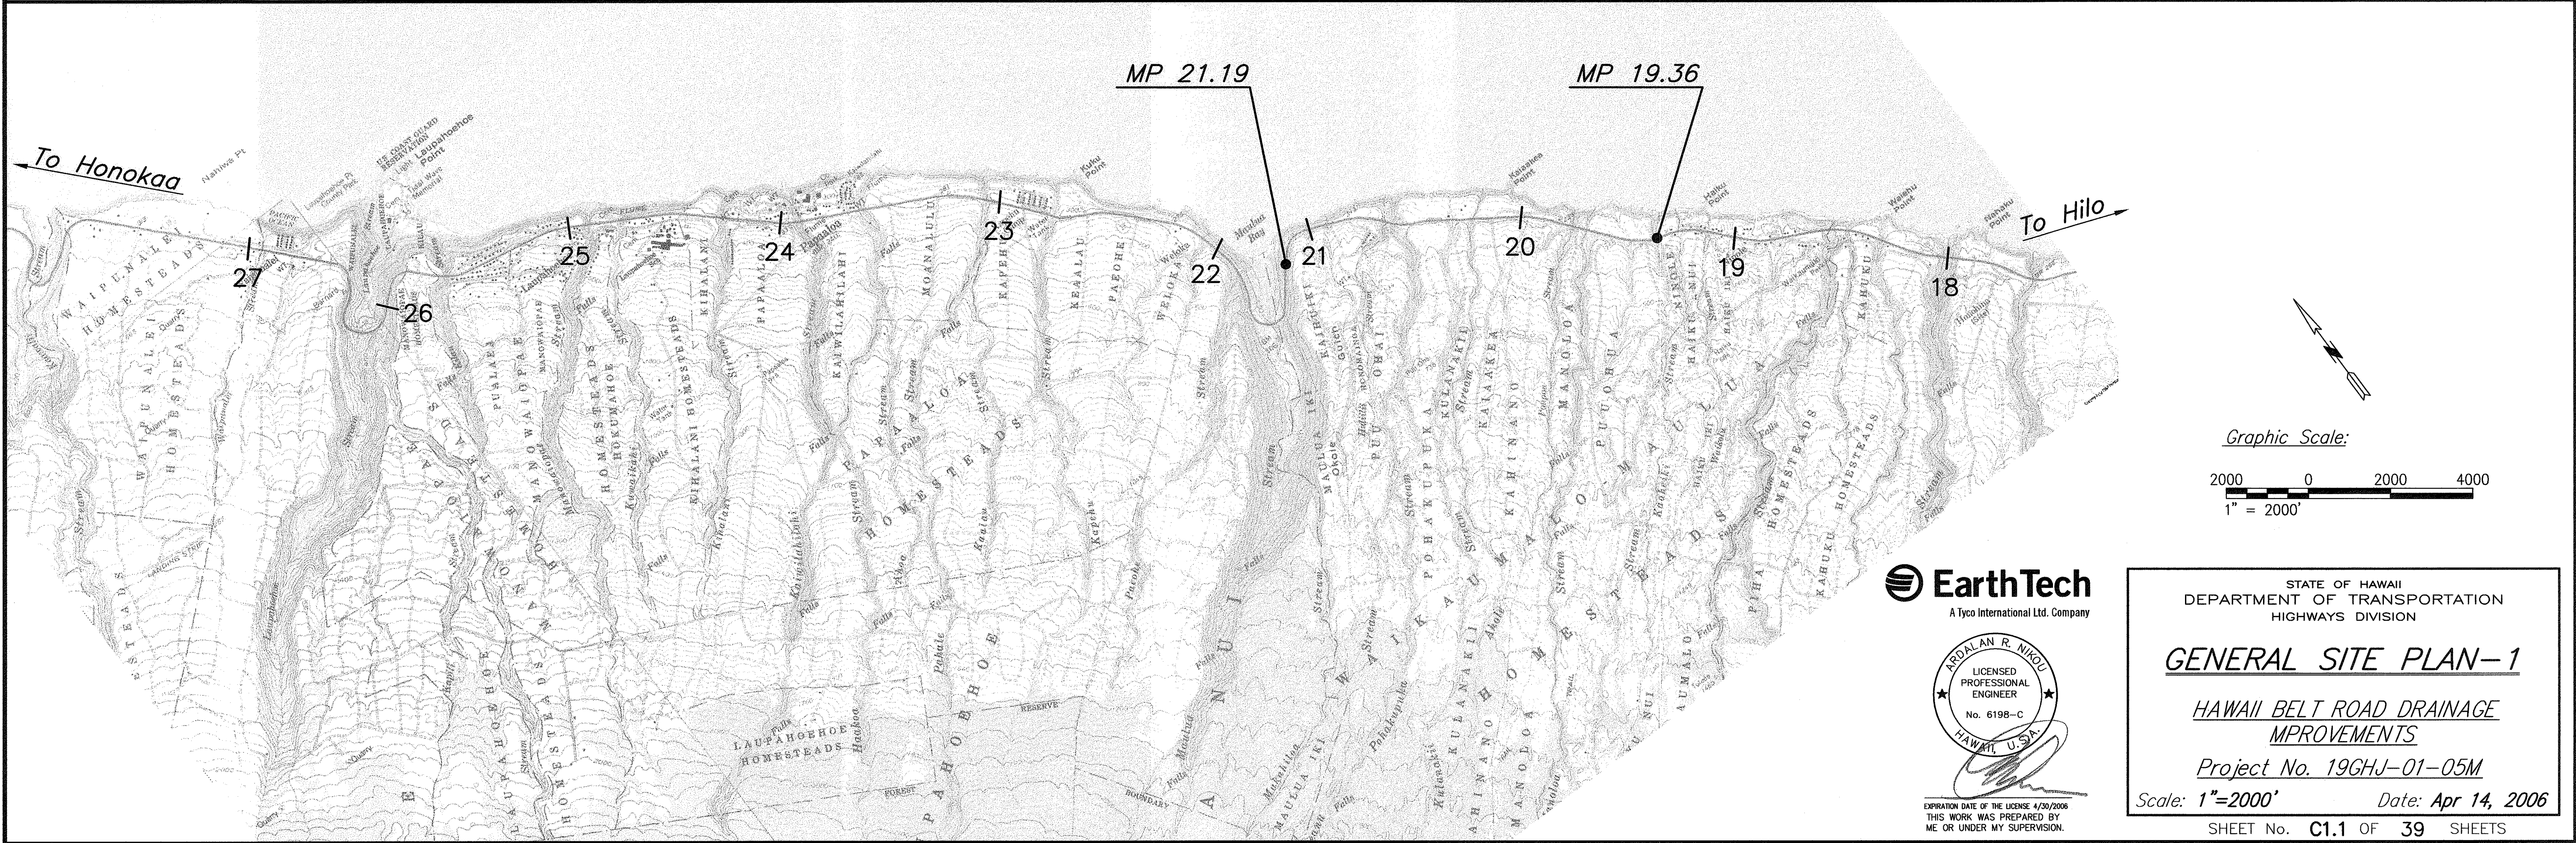


STATE	PROJ. NO.	FISCAL YEAR	SHEET NO.	TOTAL SHEETS
HAW	19GHJ-01-05M	2006	6	39

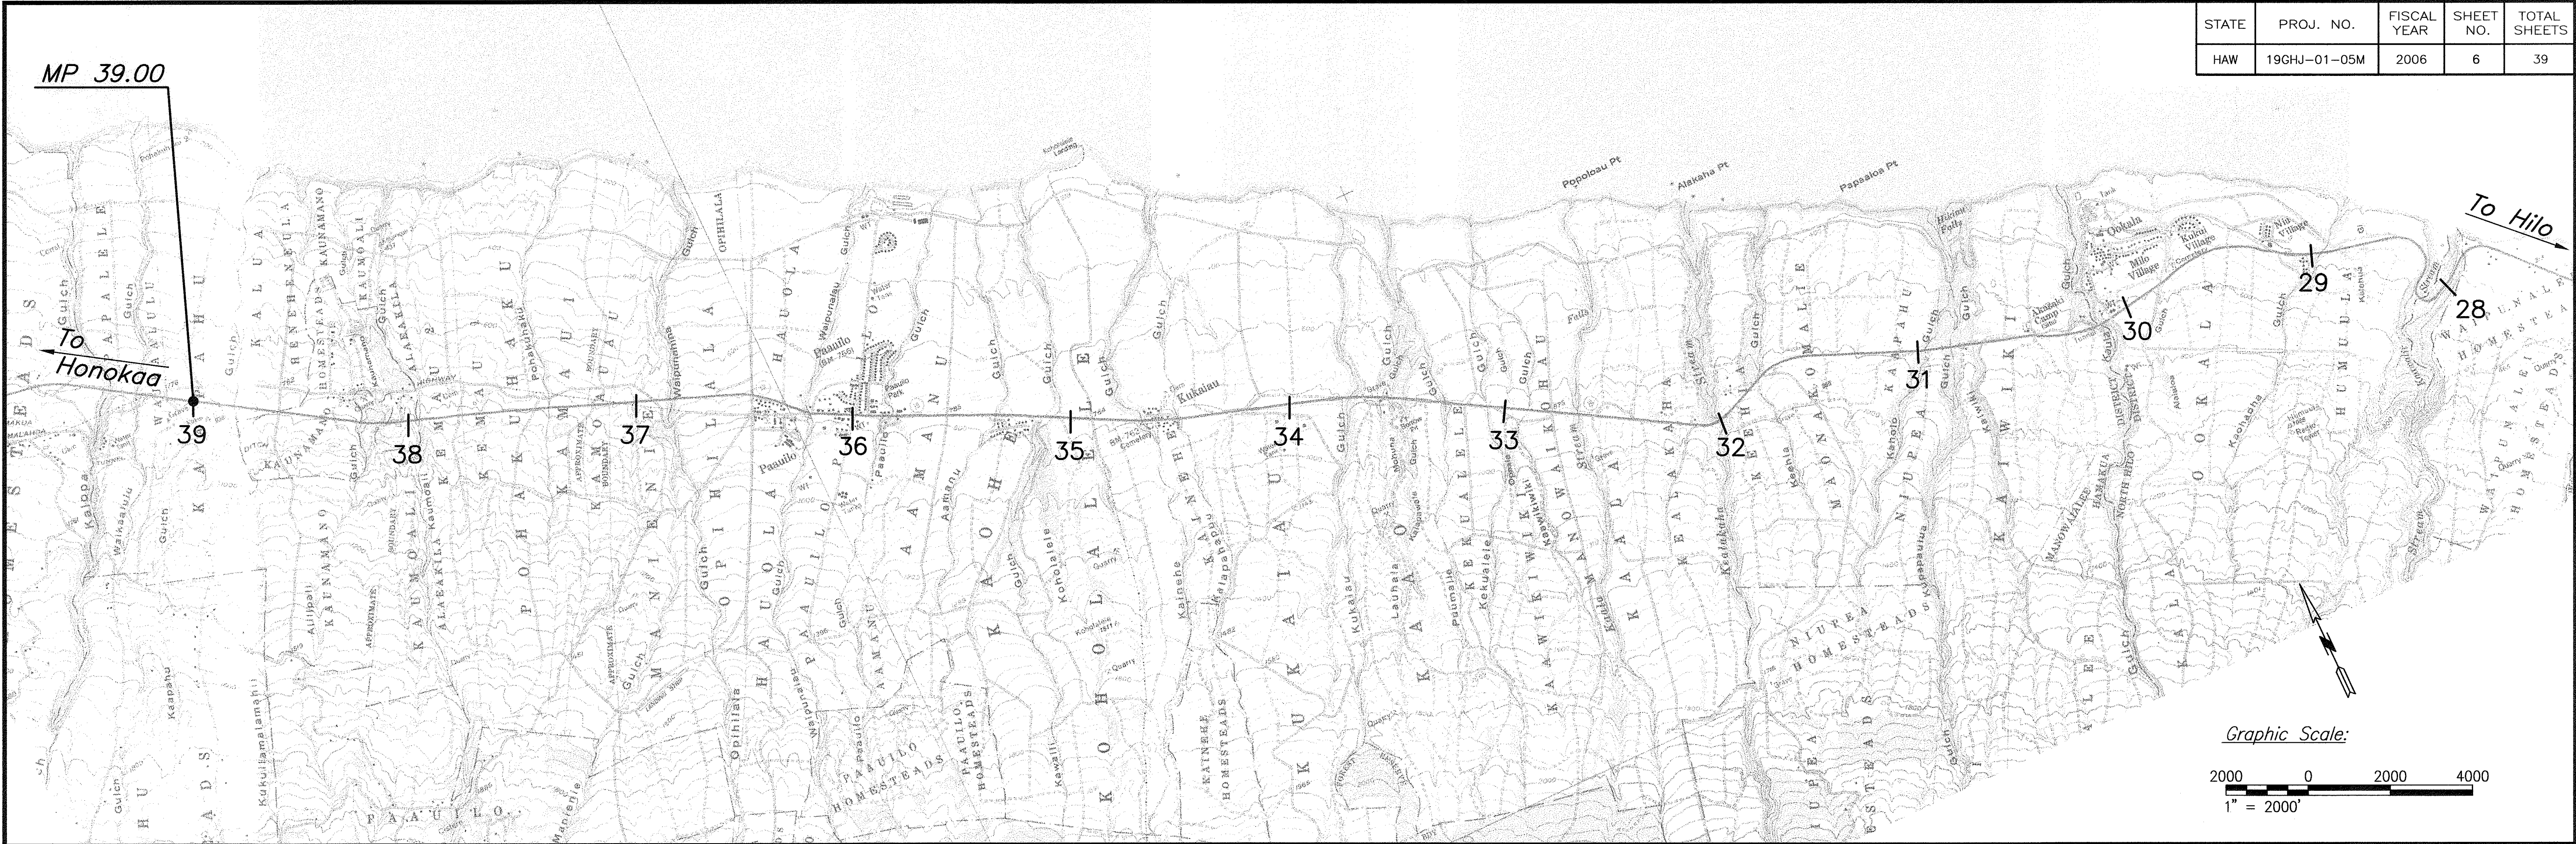

ORIGINAL PLAN	DATE
DESIGNED BY	
TRACED BY	
DESIGNED BY	
QUANTITIES BY	
CHECKED BY	
No.	

**EarthTech**  
A Tyco International Ltd. Company

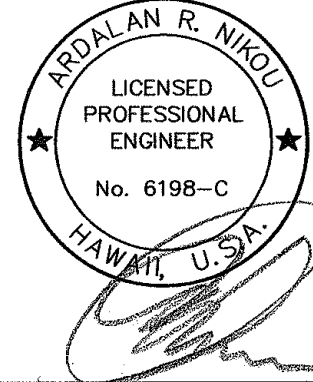

EXPIRATION DATE OF THE LICENSE 4/30/2008  
THIS WORK WAS PREPARED BY  
ME OR UNDER MY SUPERVISION.

STATE OF HAWAII  
DEPARTMENT OF TRANSPORTATION  
HIGHWAYS DIVISION  
  
GENERAL SITE PLAN-1  
  
HAWAII BELT ROAD DRAINAGE  
IMPROVEMENTS  
  
Project No. 19GHJ-01-05M  
Scale: 1"=2000'      Date: Apr 14, 2006  
  
SHEET No. C1.1 OF 39 SHEETS



