


INDEX TO DRAWINGS	
SHEET NO.	DESCRIPTION
1	TITLE SHEET
2	STANDARD PLANS SUMMARY
3	GENERAL NOTES AND LEGEND
4-5	WATER POLLUTION & EROSION CONTROL NOTES
6-7	GENERAL SITE PLAN
8-12	SITE IMPROVEMENTS
13	CIVIL DETAILS
14	TRAFFIC CONTROL PLAN
15	LANE CLOSURE PLAN - MILE POST 19.36
16	PAVING AND MARKING PLAN - MILE POST 19.36
17	BORING LOG
18-20	STRUCTURAL NOTES & DETAILS
21-23	MP 5.45 STRUCTURAL PLANS
24-26	MP 5.58 STRUCTURAL PLANS
27-32	MP 19.36 STRUCTURAL PLANS
33-35	MP 21.19 STRUCTURAL PLANS
36-39	MP 39.00 STRUCTURAL PLANS

STATE OF HAWAII
DEPARTMENT OF TRANSPORTATION
HIGHWAYS DIVISION
HONOLULU, HAWAII



PLANS FOR
HAWAII BELT ROAD DRAINAGE
IMPROVEMENTS
VARIOUS LOCATIONS

PROJECT NO. 19GHJ-01-05M

DISTRICTS OF SOUTH HILO, NORTH HILO,
AND HAMAKUA, ISLAND OF HAWAII

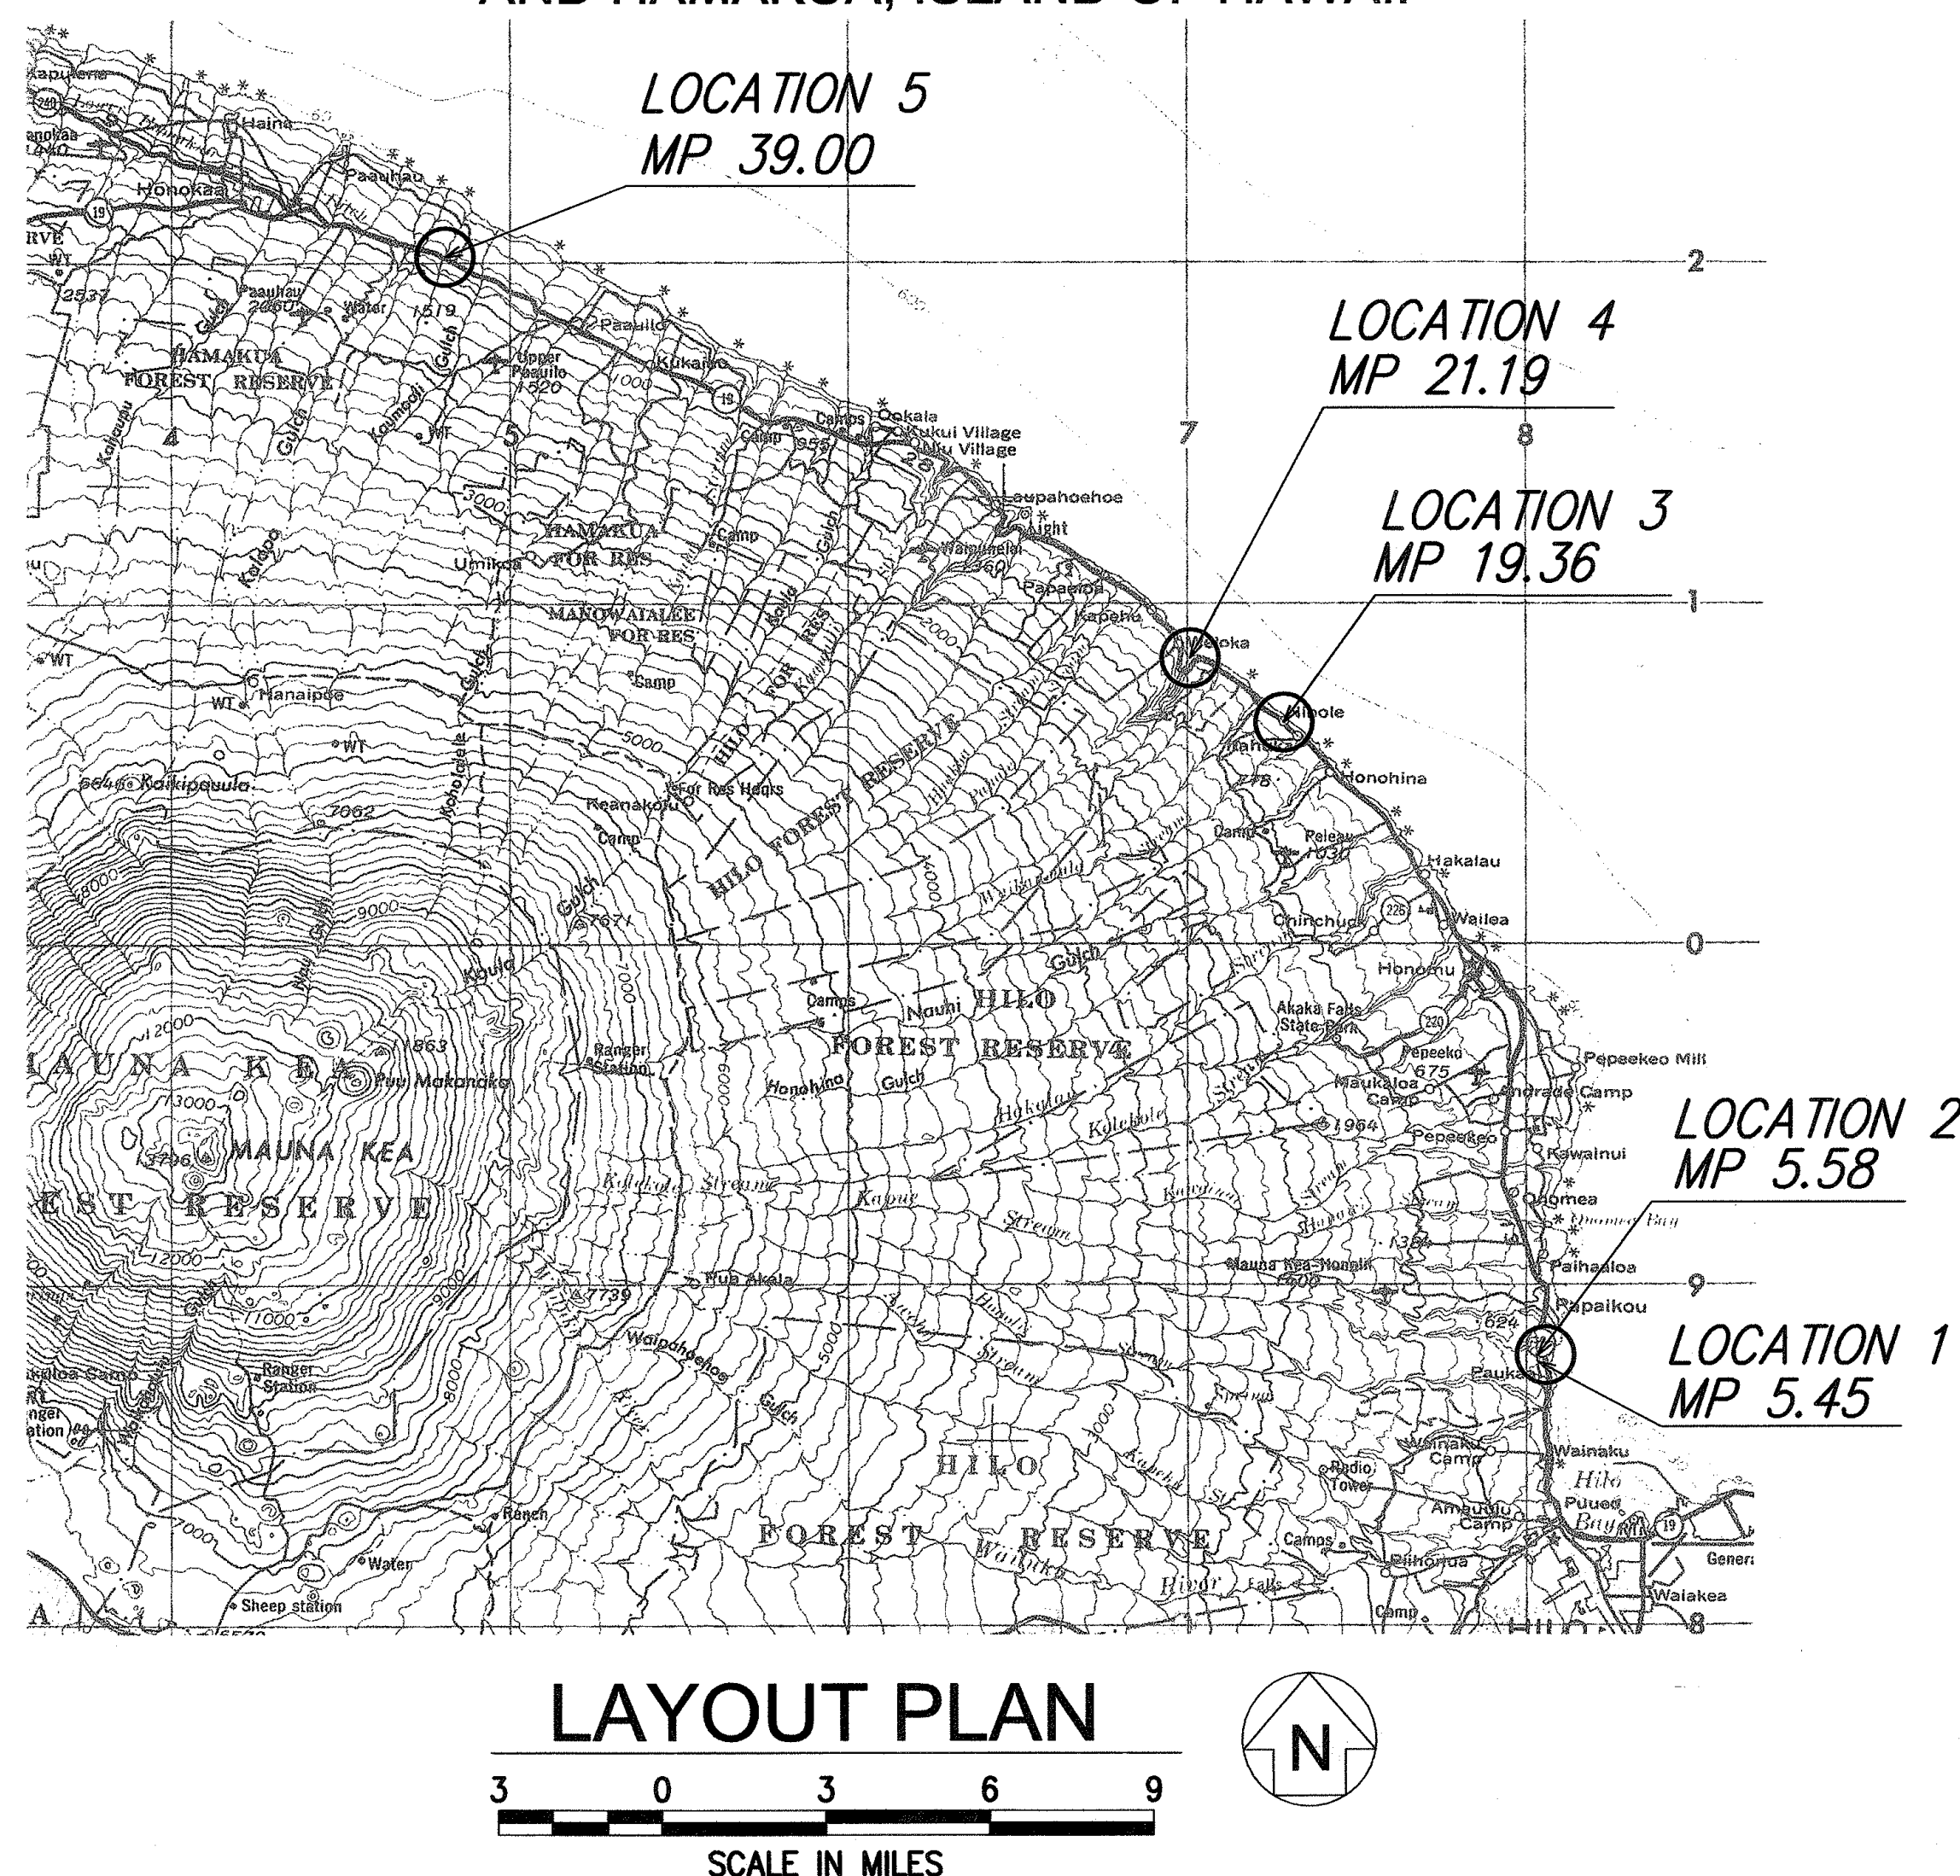

STATE	PROJ. NO.	FISCAL YEAR	SHEET NO.	TOTAL SHEETS
HAW	19GHJ-01-05M	2006	1	39

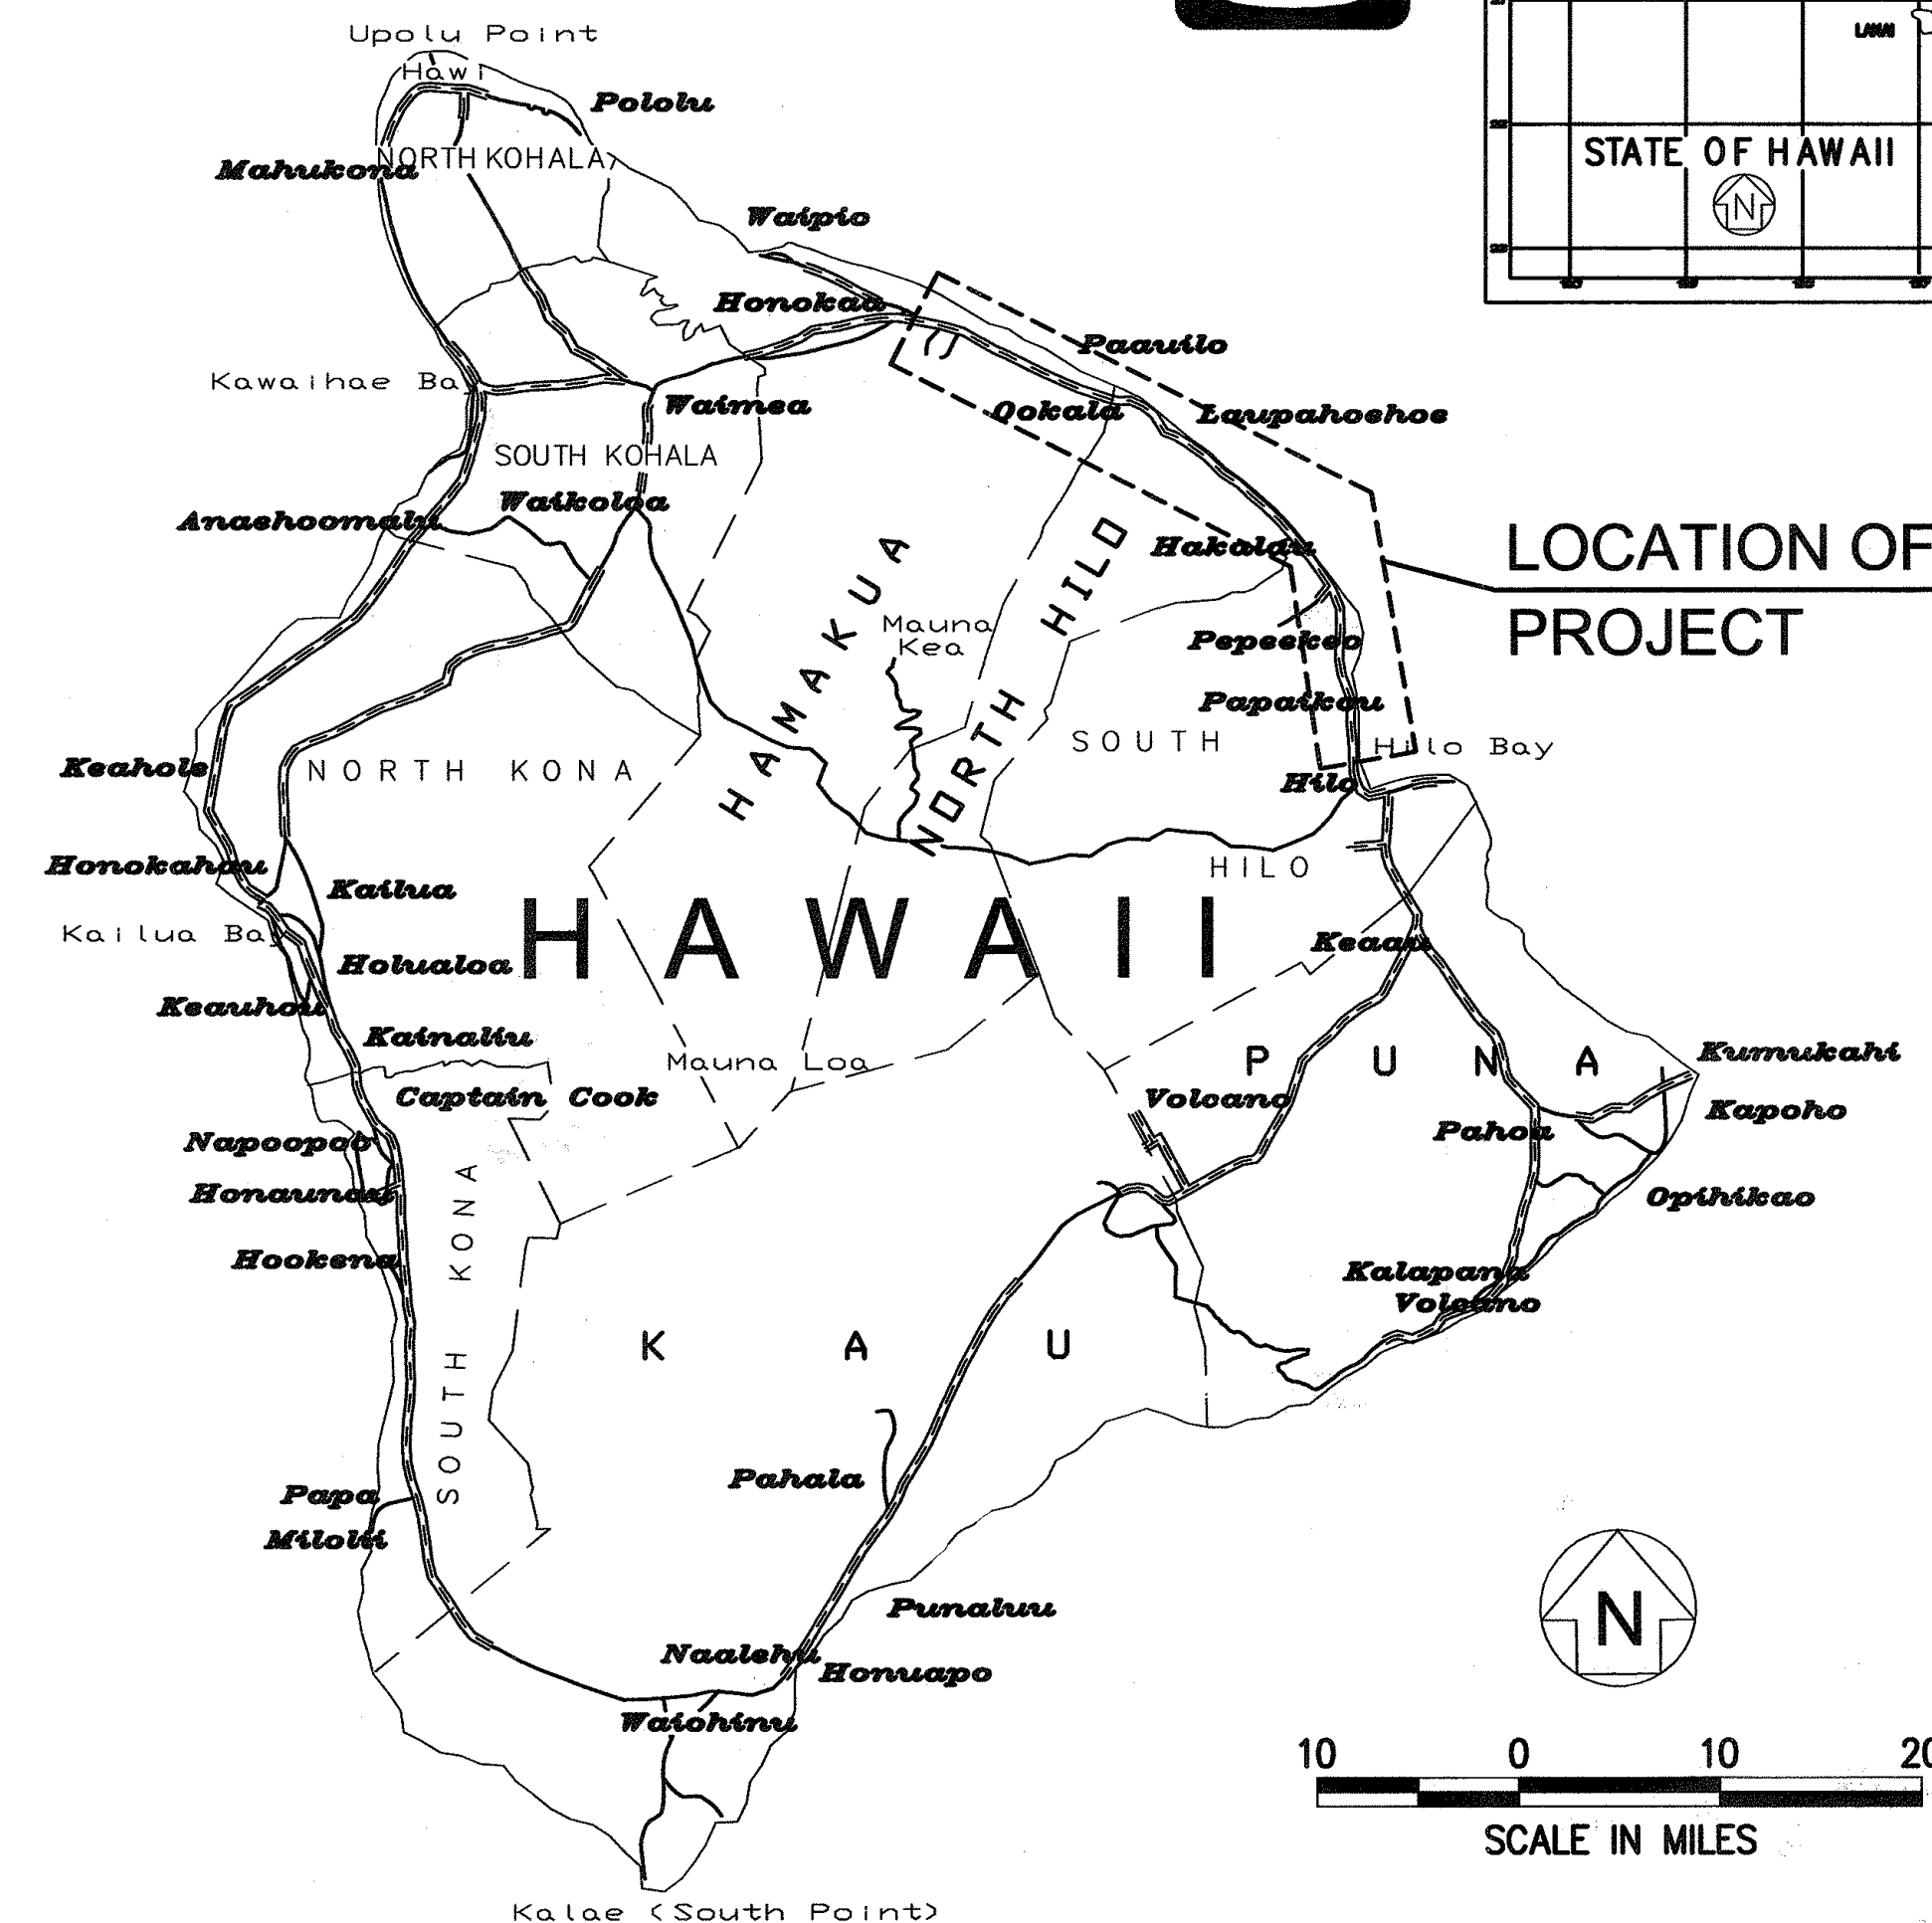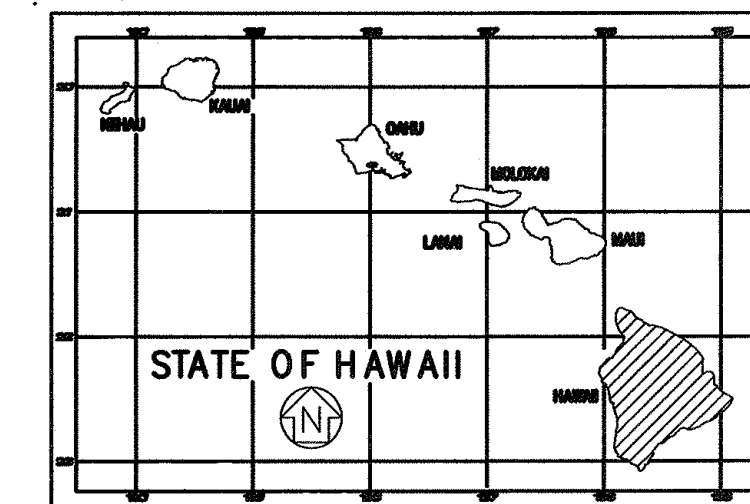

FEDERAL AID PROJECTS PREVIOUSLY
CONSTRUCTED OR UNDER CONSTRUCTION

MILE POST 5.45, 5.58, 19.36, 21.19 and 39.00

MANAGER, DEPARTMENT OF WATER SUPPLY
COUNTY OF HAWAII

DATE

CHANGES MADE DURING CONSTRUCTION HAVE BEEN
INCORPORATED ON THESE PLANS EXCEPT CHANGES
IN THE ORIGINAL THEORETICAL QUANTITIES. FOR
ACTUAL QUANTITIES, REFER TO PROJECT LEDGER
AND/OR COMPUTATION BOOK.

3-30-09
DATE

DEPARTMENT OF TRANSPORTATION
STATE OF HAWAII

APPROVED: 5/9/06
DIR. OF TRANSPORTATION DATE

APR 2006 DATE
933-8866 PHONE
HWY-H MANAGED BY
EARTH TECH DESIGNED BY