


FED. ROAD DIST. NO.	STATE	FED. AID PROJ. NO.	FISCAL YEAR	SHEET NO.	TOTAL SHEETS
HAWAII	HAW.	NH-019-1(37)	2007	ADD. 22	47

Route 11, @ Sta. 1278+94± to @ Sta. 1282+26± Lt.
Remove and Dispose of Existing Guardrail and Post. Install New Type 3 Guardrail Thrie Beam transition to New Type 3 Guardrail and Modified Type G Flare at Approach End at Sta. 1280+80±. Install New Type 3 Guardrail at Station 1281+00 with Modified Type G at the Trailing End and New ET 2000 Plus at Approach End. For Details, See Plan Sheets Numbers 6, 7, 8, 13, and 32 thru 36.

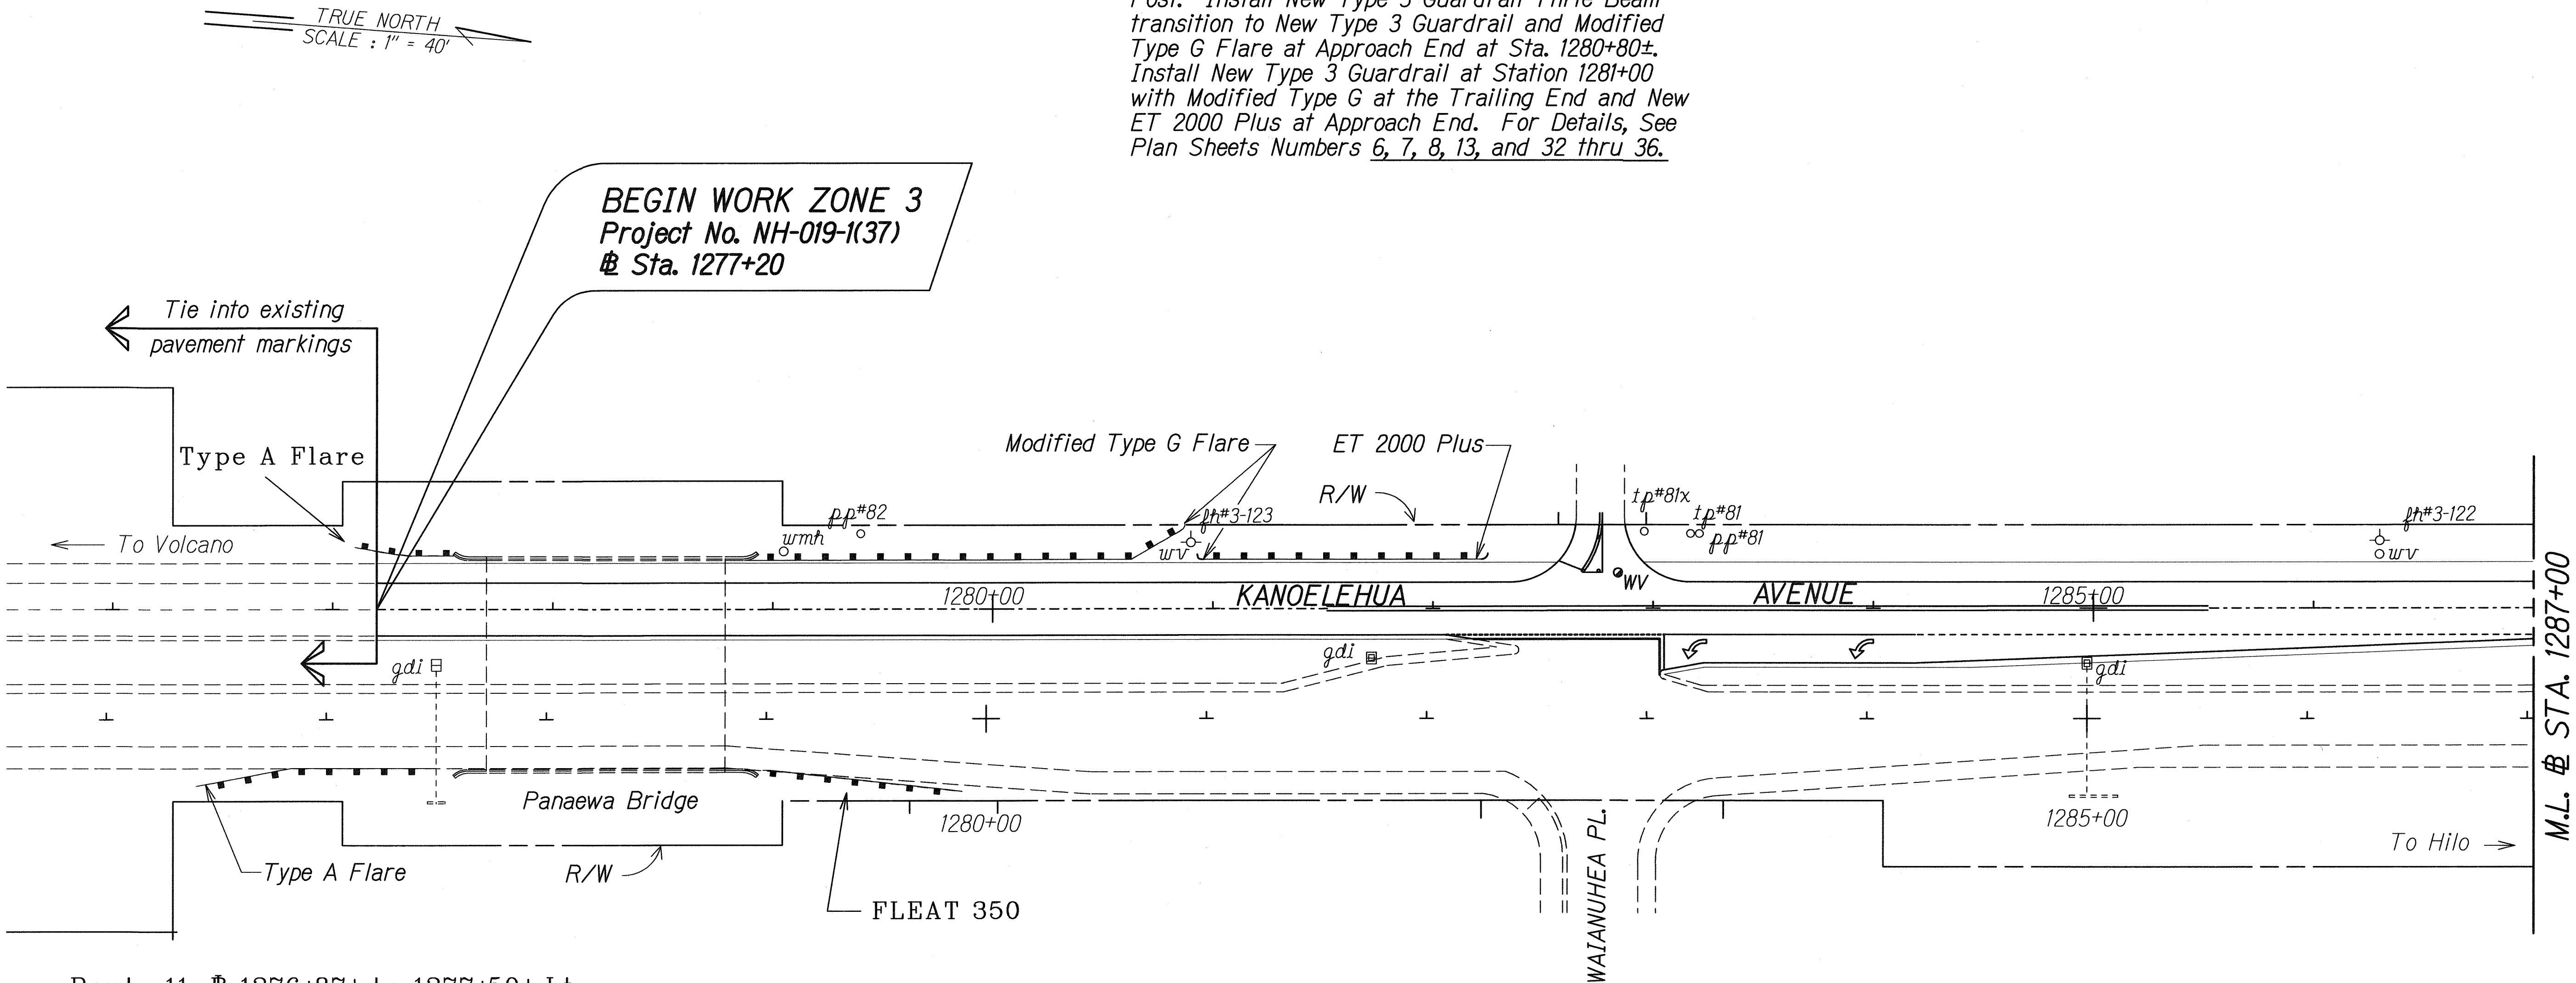

Route 11, @ Sta. 1276+87± to 1277+50± Lt.
Remove and Dispose of Existing Guardrail and Post. Install New Type 3 Thrie Beam Transition to New Type 3 Guardrail and New Type A Flare at Trailing End. For Details, See Plan Sheets Numbers 6, 7, 8, 10 thru 12 and 32 thru 36.

Route 11, @ Sta. 1278+95± to @ Sta. 1279+70± Rt.
Remove and Dispose of Existing Guardrail and Post. Install New Type 3 Guardrail Thrie Beam Transition to New Type 3 Guardrail and New Fleet 350 at Trailing End. For Details, See Plan Sheets Numbers 6, 7, 8, 10 thru 12, and 32 thru 36.


Route 11, @ Sta. 1276+38± to @ Sta. 1277+60± Rt.
Remove and Dispose of Existing Guardrail and Post. Install New Type 3 Guardrail Thrie Beam transition to New Type 3 Guardrail and New Type A Flare at Approach End. For Details, See Plan Sheets Nos. 6, 7, 8, 10 thru 12, and 32 thru 36.

LEGEND FOR AS-BUILT POSTINGS	
	Squiggly line for as-built deletion
	Double line for as-built deletion
Roadway	Text for as-built posting

4/20/07	Edited Notes.
DATE	REVISION
STATE OF HAWAII DEPARTMENT OF TRANSPORTATION HIGHWAYS DIVISION ROADWAY PLAN HAWAII BELT ROAD GUARDRAIL AND SHOULDER IMPROVEMENTS Paauhau Road to Papalele Road and Various Locations Federal-Aid Project No. NH-019-1(37) Scale: 1"=40' Date: April, 2007	
SHEET No. 7 OF 8 SHEETS	

ORIGINAL PLAN	SURVEY PLOTTED BY	DATE
NOTE BOOK	DRAWN BY	4/26
add/correction	TRACED BY	
	QUANTIFIED BY	
	CHECKED BY	

FED. ROAD DIST. NO.	STATE	FED. AID PROJ. NO.	FISCAL YEAR	SHEET NO.	TOTAL SHEETS
HAWAII	HAW.	NH-019-1(37)	2007	ADD. 23	47

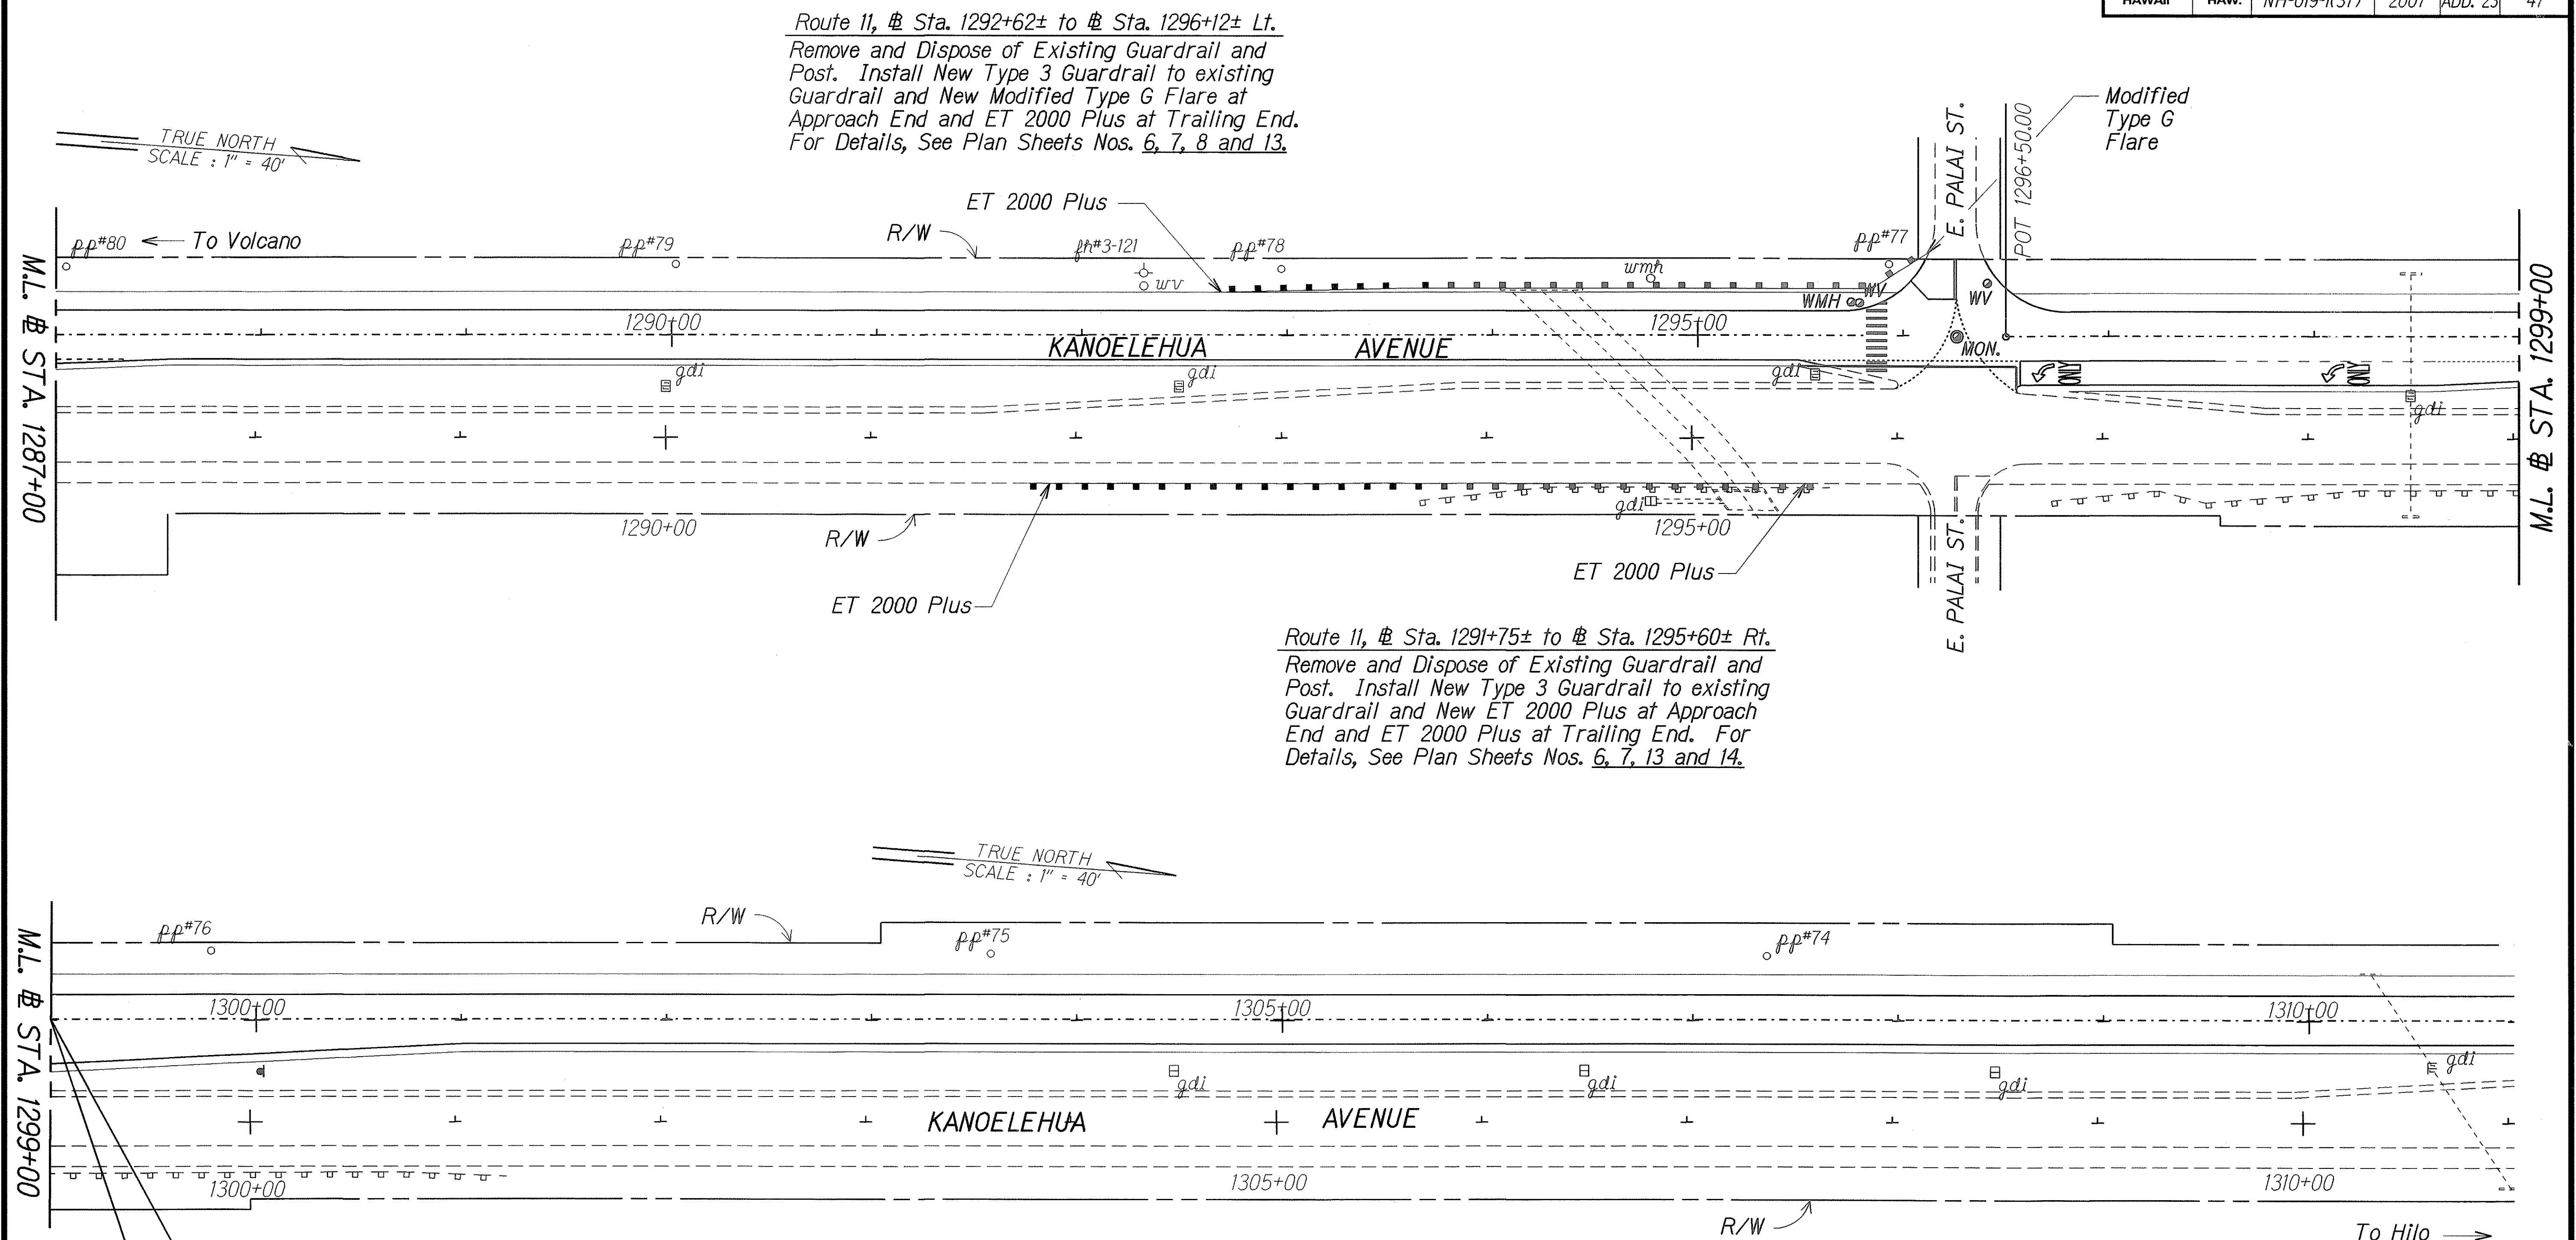

ORIGINAL PLAN	DATE	4/26
DESIGNED BY	DESIGNED BY	
QUANTITIES BY	QUANTITIES BY	
CHECKED BY	CHECKED BY	

END WORK ZONE 3
Project No. NH-019-1(37)
Sta. 1299+00

4/20/07	Edited Notes.
DATE	REVISION
STATE OF HAWAII DEPARTMENT OF TRANSPORTATION HIGHWAYS DIVISION ROADWAY PLAN HAWAII BELT ROAD GUARDRAIL AND SHOULDER IMPROVEMENTS Paauhau Road to Papalele Road and Various Locations Federal-Aid Project No. NH-019-1(37) Scale: 1"=40' Date: April, 2007	
SHEET No. 8 OF 8 SHEETS	