

SHEET NO.	INDEX TO DRAWINGS
1	TITLE SHEET
2	STANDARD PLANS SUMMARY
3	GENERAL NOTES AND LEGEND
4 - 5	WATER POLLUTION AND EROSION CONTROL NOTES
6 - 15	GUARDRAIL DETAILS
16 - 20	ROADWAY PLANS - WORK ZONE 1
21	ROADWAY PLANS - WORK ZONE 2
22 - 23	ROADWAY PLANS - WORK ZONE 3
24 - 36	BRIDGE PLANS
37 - 47	PAVEMENT MARKING AND SIGNAGE PLANS

STATE OF HAWAII

DEPARTMENT OF TRANSPORTATION

HIGHWAYS DIVISION

HONOLULU, HAWAII

"AS-BUILT"

PLANS FOR

HAWAII BELT ROAD

GUARDRAIL and SHOULDER IMPROVEMENTS


PAAUHAU ROAD TO PAPALELE ROAD

AND VARIOUS LOCATIONS



FEDERAL-AID PROJECT NO. NH-019-1(37)

DISTRICT OF HAMAKUA

ISLAND OF HAWAII

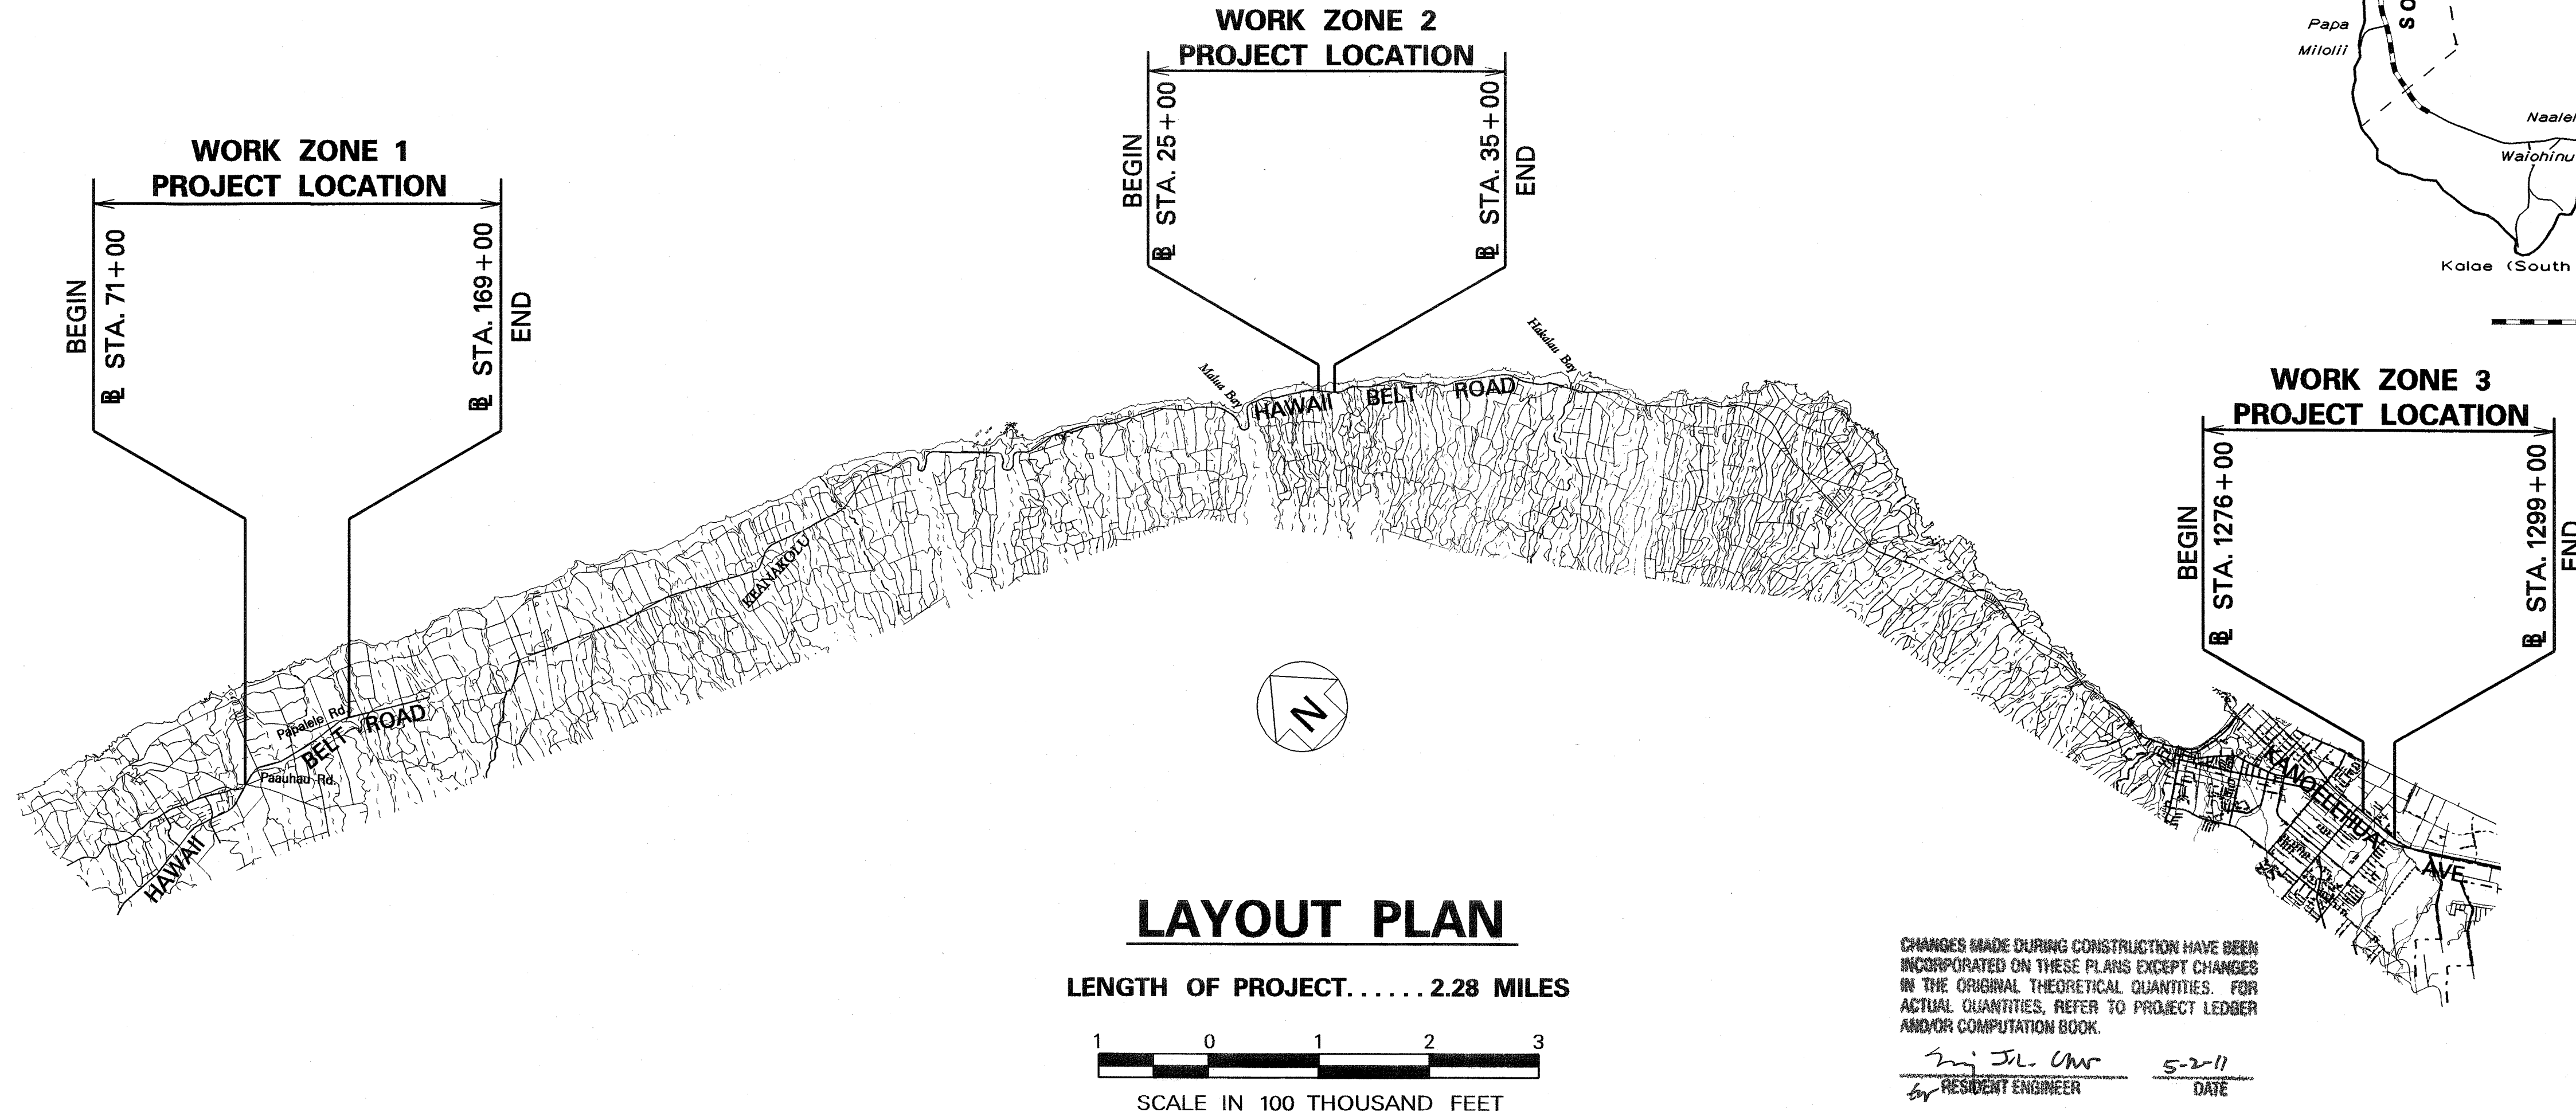

FED. ROAD DIST. NO.	STATE	FED. AID PROJ. NO.	FISCAL YEAR	SHEET NO.	TOTAL SHEETS
HAWAII	HAW.	NH-019-1(37)	2007	1	47

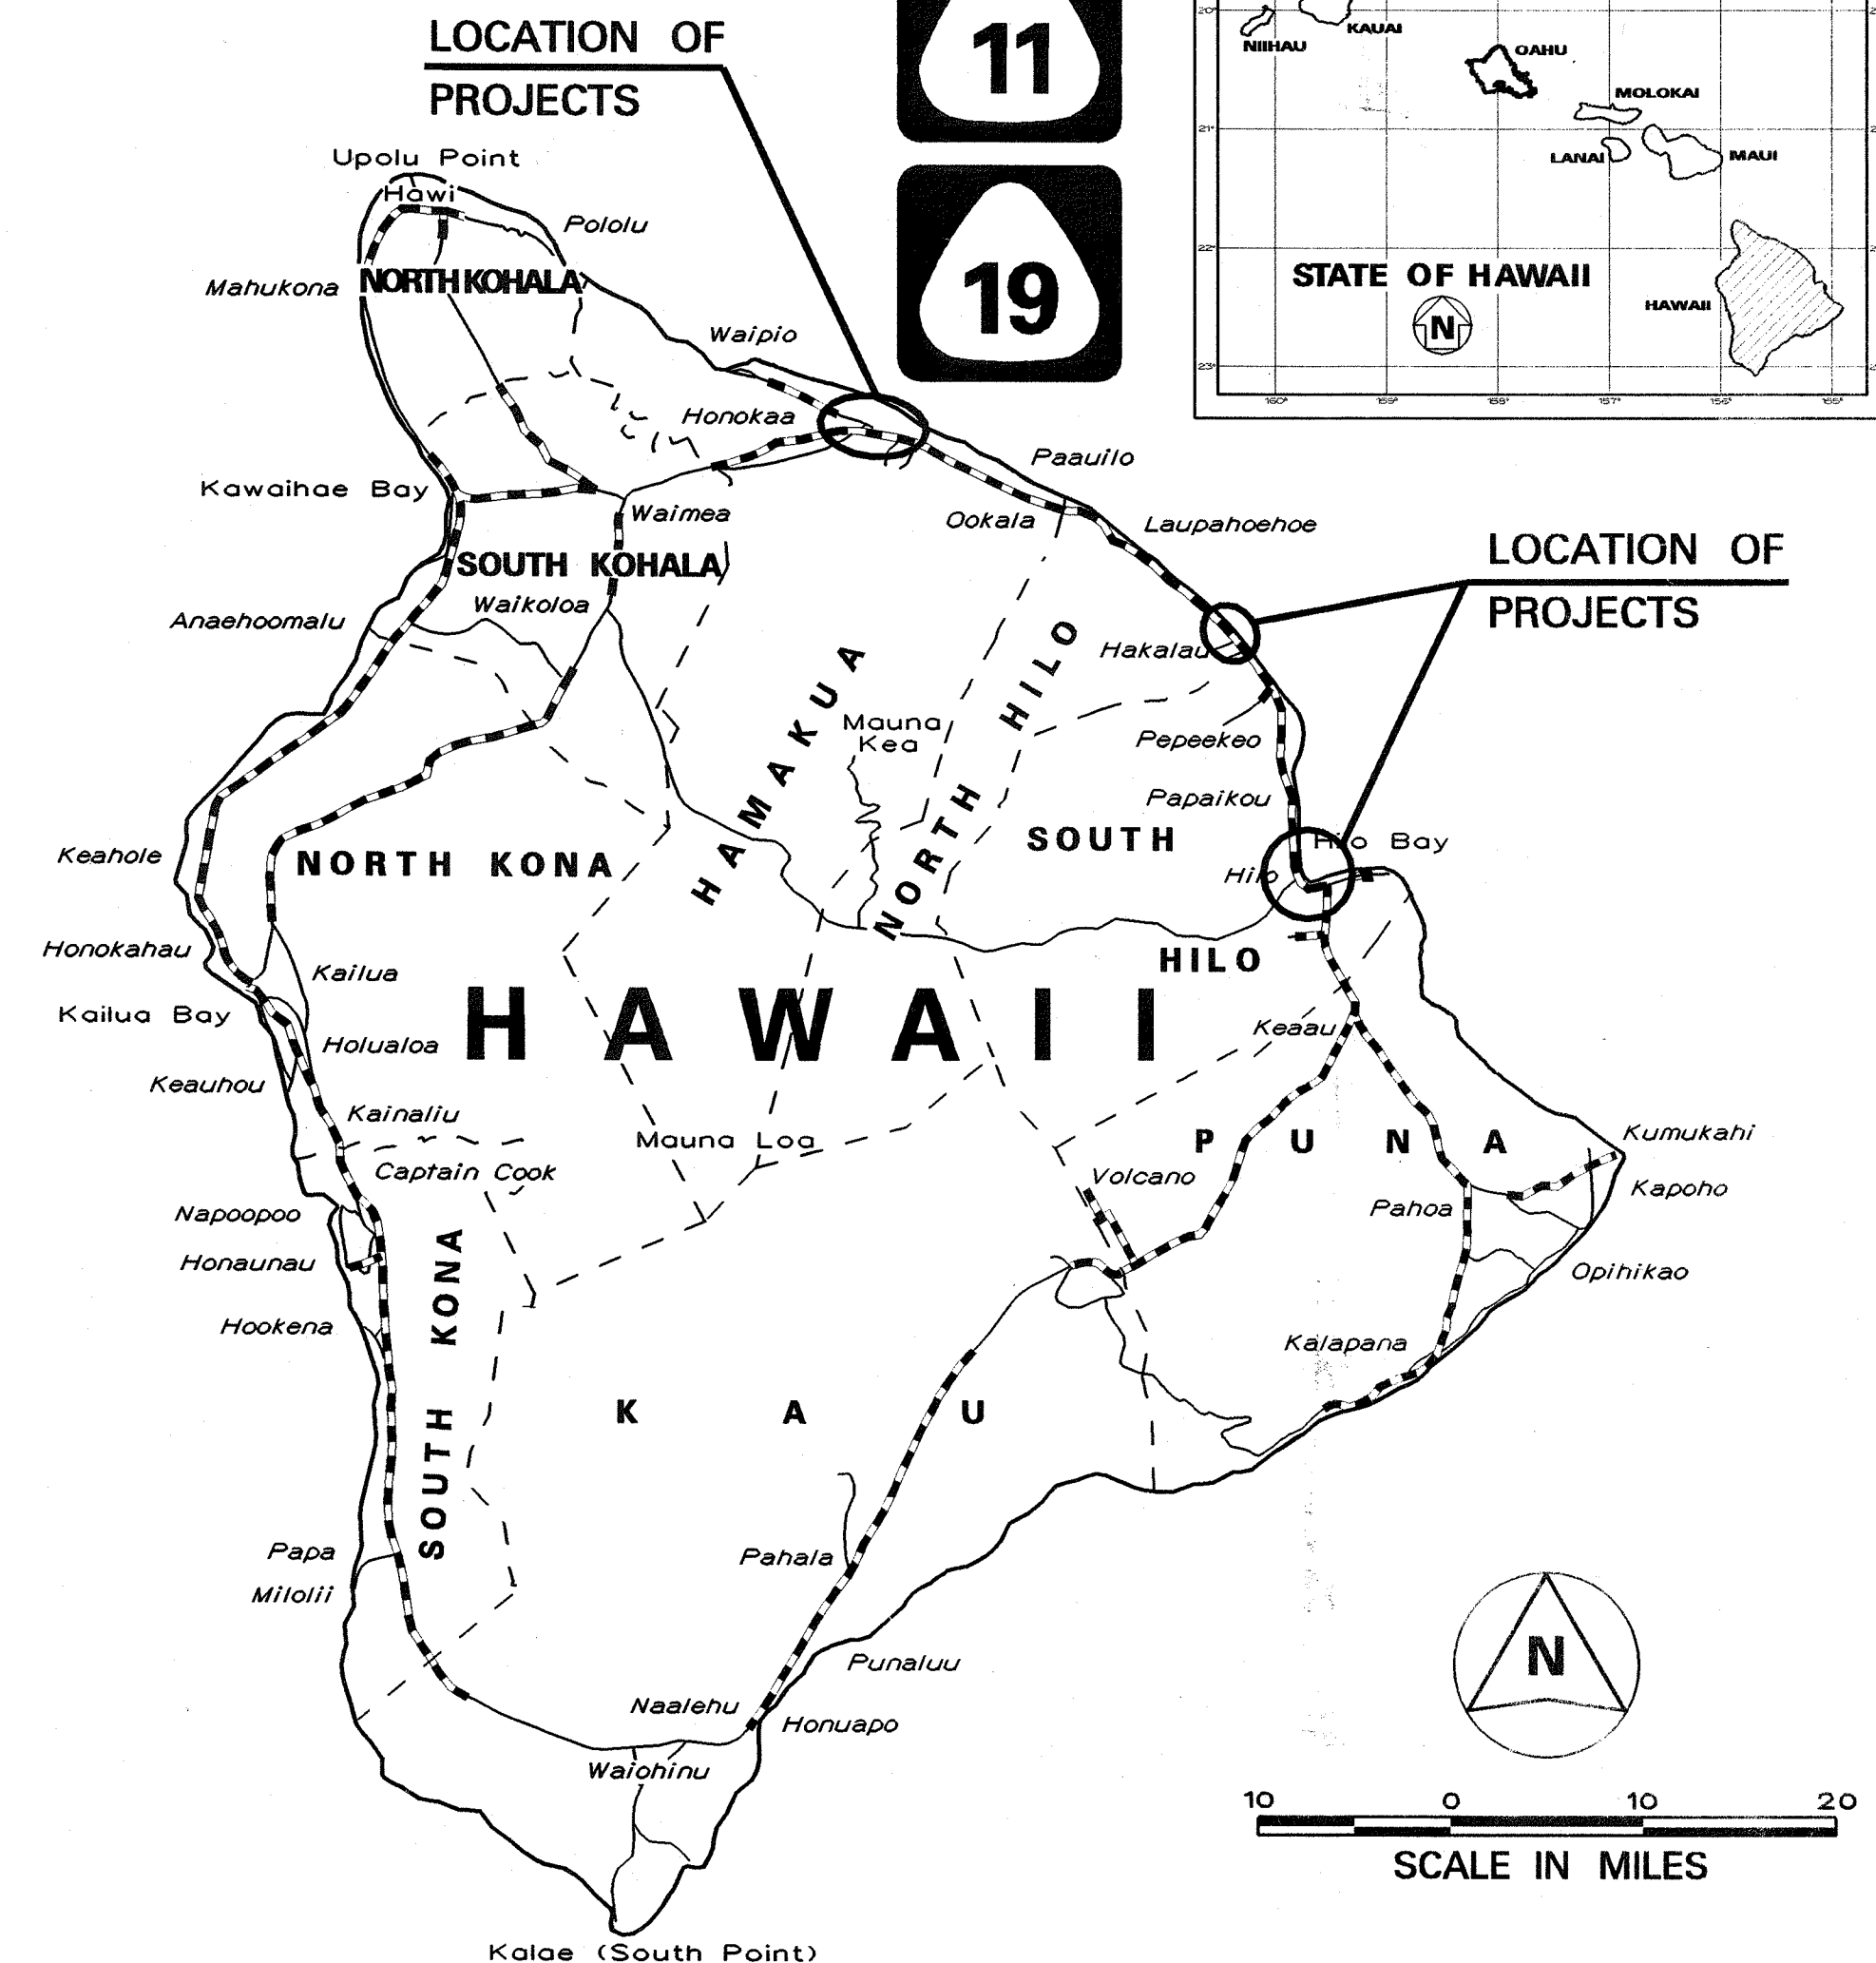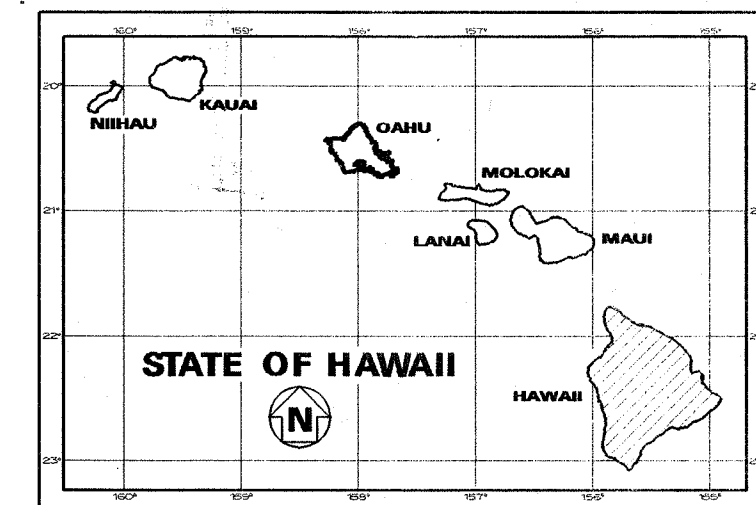

FEDERAL AID PROJECTS PREVIOUSLY CONSTRUCTED OR UNDER CONSTRUCTION

MILE POST 39.59 TO MILE POST 41.56
MILE POST 20.00 TO MILE POST 20.01
MILE POST 3.00 TO MILE POST 3.30

	Route 11, M.P. 3.00 to 3.30	Route 19, M.P. 20.00 to 20.01	Route 19, M.P. 39.59 to 41.56
ADT (2006)	33,300	7,300	10,400
ADT (2026)	42,800	10,100	14,400
DHV	3,900	860	1,200
Design D	80/20	55/45	60/40
Design T	5.0	7.0	7.0
T24	4.0	10.0	10.0
V	65	65	65

DEPARTMENT OF TRANSPORTATION STATE OF HAWAII
APPROVED:
<i>[Signature]</i> 3-16-07 DIR. OF TRANSPORTATION DATE

HWY-DD AUG., 2006
DESIGNED BY 692-7570 PHONE
MANAGED BY

CHANGES MADE DURING CONSTRUCTION HAVE BEEN
INCORPORATED ON THESE PLANS EXCEPT CHANGES
IN THE ORIGINAL THEORETICAL QUANTITIES. FOR
ACTUAL QUANTITIES, REFER TO PROJECT LEDGER
AND/OR COMPUTATION BOOK.

[Signature] 5-2-11
RESIDENT ENGINEER DATE