



FED. ROAD DIST. NO.	STATE	FED. AID PROJ. NO.	FISCAL YEAR	SHEET NO.	TOTAL SHEETS
HAWAII	HAW.	BR-019-2(57)	2005	8	13

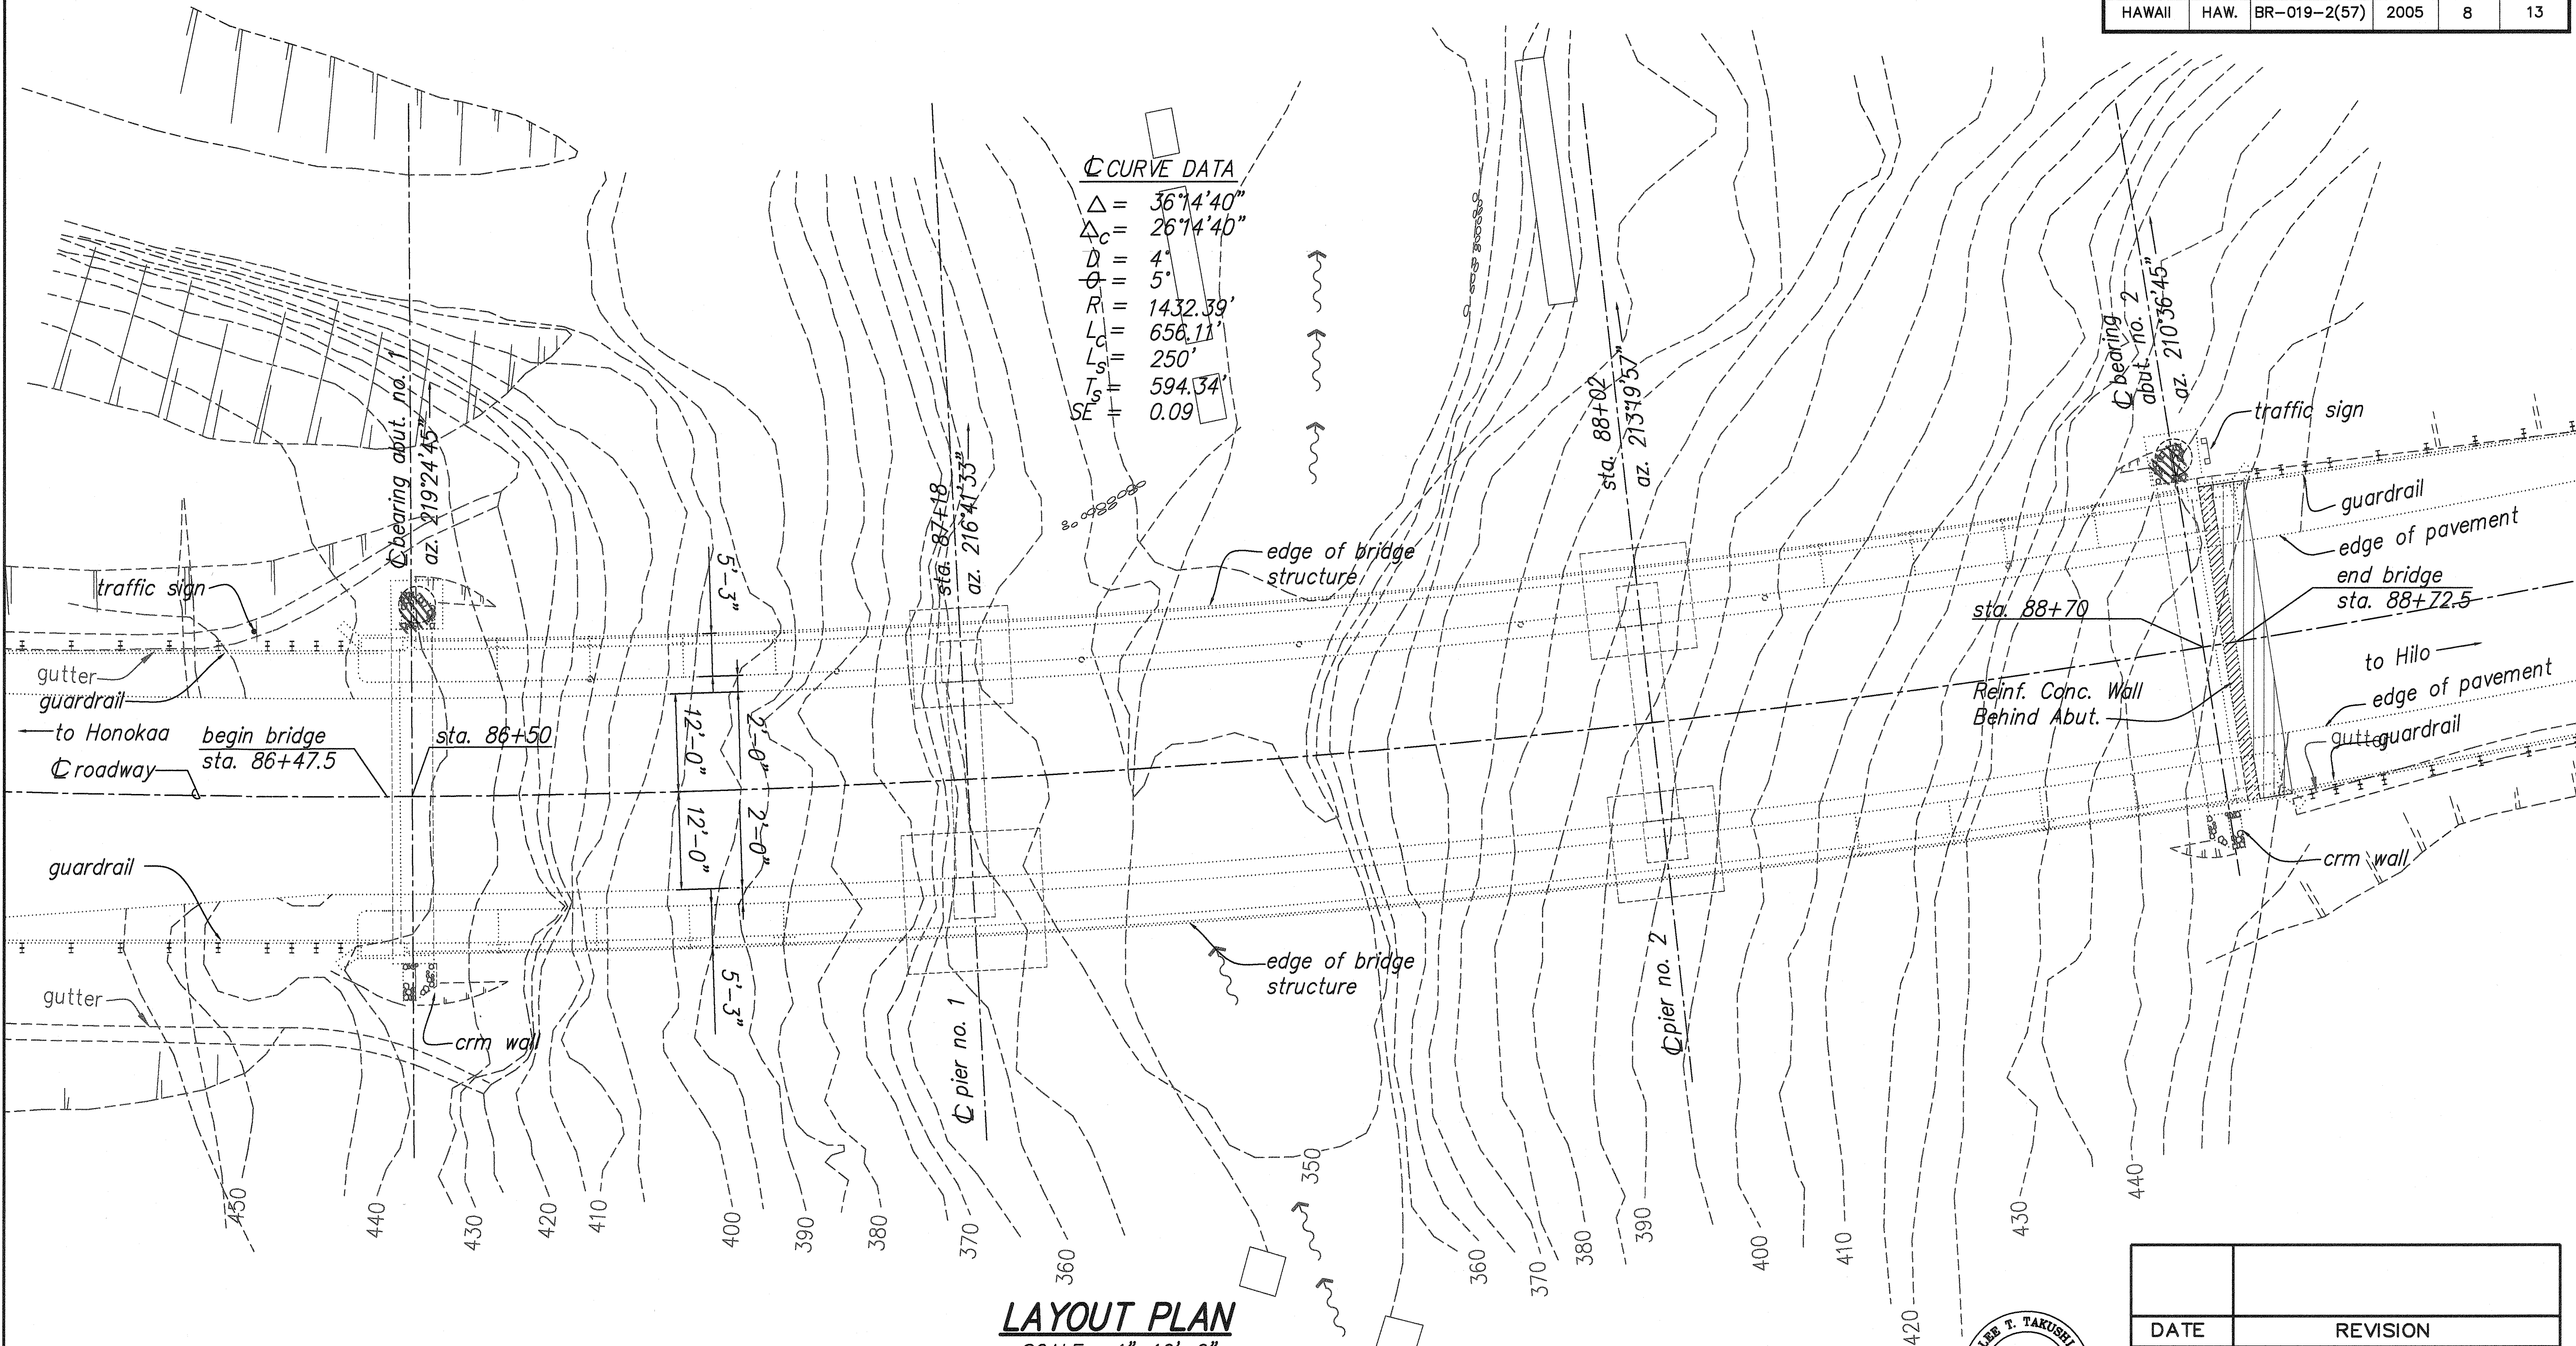

LAYOUT PLAN
SCALE: 1"=10'-0"


ORIGINAL PLAN	SURVEY PLOTTED BY	DATE
NO. 1	DRAWN BY	" "
NO. 2	CHECKED BY	" "
NO. 3	QUANTITIES BY	" "
NO. 4	CHECKED BY	" "

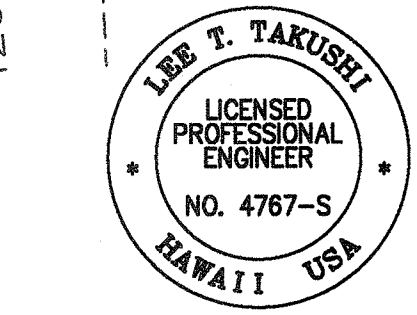

Lee T. Takushi 04/30/06
SIGNATURE EXP. DATE OF THE LICENSE
THIS WORK WAS PREPARED BY ME OR UNDER MY SUPERVISION


DATE	REVISION
STATE OF HAWAII DEPARTMENT OF TRANSPORTATION HIGHWAYS DIVISION KILAU BRIDGE LAYOUT PLAN	
HAWAII BELT ROAD, SEISMIC RETROFIT OF VARIOUS BRIDGES, VICINITY OF LAUPAHOEHOE FEDERAL AID PROJECT NO. BR-019-2(57)	
SCALE: AS NOTED	DATE: OCT 2004

FED. ROAD DIST. NO.	STATE	FED. AID PROJ. NO.	FISCAL YEAR	SHEET NO.	TOTAL SHEETS
HAWAII	HAW.	BR-019-2(57)	2005	9	13

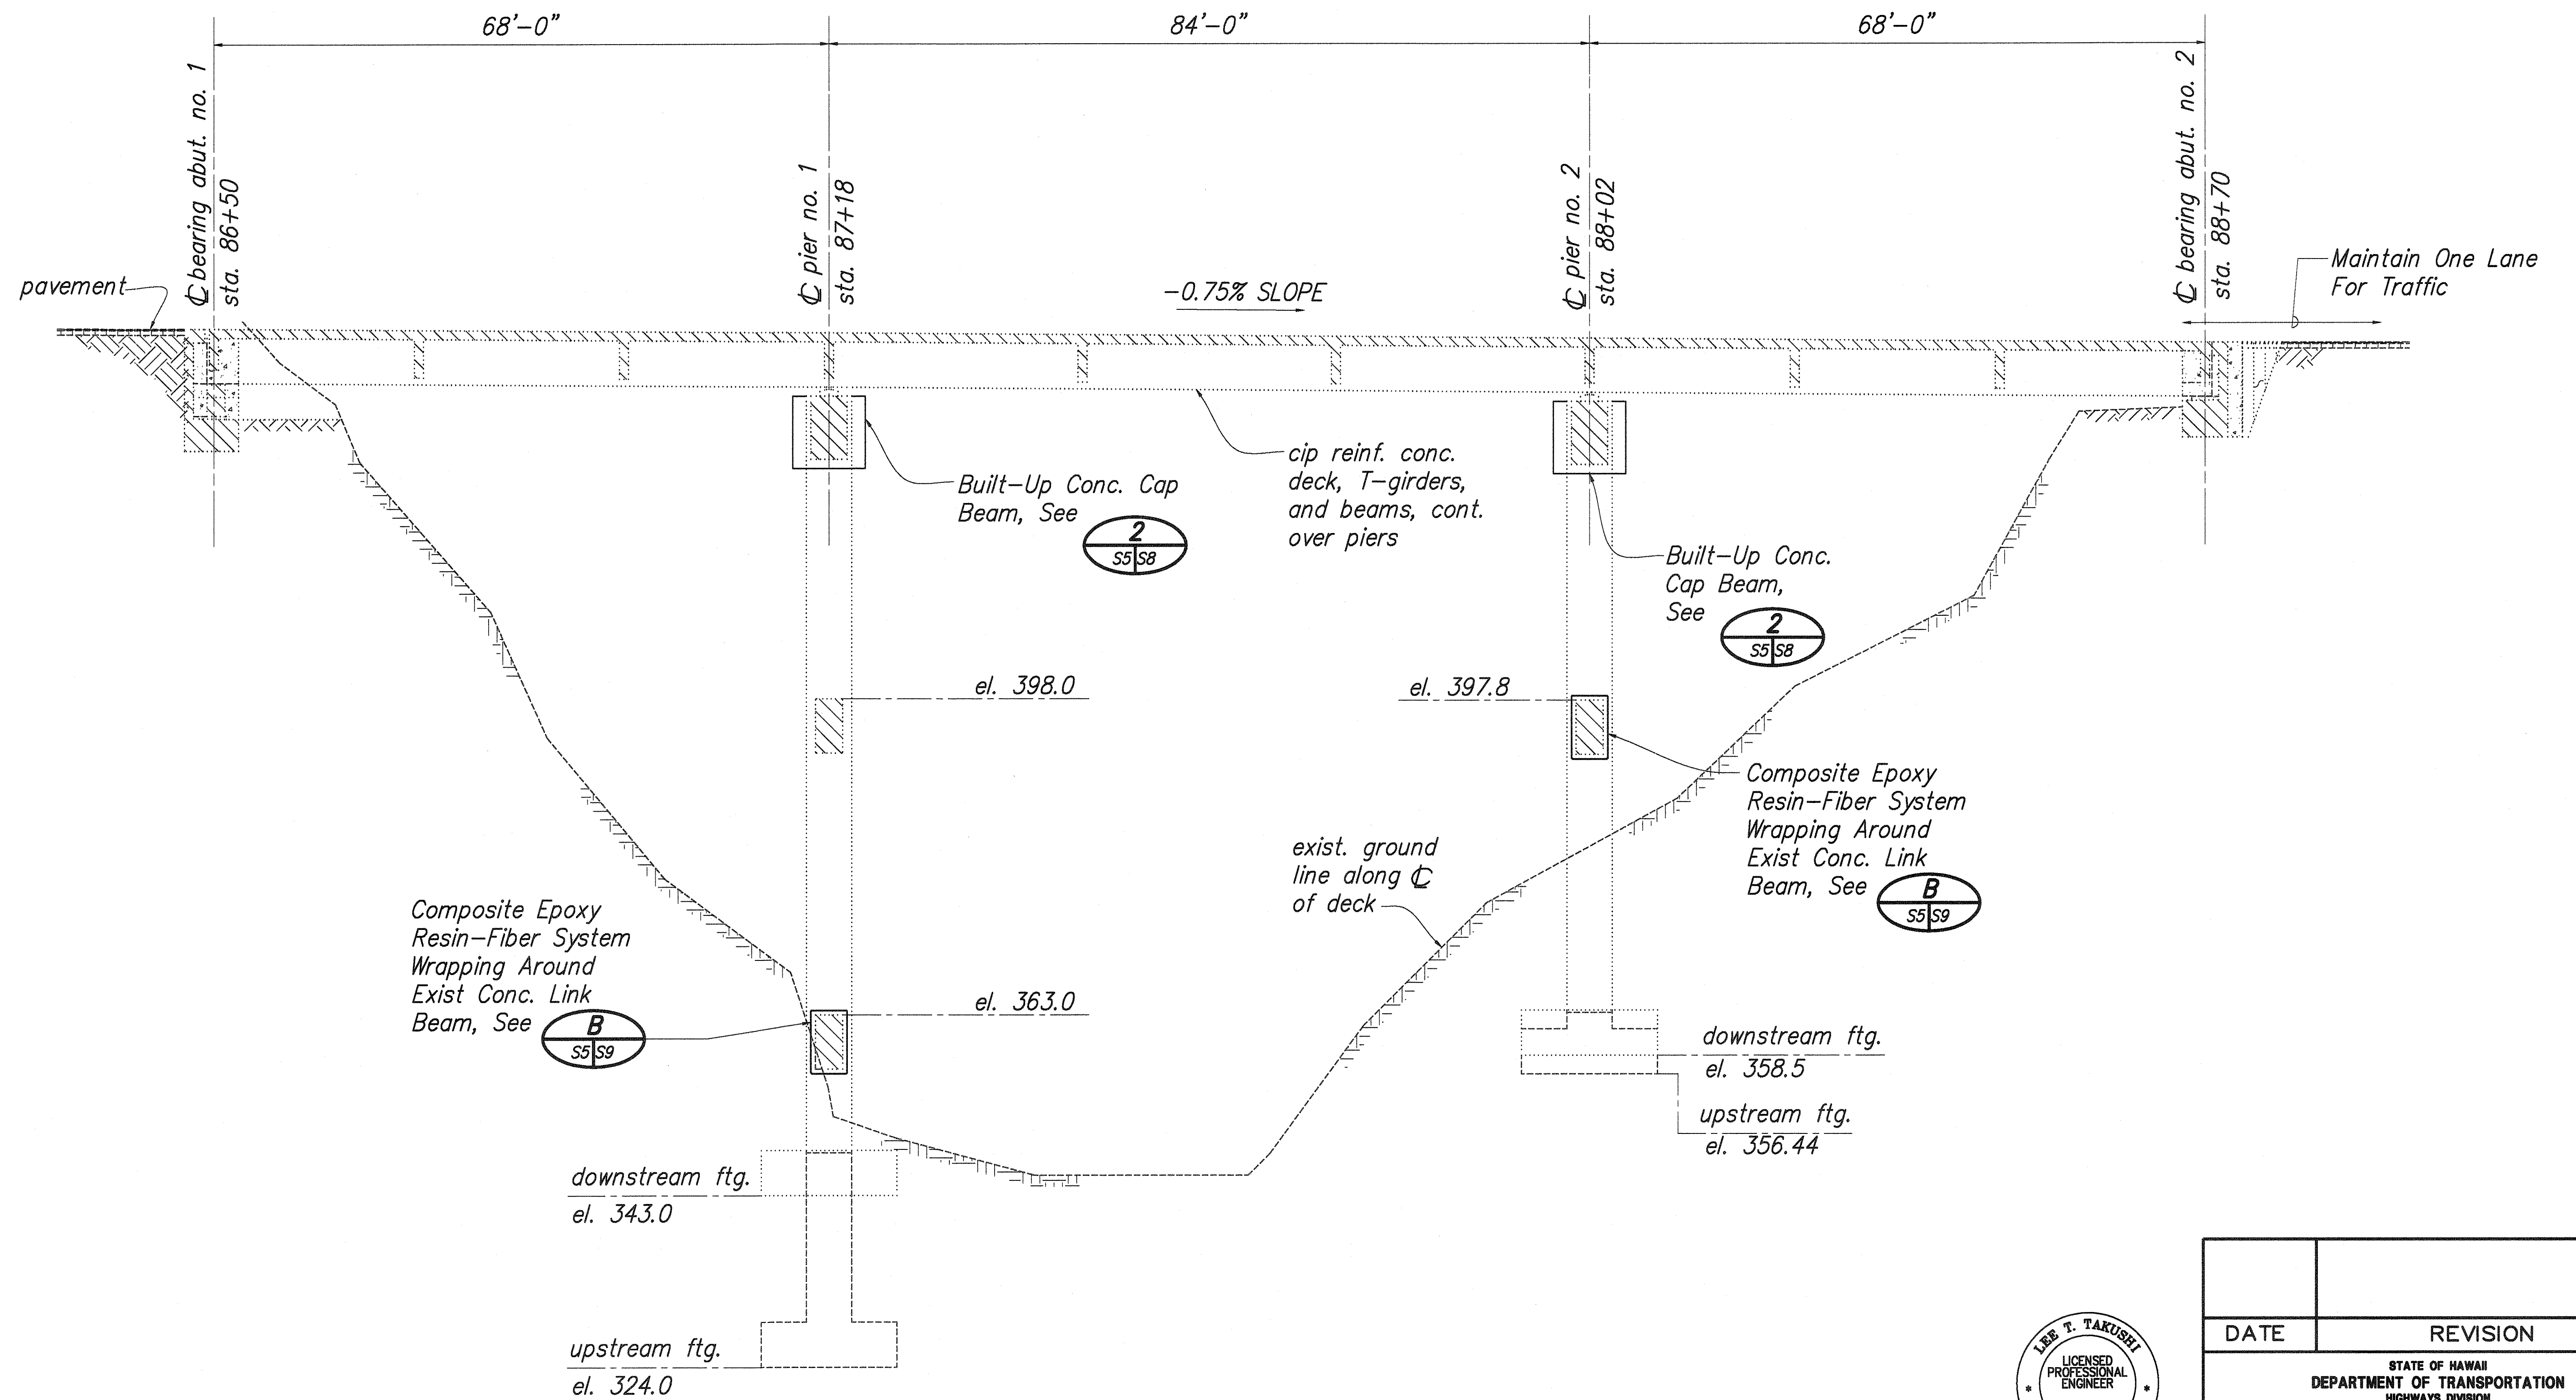

LONGITUDINAL SECTION ALONG ϕ ROADWAY
SCALE: 1" = 10'-0"

SURVEY PLOTTED BY	DATE
DESIGNED BY	" "
TRACED BY	" "
NOTED BY	" "
CHECKED BY	" "
NO.	

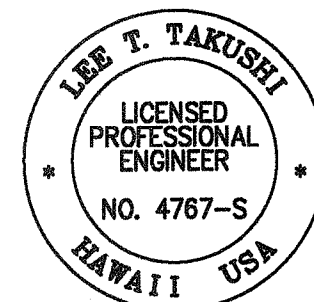

Lee T. Takushi 04/30/06
SIGNATURE EXP. DATE OF THE LICENSE
THIS WORK WAS PREPARED BY ME OR UNDER MY SUPERVISION

DATE	REVISION
	STATE OF HAWAII DEPARTMENT OF TRANSPORTATION HIGHWAYS DIVISION
	KILAUE BRIDGE LONGITUDINAL SECTION
	HAWAII BELT ROAD, SEISMIC RETROFIT OF VARIOUS BRIDGES, VICINITY OF LAUPAHOEHOE FEDERAL AID PROJECT NO. BR-019-2(57)
	SCALE: AS NOTED DATE: OCT 2004

SHEET No. S5 OF 9 SHEETS

"AS-BUILT"