

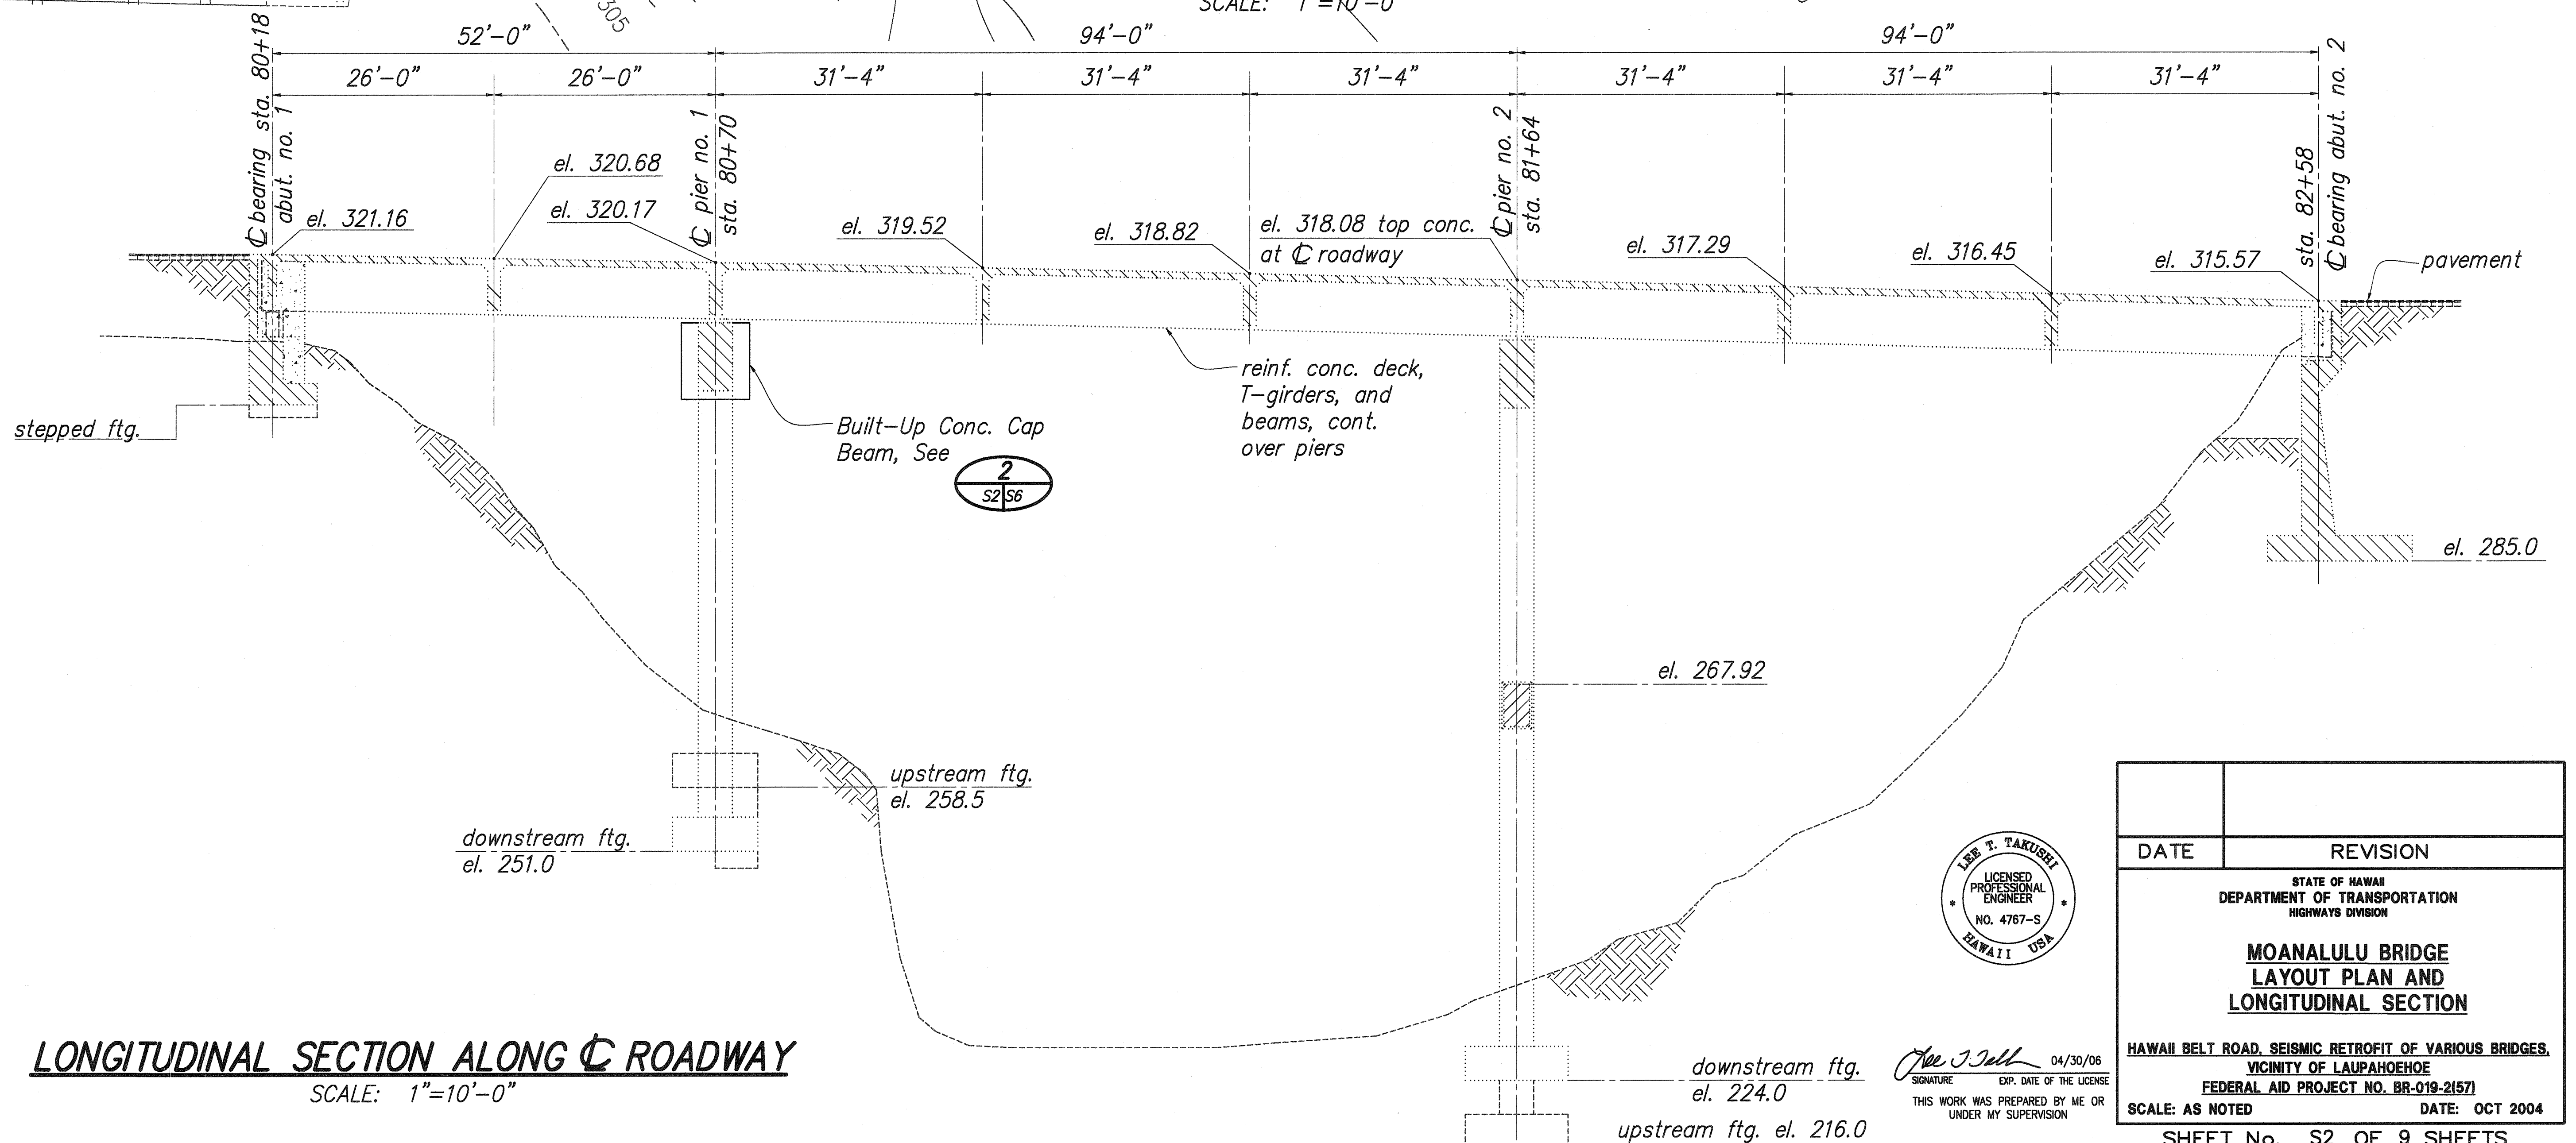


FED. ROAD DIST. NO.	STATE	FED. AID PROJ. NO.	FISCAL YEAR	SHEET NO.	TOTAL SHEETS
HAWAII	HAW.	BR-019-2(57)	2005	6	13

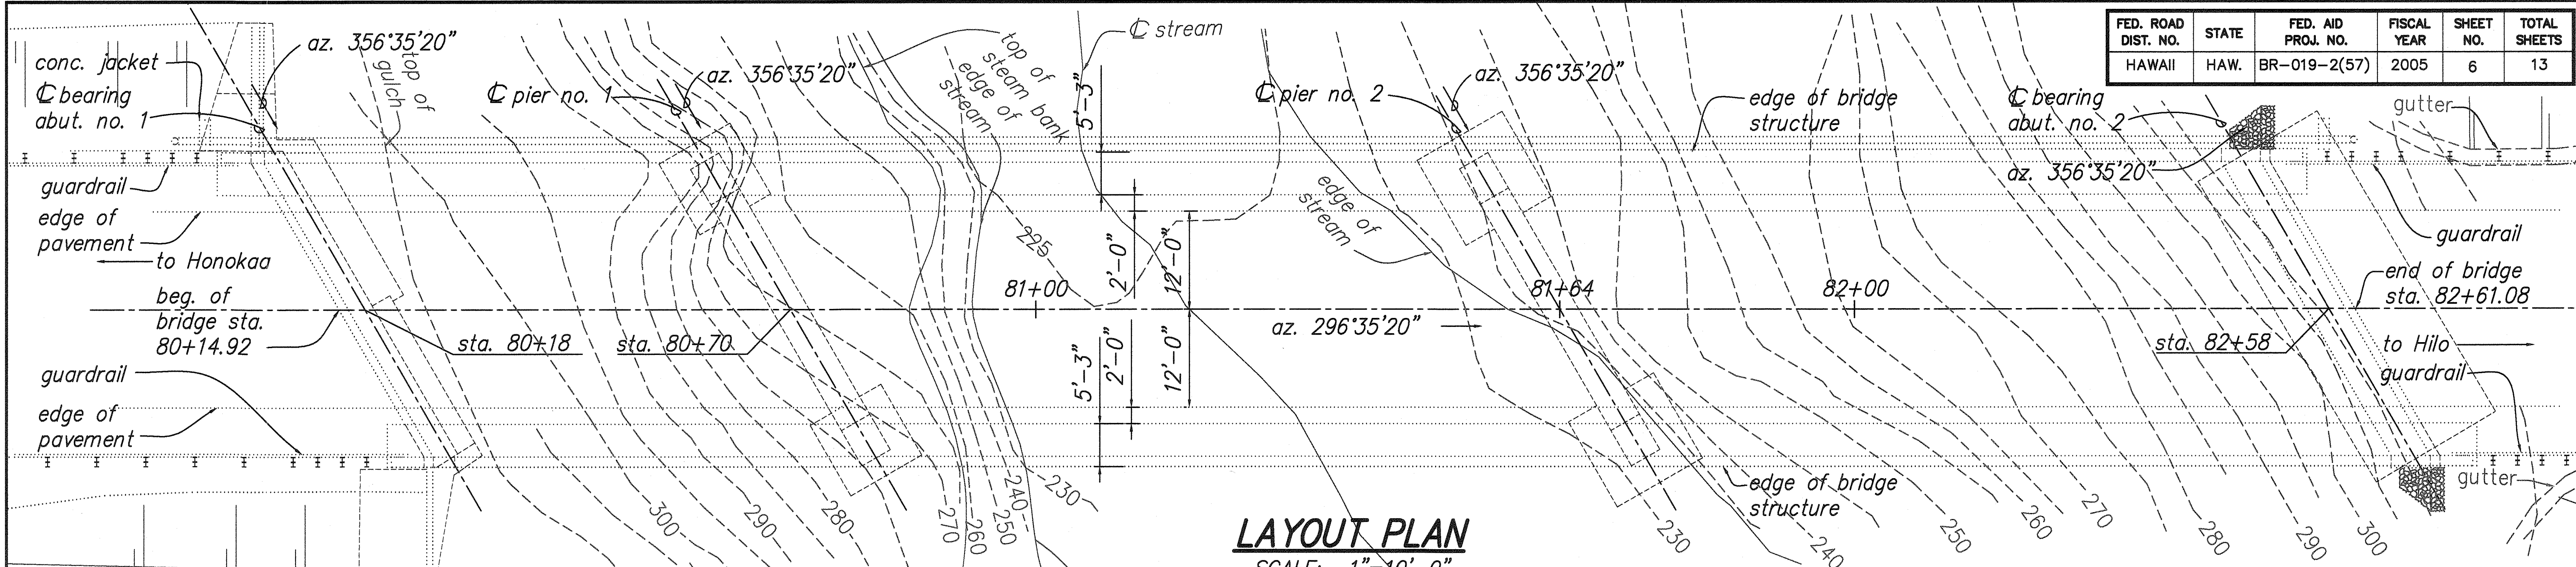

SURVEY PLOTTED BY	DATE
DESIGNED BY	" "
QUANTITIES BY	" "
CHECKED BY	" "

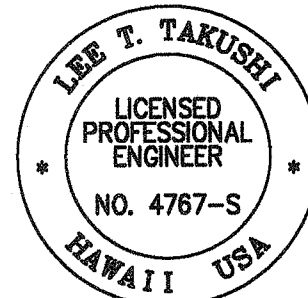

SIGNATURE: *Lee T. Takushi* 04/30/06
EXP. DATE OF THE LICENSE
THIS WORK WAS PREPARED BY ME OR UNDER MY SUPERVISION

DATE	REVISION

STATE OF HAWAII
DEPARTMENT OF TRANSPORTATION
HIGHWAYS DIVISION

**MOANALULU BRIDGE
LAYOUT PLAN AND
LONGITUDINAL SECTION**

HAWAII BELT ROAD, SEISMIC RETROFIT OF VARIOUS BRIDGES,
VICINITY OF LAUPAHOEHOE
FEDERAL AID PROJECT NO. BR-019-2(57)

SCALE: AS NOTED DATE: OCT 2004

SHEET No. S2 OF 9 SHEETS

"AS-BUILT"