
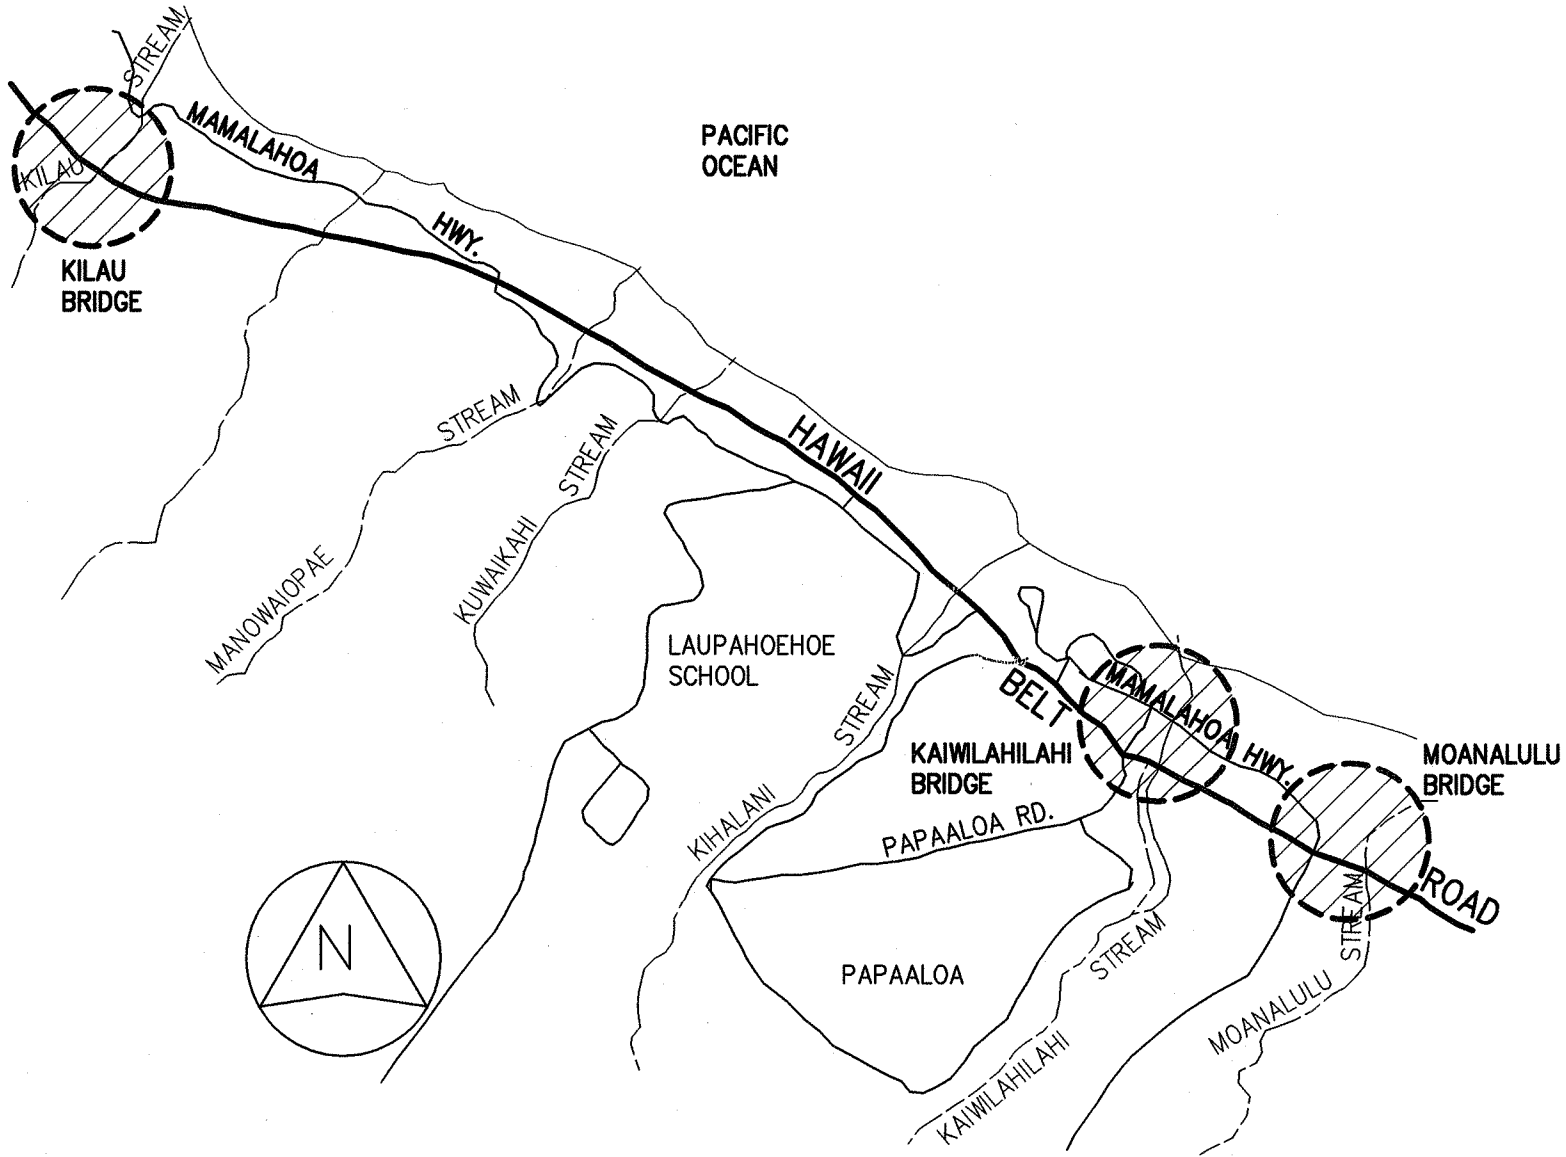
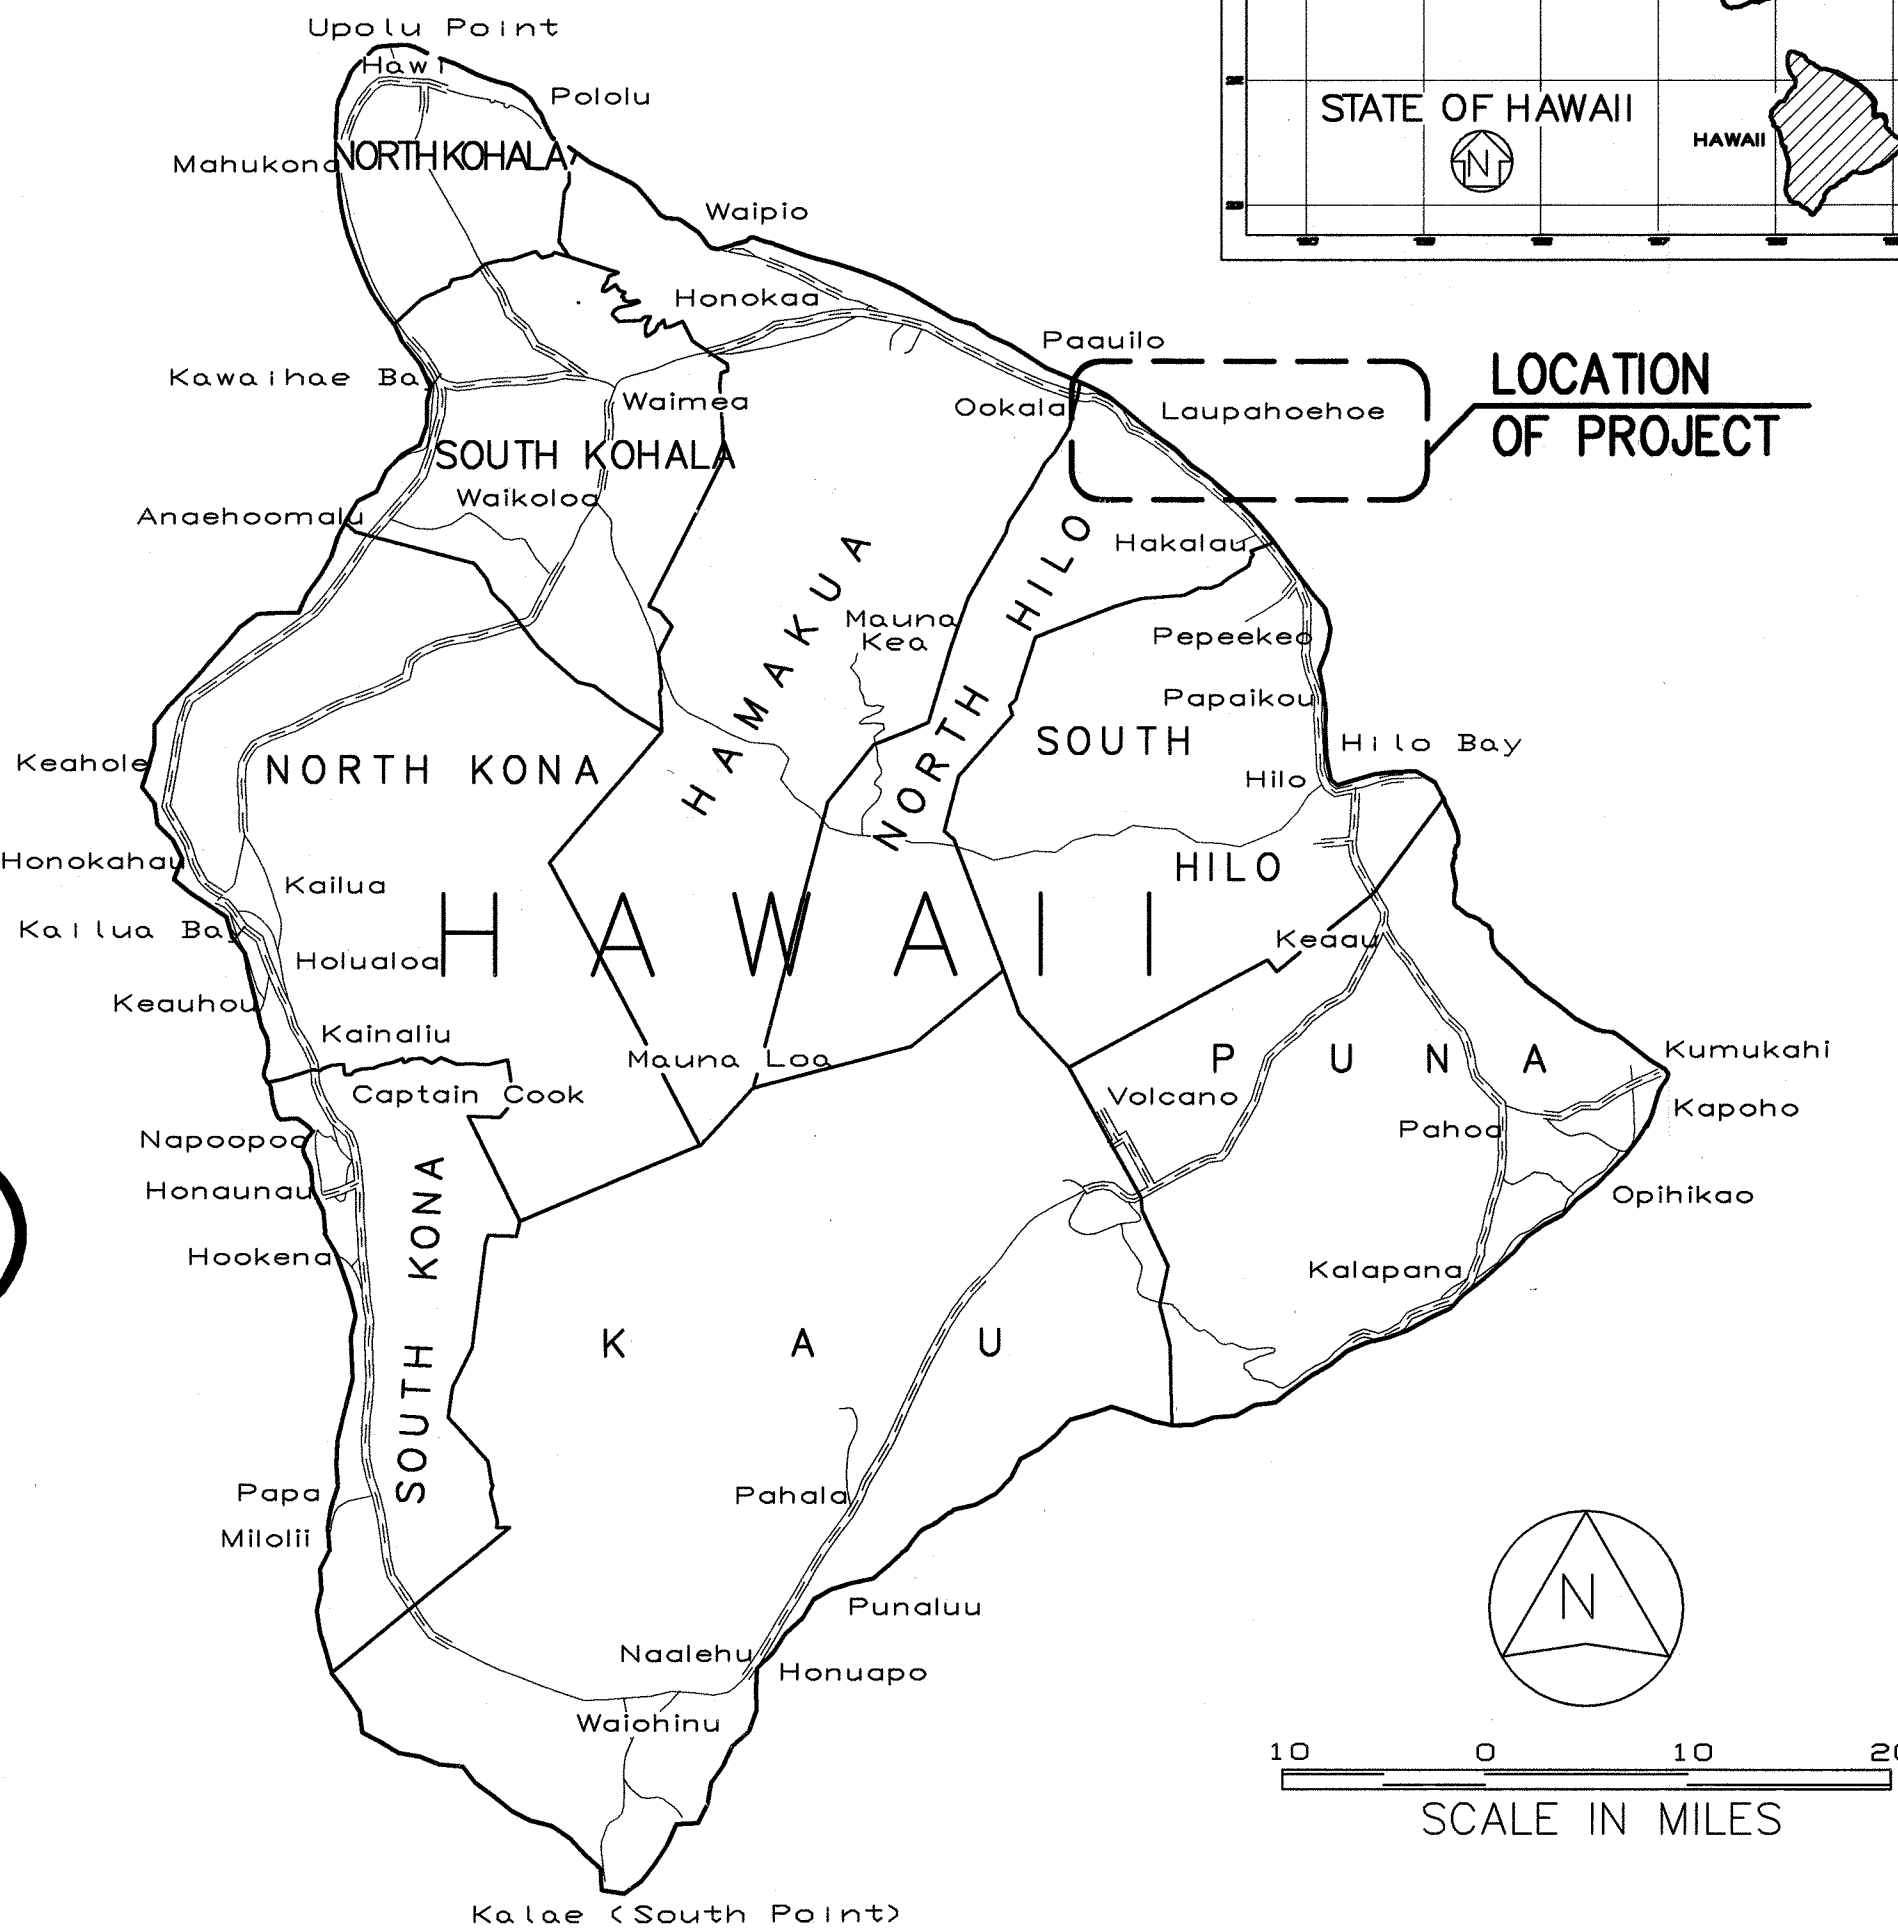


INDEX TO DRAWINGS	
SHEET NO.	DESCRIPTION
1	TITLE SHEET
2	STANDARD PLANS SUMMARY
3	WATER POLLUTION AND EROSION CONTROL NOTES
4	WATER POLLUTION AND EROSION CONTROL NOTES
5	GENERAL NOTES
6	MOANALULU BRIDGE - LAYOUT PLAN AND LONGITUDINAL SECTION
7	KAIWILAHILAHI BRIDGE - LAYOUT PLAN AND LONGITUDINAL SECTION
8	KILAU BRIDGE - LAYOUT PLAN
9	KILAU BRIDGE - LONGITUDINAL SECTION
10	MOANALULU BRIDGE PIER NO.1 NEW CONDITION PLAN AND SECTIONS
11	KAIWILAHILAHI BRIDGE PIER NO.1 AND NO.2 NEW CONDITION PLAN AND SECTIONS
12	KILAU BRIDGE PIER NO.1 AND NO.2 NEW CONDITION PLAN AND SECTIONS
13	TYPICAL LINK BEAM DETAILS

STATE OF HAWAII
DEPARTMENT OF TRANSPORTATION
HIGHWAYS DIVISION
HONOLULU, HAWAII
"AS-BUILT"
PLANS FOR

HAWAII BELT ROAD
SEISMIC RETROFIT OF VARIOUS BRIDGES
VICINITY OF LAUPAHOEHOE
PHASE 2
FEDERAL AID PROJECT NO. BR-019-2(57)
DISTRICT OF NORTH HILO
ISLAND OF HAWAII

FED. ROAD DIST. NO.	STATE	FED. AID PROJ. NO.	FISCAL YEAR	SHEET NO.	TOTAL SHEETS
HAWAII	HAW.	BR-019-2(57)	2005	1	13

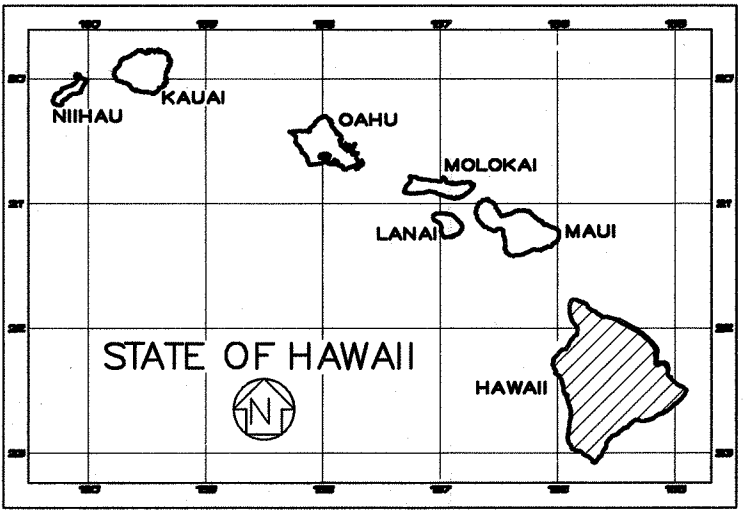

LAYOUT PLAN
NOT TO SCALE

MOANALULU BRIDGE	M.P. 23.66
KAIWILAHILAHI BRIDGE	M.P. 23.96
KILAU BRIDGE	M.P. 25.63

CHANGES MADE DURING CONSTRUCTION HAVE BEEN INCORPORATED ON THESE PLANS EXCEPT CHANGES IN THE ORIGINAL THEORETICAL QUANTITIES. FOR ACTUAL QUANTITIES, REFER TO PROJECT LEDGER AND/OR COMPUTATION BOOK.

[Signature] 12-8-09
RESIDENT ENGINEER DATE

DEPARTMENT OF TRANSPORTATION
STATE OF HAWAII
APPROVED:
[Signature] 3-3-06
DIR. OF TRANSPORTATION DATE

ORIGINAL PLAN	DATE
SURVEY PLOTTED BY	
DRAWN BY	
DESIGNED BY	
CHECKED BY	
NOTE BOOK	
NO.	

3-3-06
DATE

692-7545
PHONE

HWY-DS
MANAGED BY

SSFM INTERNATIONAL, INC.
DESIGNED BY