



FED. ROAD DIST. NO.	STATE	FED. AID PROJ. NO.	FISCAL YEAR	SHEET NO.	TOTAL SHEETS
HAWAII	HAW.	BR-019-2(59)	2009	5	22

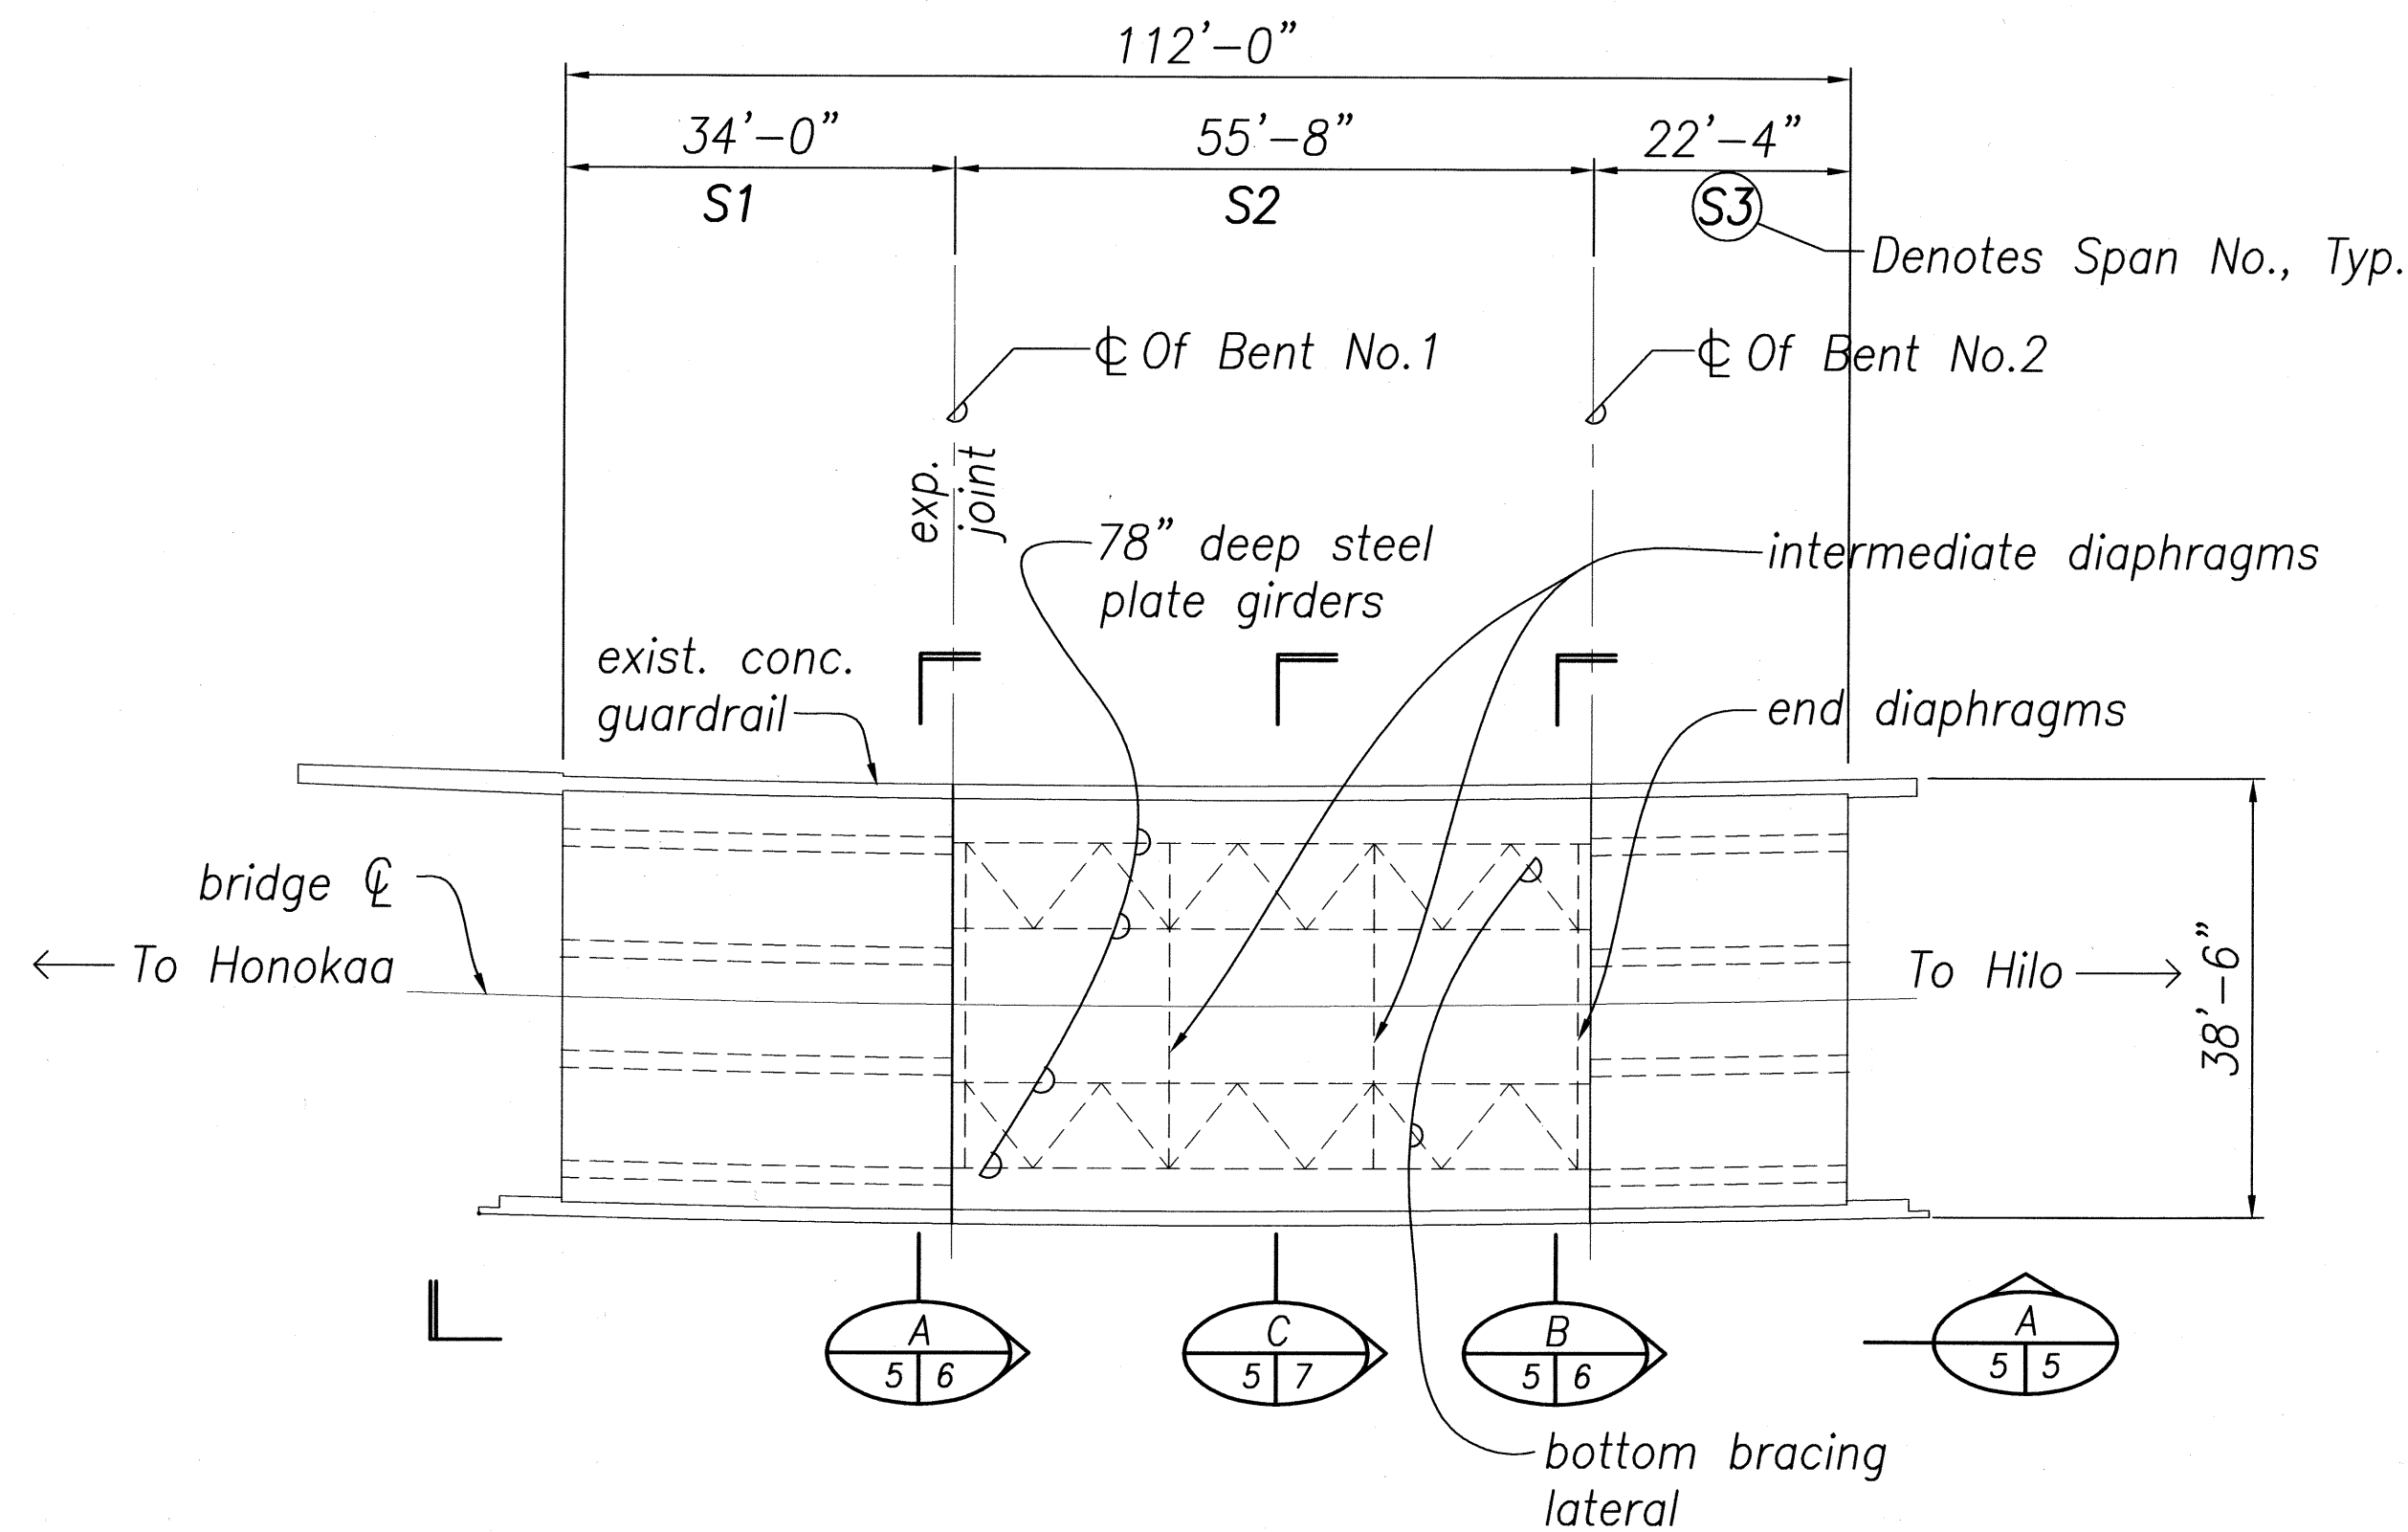


DECK PLAN – NINOLE BRIDGE 1
5 | 5
Scale: 1/16" = 1'-0"

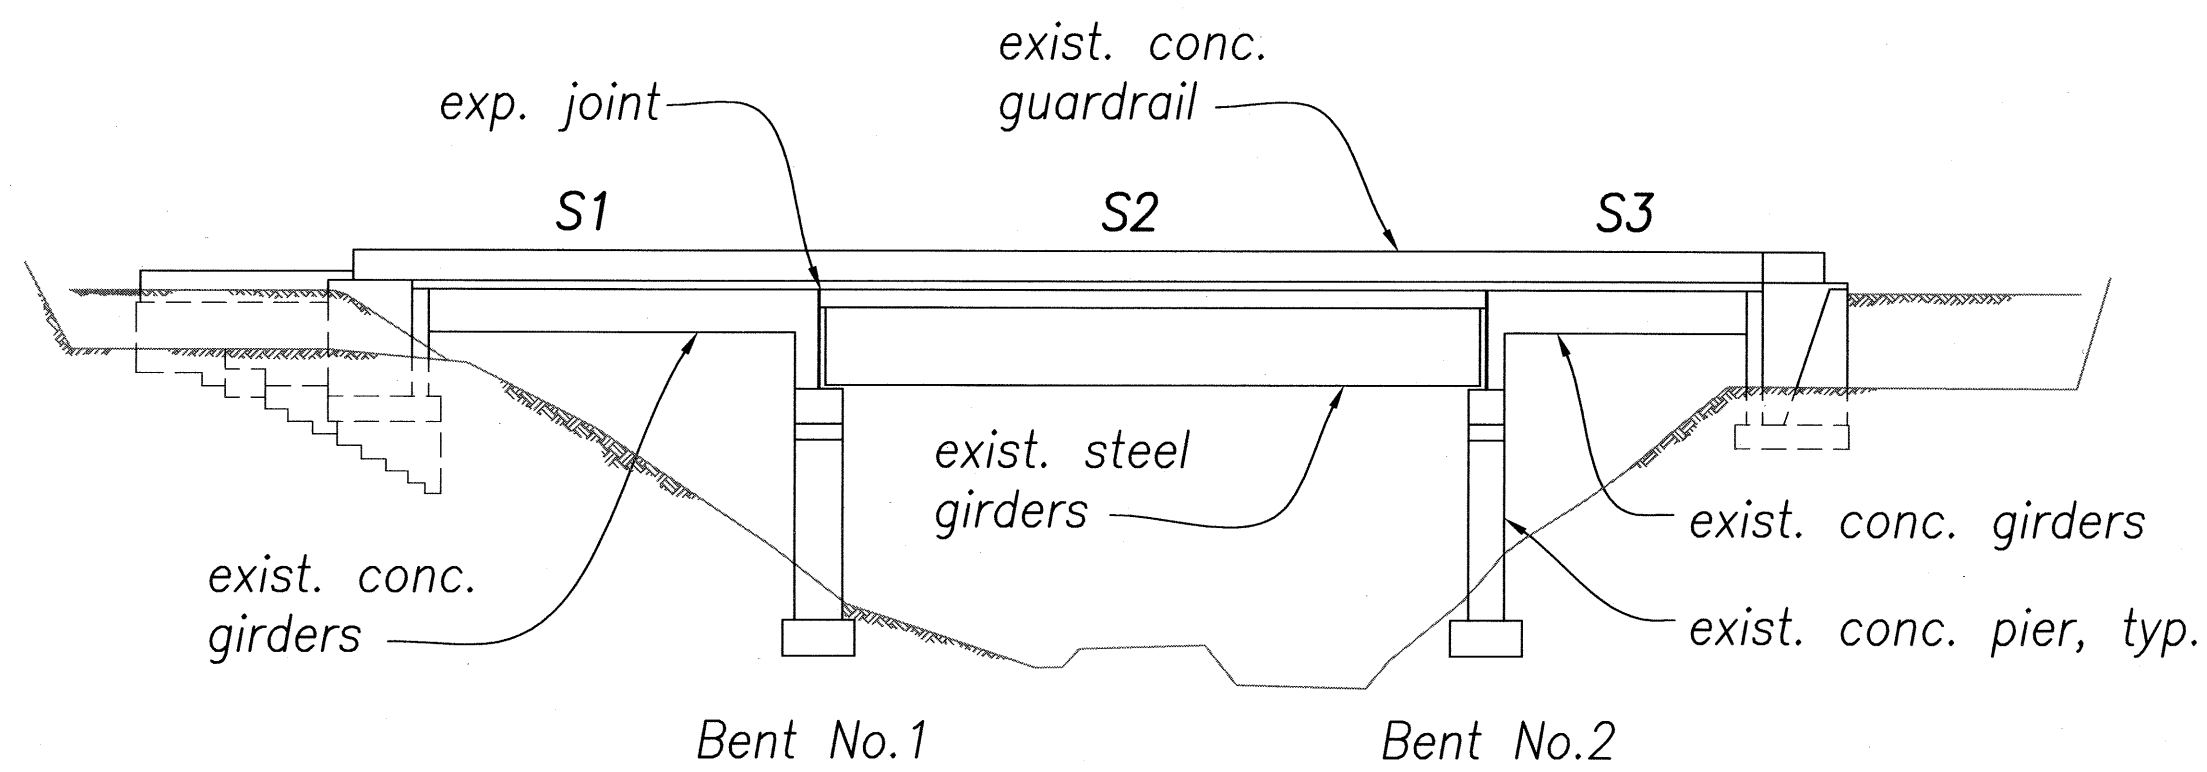

LONGITUDINAL ELEVATION – NINOLE BRIDGE A
5 | 5
Scale: 1/16" = 1'-0"

ORIGINAL PLAN	SURVEY PLOTTED BY	DATE
NOTE BOOK	DRAWN BY	" "
No.	DESIGNED BY	" "
	CHECKED BY	" "

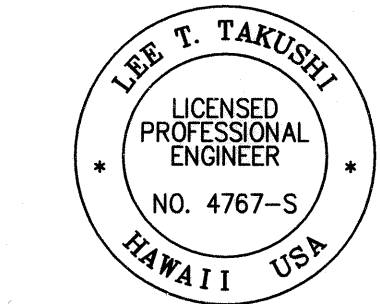


THIS WORK WAS PREPARED BY ME OR UNDER MY SUPERVISION

Lee T. Takushi 4/30/10
SIGNATURE EXP. DATE OF THE LICENSE


STATE OF HAWAII
DEPARTMENT OF TRANSPORTATION
HIGHWAYS DIVISION
NINOLE BRIDGE
PLAN AND ELEVATION
HAWAII BELT ROAD
CLEAN AND PAINT STEEL MEMBERS
NINOLE, MAULUA, KUWAIKAHI AND KUKAIAU
PROJECT NO. BR-019-2(59)

Scale: As Noted
Date: February 2009
Sheet No. 5 Of 22 Sheets

FED. ROAD DIST. NO.	STATE	FED. AID PROJ. NO.	FISCAL YEAR	SHEET NO.	TOTAL SHEETS
HAWAII	HAW.	BR-019-2(59)	2009	6	22

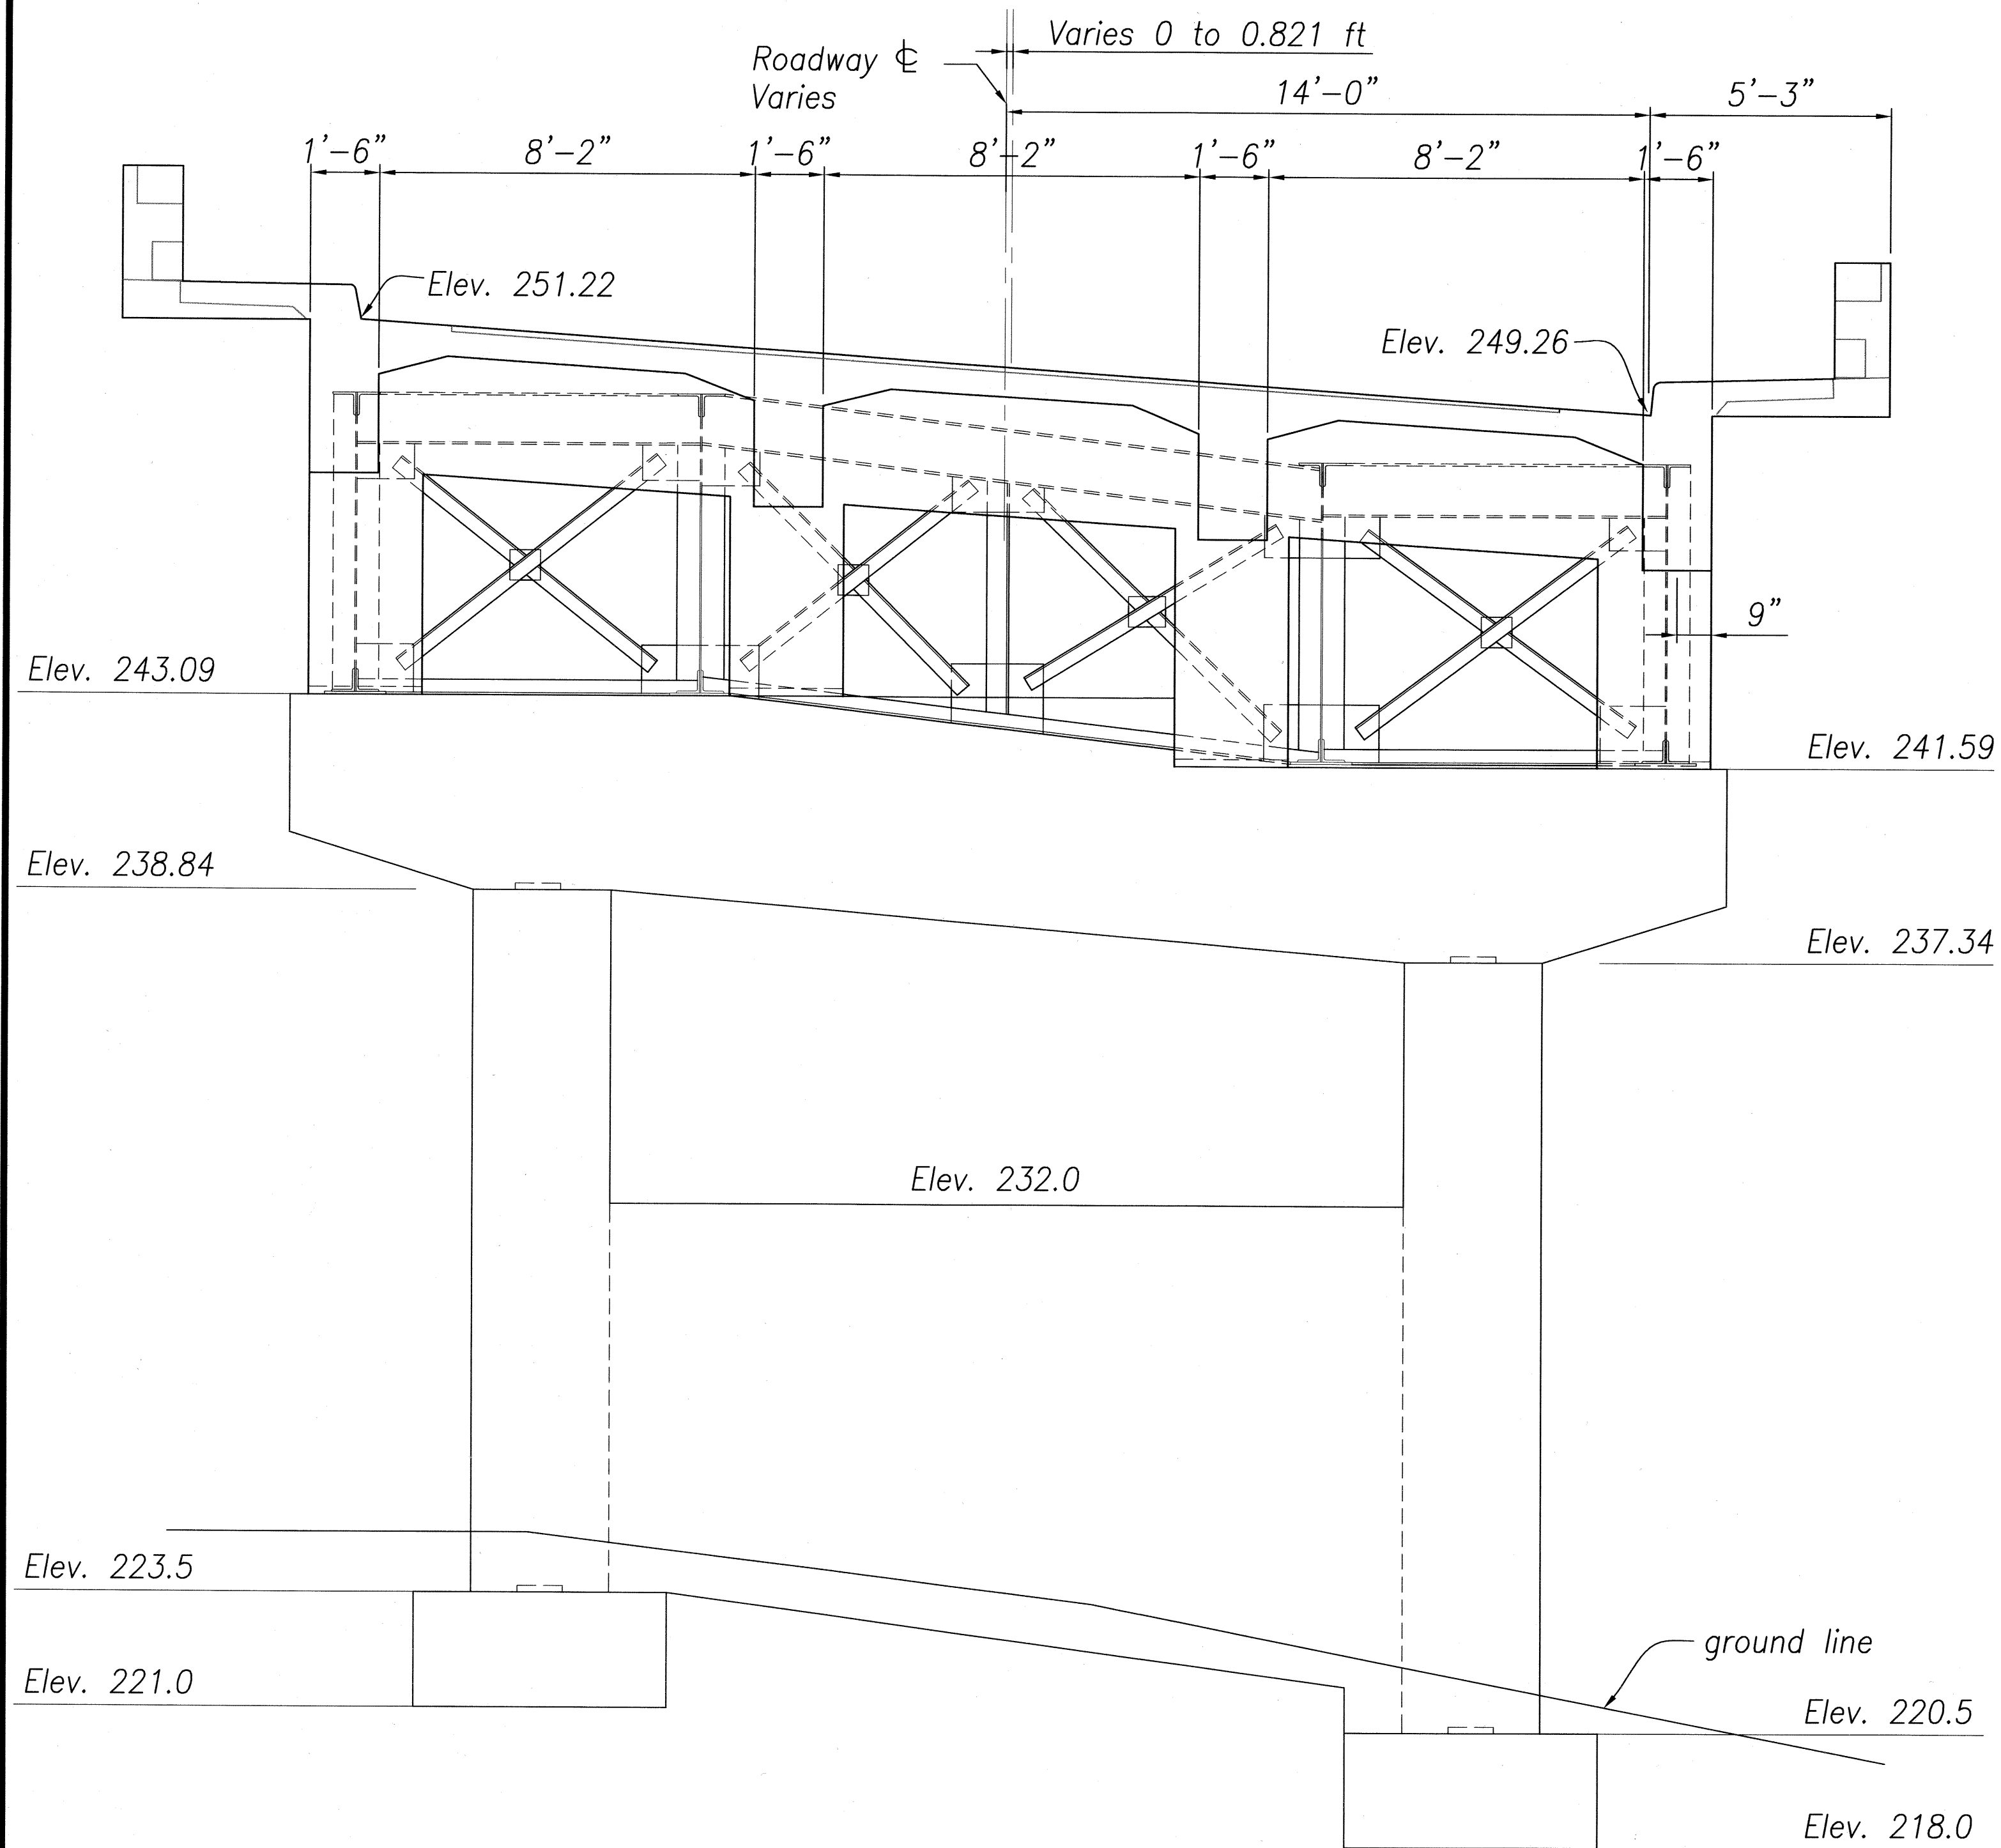


ELEVATION OF BENT No. 1 A
5 | 6
Scale: 3/8" = 1'-0"

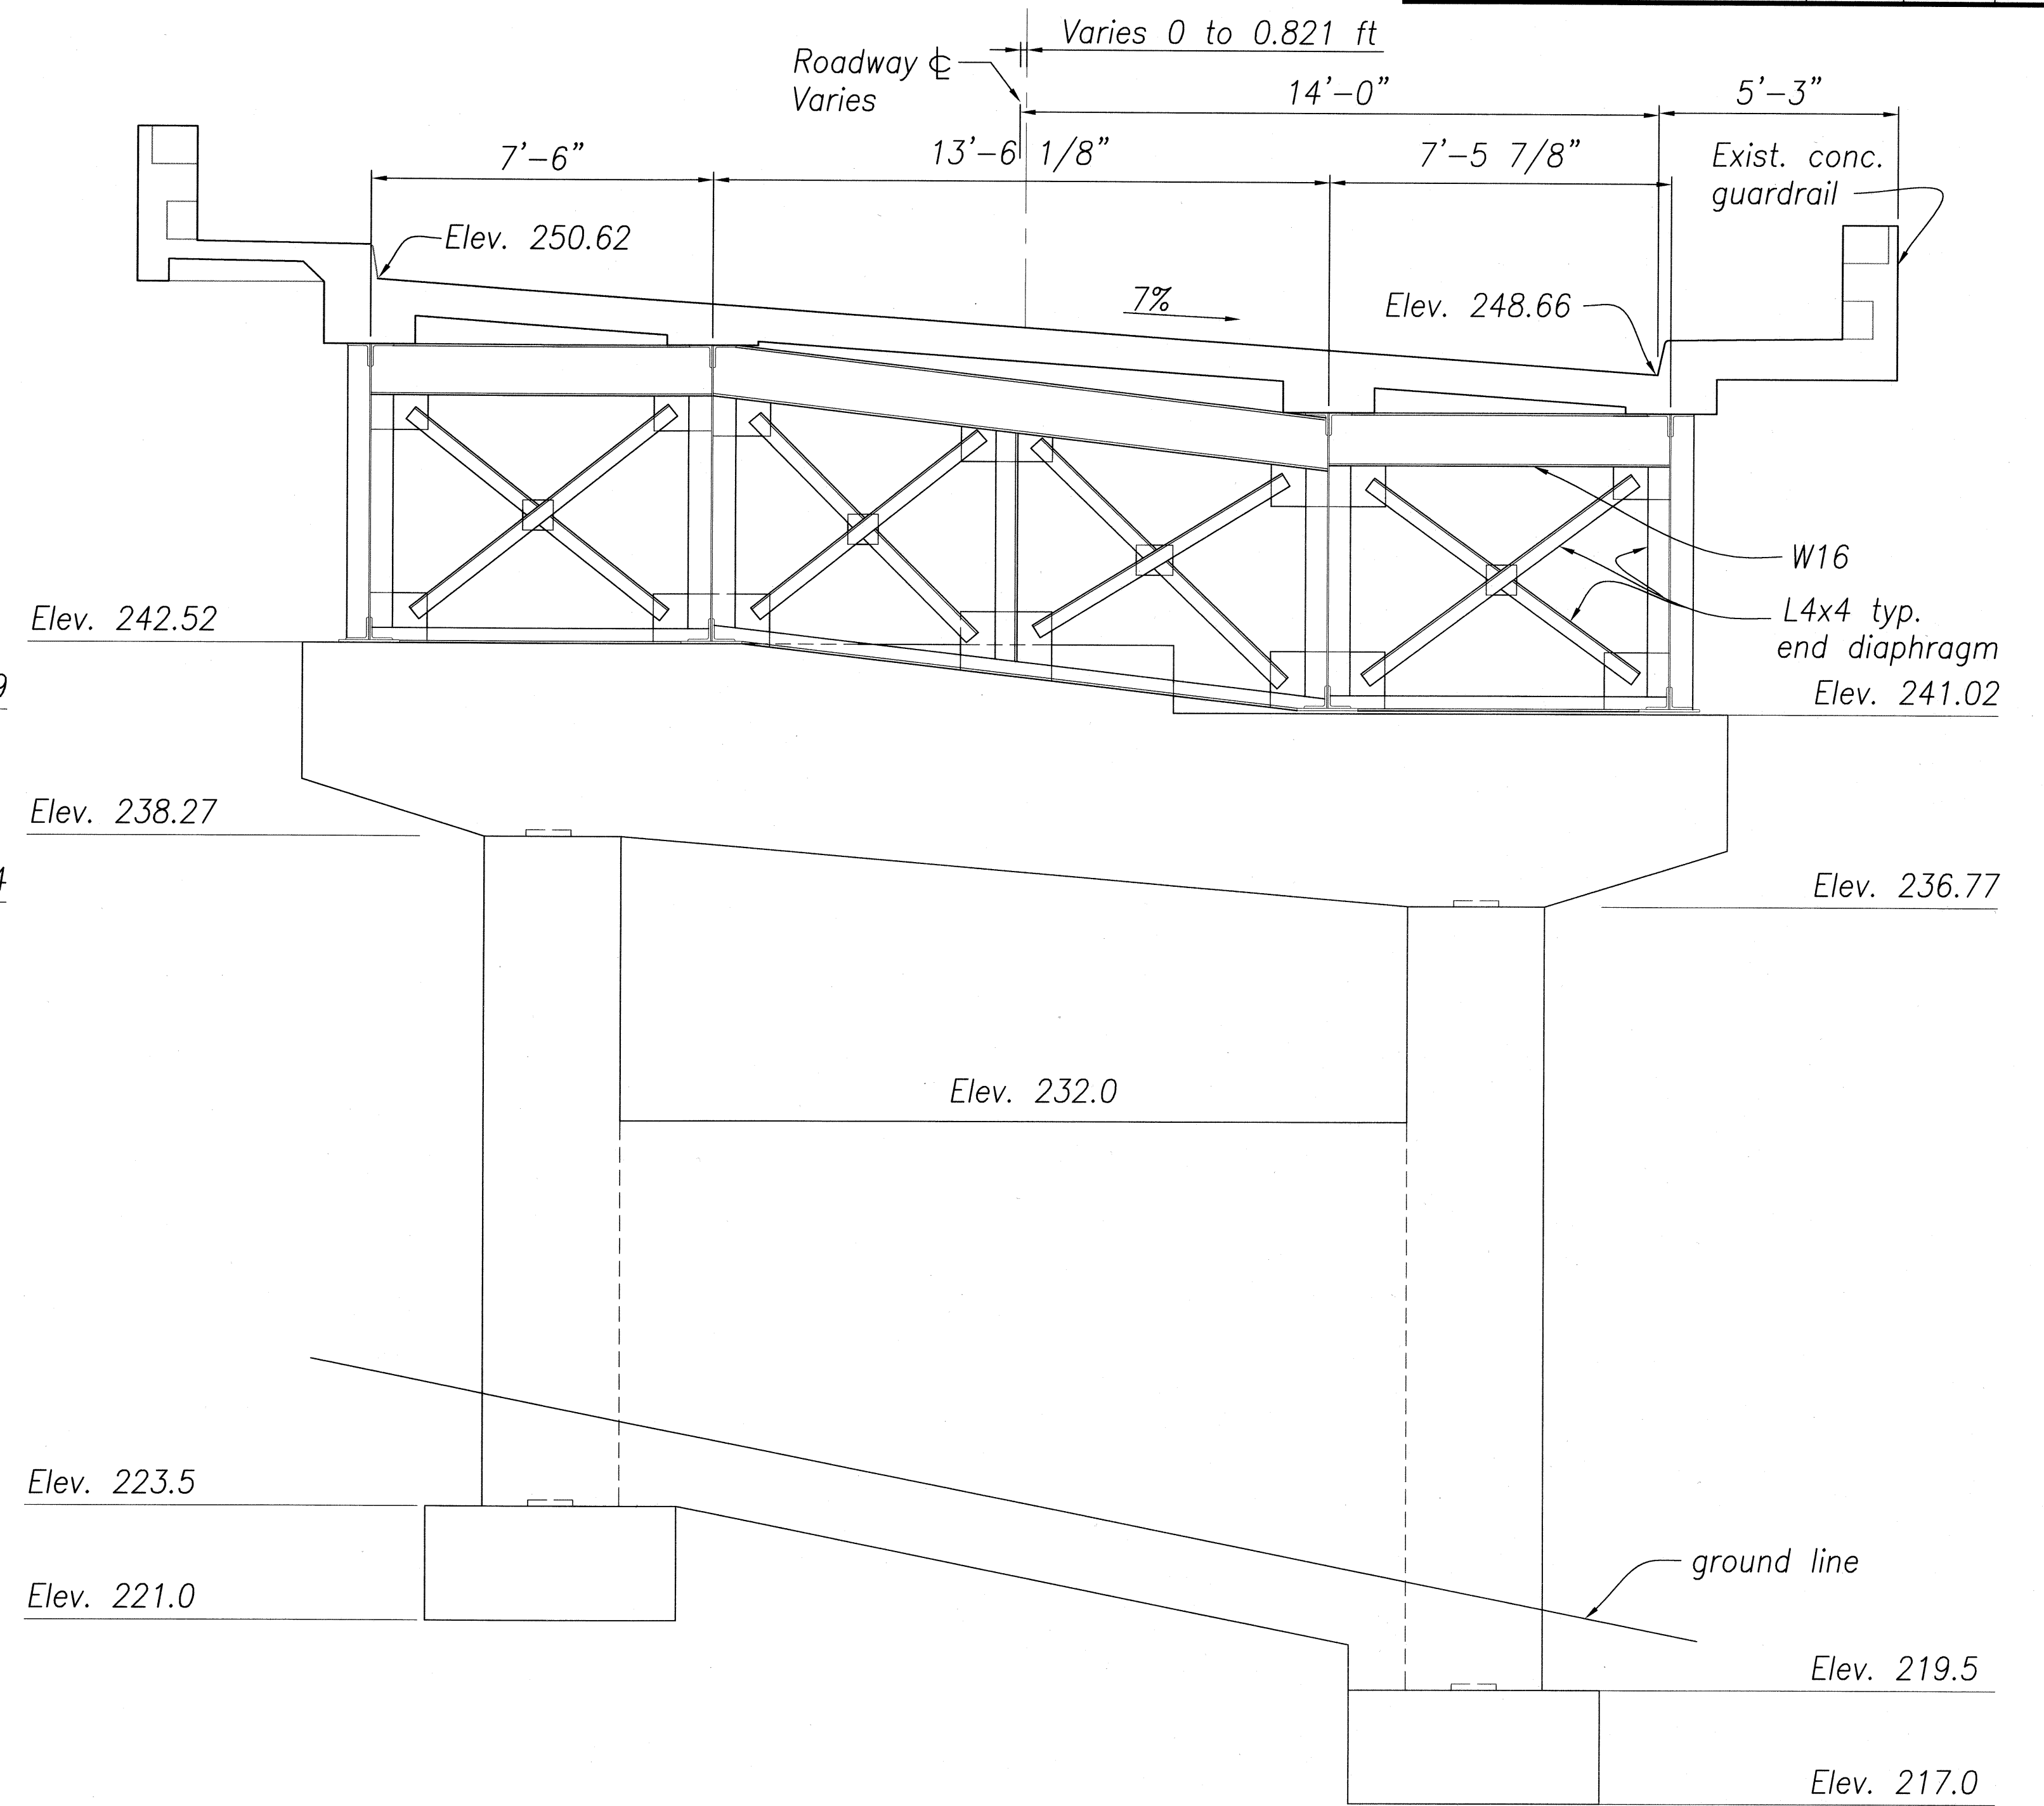

ELEVATION OF BENT No. 2 B
5 | 6
Scale: 3/8" = 1'-0"

SURVEY PLOTTED BY	DATE
DRAWN BY	
DESIGNED BY	
CHECKED BY	
ORIGINAL PLAN	
NOTE BOOK	
No.	

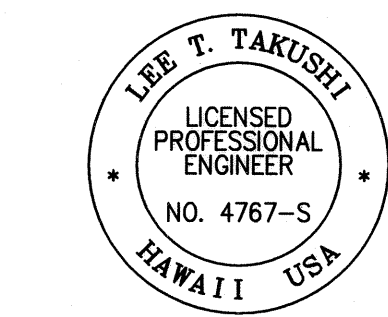


THIS WORK WAS PREPARED BY ME OR UNDER MY SUPERVISION

Lee T. Takushi 4/30/10
SIGNATURE EXP. DATE OF THE LICENSE

STATE OF HAWAII
DEPARTMENT OF TRANSPORTATION
HIGHWAYS DIVISION
NINOLE BRIDGE
SECTION ELEVATION
HAWAII BELT ROAD
CLEAN AND PAINT STEEL MEMBERS
NINOLE, MAULUA, KUWAIKAI AND KUKAIAU
PROJECT NO. BR-019-2(59)
Date: February 2009



Scale: As Noted
Sheet No. 6 Of 22 Sheets

FED. ROAD DIST. NO.	STATE	FED. AID PROJ. NO.	FISCAL YEAR	SHEET NO.	TOTAL SHEETS
HAWAII	HAW.	BR-019-2(59)	2009	7	22

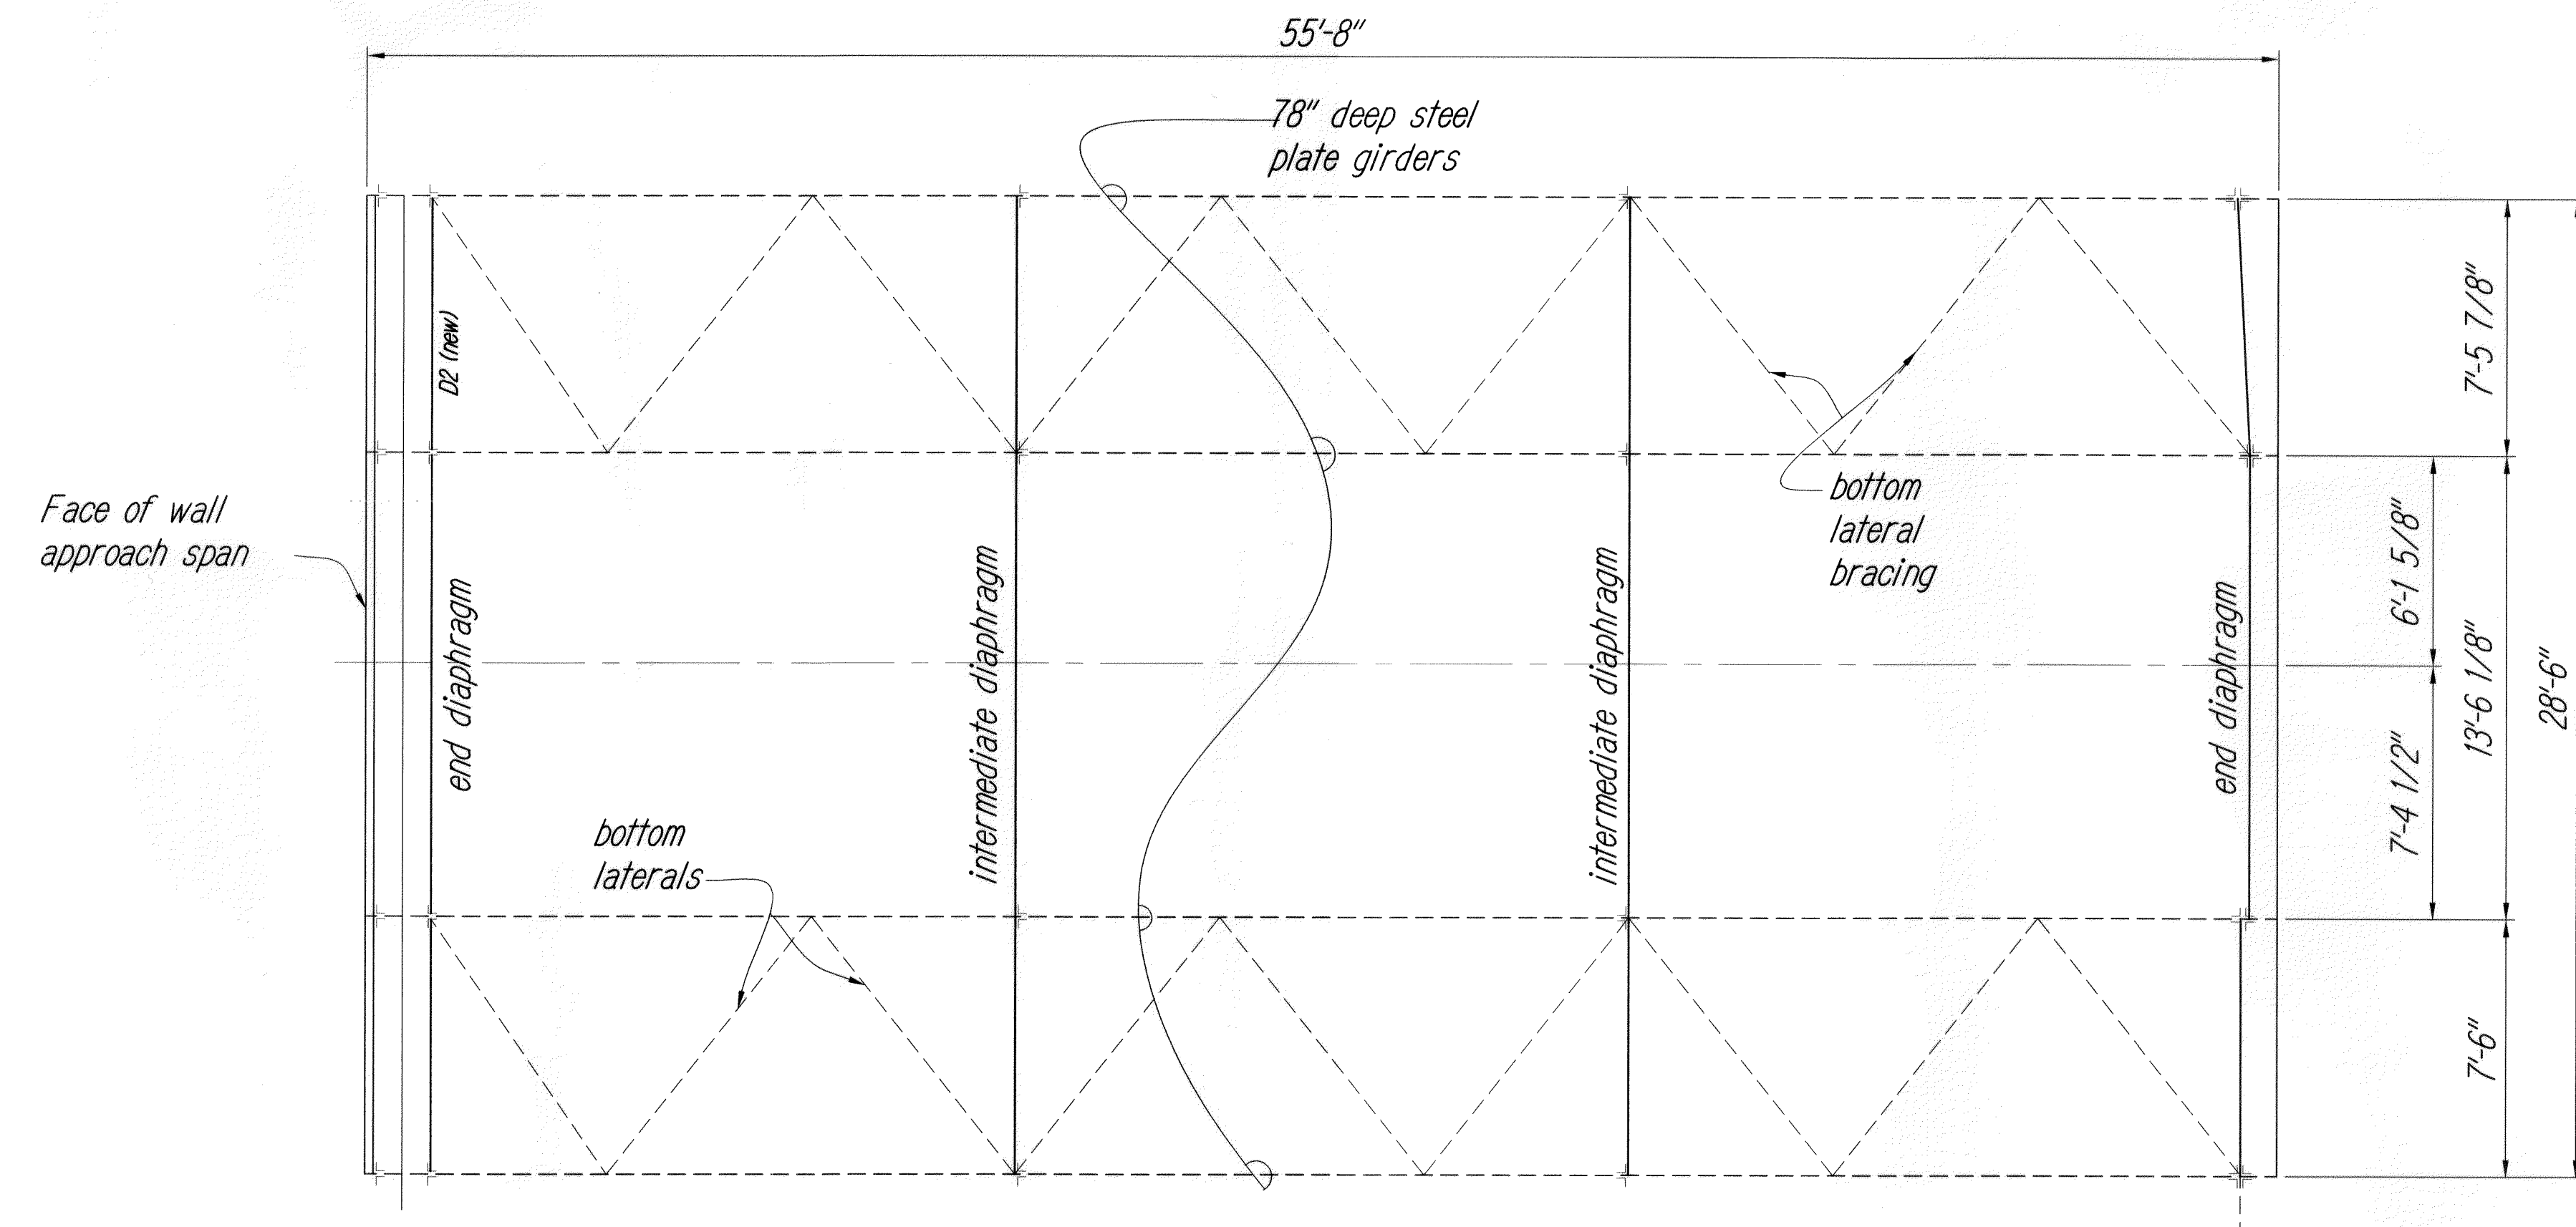


FRAMING PLAN - NINOLE BRIDGE

Scale: $1/4" = 1'-0"$

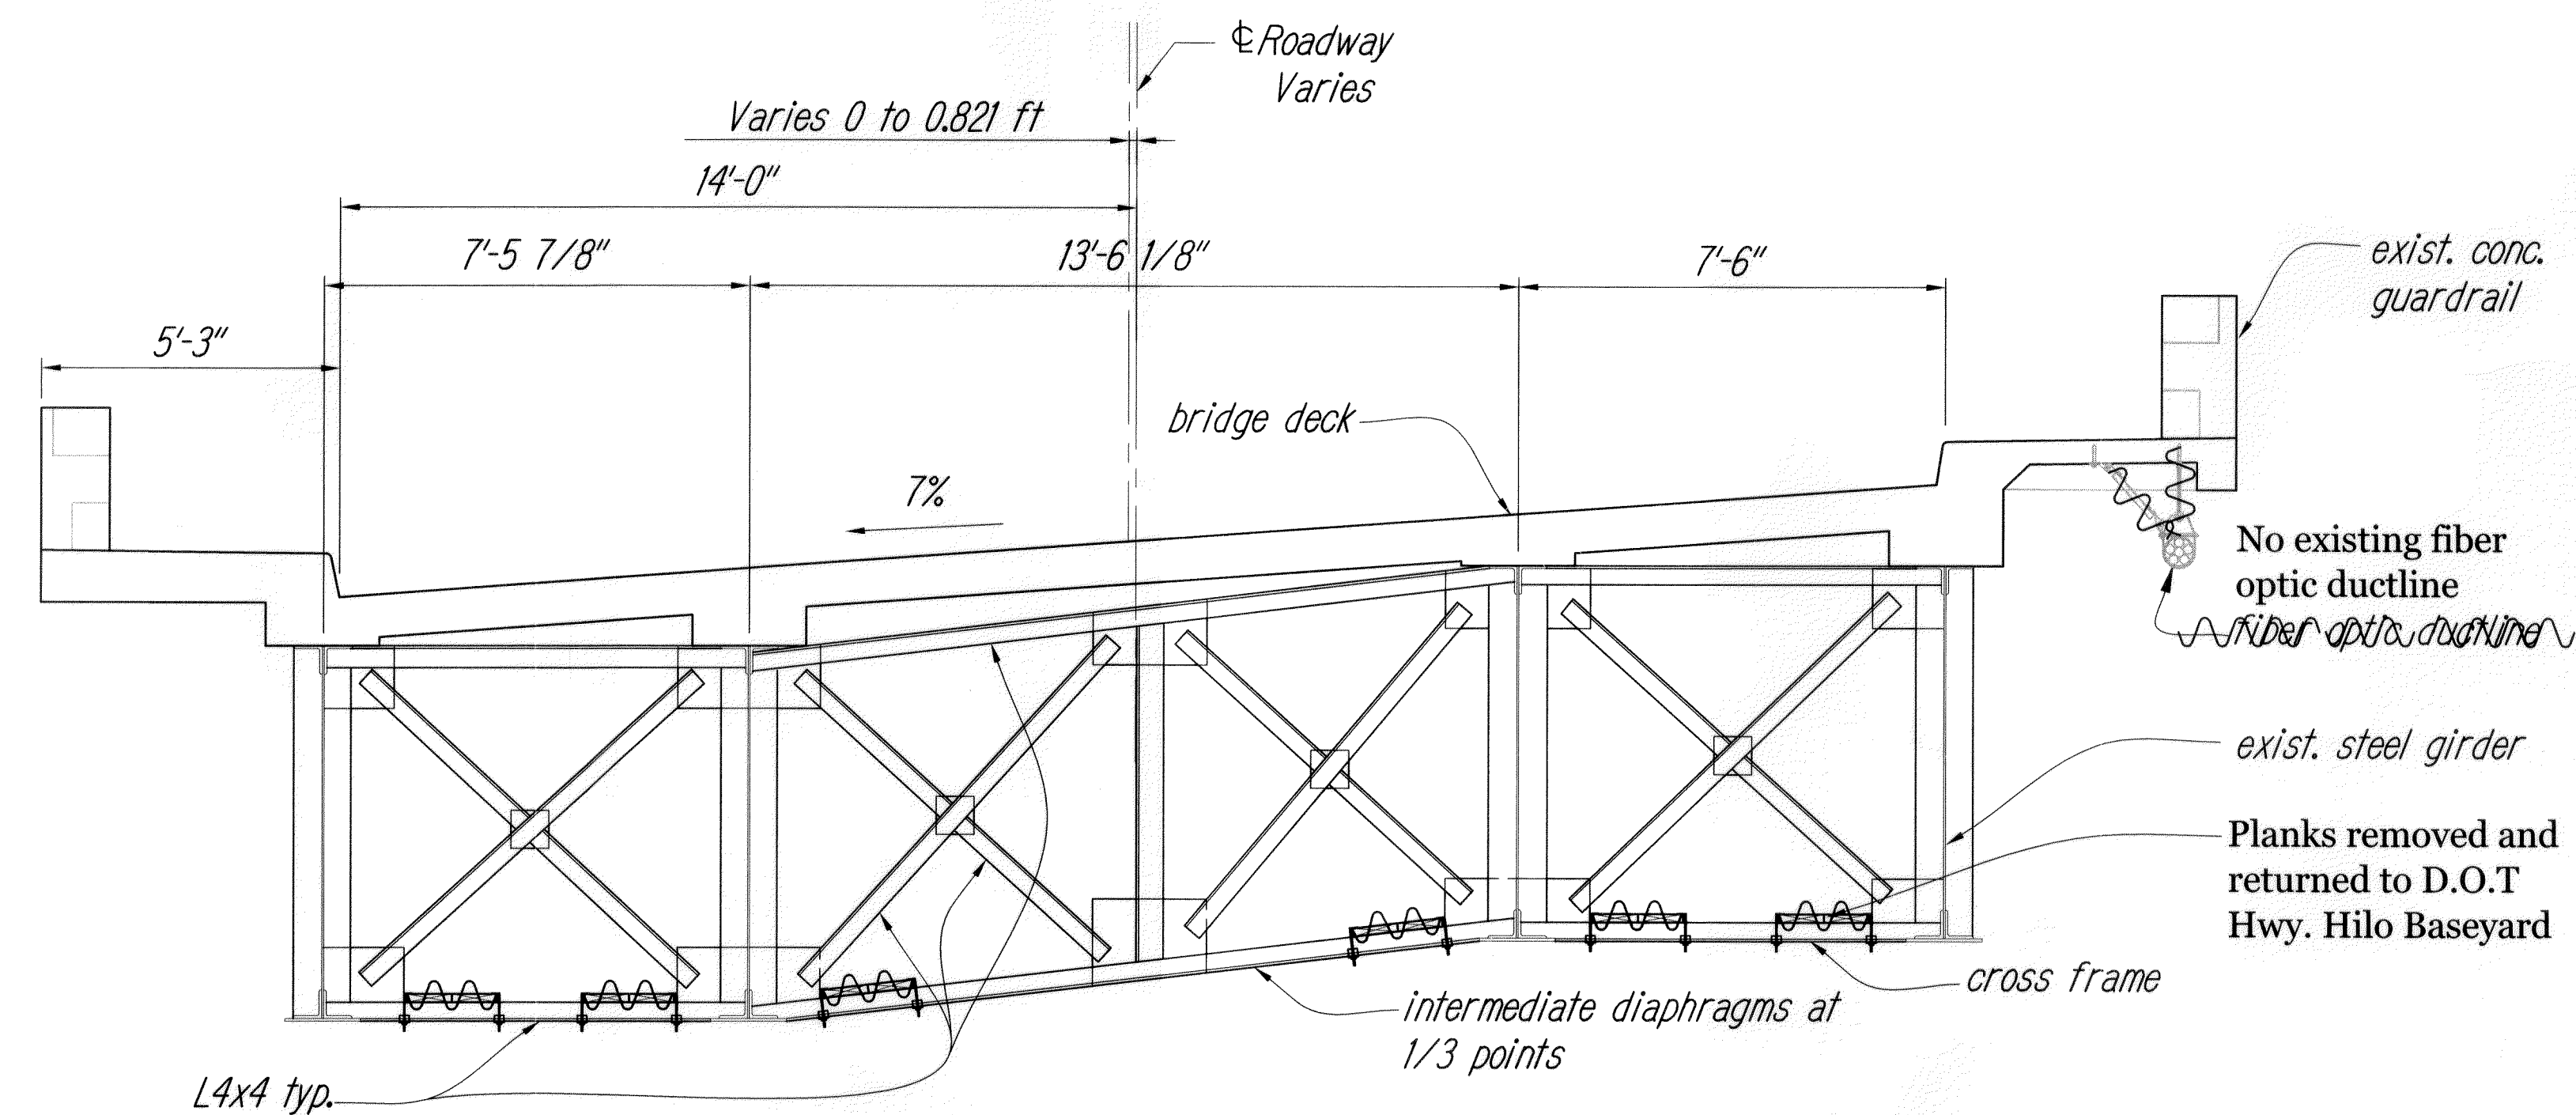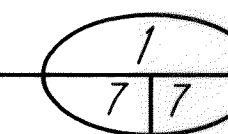

DECK SECTION - NINOLE BRIDGE

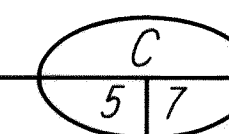

Scale: $3/8'' = 1'-0''$



THIS WORK WAS PREPARED BY ME OR
UNDER MY SUPERVISION

SIGNATURE Lee J. Tall EXP. DATE OF THE LICENSE 4/30/10

LEGEND FOR AS-BUILT POSTINGS

	Squiggly line for as-built deletion
	Double line for as-built deletion
Roadway	Text for as-built posting

STATE OF HAWAII
DEPARTMENT OF TRANSPORTATION
HIGHWAYS DIVISION
NINOLE BRIDGE
PLAN AND SECTION
HAWAII BELT ROAD
CLEAN AND PAINT STEEL MEMBERS
NINOLE, MAULUA, KUWAIKAHI AND KUKIAIU
PROJECT NO. BR-019-2(59)

Scale: As Noted Date: February 2009

Sheet No. 7 Of 22 Sheets