

FED. ROAD DIST. NO.	STATE	PROJ. NO.	FISCAL YEAR	SHEET NO.	TOTAL SHEETS
HAWAII	HAW	19FGH-01-07M	2008	23	51



Photo 1



Photo 2




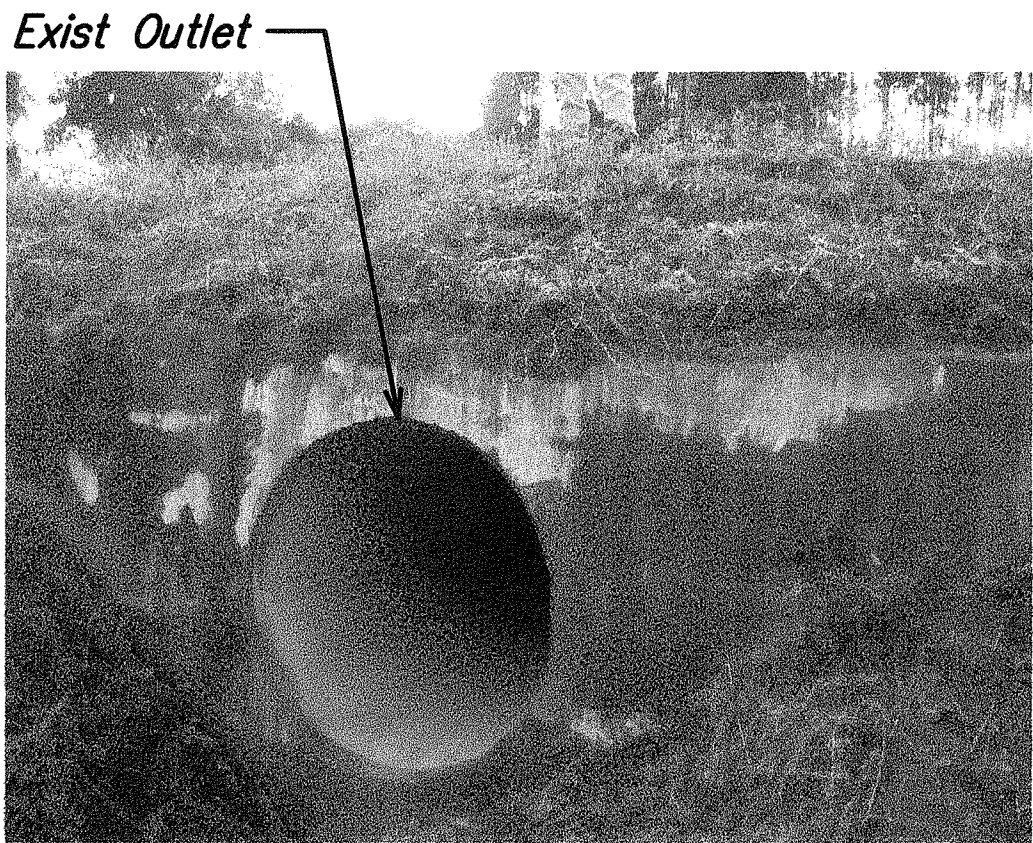


Photo 3



PHOTO NOTE:
Photographs are only for identifying the worksite. The Contractor shall perform his/her own site inspection to verify the existing site conditions that he/she may encounter during construction.

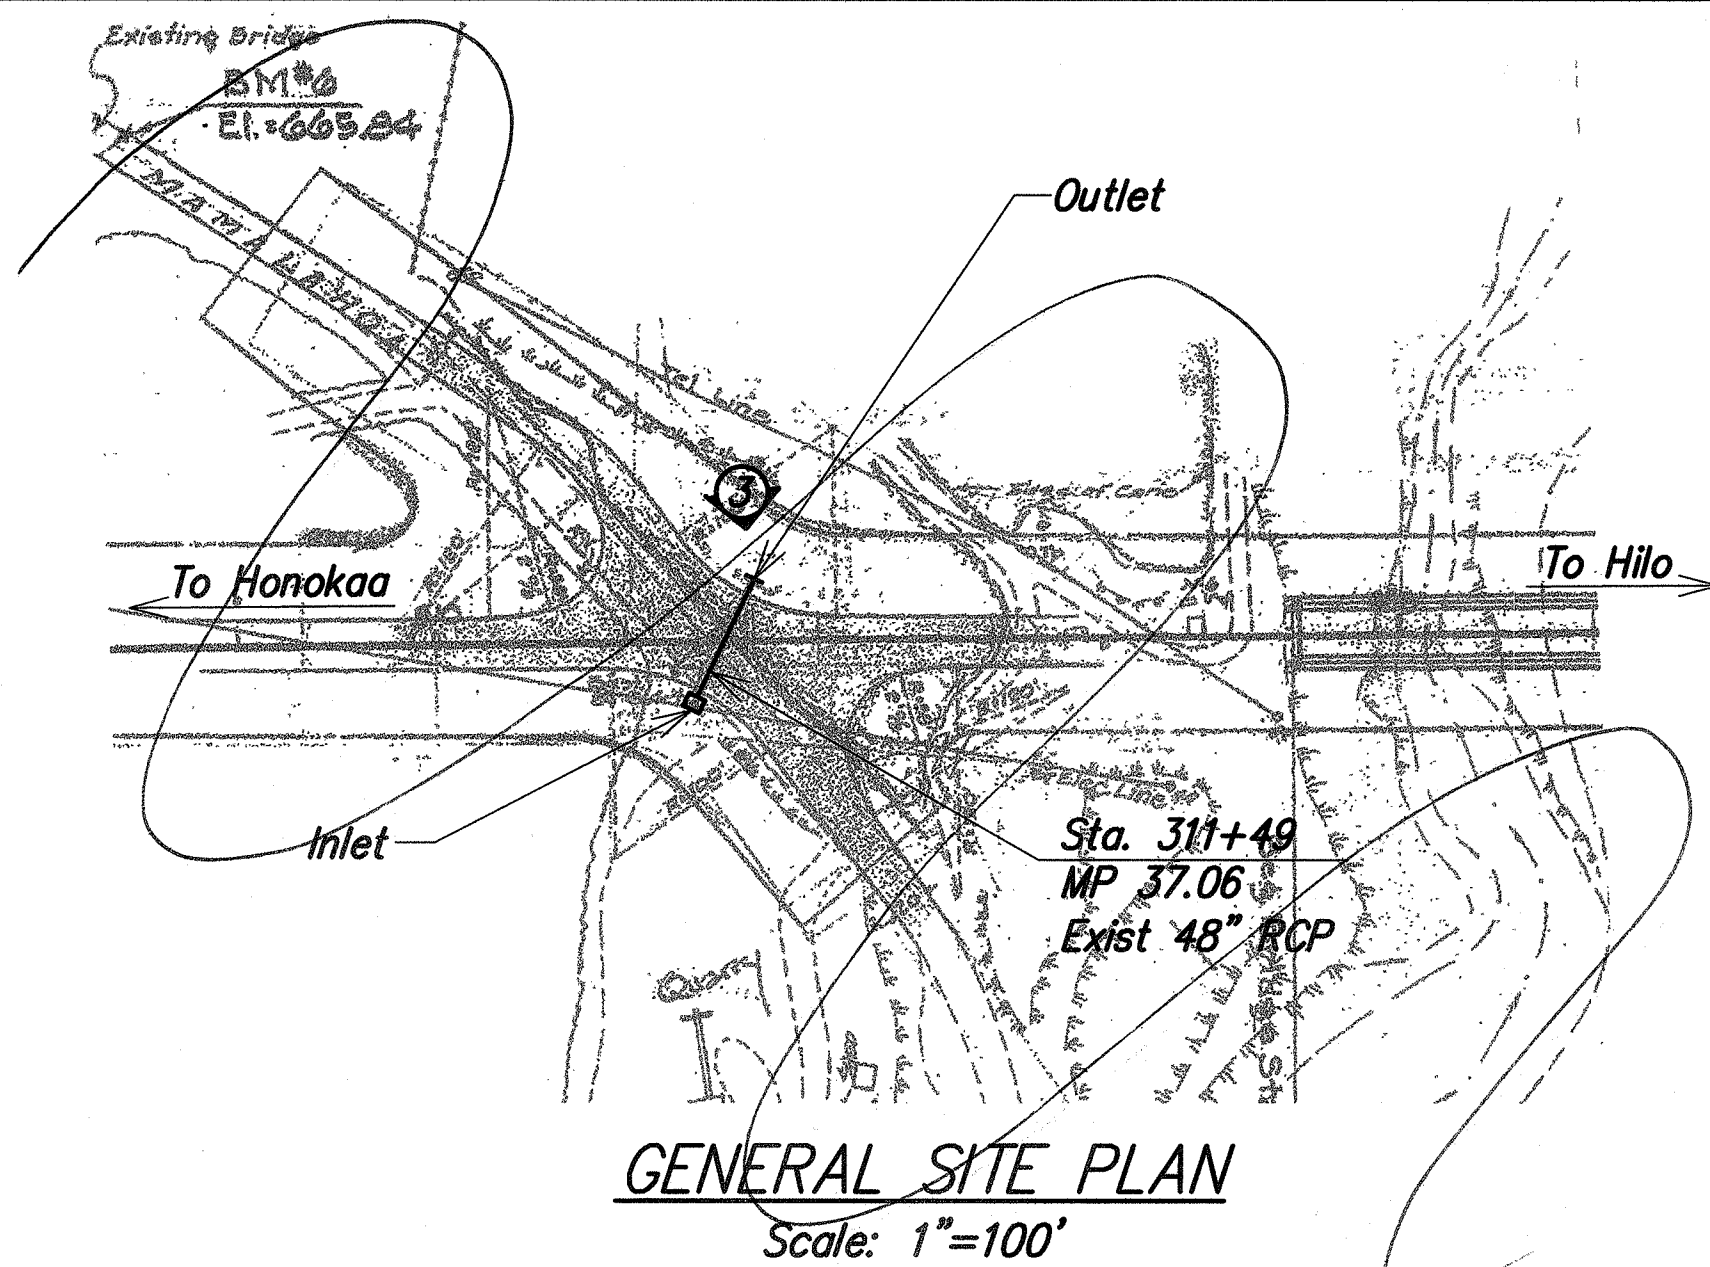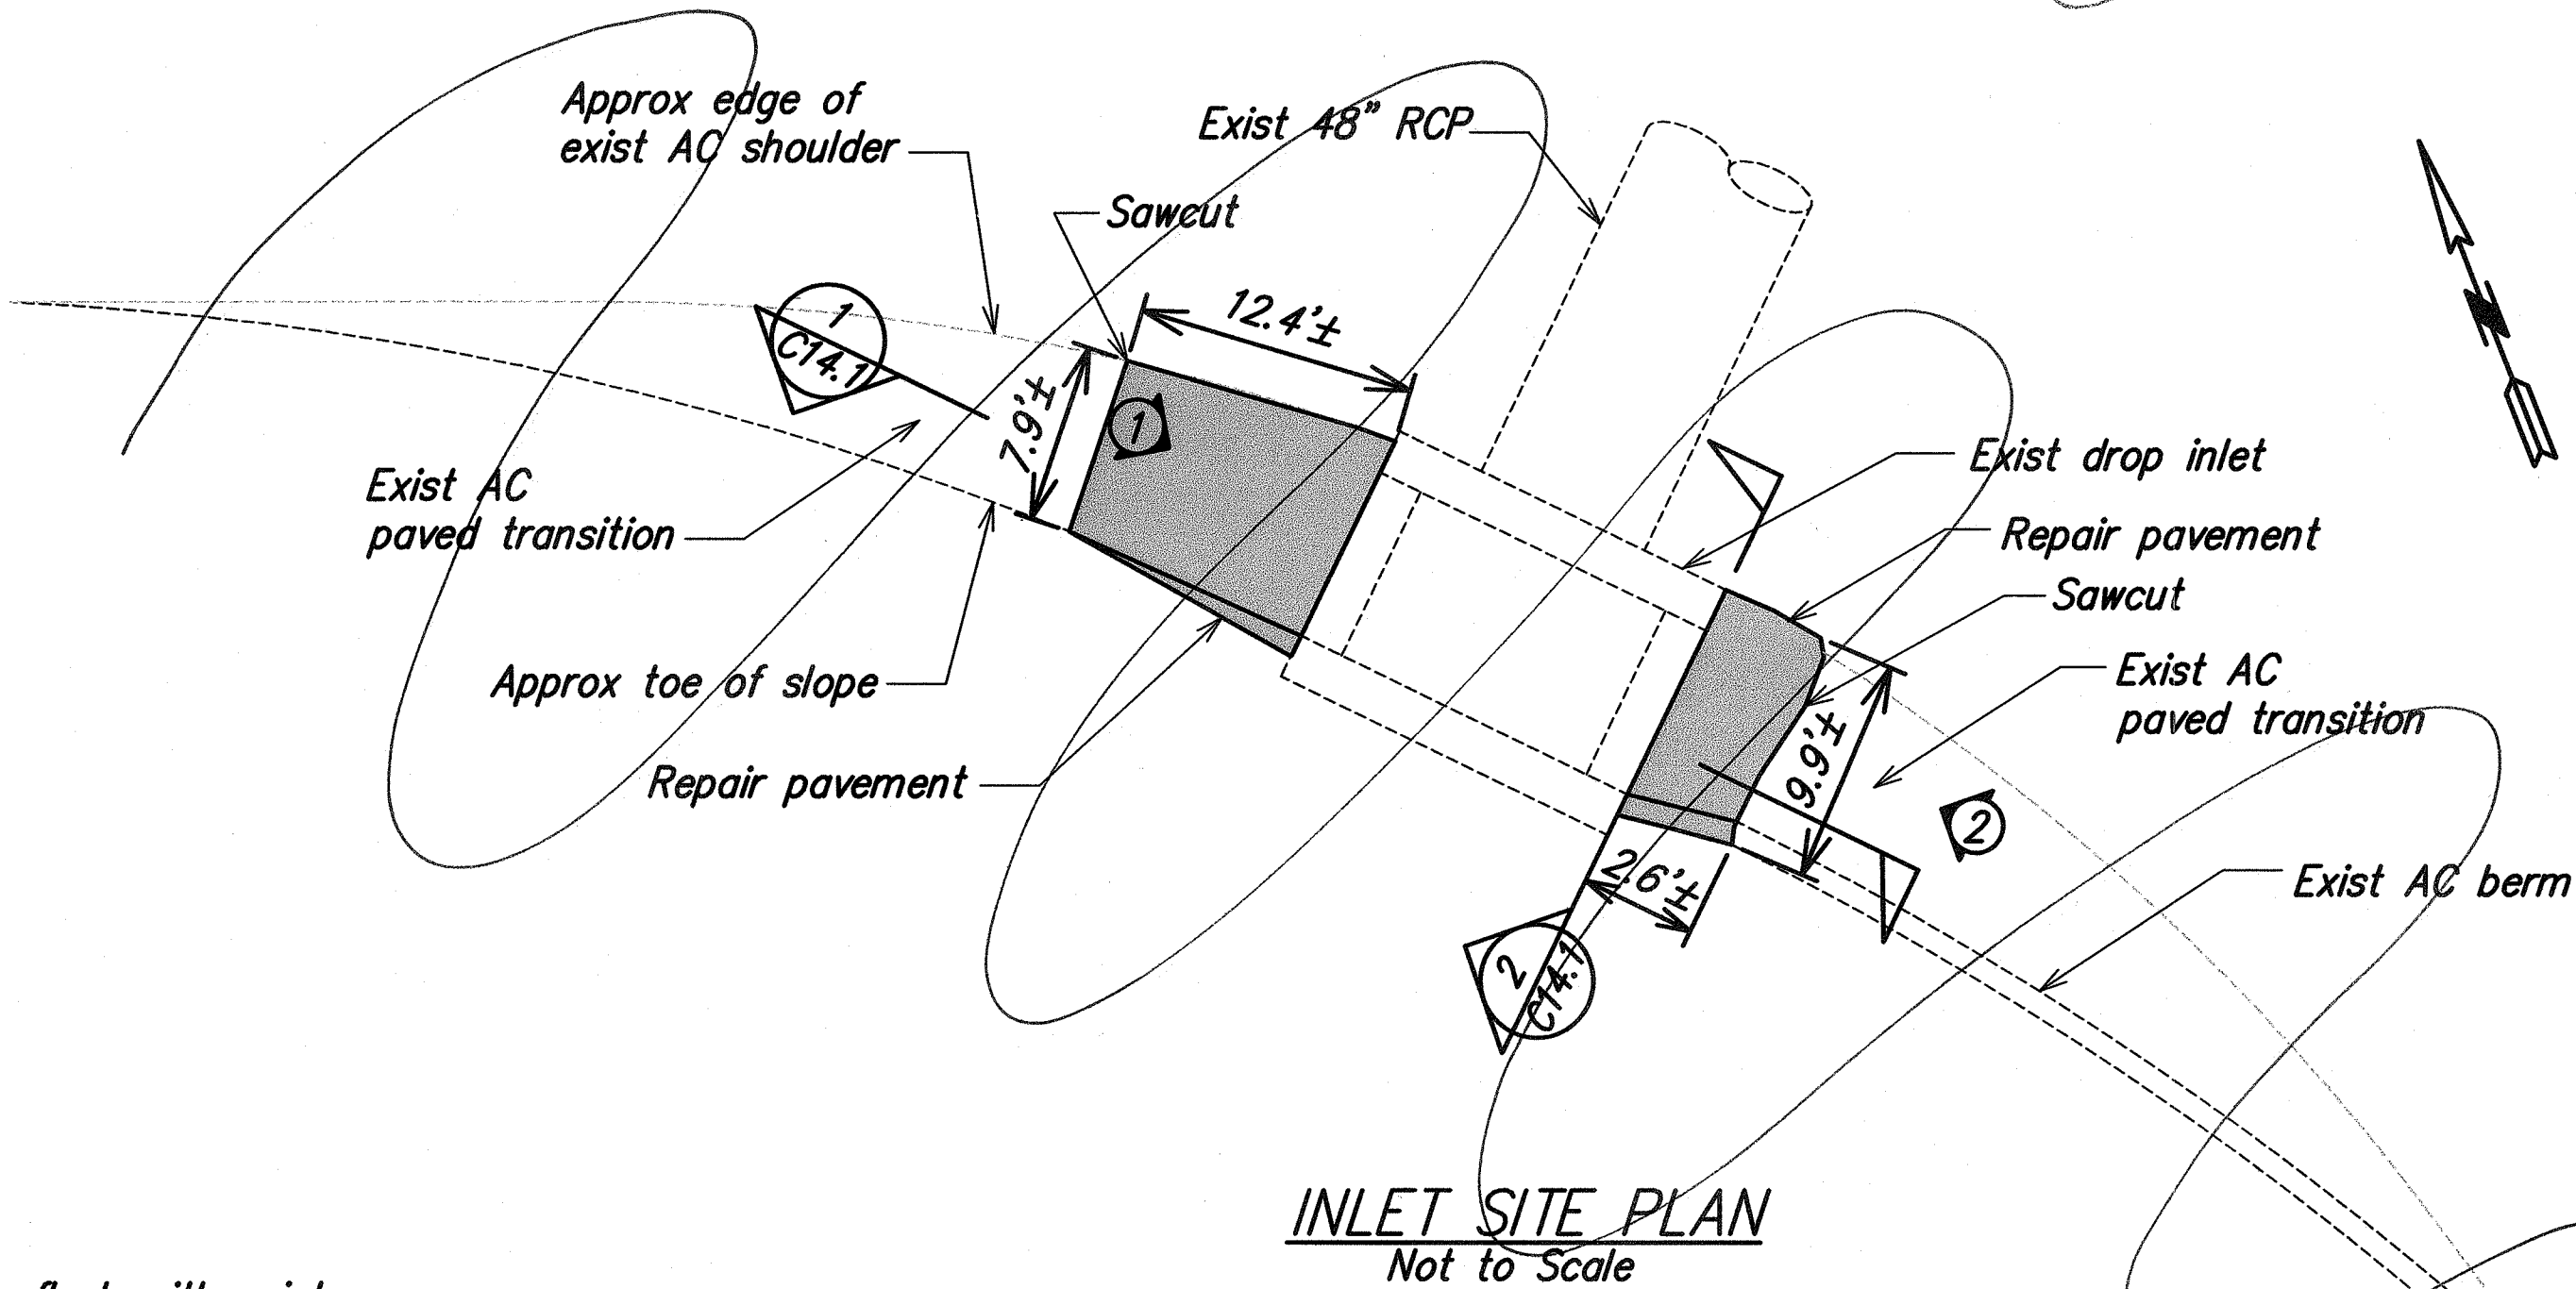

N.I.C.

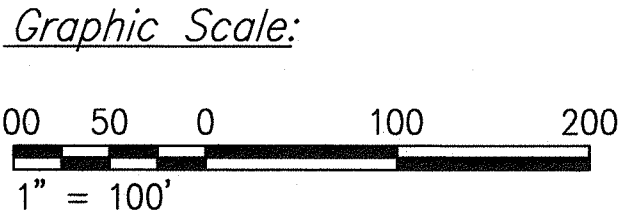

ORIGINAL PLAN	SURVEY PLOTTED BY	DATE
NOTE BOOK	DRAWN BY	
	DESIGNED BY	
	CHECKED BY	

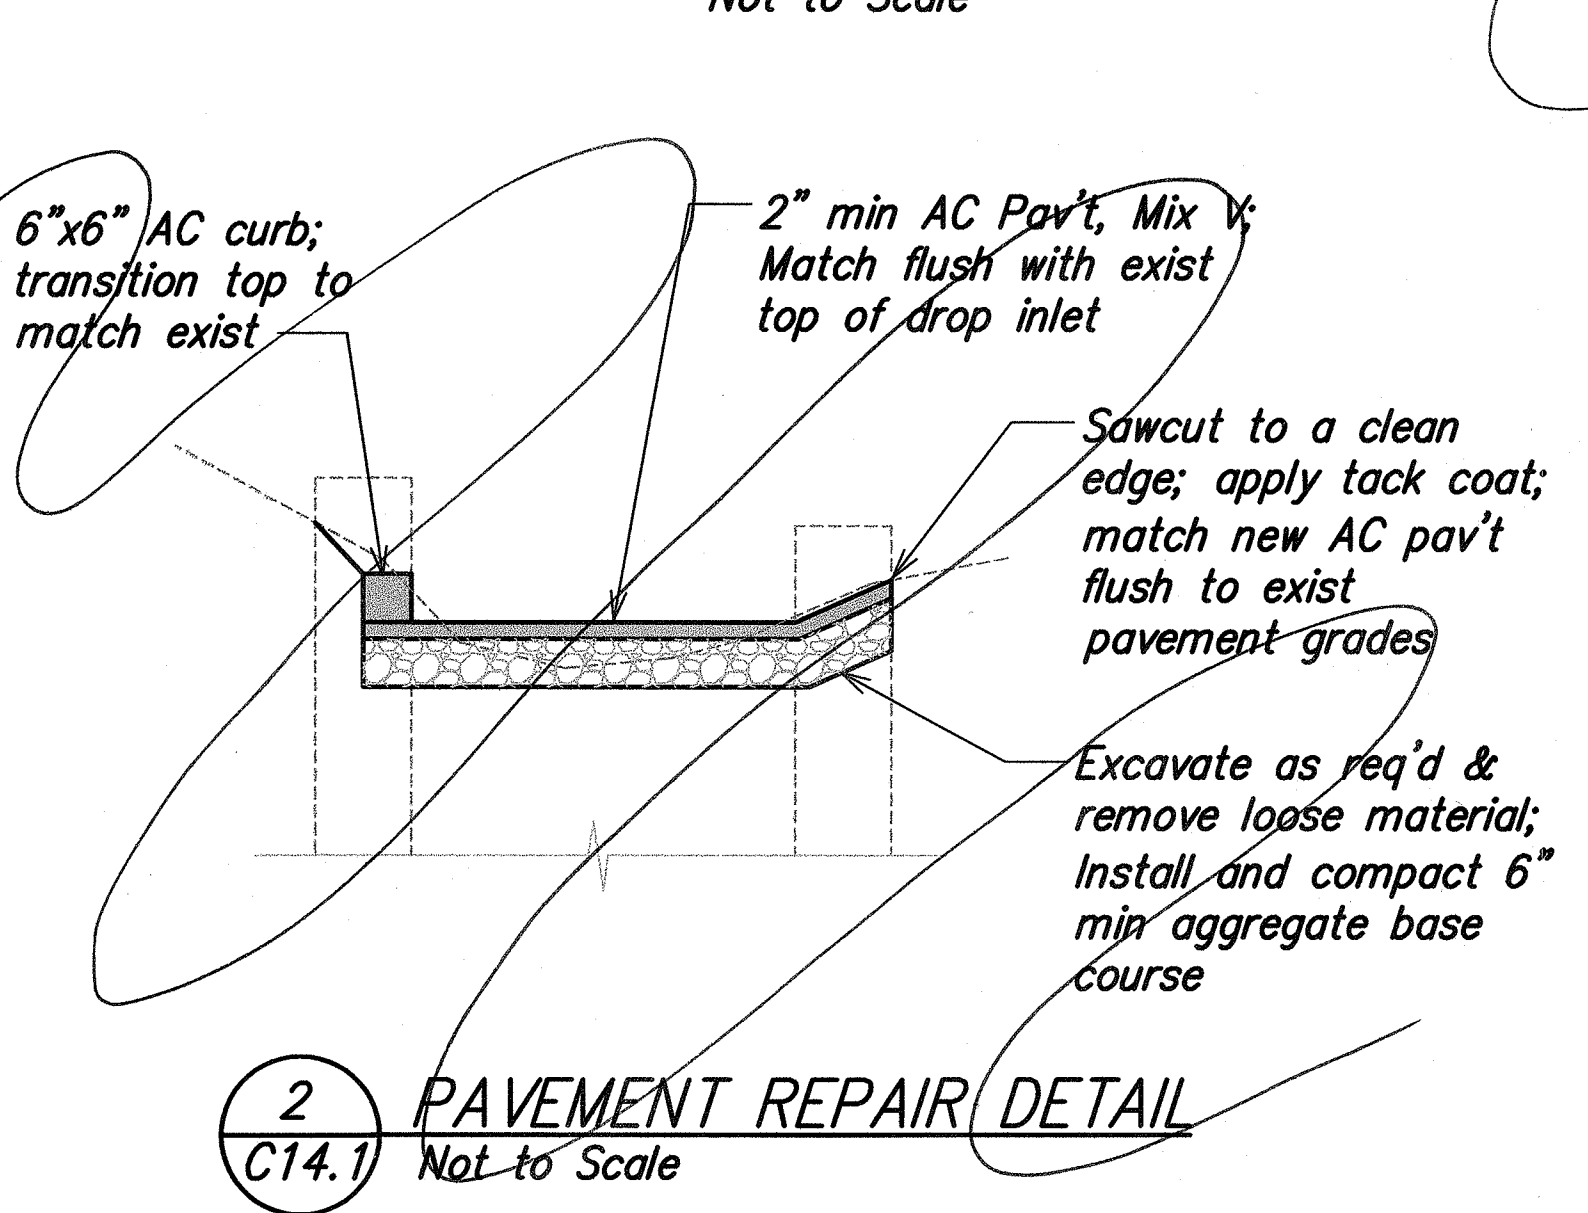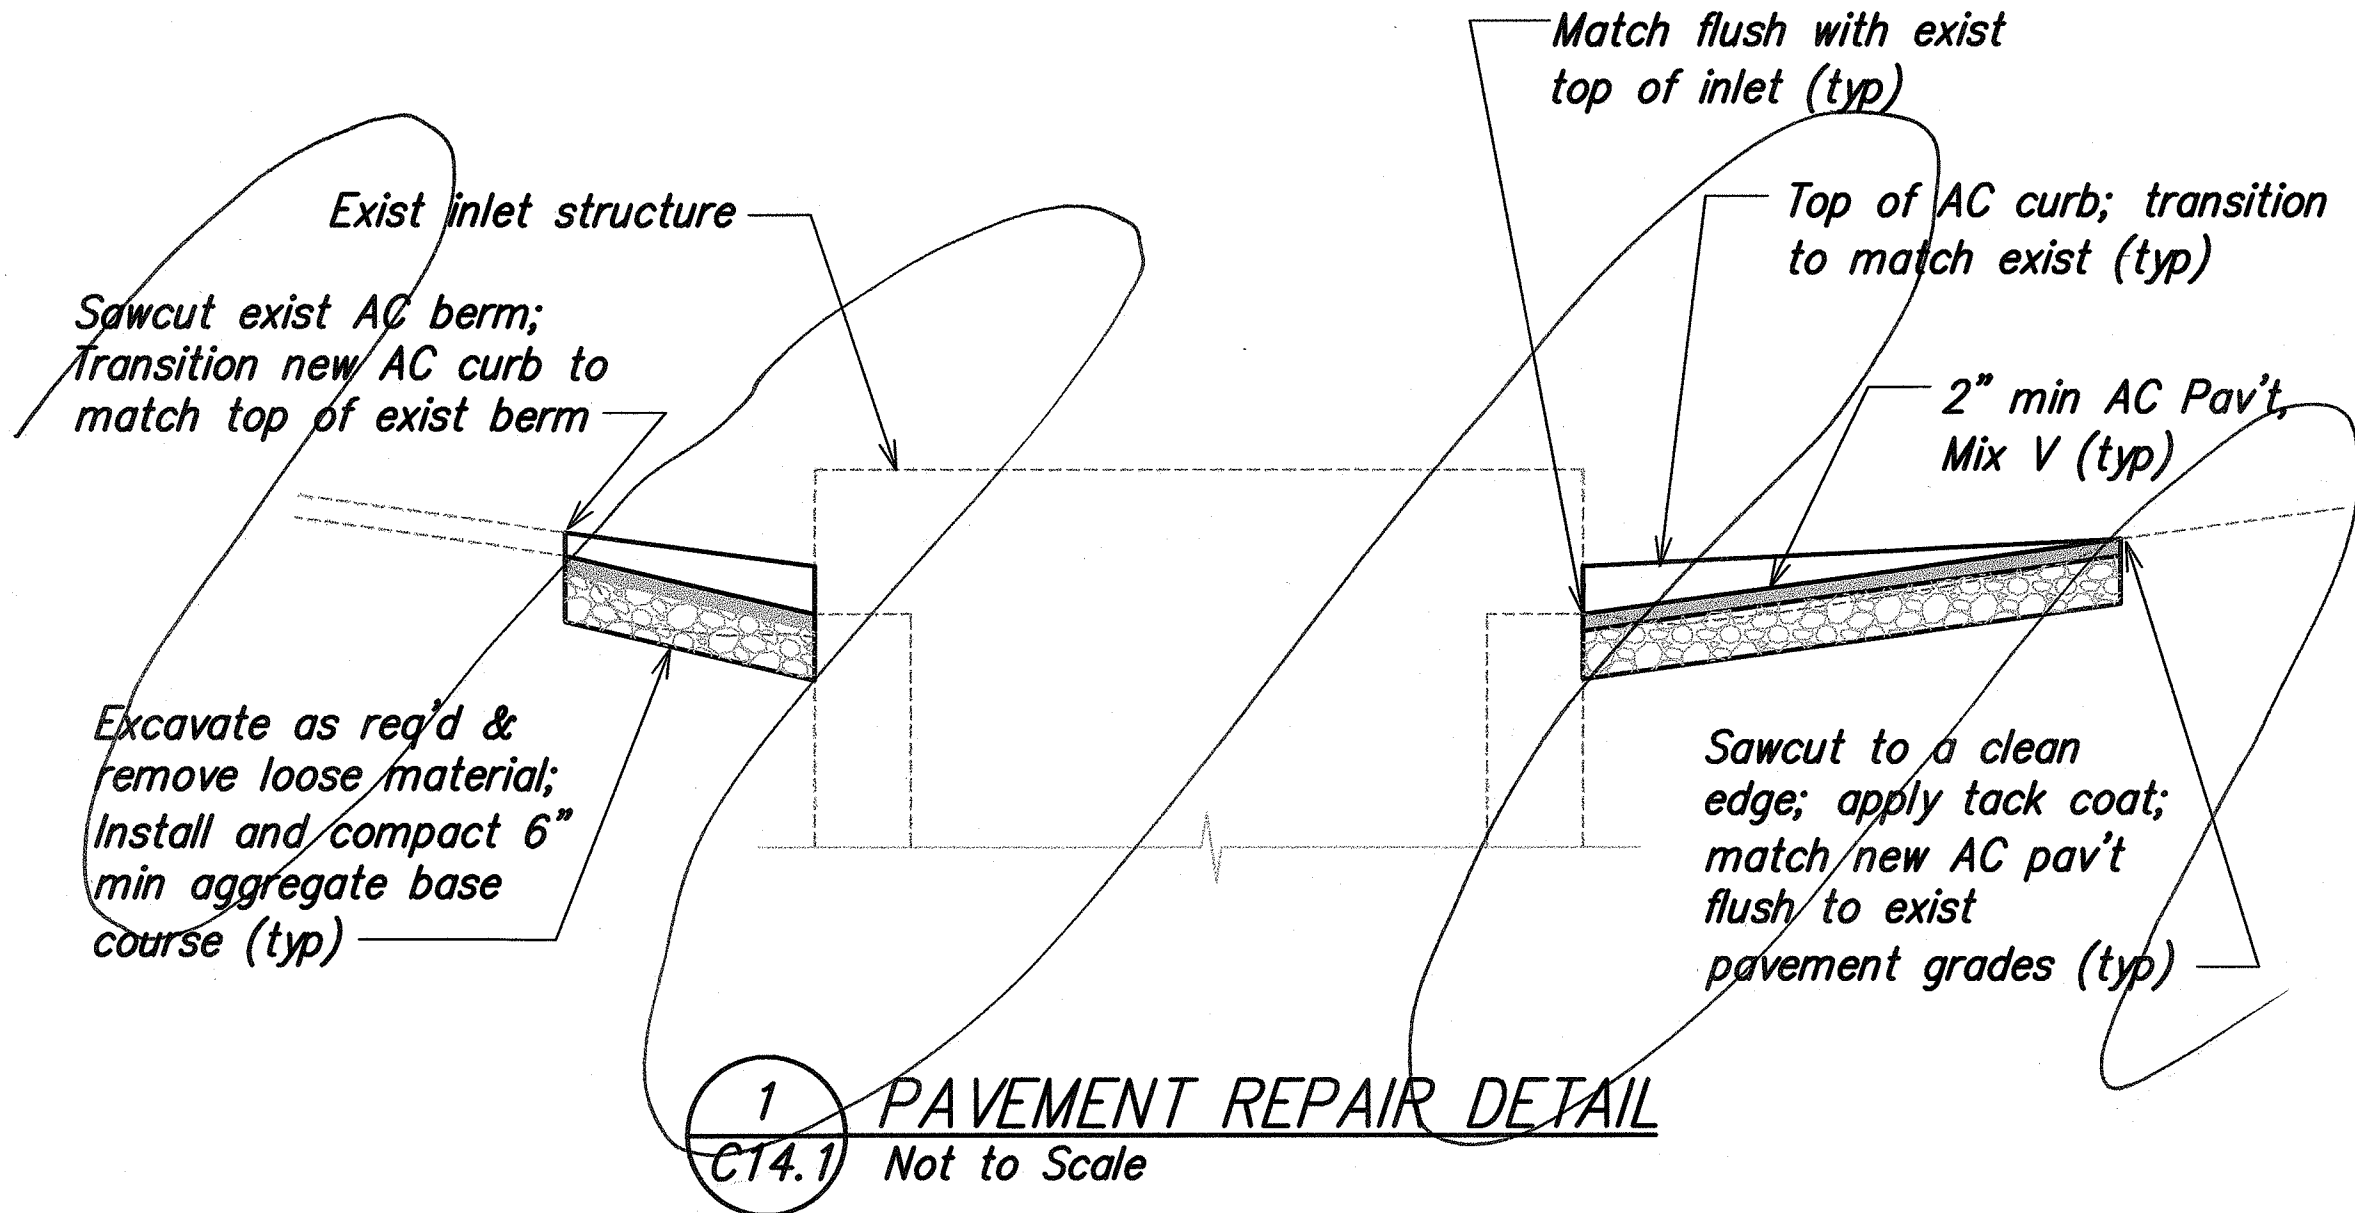

EarthTech

A Tyco International Ltd. Company

STATE OF HAWAII
DEPARTMENT OF TRANSPORTATION
HIGHWAYS DIVISION

**MILE POST 37.06
SITE IMPROVEMENTS**

**HAWAII BELT ROAD DRAINAGE
IMPROVEMENTS**

Project No. 19FGH-01-07M

Scale: As Noted Date: April 2007

SHEET No. C14.1 OF 1 SHEETS