

FED. ROAD DIST. NO.	STATE	PROJ. NO.	FISCAL YEAR	SHEET NO.	TOTAL SHEETS
HAWAII	HAW	19FGH-01-07M	2008	24	51



Photo 1

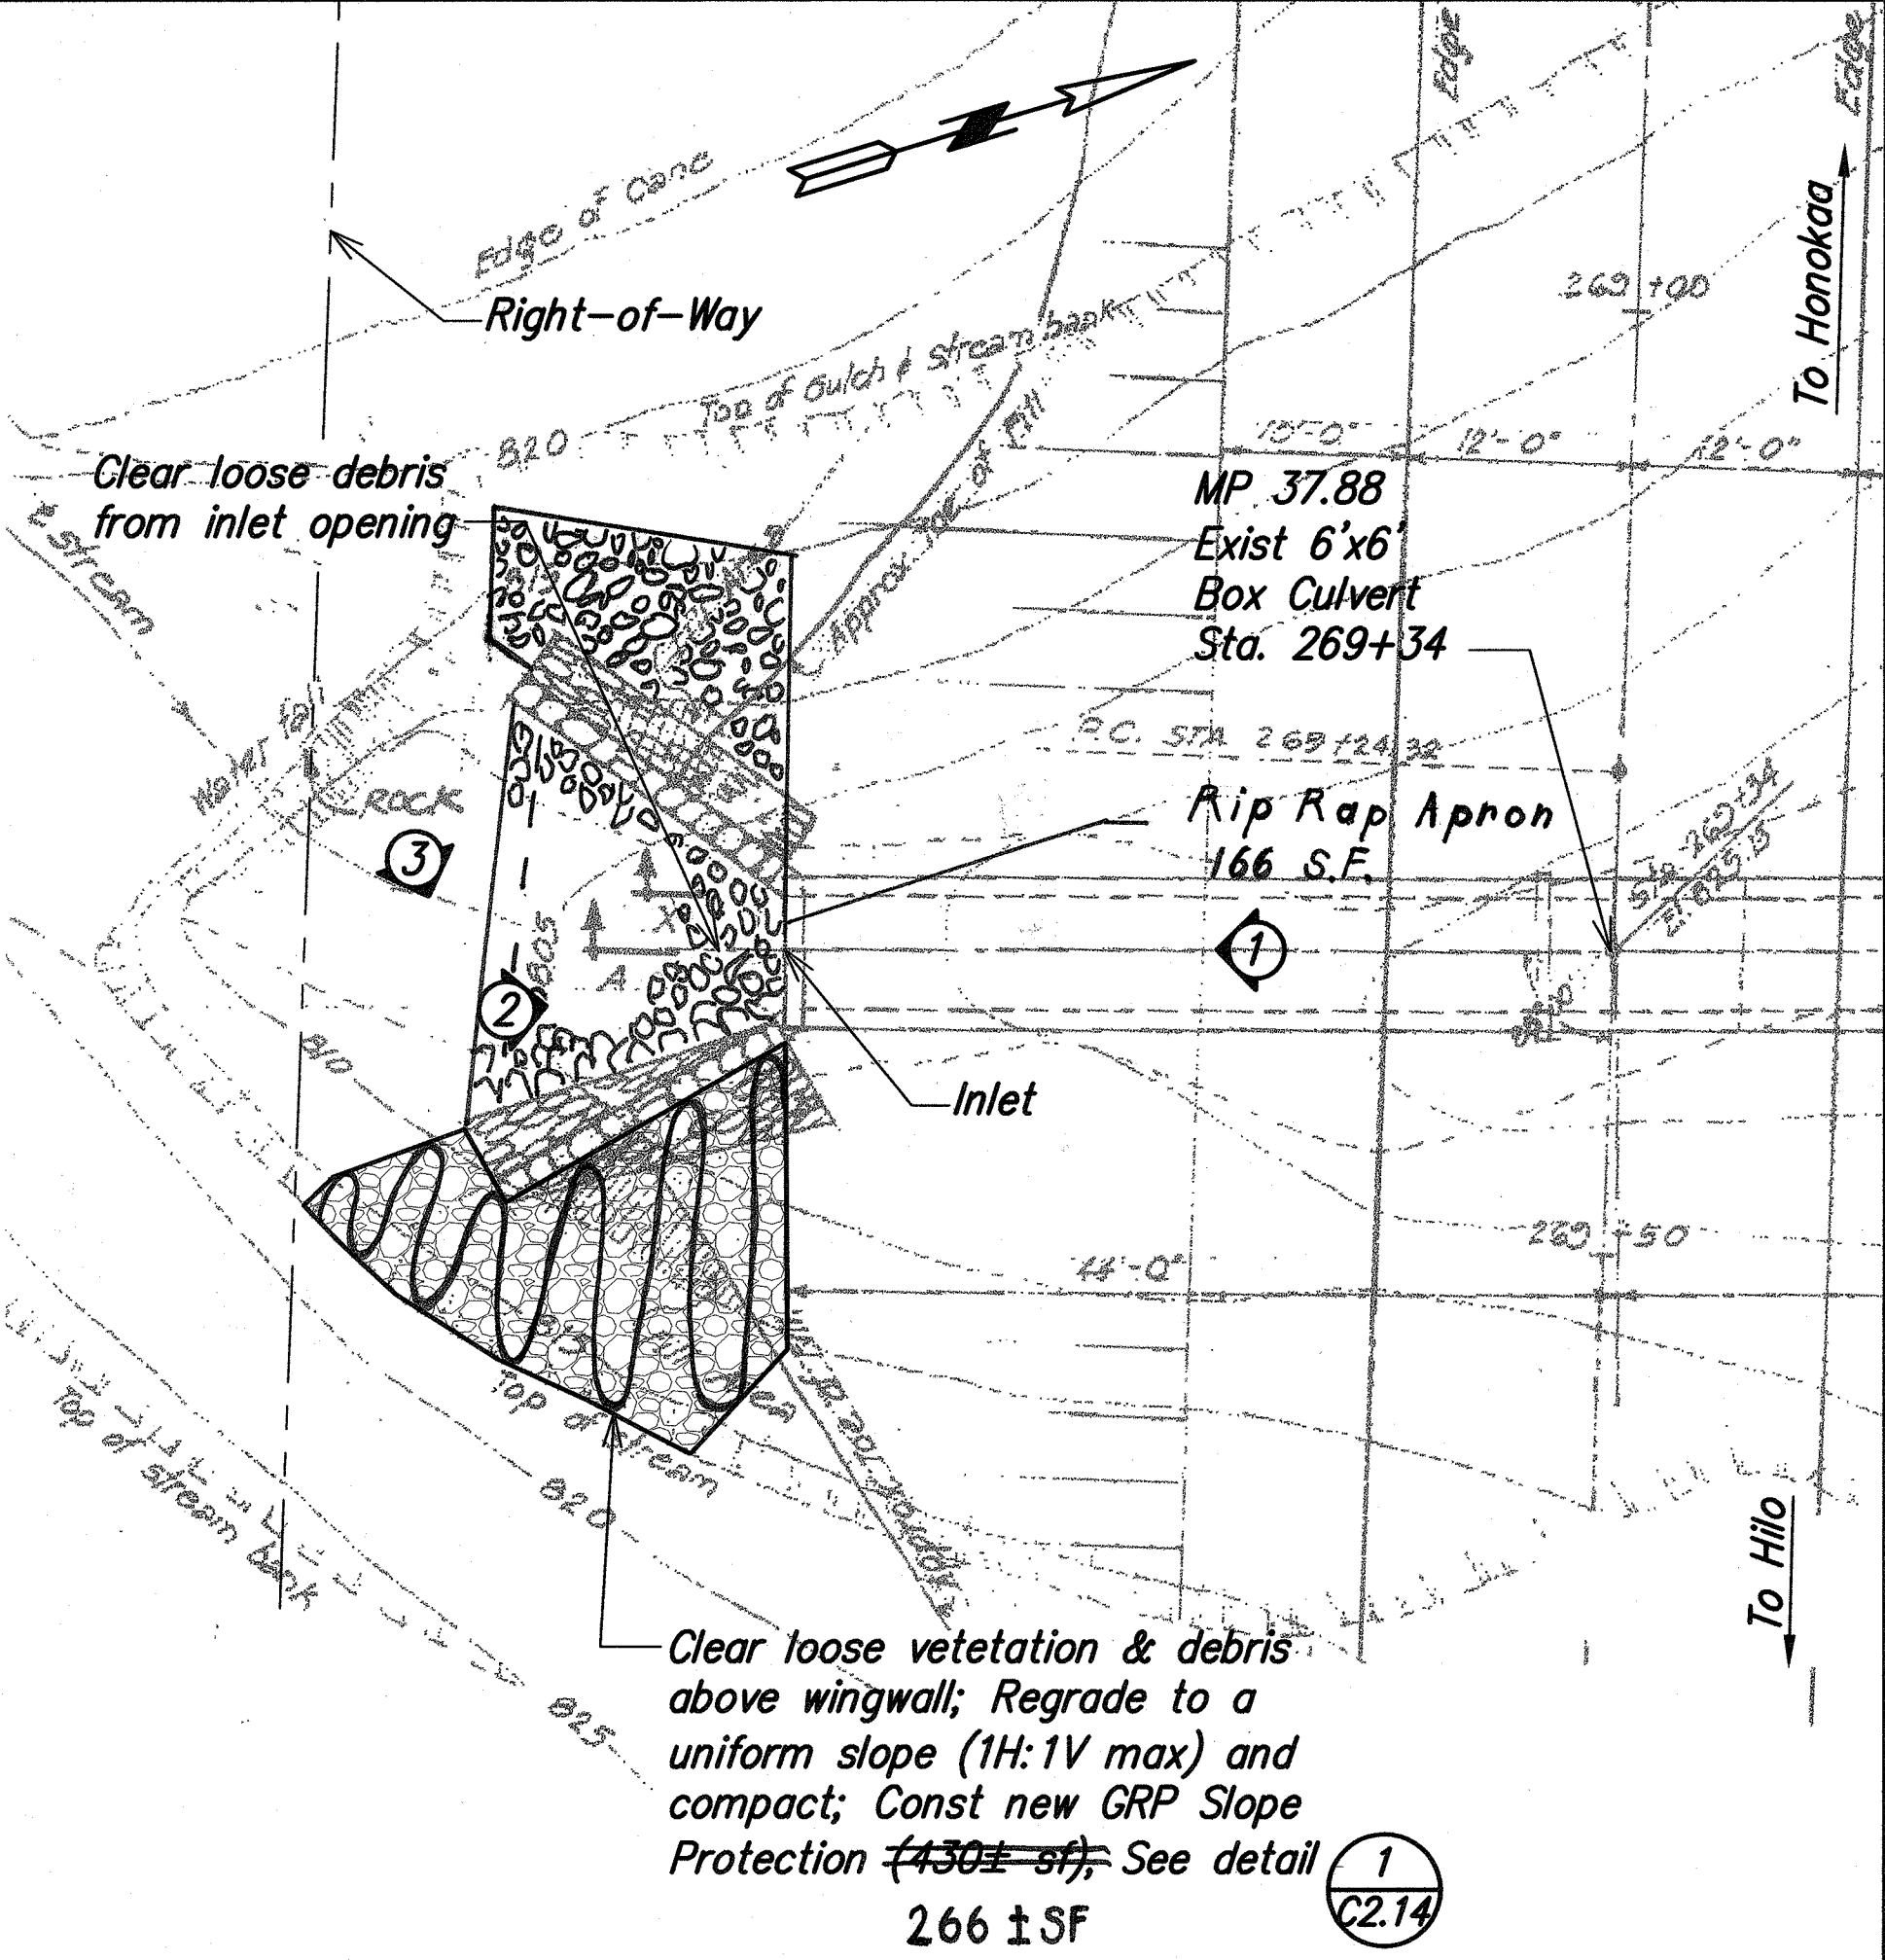


Photo 2




Photo 3

PHOTO NOTE:
Photographs are only for identifying the worksite. The Contractor shall perform his/her own site inspection to verify the existing site conditions that he/she may encounter during construction.



INLET SITE PLAN
Scale: 1"=10'

Note:
See Structural drawings S10.1 thru S10.2 for culvert repairs.

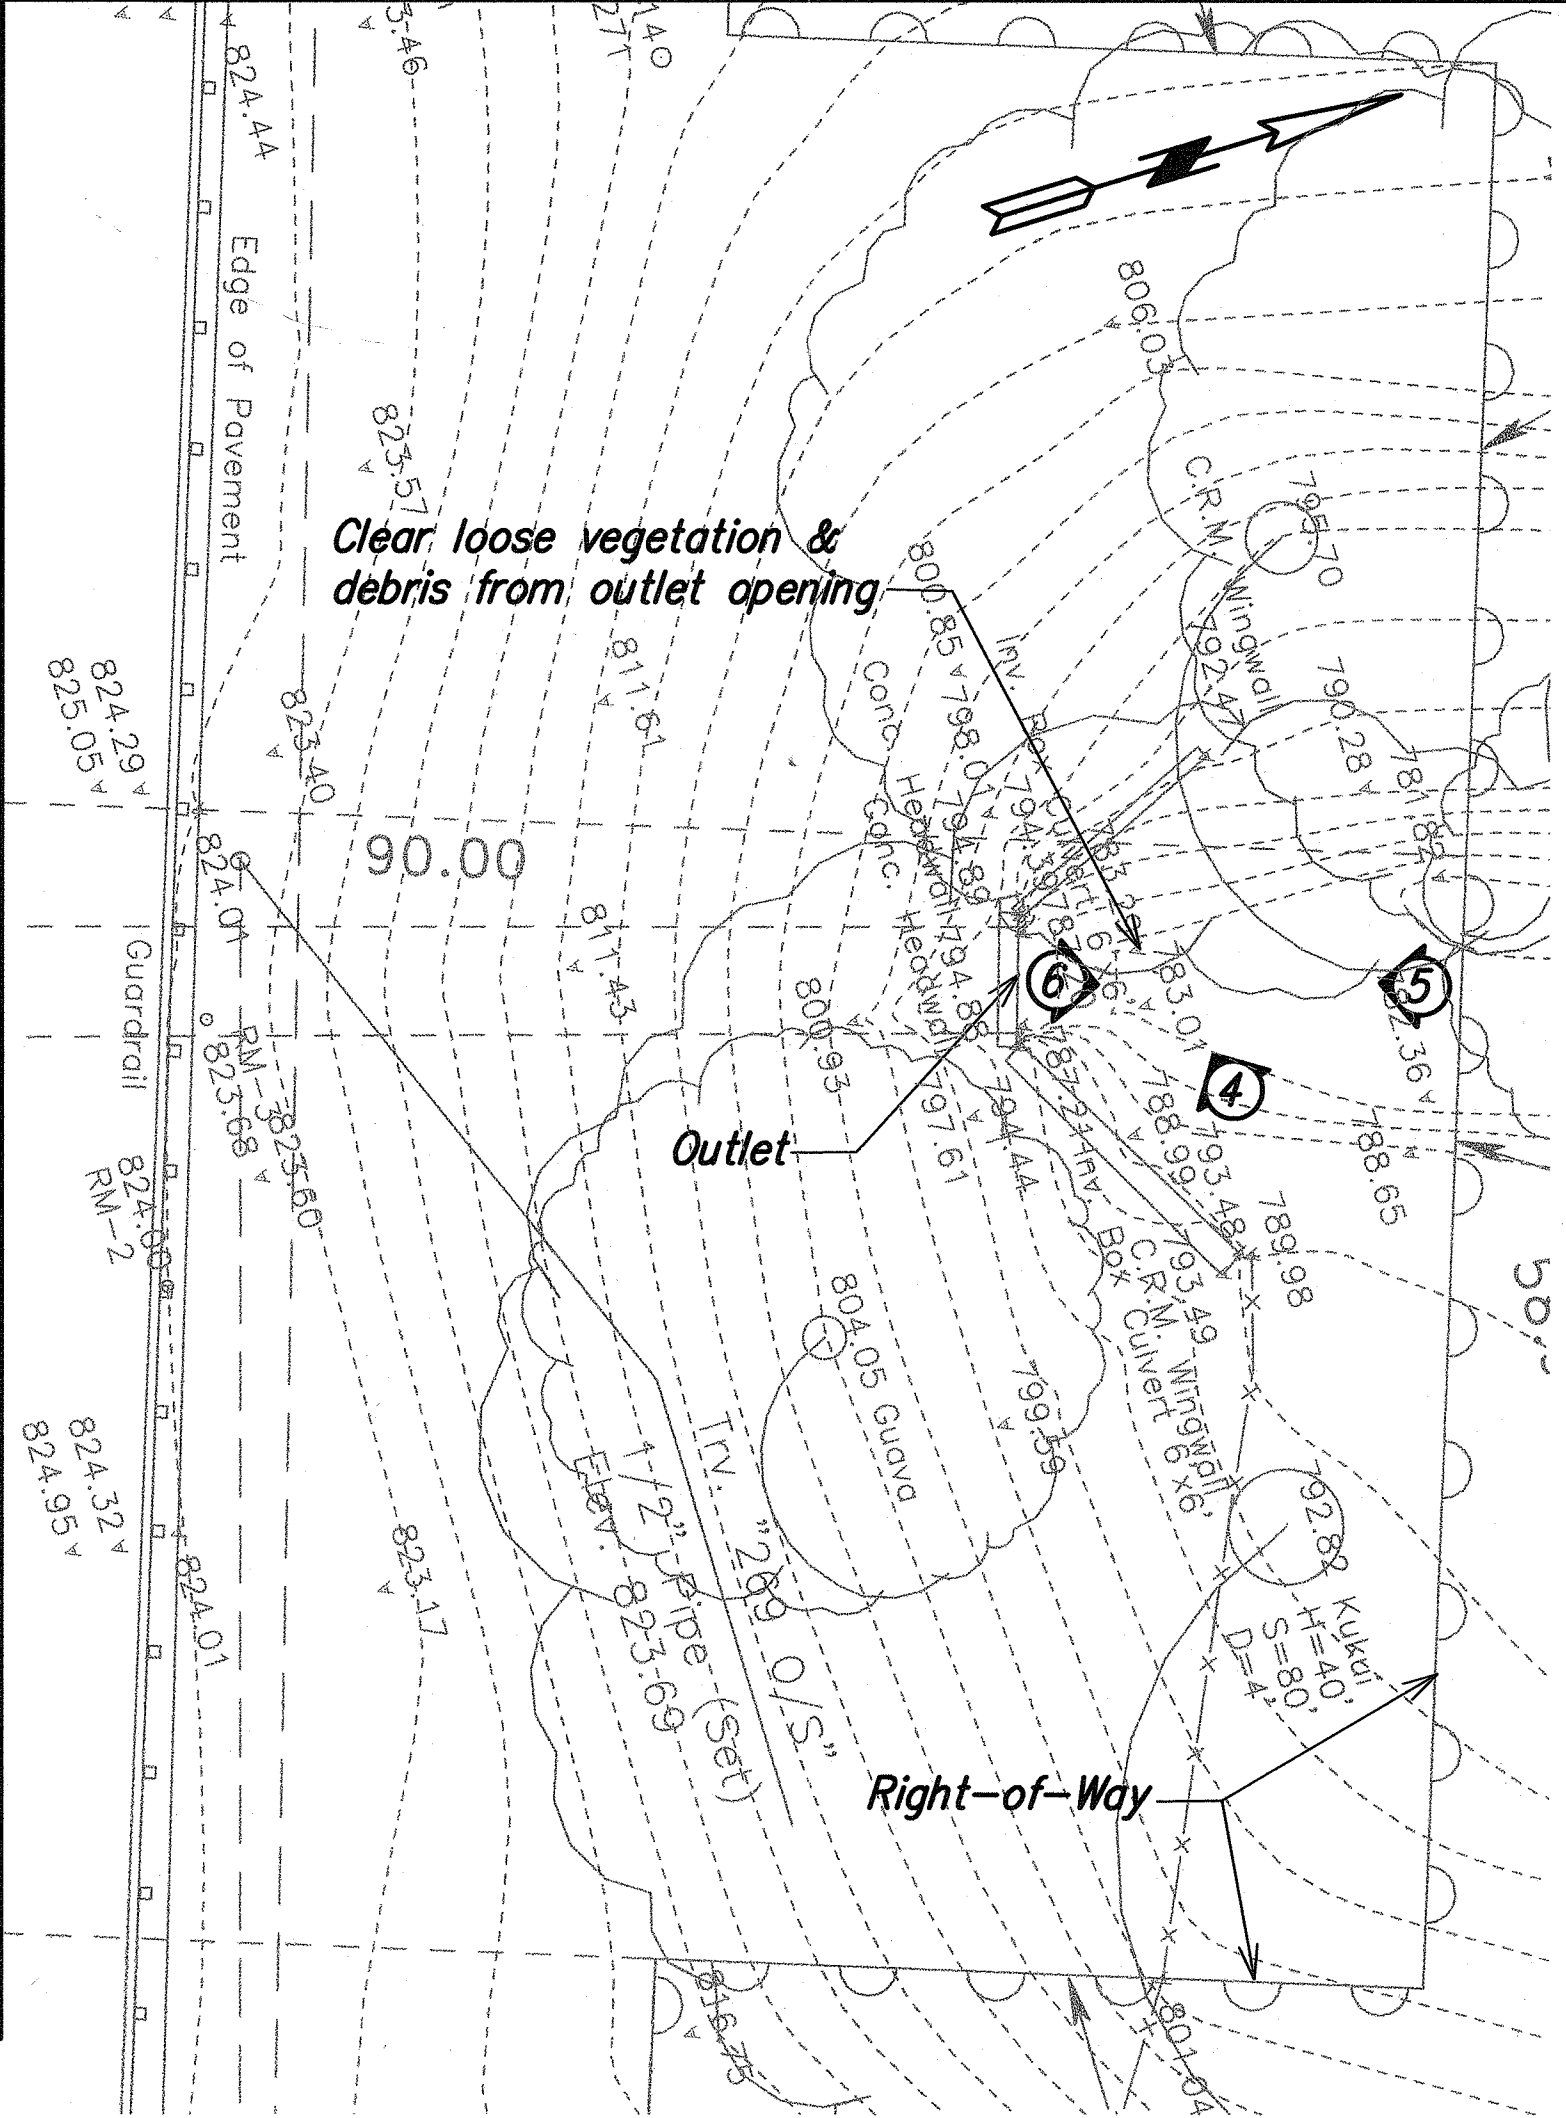

OUTLET SITE PLAN
Scale: 1"=10'



Photo 4


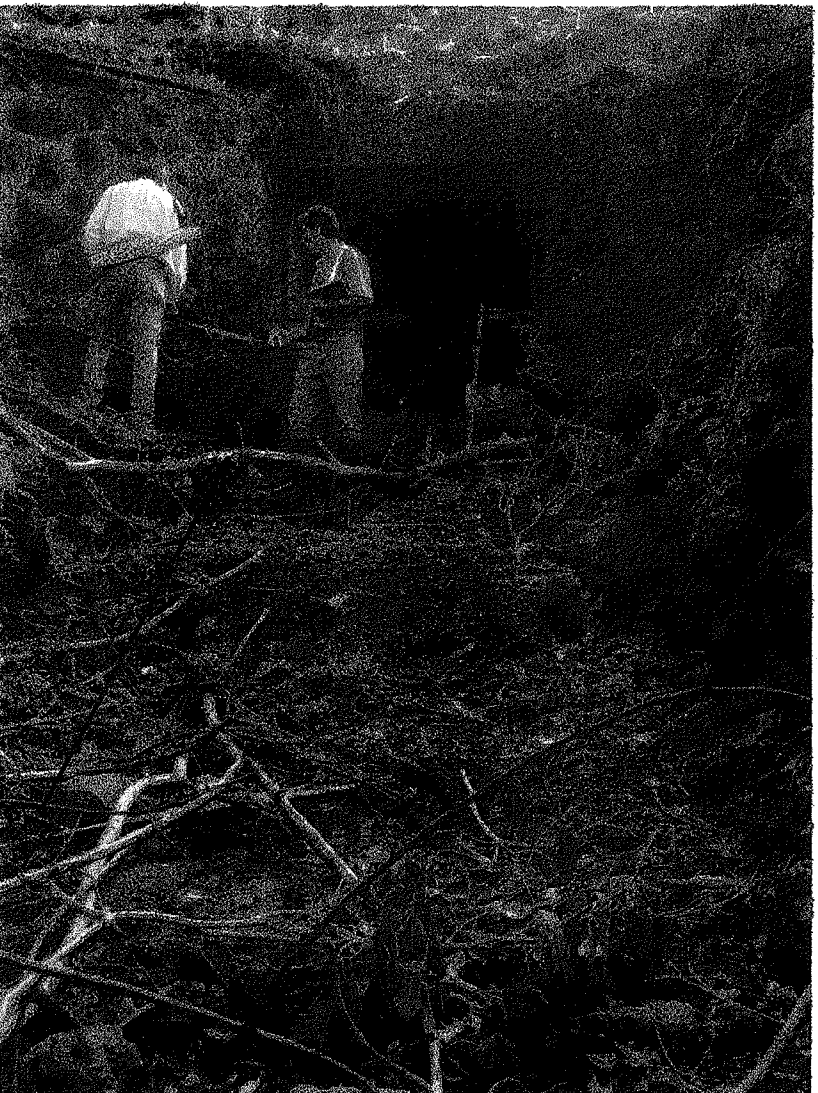


Photo 5



Photo 6

Note:
Weepholes & continuous gravel layer shall be located at approximately 1/3-height of slope protection.

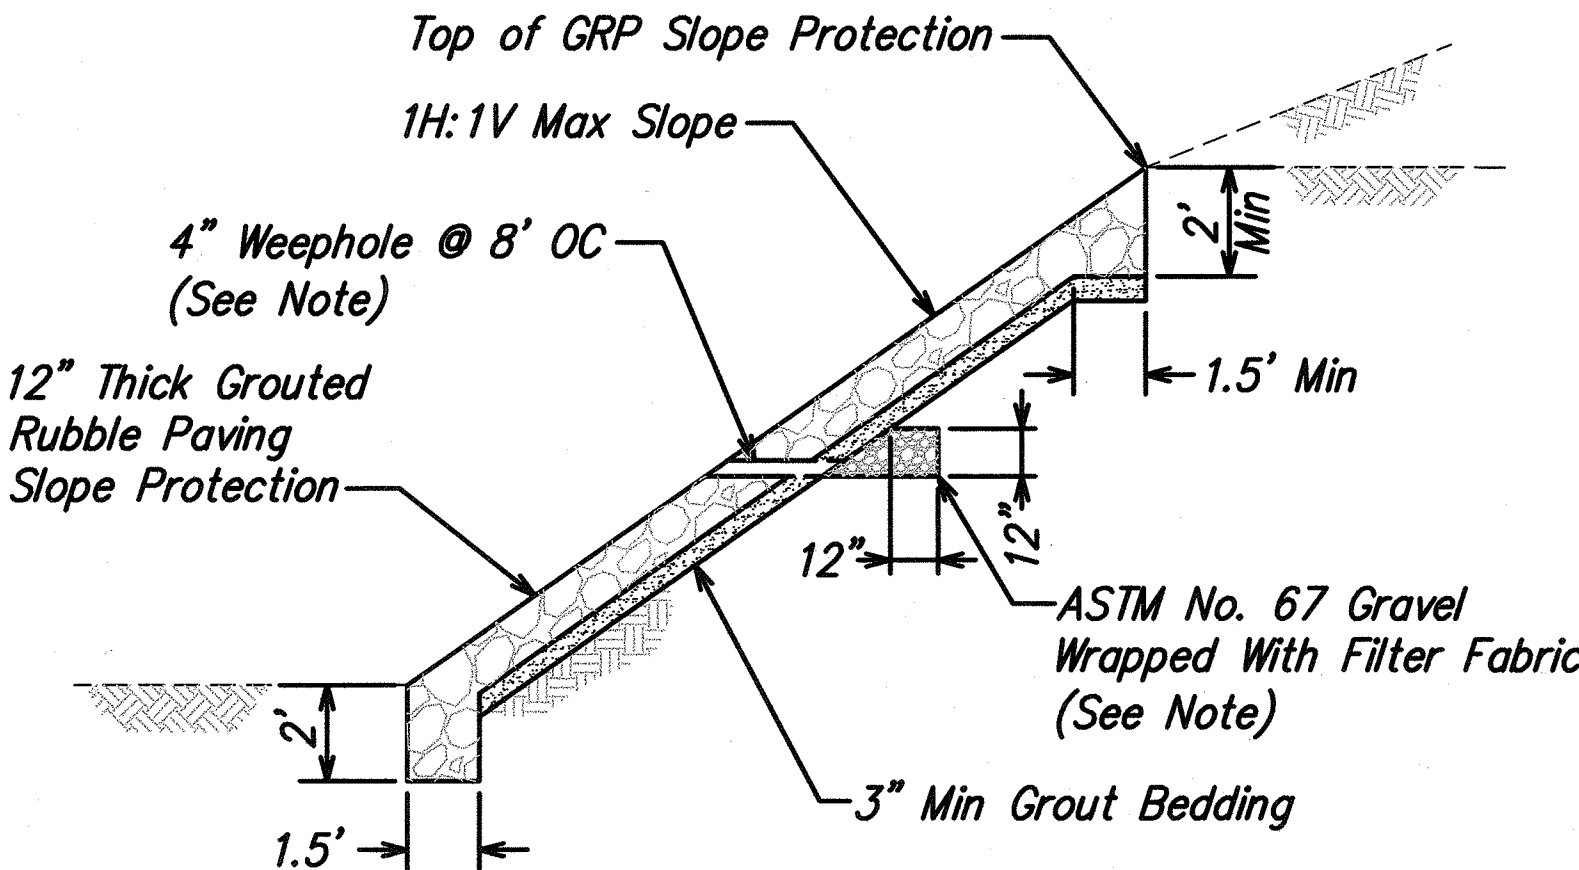


1 C2.14 GROUTED RUBBLE PAVING SLOPE PROTECTION
Not to Scale

Graphic Scale:



EarthTech
A Tyco International Ltd. Company

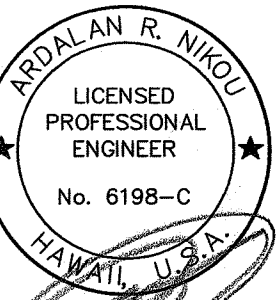

EXPIRATION DATE OF THE LICENSE: 4/30/2008
THIS WORK WAS PREPARED BY ME OR UNDER MY SUPERVISION.

STATE OF HAWAII
DEPARTMENT OF TRANSPORTATION
HIGHWAYS DIVISION

MILE POST 37.88
SITE IMPROVEMENTS

HAWAII BELT ROAD DRAINAGE
IMPROVEMENTS

Project No. 19FGH-01-07M

Scale: As Noted Date: April 2007

SHEET No. C15.1 OF 1 SHEETS

"AS-BUILT"