



FED. ROAD DIST. NO.	STATE	PROJ. NO.	FISCAL YEAR	SHEET NO.	TOTAL SHEETS
HAWAII	HAW.	19FGH-01-07M	2008	48	51

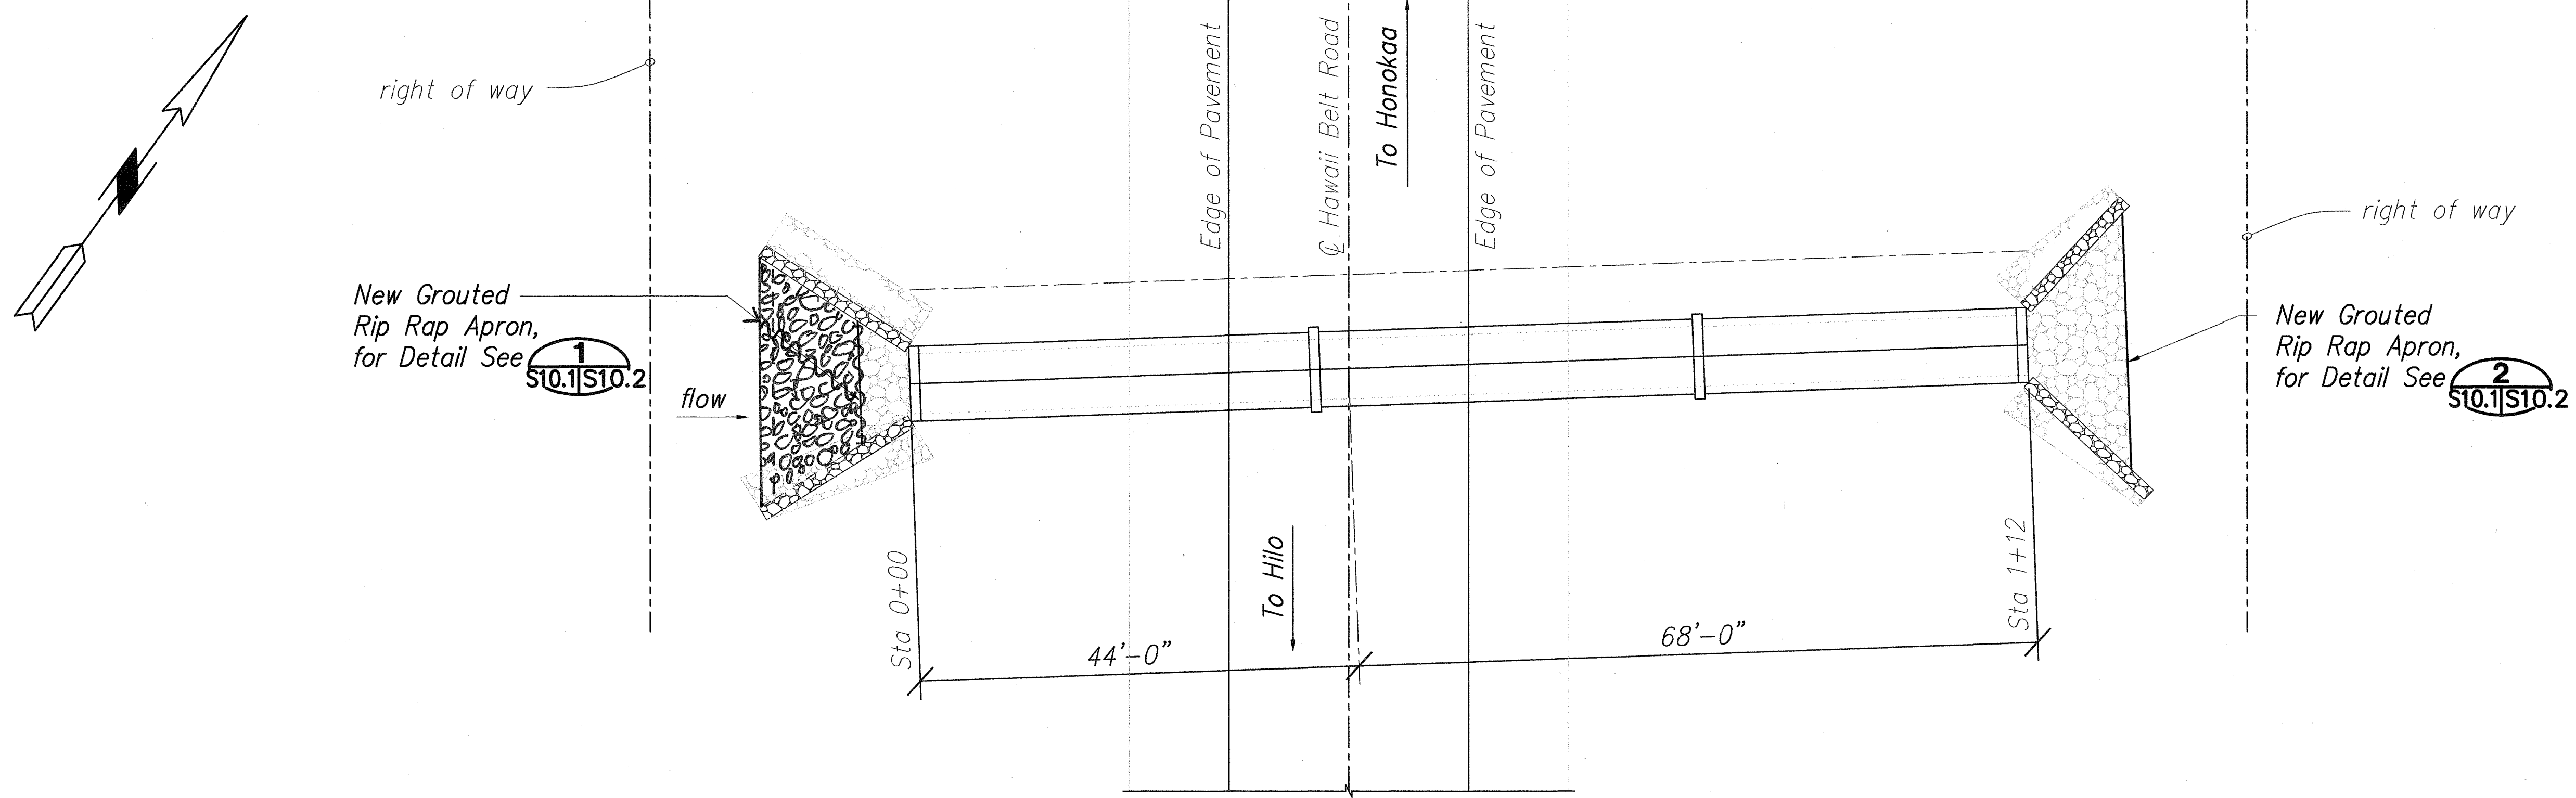


LAYOUT PLAN

Scale: 1" = 10'-0"

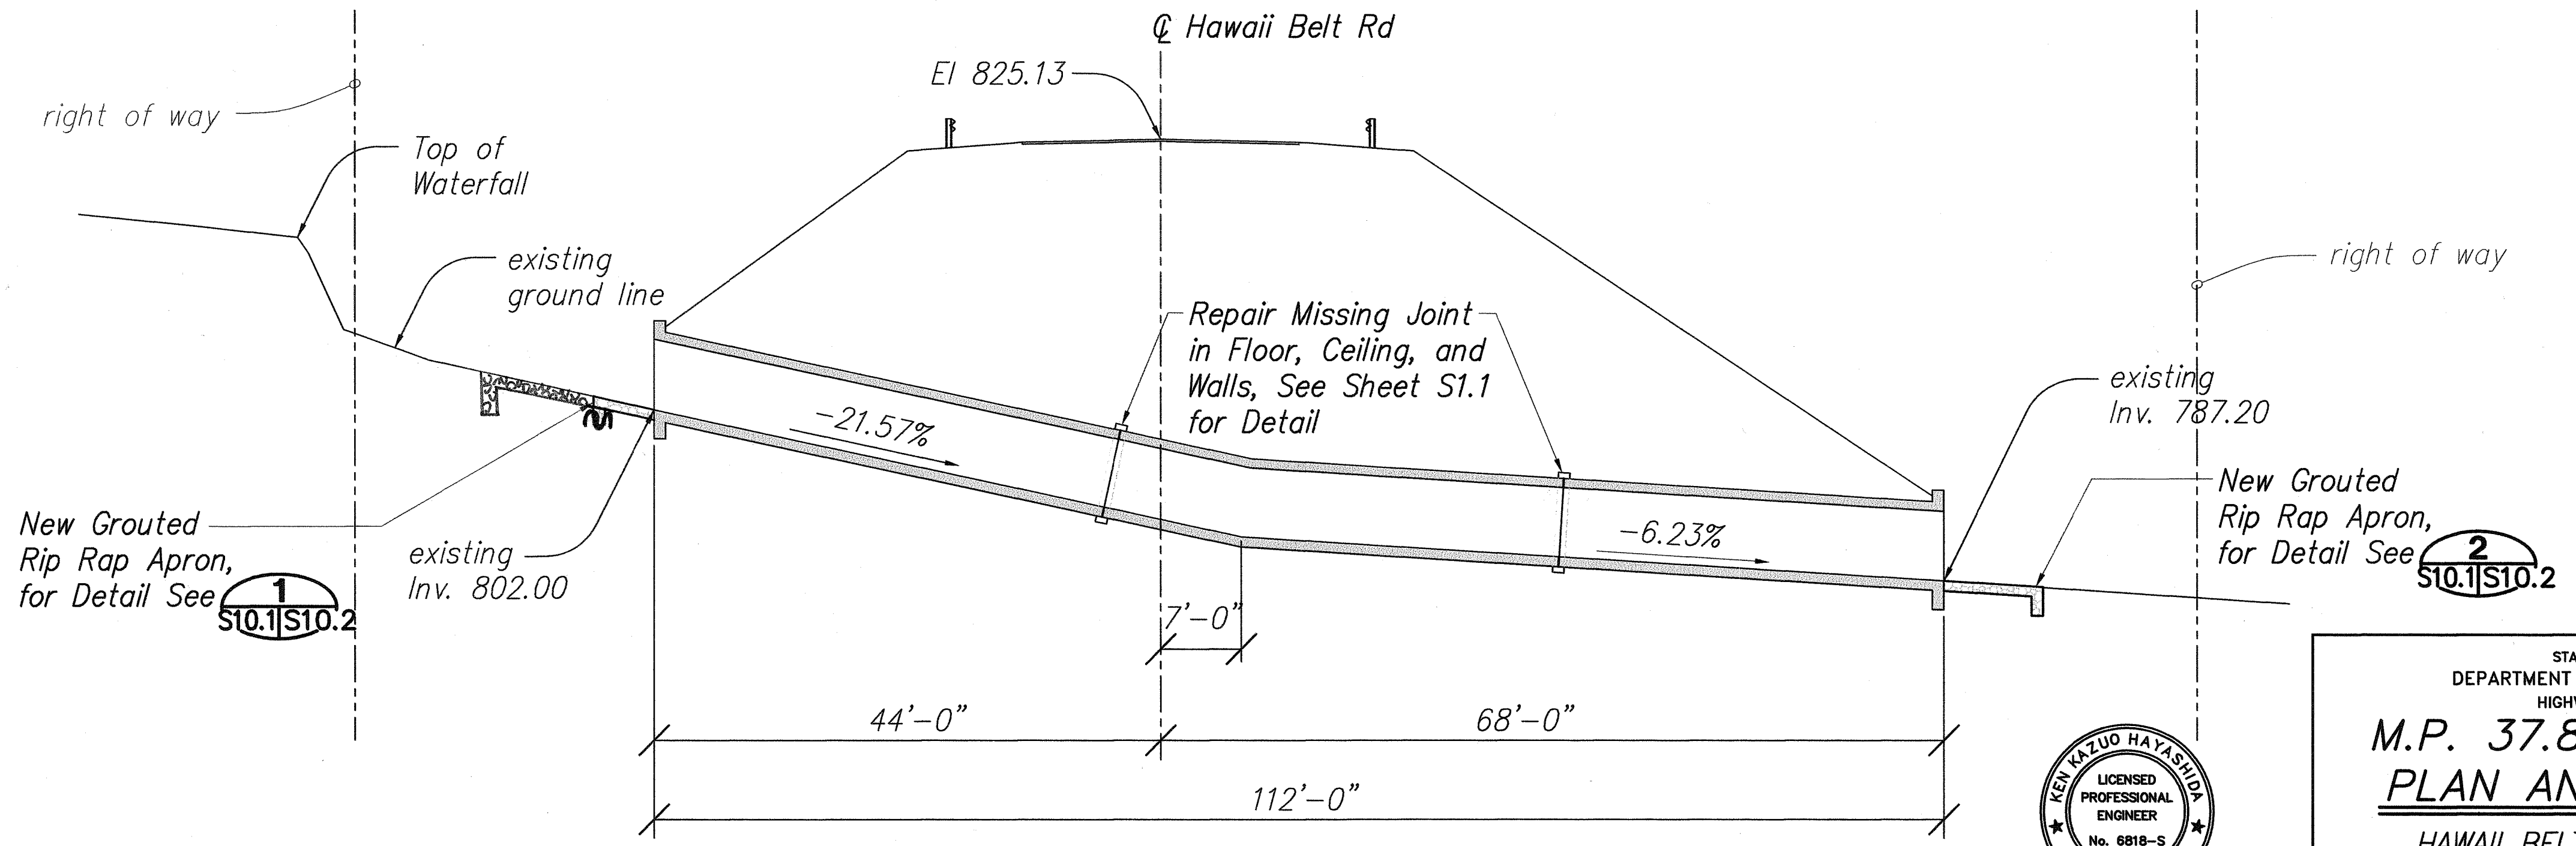

SECTION ALONG Q CULVERT

Scale: 1" = 10'-0"

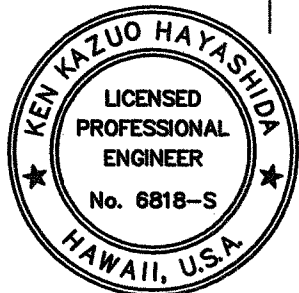

STATE OF HAWAII  
DEPARTMENT OF TRANSPORTATION  
HIGHWAYS DIVISION  
**M.P. 37.88 CULVERT  
PLAN AND PROFILE**  
*HAWAII BELT ROAD DRAINAGE  
IMPROVEMENTS*  
Project No. 19FGH-01-07M  
Scale: AS NOTED Date: APRIL 2007  
SHEET No. S10.1 OF 51 SHEETS

THIS WORK WAS PREPARED BY  
ME OR UNDER MY SUPERVISION

ORIGINAL PLAN	DATE
DESIGNED BY	
TRACED BY	
NOTED BY	
CHECKED BY	
NO.	

"AS-BUILT"

