

FED. ROAD DIST. NO.	STATE	PROJ. NO.	FISCAL YEAR	SHEET NO.	TOTAL SHEETS
HAWAII	HAW	19FGH-01-07M	2008	27	51

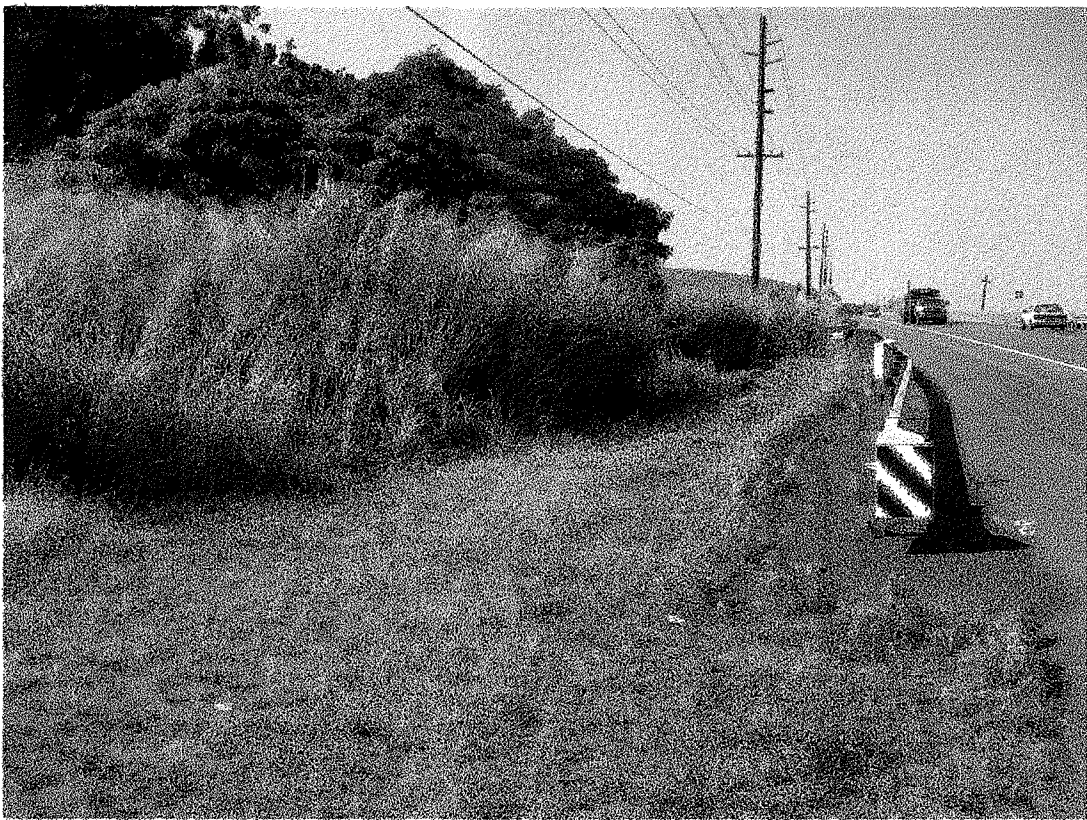


Photo 1

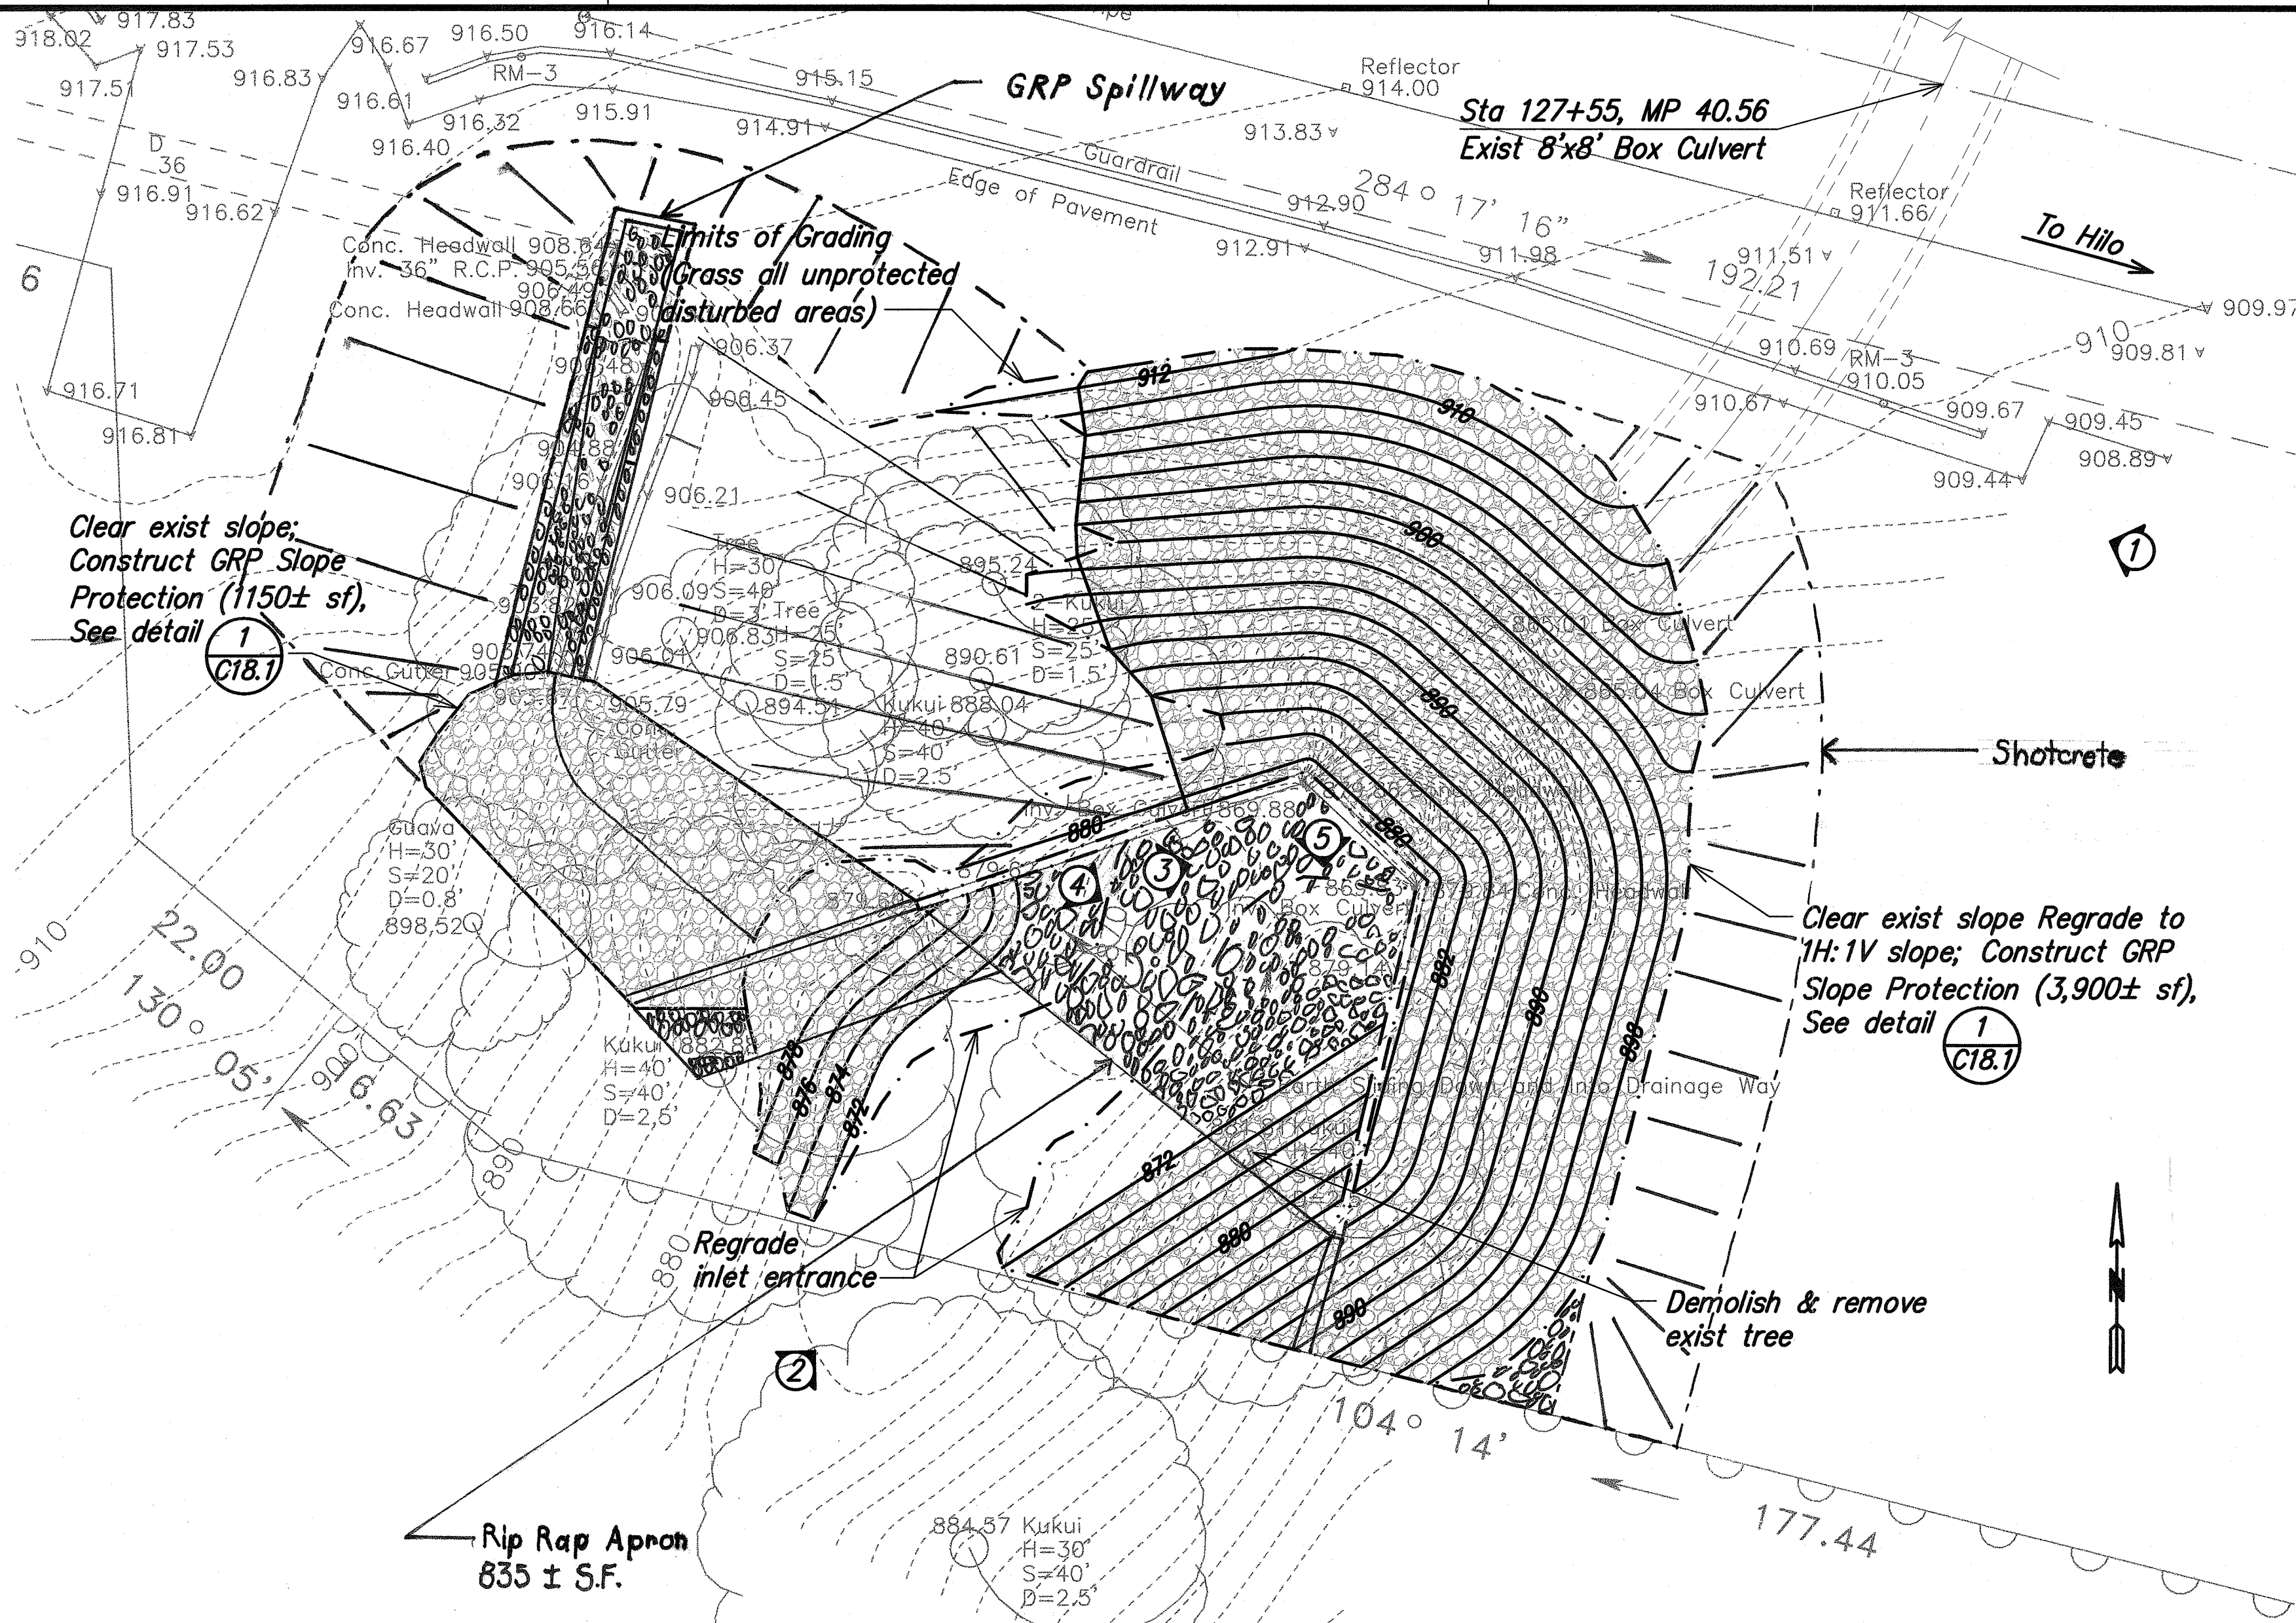


Photo 2

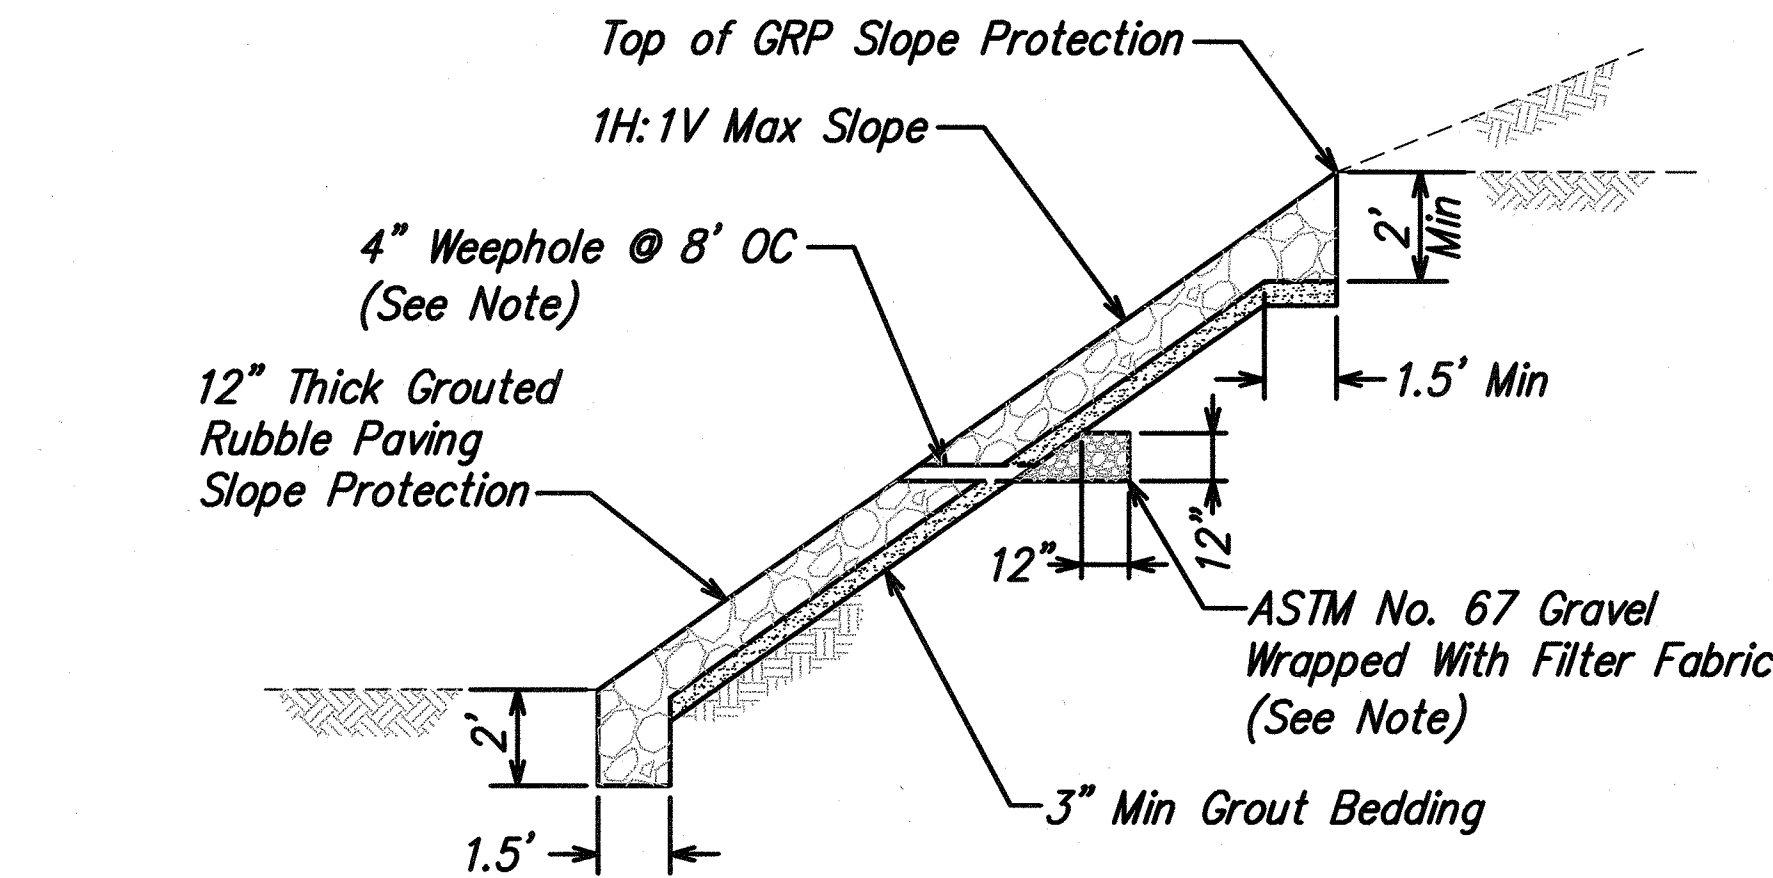


Photo 3

PHOTO NOTE:
Photographs are only for identifying the worksite. The Contractor shall perform his/her own site inspection to verify the existing site conditions that he/she may encounter during construction.



SITE PLAN
Scale: 1"=10'



Note:
Weepholes & continuous gravel layer shall be located at approximately 1/3-height of slope protection.


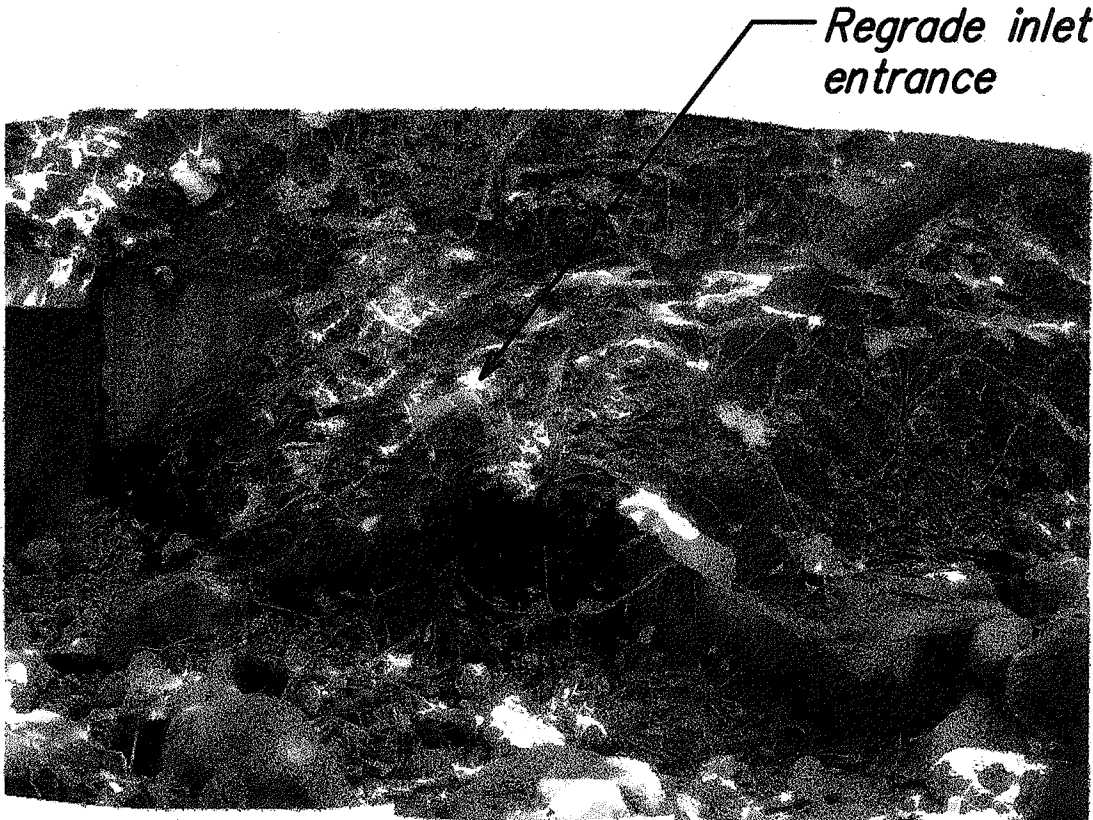


Photo 4




Photo 5

Shotcrete

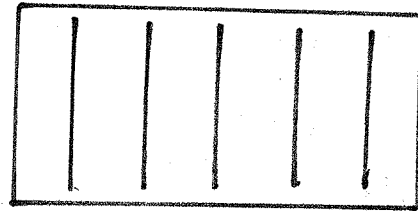


SURVEY PLOTTED BY	DATE
DRAWN BY	
DESIGNED BY	
CHECKED BY	
ORIGINAL PLAN	
NOTE BOOK	

EarthTech
A Tyco International Ltd. Company

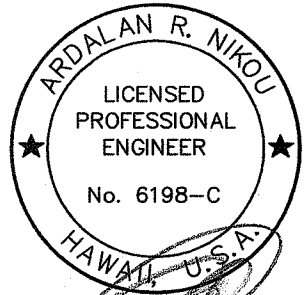

STATE OF HAWAII
DEPARTMENT OF TRANSPORTATION
HIGHWAYS DIVISION

MILE POST 40.56
SITE IMPROVEMENTS
HAWAII BELT ROAD DRAINAGE IMPROVEMENTS
Project No. 19FGH-01-07M
Scale: As Noted Date: April 2007
SHEET No. C18.1 OF 1 SHEETS

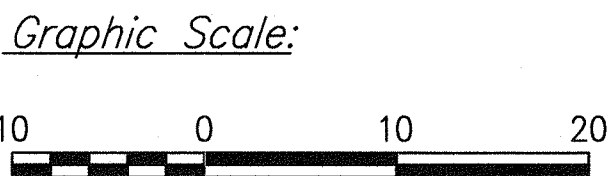

"AS-BUILT"