

INDEX TO DRAWINGS	
SHEET NO.	DESCRIPTION
1	TITLE SHEET
2	STANDARD PLANS SUMMARY
3	GENERAL NOTES AND LEGEND
4-5	WATER POLLUTION AND EROSION CONTROL NOTES
6-7	GENERAL SITE PLAN
8-9	MP 15.34 SITE IMPROVEMENTS & CROSS SECTIONS
10-11	MP 16.59 SITE IMPROVEMENTS & CROSS SECTIONS
12	MP 19.55 SITE IMPROVEMENTS
13	MP 21.92 SITE IMPROVEMENTS
14-15	MP 25.99 SITE IMPROVEMENTS & CROSS SECTIONS
16	MP 27.10 SITE IMPROVEMENTS
17	MP 29.01 SITE IMPROVEMENTS
18	MP 31.45 SITE IMPROVEMENTS
19	MP 33.14 SITE IMPROVEMENTS
20	MP 33.75 SITE IMPROVEMENTS
21	MP 33.76 SITE IMPROVEMENTS
22	MP 35.51 SITE IMPROVEMENTS
23	MP 37.06 SITE IMPROVEMENTS
24	MP 37.88 SITE IMPROVEMENTS
25	MP 38.31 SITE IMPROVEMENTS
26	MP 40.33 SITE IMPROVEMENTS
27	MP 40.56 SITE IMPROVEMENTS
28	MP 41.95 SITE IMPROVEMENTS
29-31	STRUCTURAL NOTES & DETAILS
32-33	MP 16.59 STRUCTURAL PLANS
34	MP 19.55 STRUCTURAL PLANS
35-36	MP 21.92 STRUCTURAL PLANS
37-38	MP 27.10 STRUCTURAL PLANS
39-40	MP 31.45 STRUCTURAL PLANS
41-45	MP 33.75 STRUCTURAL PLANS
36	MP 33.76 STRUCTURAL PLANS
47	MP 35.51 STRUCTURAL PLANS
48-49	MP 37.88 STRUCTURAL PLANS
50-51	MP 40.33 STRUCTURAL PLANS


EARTH TECH
DESIGNED BY

HWY-H
MANAGED BY



933-8866
PHONE

APR 2007
DATE




STATE OF HAWAII
DEPARTMENT OF TRANSPORTATION
HIGHWAYS DIVISION
HONOLULU, HAWAII
"AS-BUILT"
PLANS FOR
HAWAII BELT ROAD DRAINAGE
IMPROVEMENTS
VARIOUS LOCATIONS
PROJECT NO. 19FGH-01-07M
DISTRICTS OF SOUTH HILO, NORTH HILO
AND HAMAKUA, ISLAND OF HAWAII

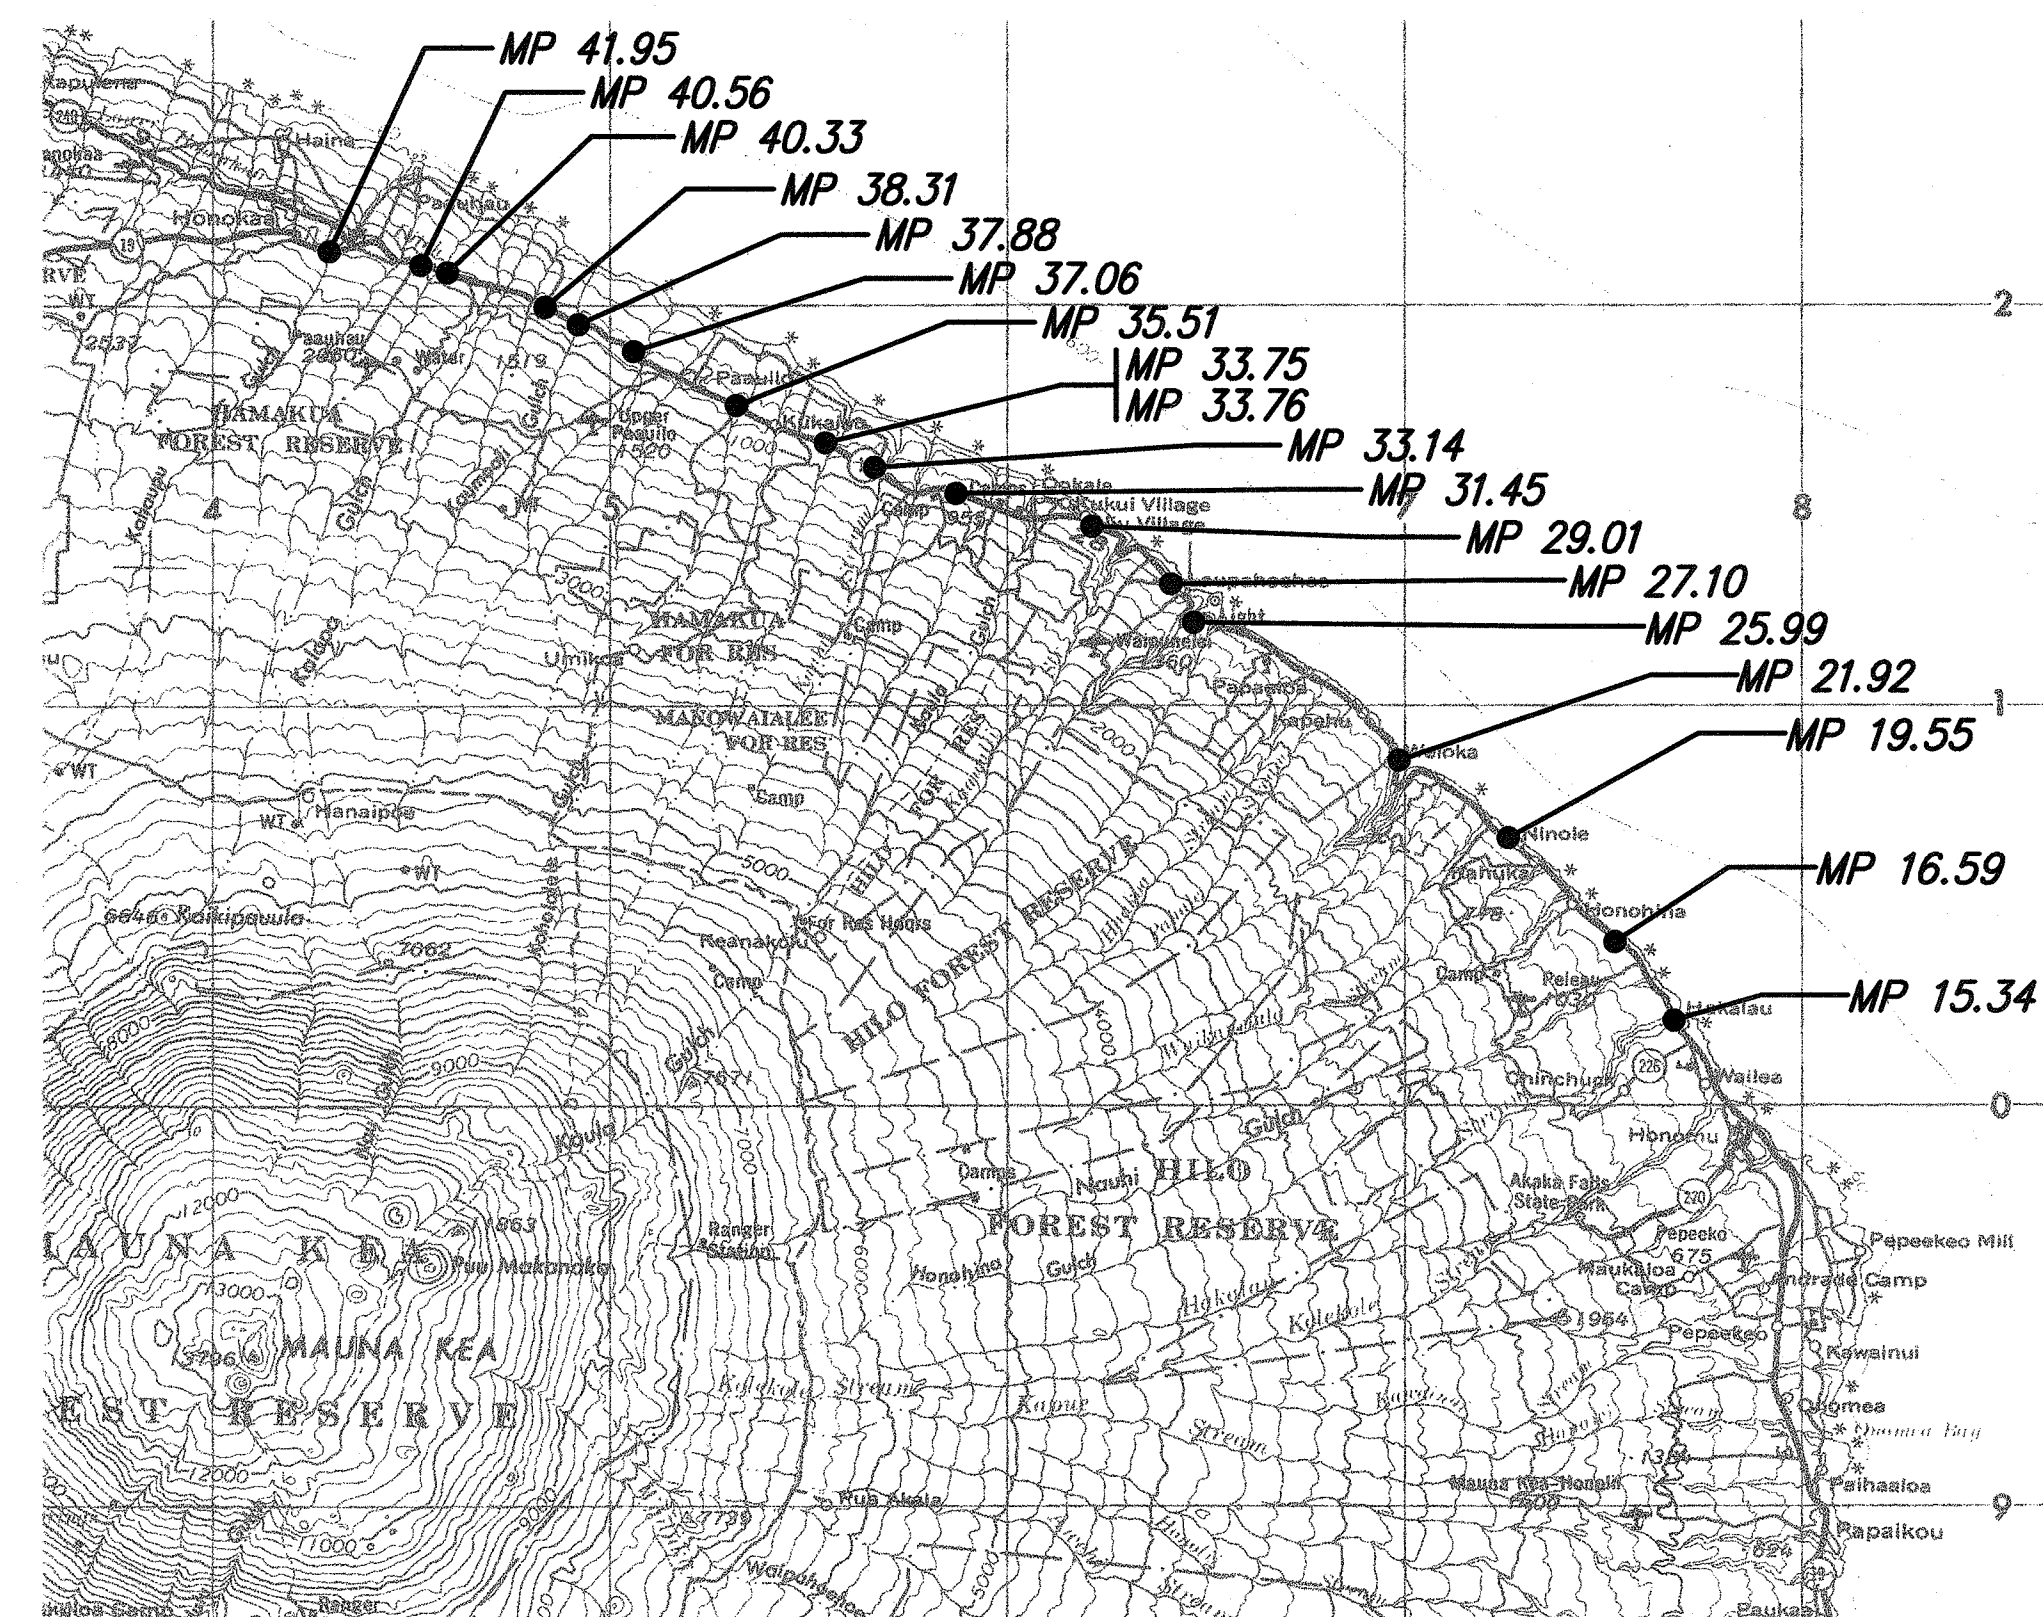

LAYOUT PLAN

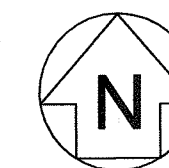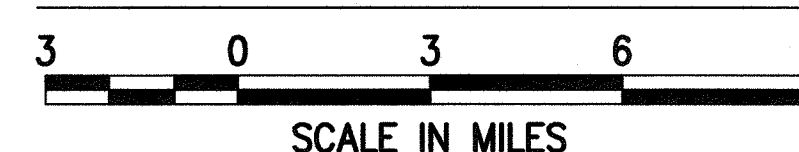

FED. ROAD DIST. NO.	STATE	PROJ. NO.	FISCAL YEAR	SHEET NO.	TOTAL SHEETS
HAWAII	HAW	19FGH-01-07M	2008	1	51

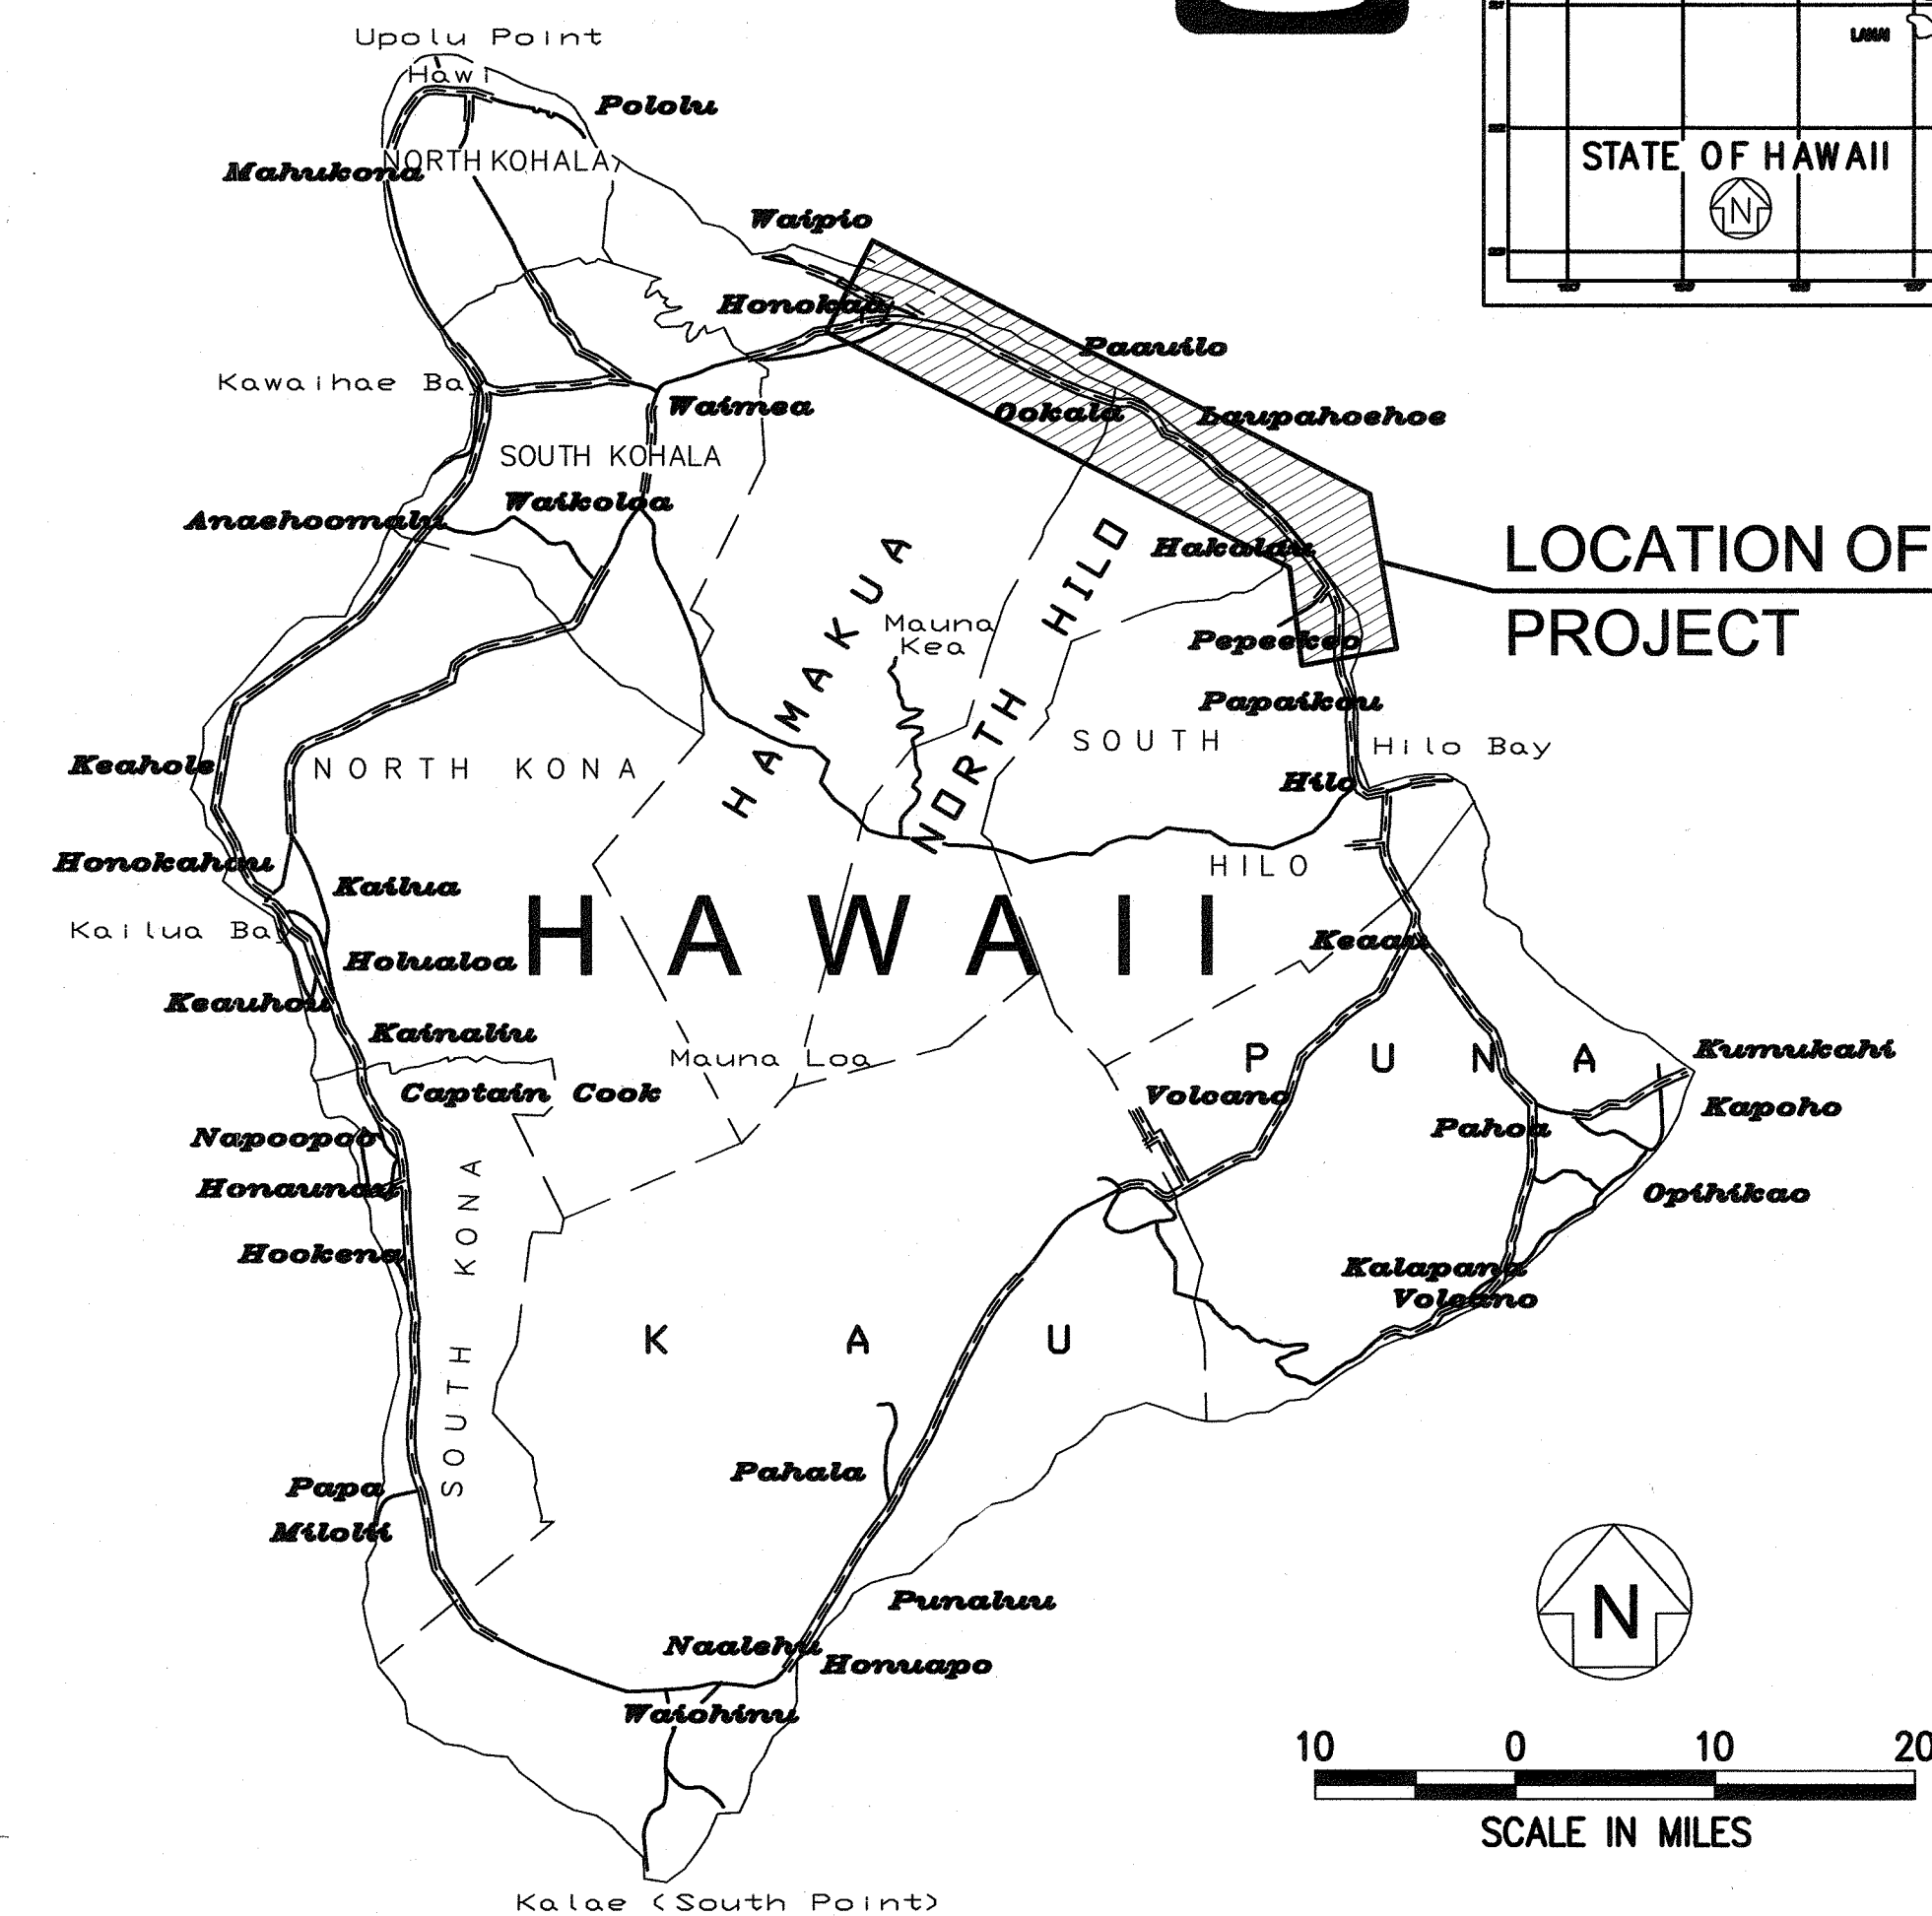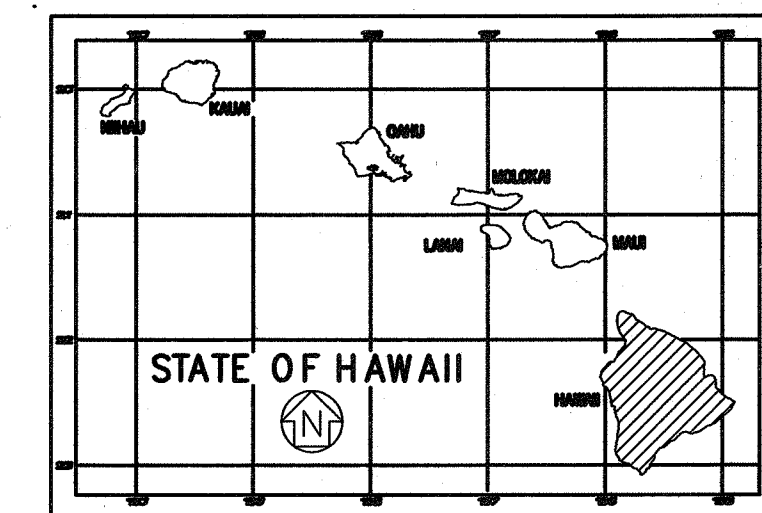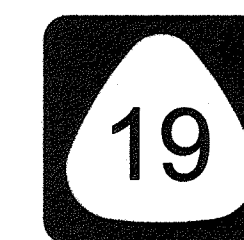

LOCATION OF
PROJECT



----- FEDERAL AID PROJECTS PREVIOUSLY
CONSTRUCTED OR UNDER CONSTRUCTION

MILE POST 15.34 TO MILE POST 41.95

CHANGES MADE DURING CONSTRUCTION HAVE BEEN
INCORPORATED ON THESE PLANS EXCEPT CHANGES
IN THE ORIGINAL THEORETICAL QUANTITIES. FOR
ACTUAL QUANTITIES, REFER TO PROJECT LEDGER
AND/OR COMPUTATION BOOK.

Robert Yung Lu 3/11/14
RESIDENT ENGINEER DATE

DEPARTMENT OF TRANSPORTATION
STATE OF HAWAII

APPROVED:

Dir. of Transportation

5/7/07
DATE