


FED. ROAD DIST. NO.	STATE	FED. AID PROJ. NO.	FISCAL YEAR	SHEET NO.	TOTAL SHEETS
HAWAII	HAW.	ER-15(3)	2010	11	80

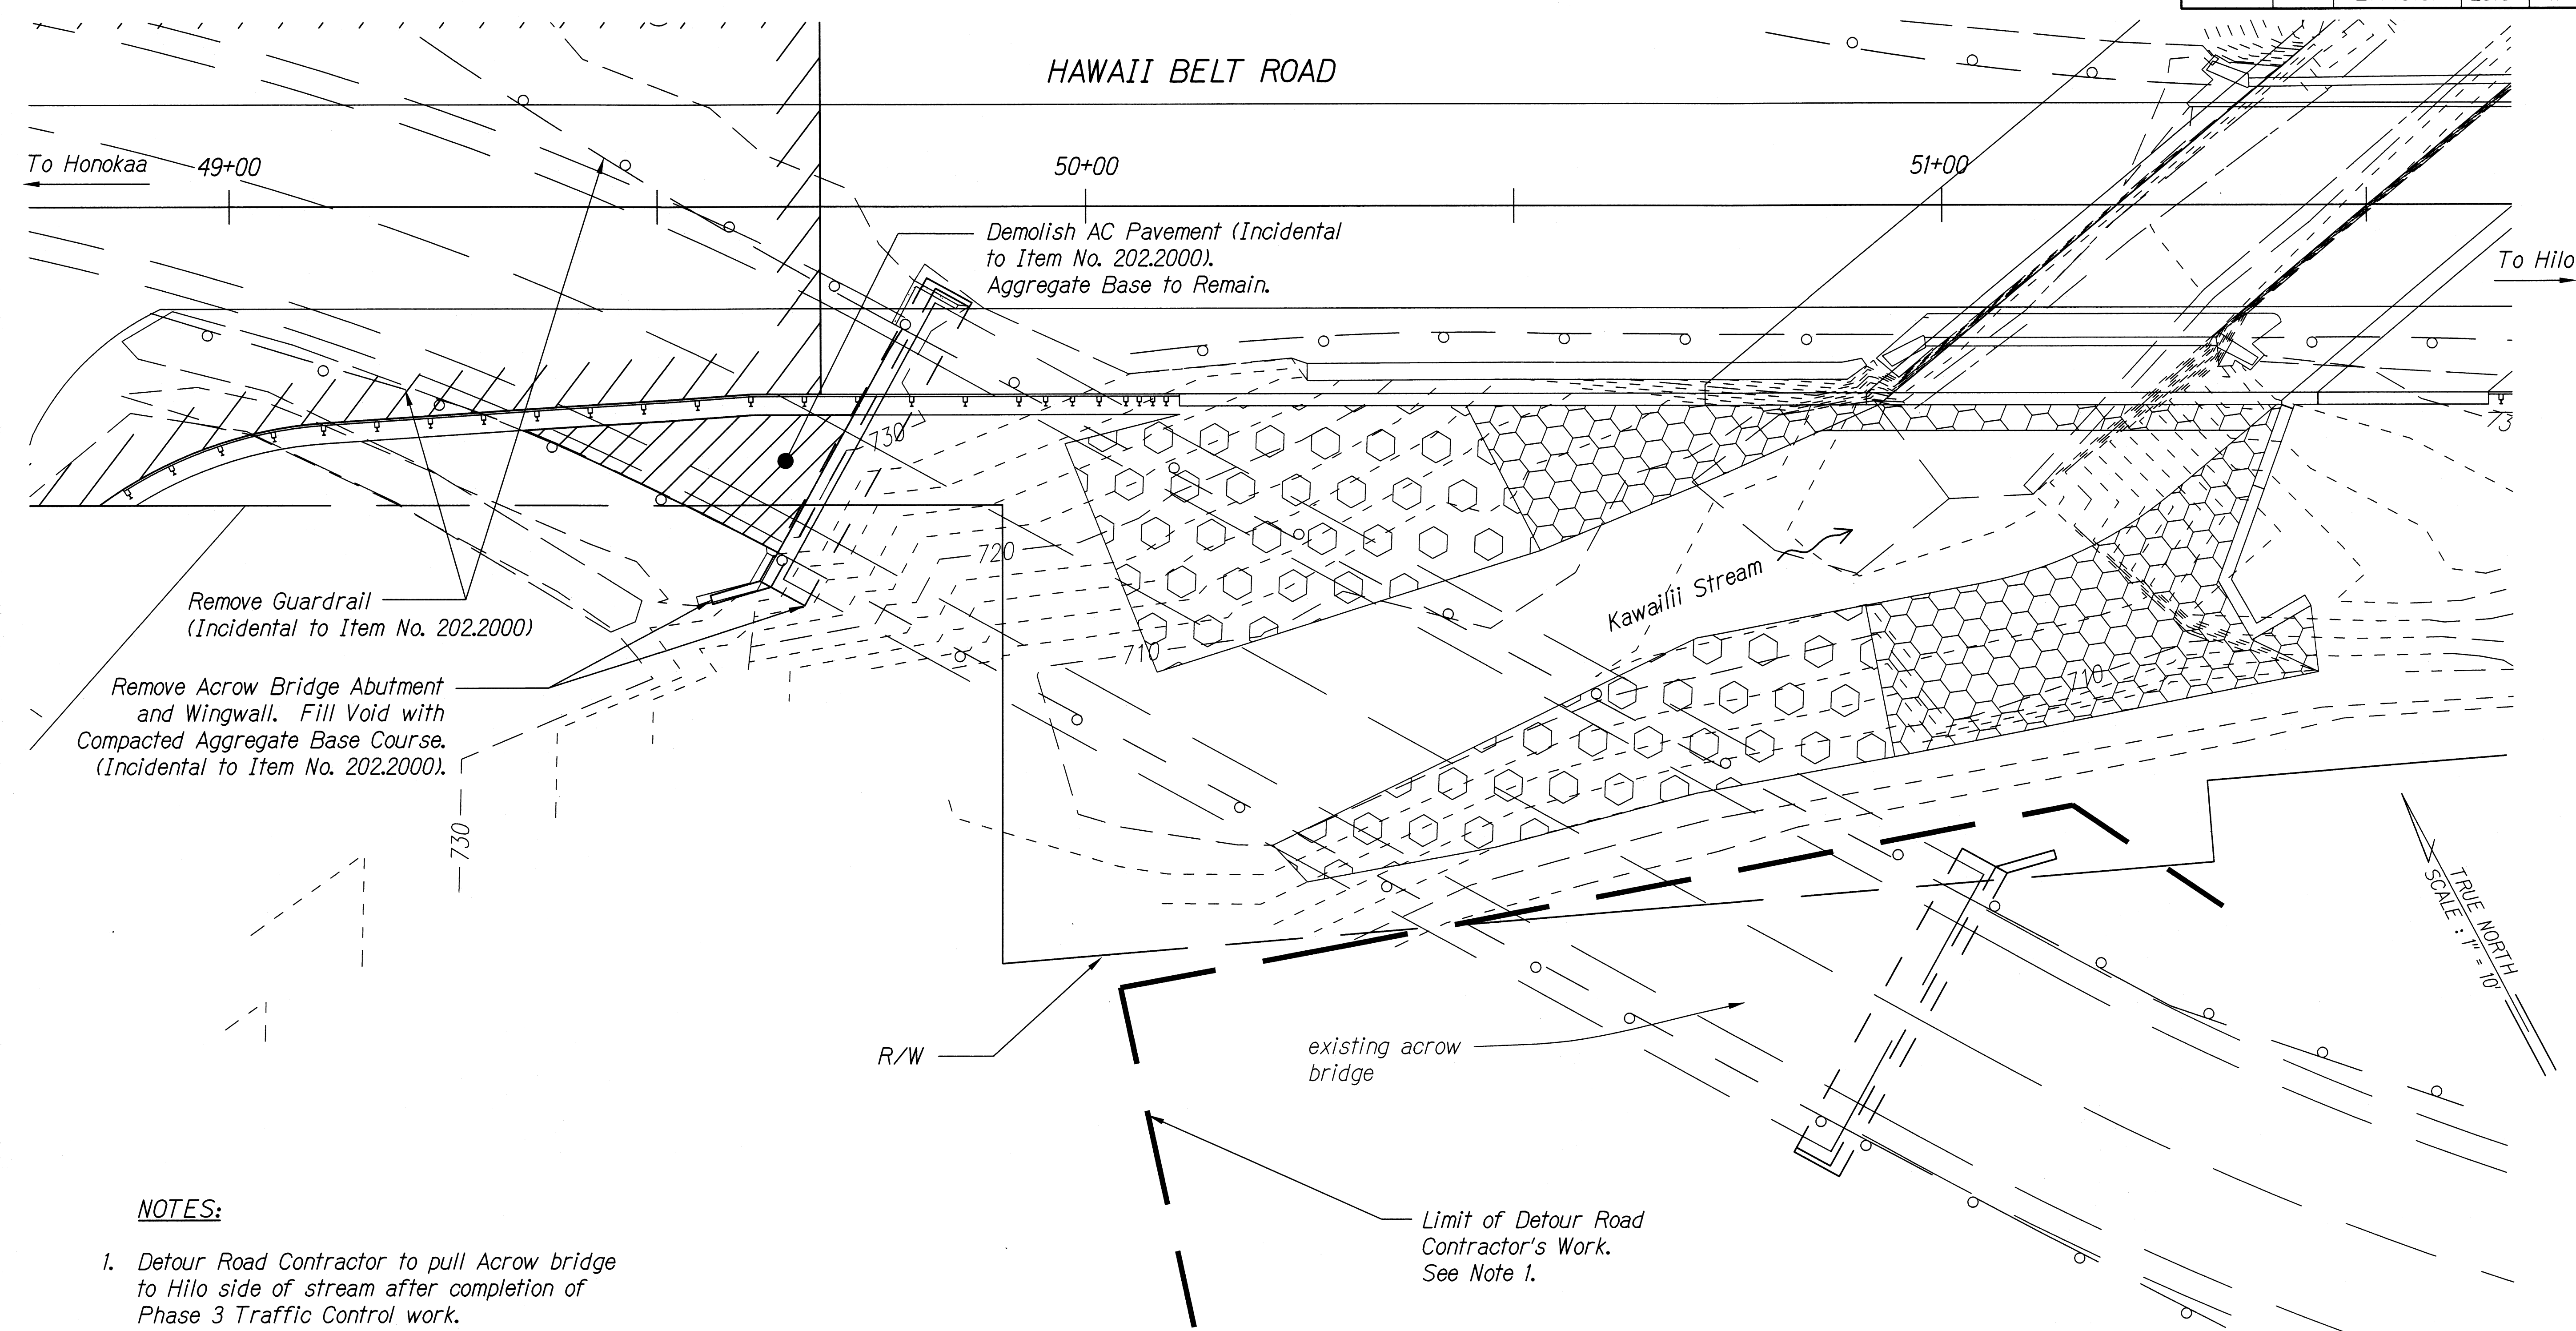

NOTES:



1. Detour Road Contractor to pull Acrow bridge to Hilo side of stream after completion of Phase 3 Traffic Control work.
2. The Detour Road Contractor is actively maintaining the detour road, and may be working in the area during construction.

ORIGINAL PLAN	DATE
DESIGNED BY	
TRACED BY	
NOTE BOOK	
QUANTITIES BY	
CHECKED BY	
N.	

ACROW BRIDGE ABUTMENT DEMOLITION PLAN

Scale: 1"=10'


GRAPHIC SCALE

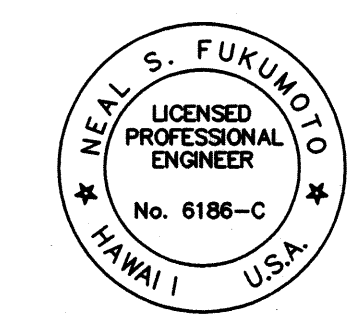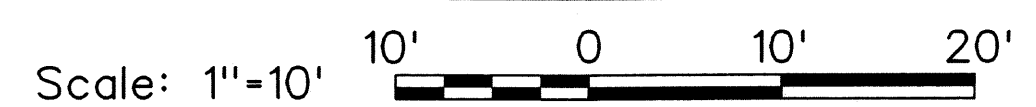

This work was prepared by me or under my supervision.
Exp. 04-30-10
Neal S. Fukunaga
Wesley R. Segawa & Associates, Inc.


STATE OF HAWAII
DEPARTMENT OF TRANSPORTATION
HIGHWAYS DIVISION
ACROW BRIDGE ABUTMENT
DEMOLITION PLAN
HAWAII BELT ROAD
KAWAILII STREAM BRIDGE REPLACEMENT
Federal Aid Project No. ER-15(3)
Scale: 1"=10' Date: October 2009
SHEET No. 1 OF 1 SHEETS

FED. ROAD DIST. NO.	STATE	FED. AID PROJ. NO.	FISCAL YEAR	SHEET NO.	TOTAL SHEETS
HAWAII	HAW.	ER-15(3)	2010	ADD. 11S-1	80

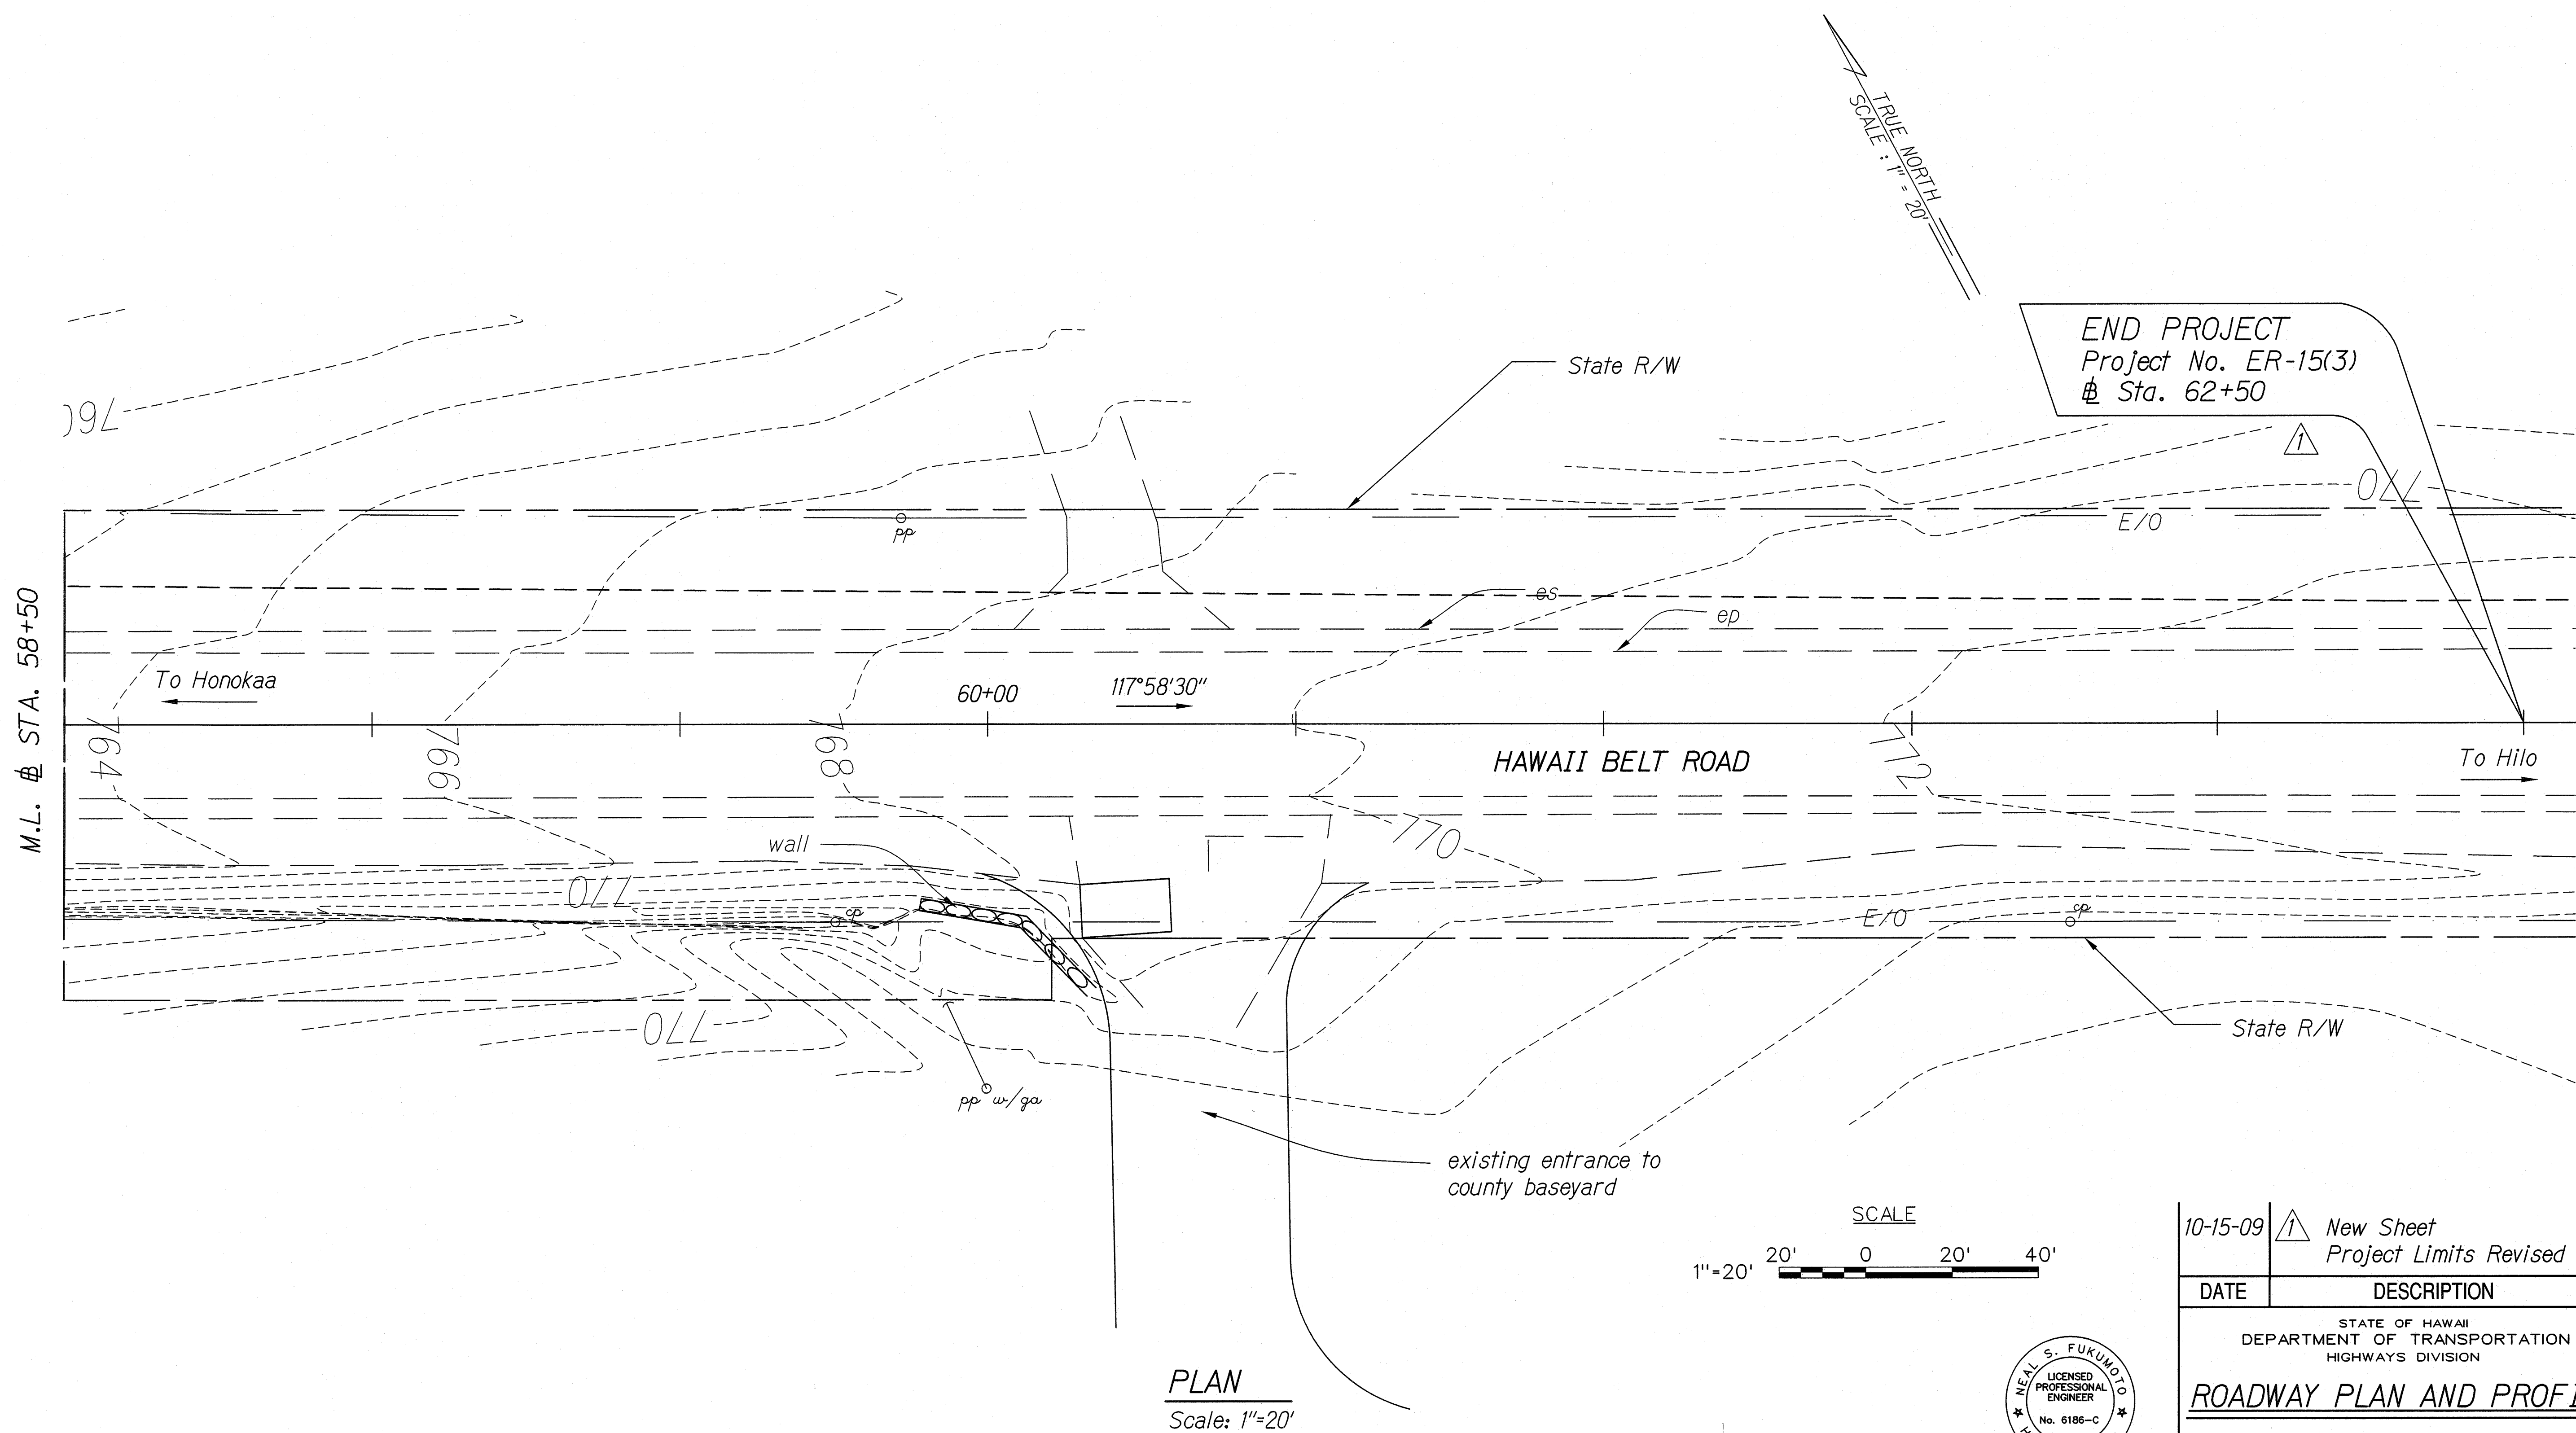

PLAN
Scale: 1"=20'

SURVEY PLOTTED BY	DATE
DRAWN BY	
DESIGNED BY	
QUANTITIES BY	
CHECKED BY	

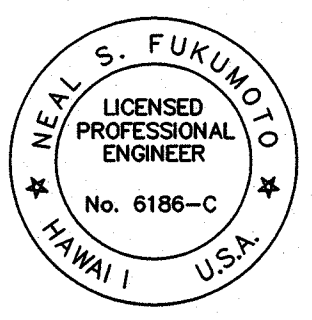

This work was prepared by me or under my supervision.
Exp. 04-30-10
Neal S. Fukumoto
Wesley R. Segawa & Associates, Inc.

10-15-09	New Sheet Project Limits Revised
DATE	DESCRIPTION
STATE OF HAWAII DEPARTMENT OF TRANSPORTATION HIGHWAYS DIVISION	
ROADWAY PLAN AND PROFILE	
HAWAII BELT ROAD KAWAIIII STREAM BRIDGE REPLACEMENT Federal Aid Project No. ER-15(3)	
Scale: As Shown	Date: October 2009
SHEET No. 4 OF 4 SHEETS	