




FED. ROAD DIST. NO.	STATE	FED. AID PROJ. NO.	FISCAL YEAR	SHEET NO.	TOTAL SHEETS
HAWAII	HAW.	ER-15(3)	2010	15	80

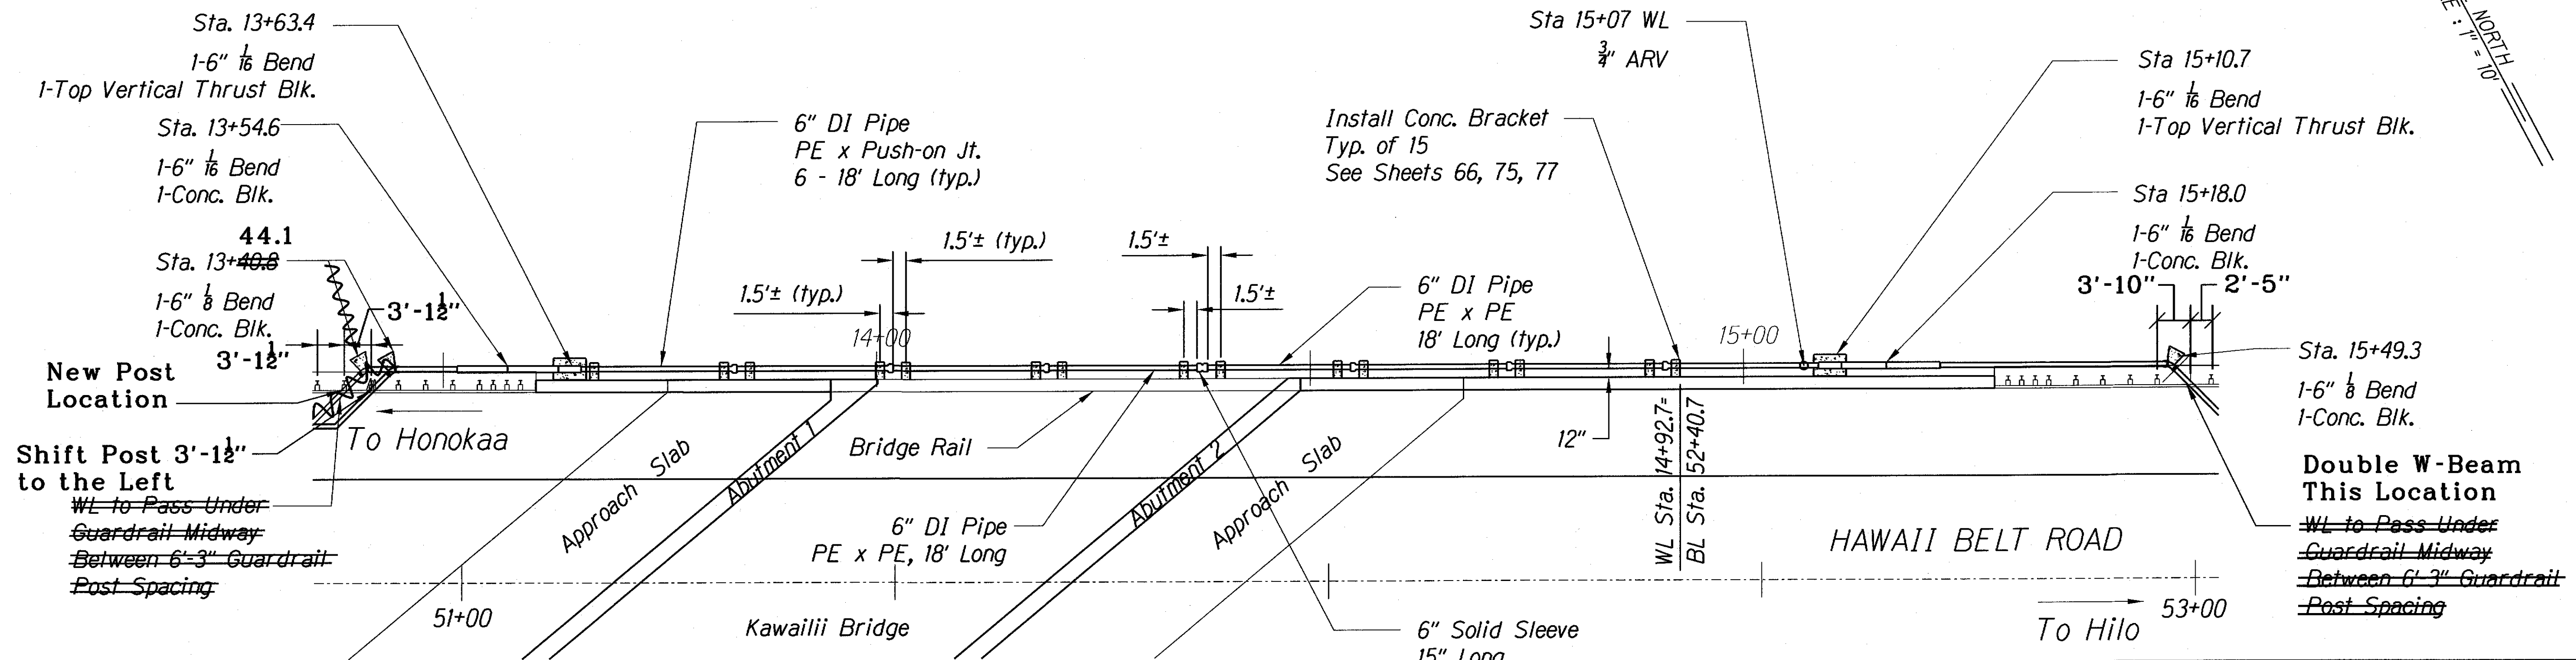

PLAN
SCALE: 1"=10'

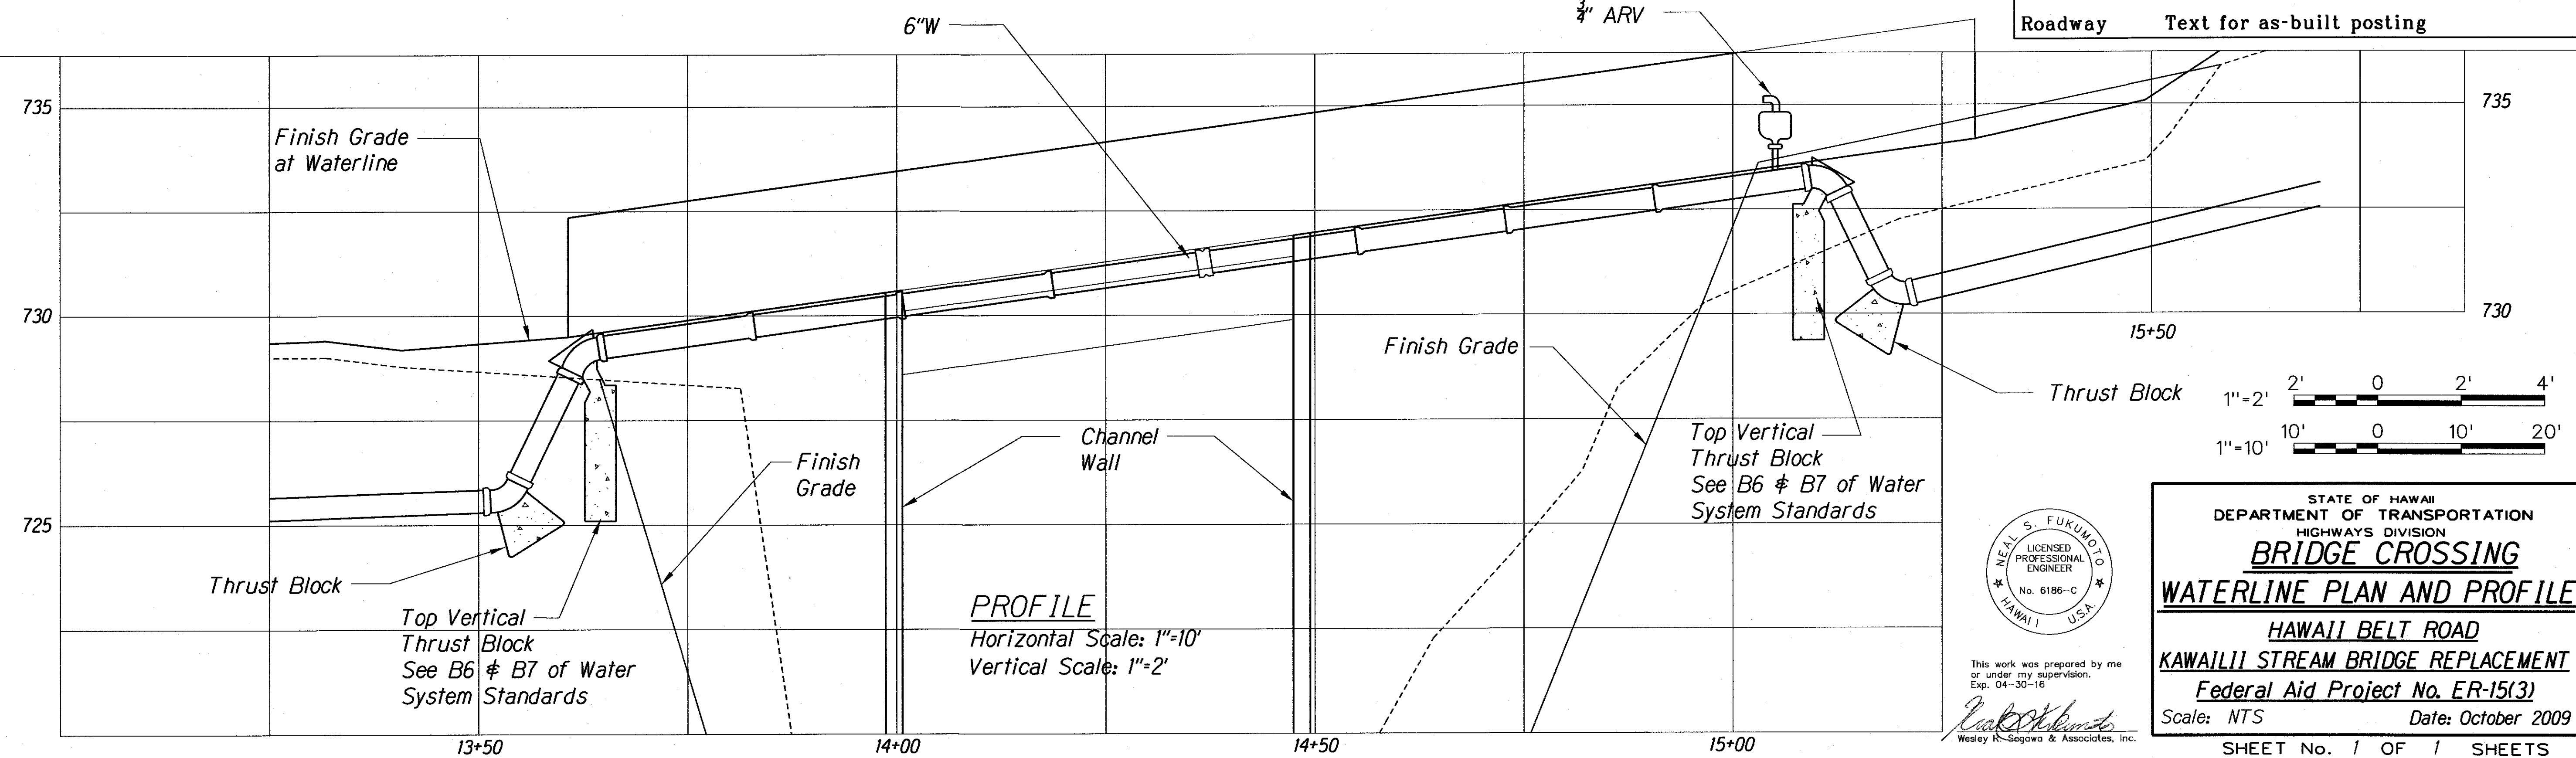

PROFILE
Horizontal Scale: 1"=10'
Vertical Scale: 1"=2'

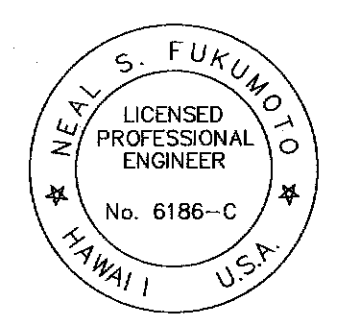

This work was prepared by me or under my supervision.
Exp. 04-30-16
Wesley R. Segawa & Associates, Inc.

STATE OF HAWAII
DEPARTMENT OF TRANSPORTATION
HIGHWAYS DIVISION
BRIDGE CROSSING
WATERLINE PLAN AND PROFILE
HAWAII BELT ROAD
KAWAILII STREAM BRIDGE REPLACEMENT
Federal Aid Project No. ER-15(3)
Scale: NTS
Date: October 2009
SHEET No. 1 OF 1 SHEETS

DESIGNED BY	DATE
DRAWN BY	
CHECKED BY	
NOTED BY	
QUANTITIES BY	
CHECKED BY	

AS-BUILT