



FED. ROAD DIST. NO.	STATE	FEDERAL AID PROJ. NO.	FISCAL YEAR	SHEET NO.	TOTAL SHEETS
HAWAII	HAW.	BR-019-2(61)	2013 C.O. 17	117	117

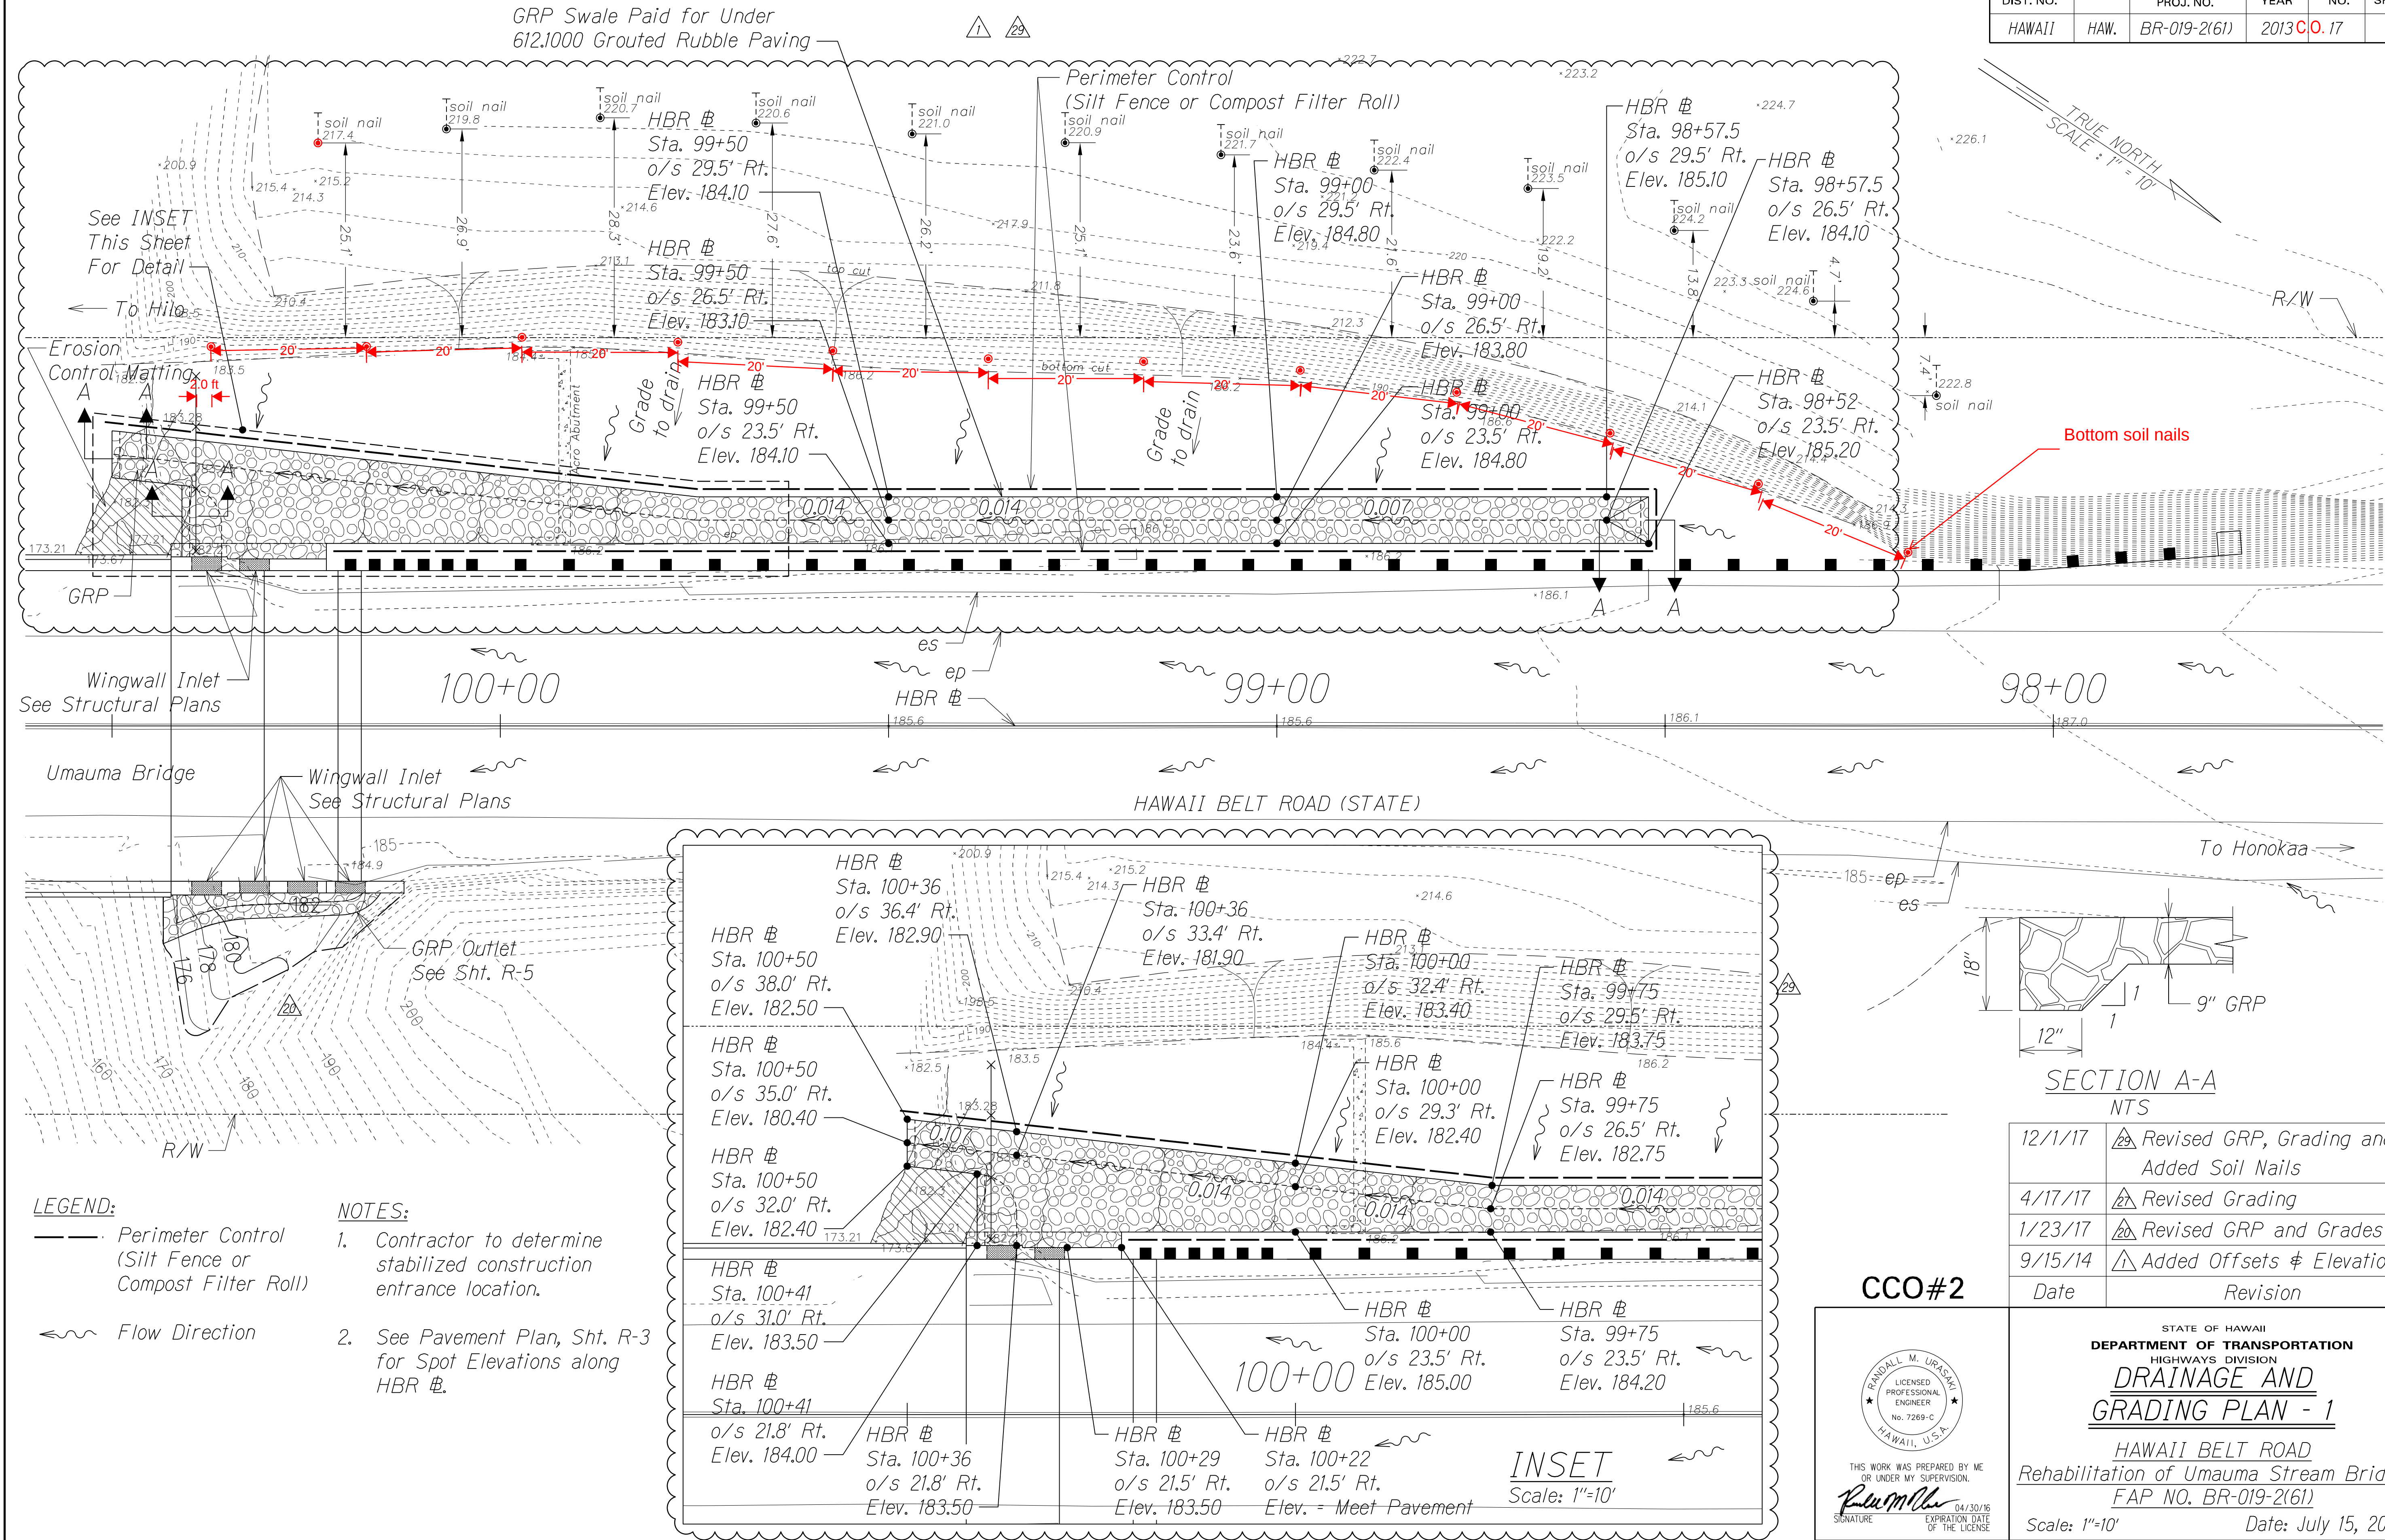

FED. ROAD DIST. NO.	STATE	FEDERAL AID PROJ. NO.	FISCAL YEAR	SHEET NO.	TOTAL SHEETS
HAWAII	HAW.	BR-019-2(61)	2013	C.O. 18	117

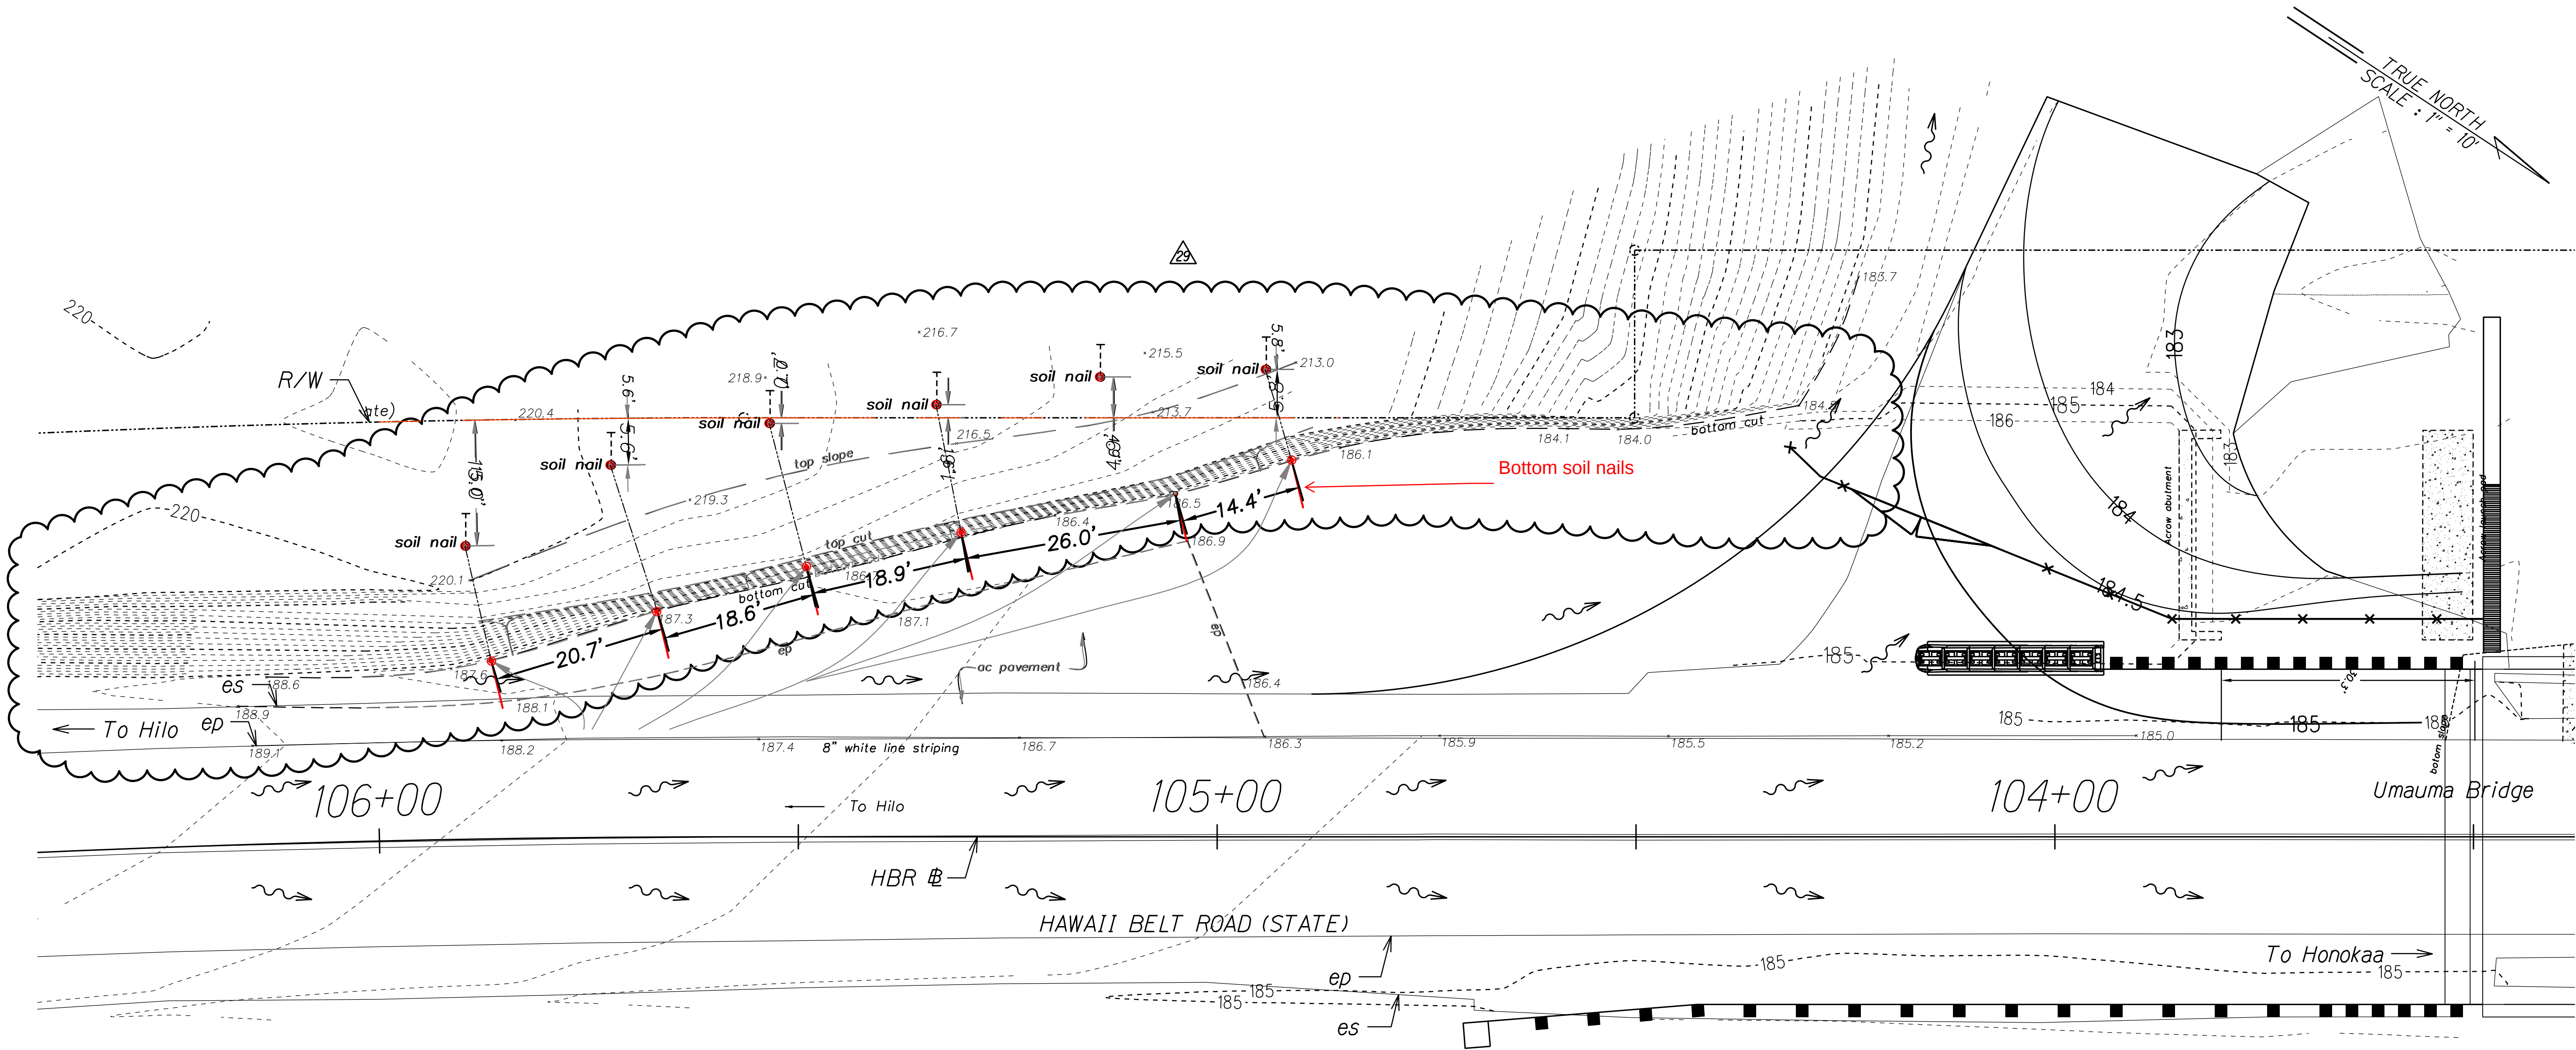

SURVEY PLOTTED BY	DATE
DRAWN BY	
DESIGNED BY	
NOTE BOOK	
QUANTITIES BY	
CHECKED BY	

NOTES:

- Contractor to determine stabilized construction entrance location.
- See Pavement Plan, Sht. R-4 for Spot Elevations along HBR #.

LEGEND:

- Perimeter Control (Silt Fence or Compost Filter Roll)
- Flow Direction

CCO#2

THIS WORK WAS PREPARED BY ME OR UNDER MY SUPERVISION.
SIGNATURE: *R. Urasaki* 04/30/16
EXPIRATION DATE OF THE LICENSE

STATE OF HAWAII
DEPARTMENT OF TRANSPORTATION
HIGHWAYS DIVISION
DRAINAGE AND GRADING PLAN - 2
HAWAII BELT ROAD
Rehabilitation of Umauma Stream Bridge
FAP NO. BR-019-2(61)
Scale: 1"=10' Date: July 15, 2014