


FED. ROAD DIST. NO.	STATE	FEDERAL AID PROJ. NO.	FISCAL YEAR	SHEET NO.	TOTAL SHEETS
HAWAII	HAW.	BR-019-2(61)	2013	C.O. 9	117

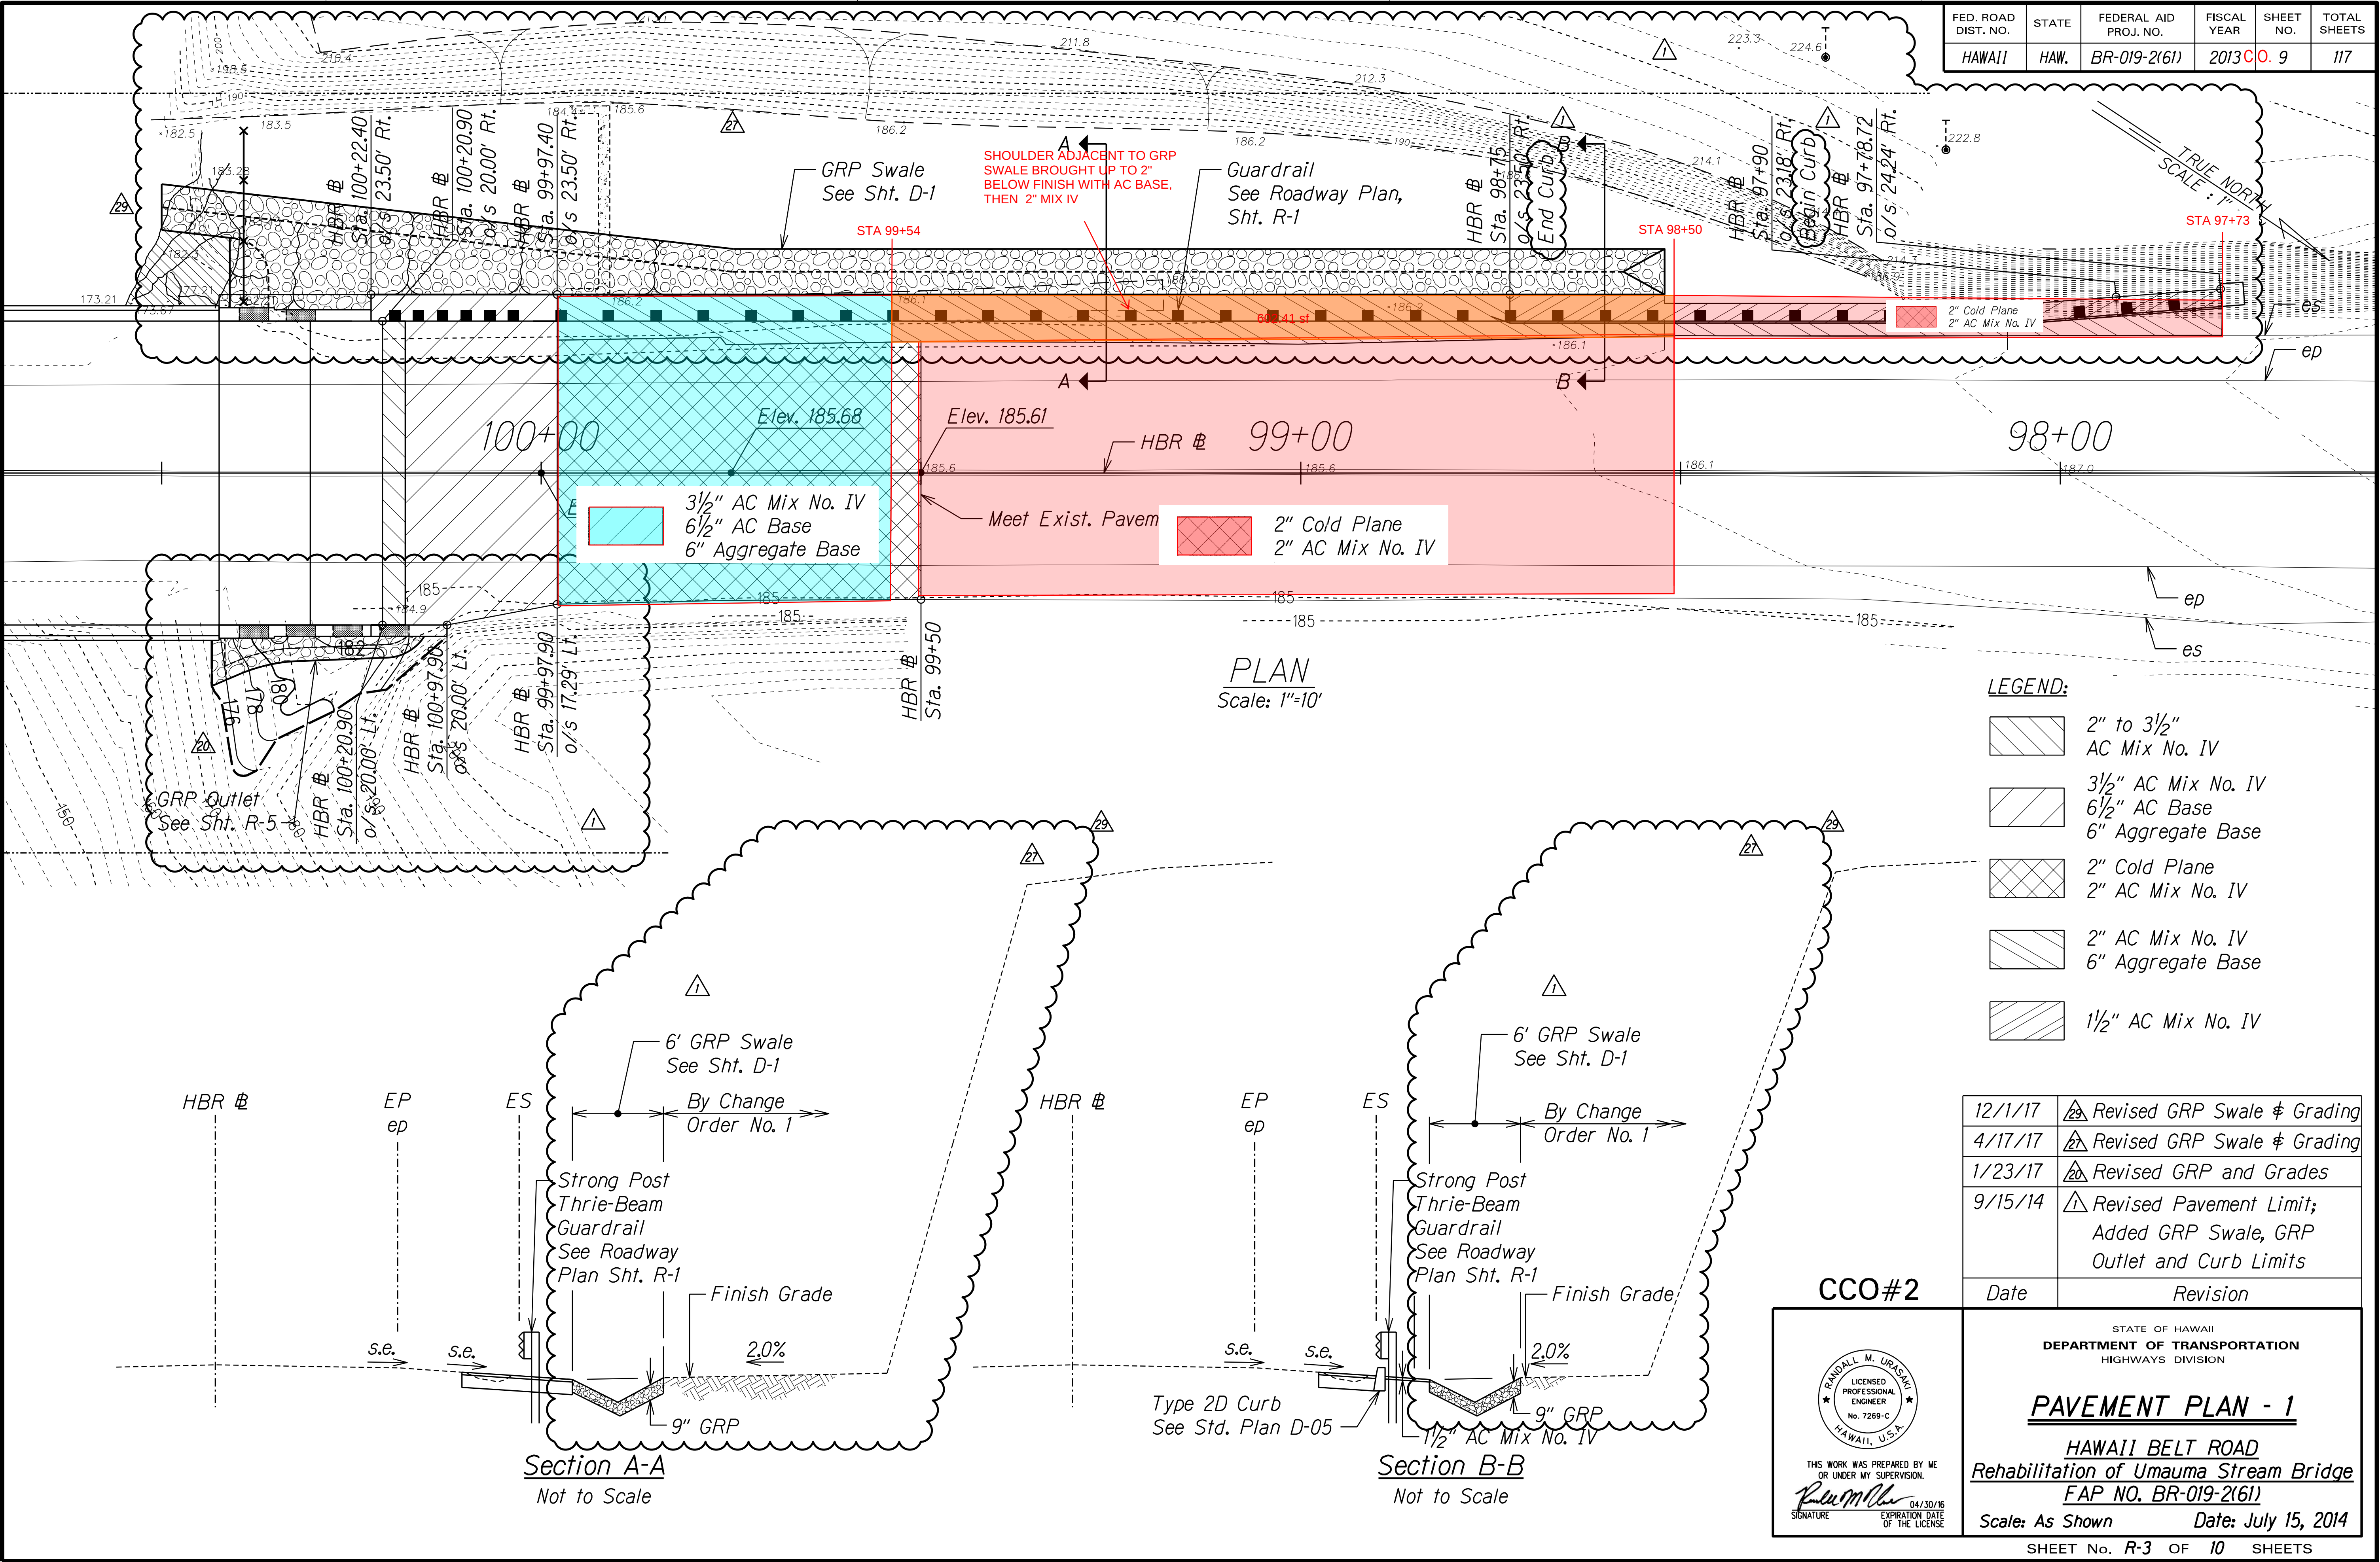

LEGEND:

	2" to 3 1/2" AC Mix No. IV
	3 1/2" AC Mix No. IV 6 1/2" AC Base 6" Aggregate Base
	2" Cold Plane 2" AC Mix No. IV
	2" AC Mix No. IV 6" Aggregate Base
	1 1/2" AC Mix No. IV

12/1/17	23 Revised GRP Swale & Grading
4/17/17	24 Revised GRP Swale & Grading
1/23/17	20 Revised GRP and Grades
9/15/14	1 Revised Pavement Limit; Added GRP Swale, GRP Outlet and Curb Limits
Date	Revision

CCO#2

THIS WORK WAS PREPARED BY ME OR UNDER MY SUPERVISION.

R. Urasaki 04/30/16
SIGNATURE EXPIRATION DATE OF THE LICENSE

STATE OF HAWAII
DEPARTMENT OF TRANSPORTATION
HIGHWAYS DIVISION

PAVEMENT PLAN - 1


HAWAII BELT ROAD
Rehabilitation of Umauma Stream Bridge
FAP NO. BR-019-2(61)

Scale: As Shown Date: July 15, 2014

SHEET No. R-3 OF 10 SHEETS

SURVEY PLOTTED BY	DATE
DRAWN BY	
DESIGNED BY	
QUANTITIES BY	
CHECKED BY	

FED. ROAD DIST. NO.	STATE	FEDERAL AID PROJ. NO.	FISCAL YEAR	SHEET NO.	TOTAL SHEETS
HAWAII	HAW.	BR-019-2(61)	2013	C.O. 10	117

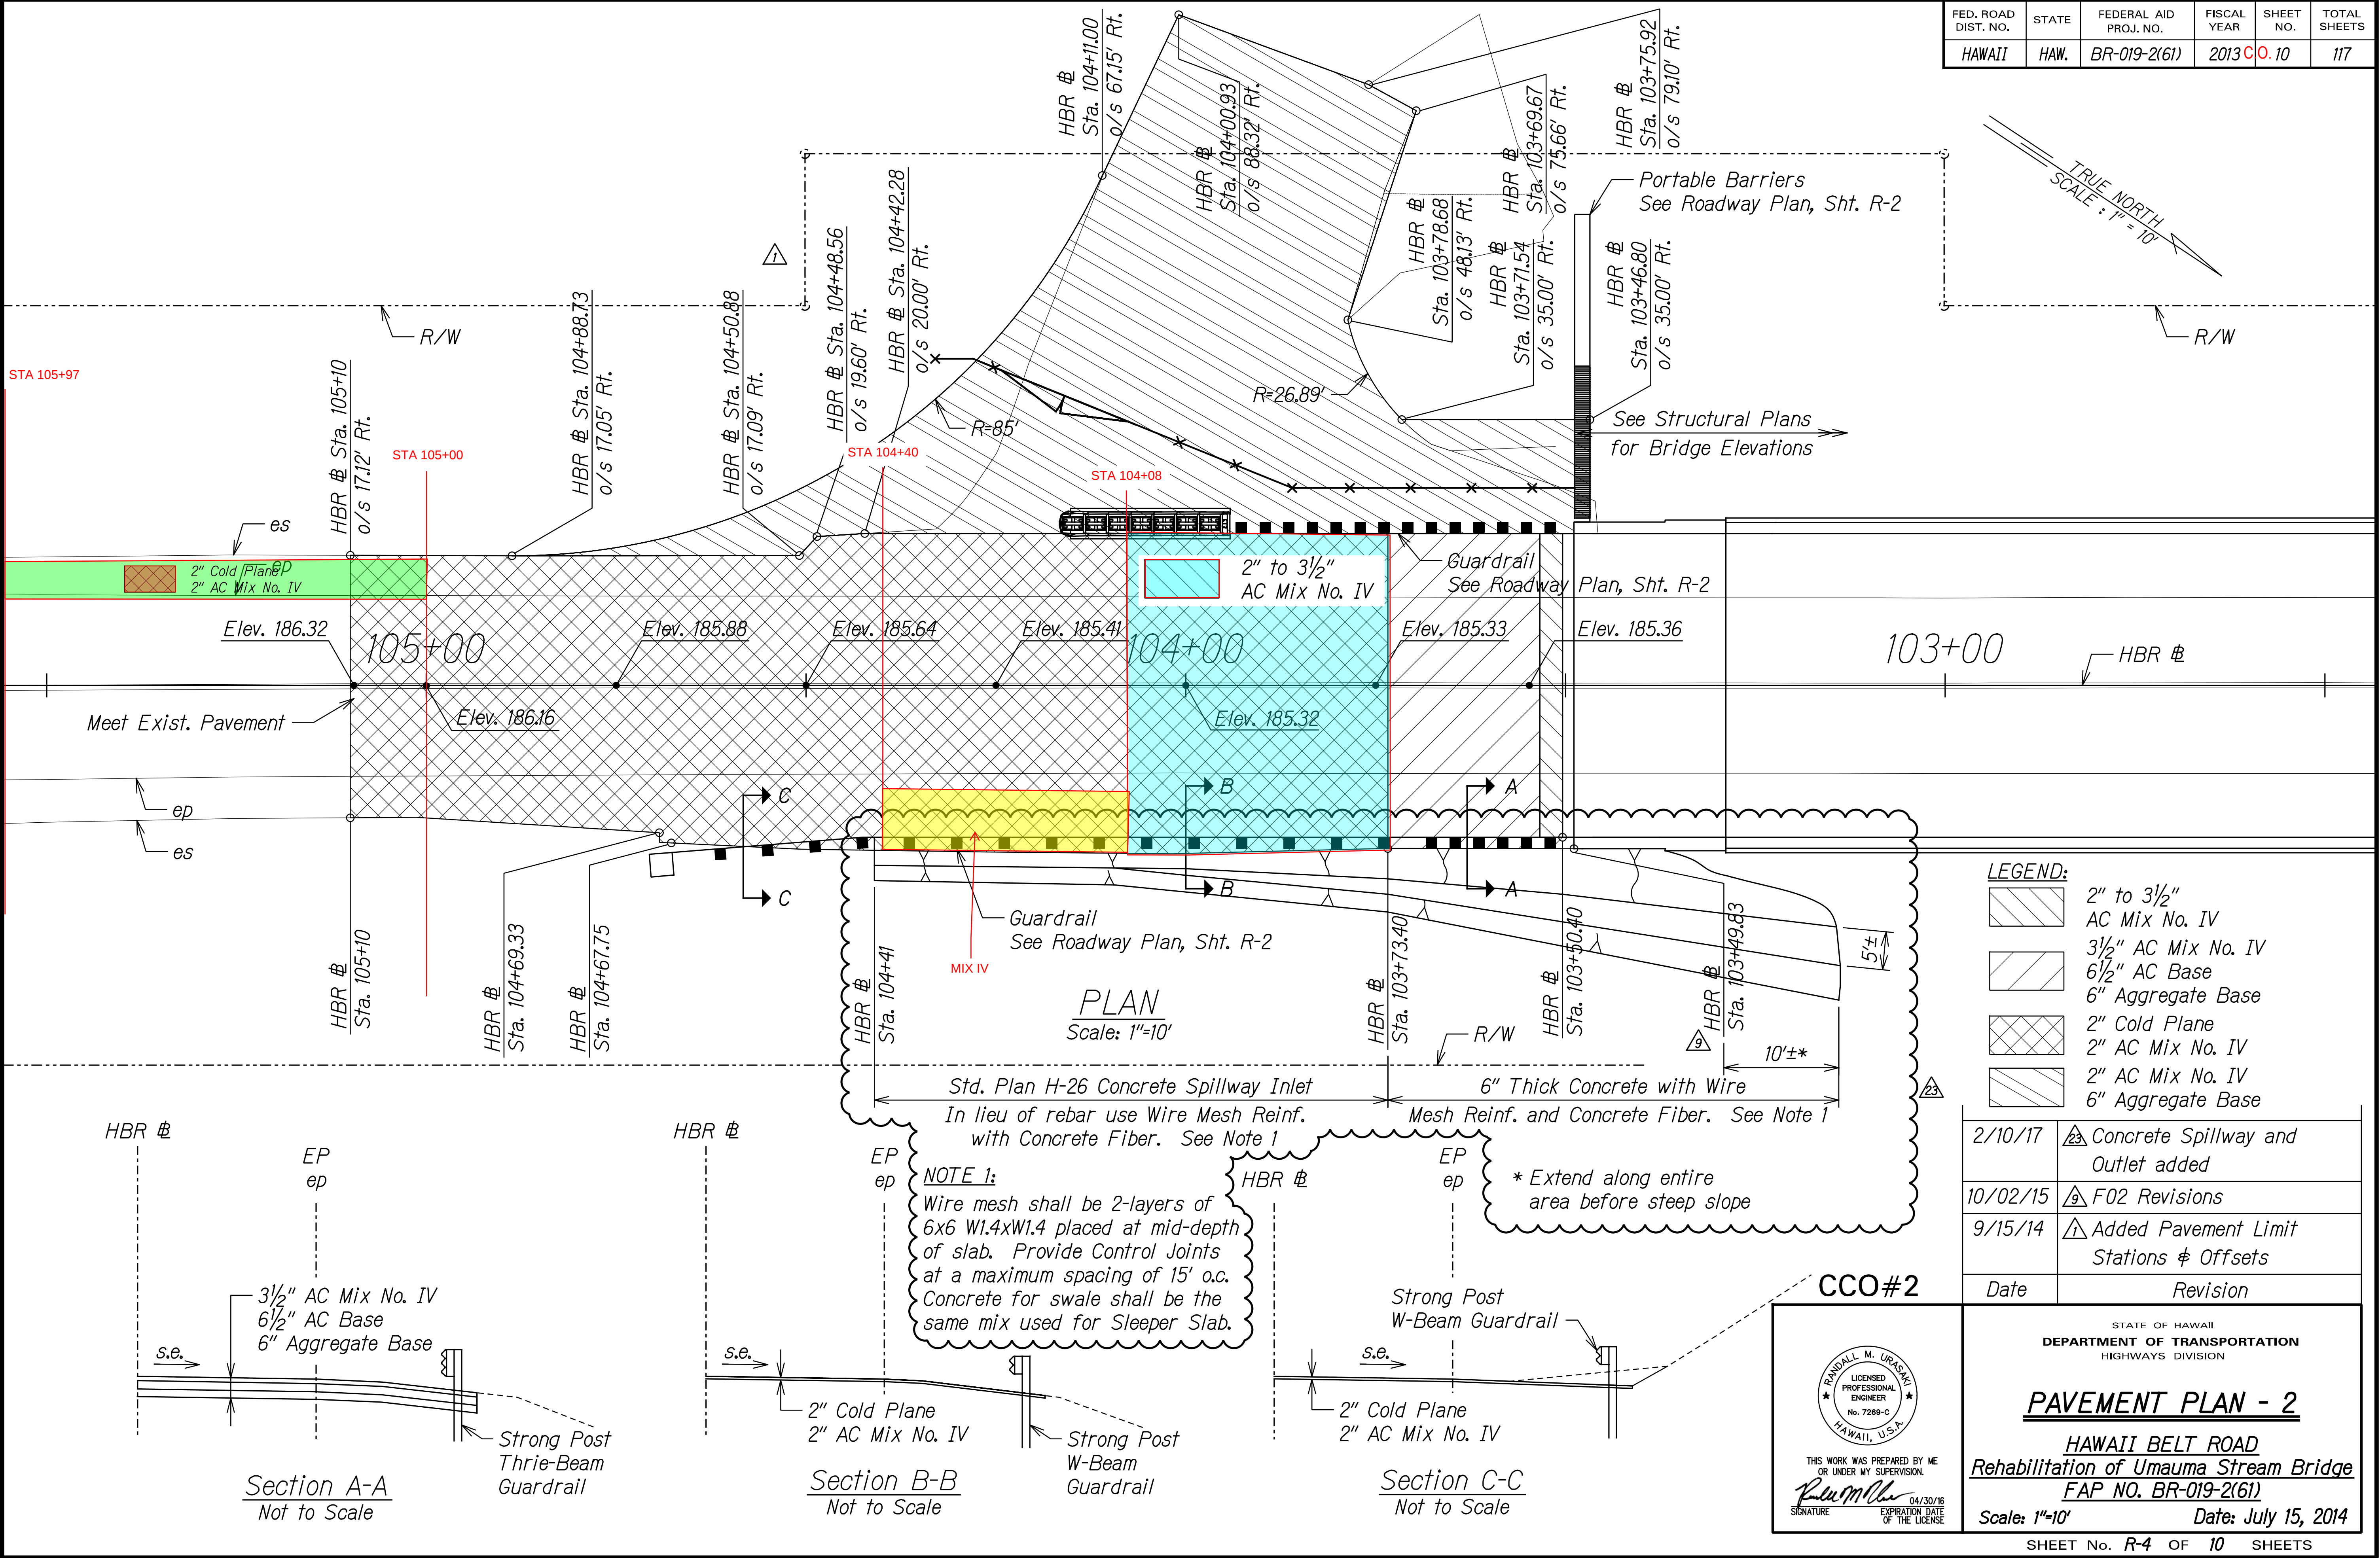

SURVEY PLOTTED BY	DATE
DRAWN BY	
DESIGNED BY	
QUANTITIES BY	
CHECKED BY	

CCO#2

RANDALL M. URASAKI
LICENSED PROFESSIONAL ENGINEER
No. 7289-C
HAWAII, U.S.A.

THIS WORK WAS PREPARED BY ME OR UNDER MY SUPERVISION.

R. M. Urasaki
SIGNATURE

04/30/16
EXPIRATION DATE OF THE LICENSE

STATE OF HAWAII
DEPARTMENT OF TRANSPORTATION
HIGHWAYS DIVISION

PAVEMENT PLAN - 2

HAWAII BELT ROAD
Rehabilitation of Umauma Stream Bridge
FAP NO. BR-019-2(61)

Scale: 1"=10' Date: July 15, 2014